



LEGEND

- ASME SECTION XI CLASS 1 PIPING
- - - ASME SECTION XI CLASS 2 PIPING
- ASME SECTION XI CLASS 3 PIPING
- NON-ISI NUCLEAR CLASS AND HSC CLASS
- REFERENCE & CONTINUITY
- D - D - HVAC DUCT
- A ANCHOR
- CS CONSTANT SPRING HANGER
- VS VARIABLE SPRING HANGER
- HS HYDRAULIC SNUBBER
- MS MECHANICAL SNUBBER
- N NON-WELDED SUPPORT ATTACHMENT
- W WELDED INTEGRAL SUPPORT ATTACHMENT
- R RIGID SUPPORT
- T SWAY STRUT
- SW SHOF WELD
- FW FIELD WELD
- LW LONGITUDINAL WELD
- WOL WELDLET
- ISI ITEM NUMBER DESIGNATION USED IN THE FIRST 10 YEAR INSERVICE INSPECTION INTERVAL.

NOTES:



1. MULTIPLE SWAY STRUTS, SPRING SUPPORTS OR SNUBBERS IN A SINGLE PIPING SUPPORT ARE SHOWN BY A NUMBER BEFORE THE SUPPORT TYPE. (EXAMPLE: 2MS - TWO HYDRAULIC TYPE SNUBBERS THAT ARE NOT WELDED INTEGRAL TO THE PIPE).
2. THE SUPPORTS ON THE DECAY HEAT LINE 10-HCB-24 ARE WITHIN THE ISI EXAMINATION BOUNDARY. THE PIPING WELDS IN THIS LINE ARE SHOWN FOR REFERENCE PURPOSES ONLY. THESE WELDS MAY NOT BE REPRESENTED IN THE ACTUAL AS-BUILT CONDITION.
3. PIPING SYSTEMS ON THIS DRAWING WHICH ARE OUTSIDE OF THE ISI BOUNDARY, ARE SHOWN FOR REFERENCE AND CONTINUITY PURPOSES ONLY. THE CONFIGURATION SHOWN MAY NOT REPRESENT THE ACTUAL AS-BUILT CONDITION.

GENERAL NOTE:

DIMENSIONS SHOWN ON THIS DRAWING ARE TO BE USED FOR APPROXIMATE LOCATION ONLY. USE DESIGN DRAWINGS FOR DIMENSIONAL VERIFICATION.

REFERENCE DRAWINGS:

- 15102-033B DECAY HEAT TRAIN 1
- 15102-033C DECAY HEAT TRAIN 2

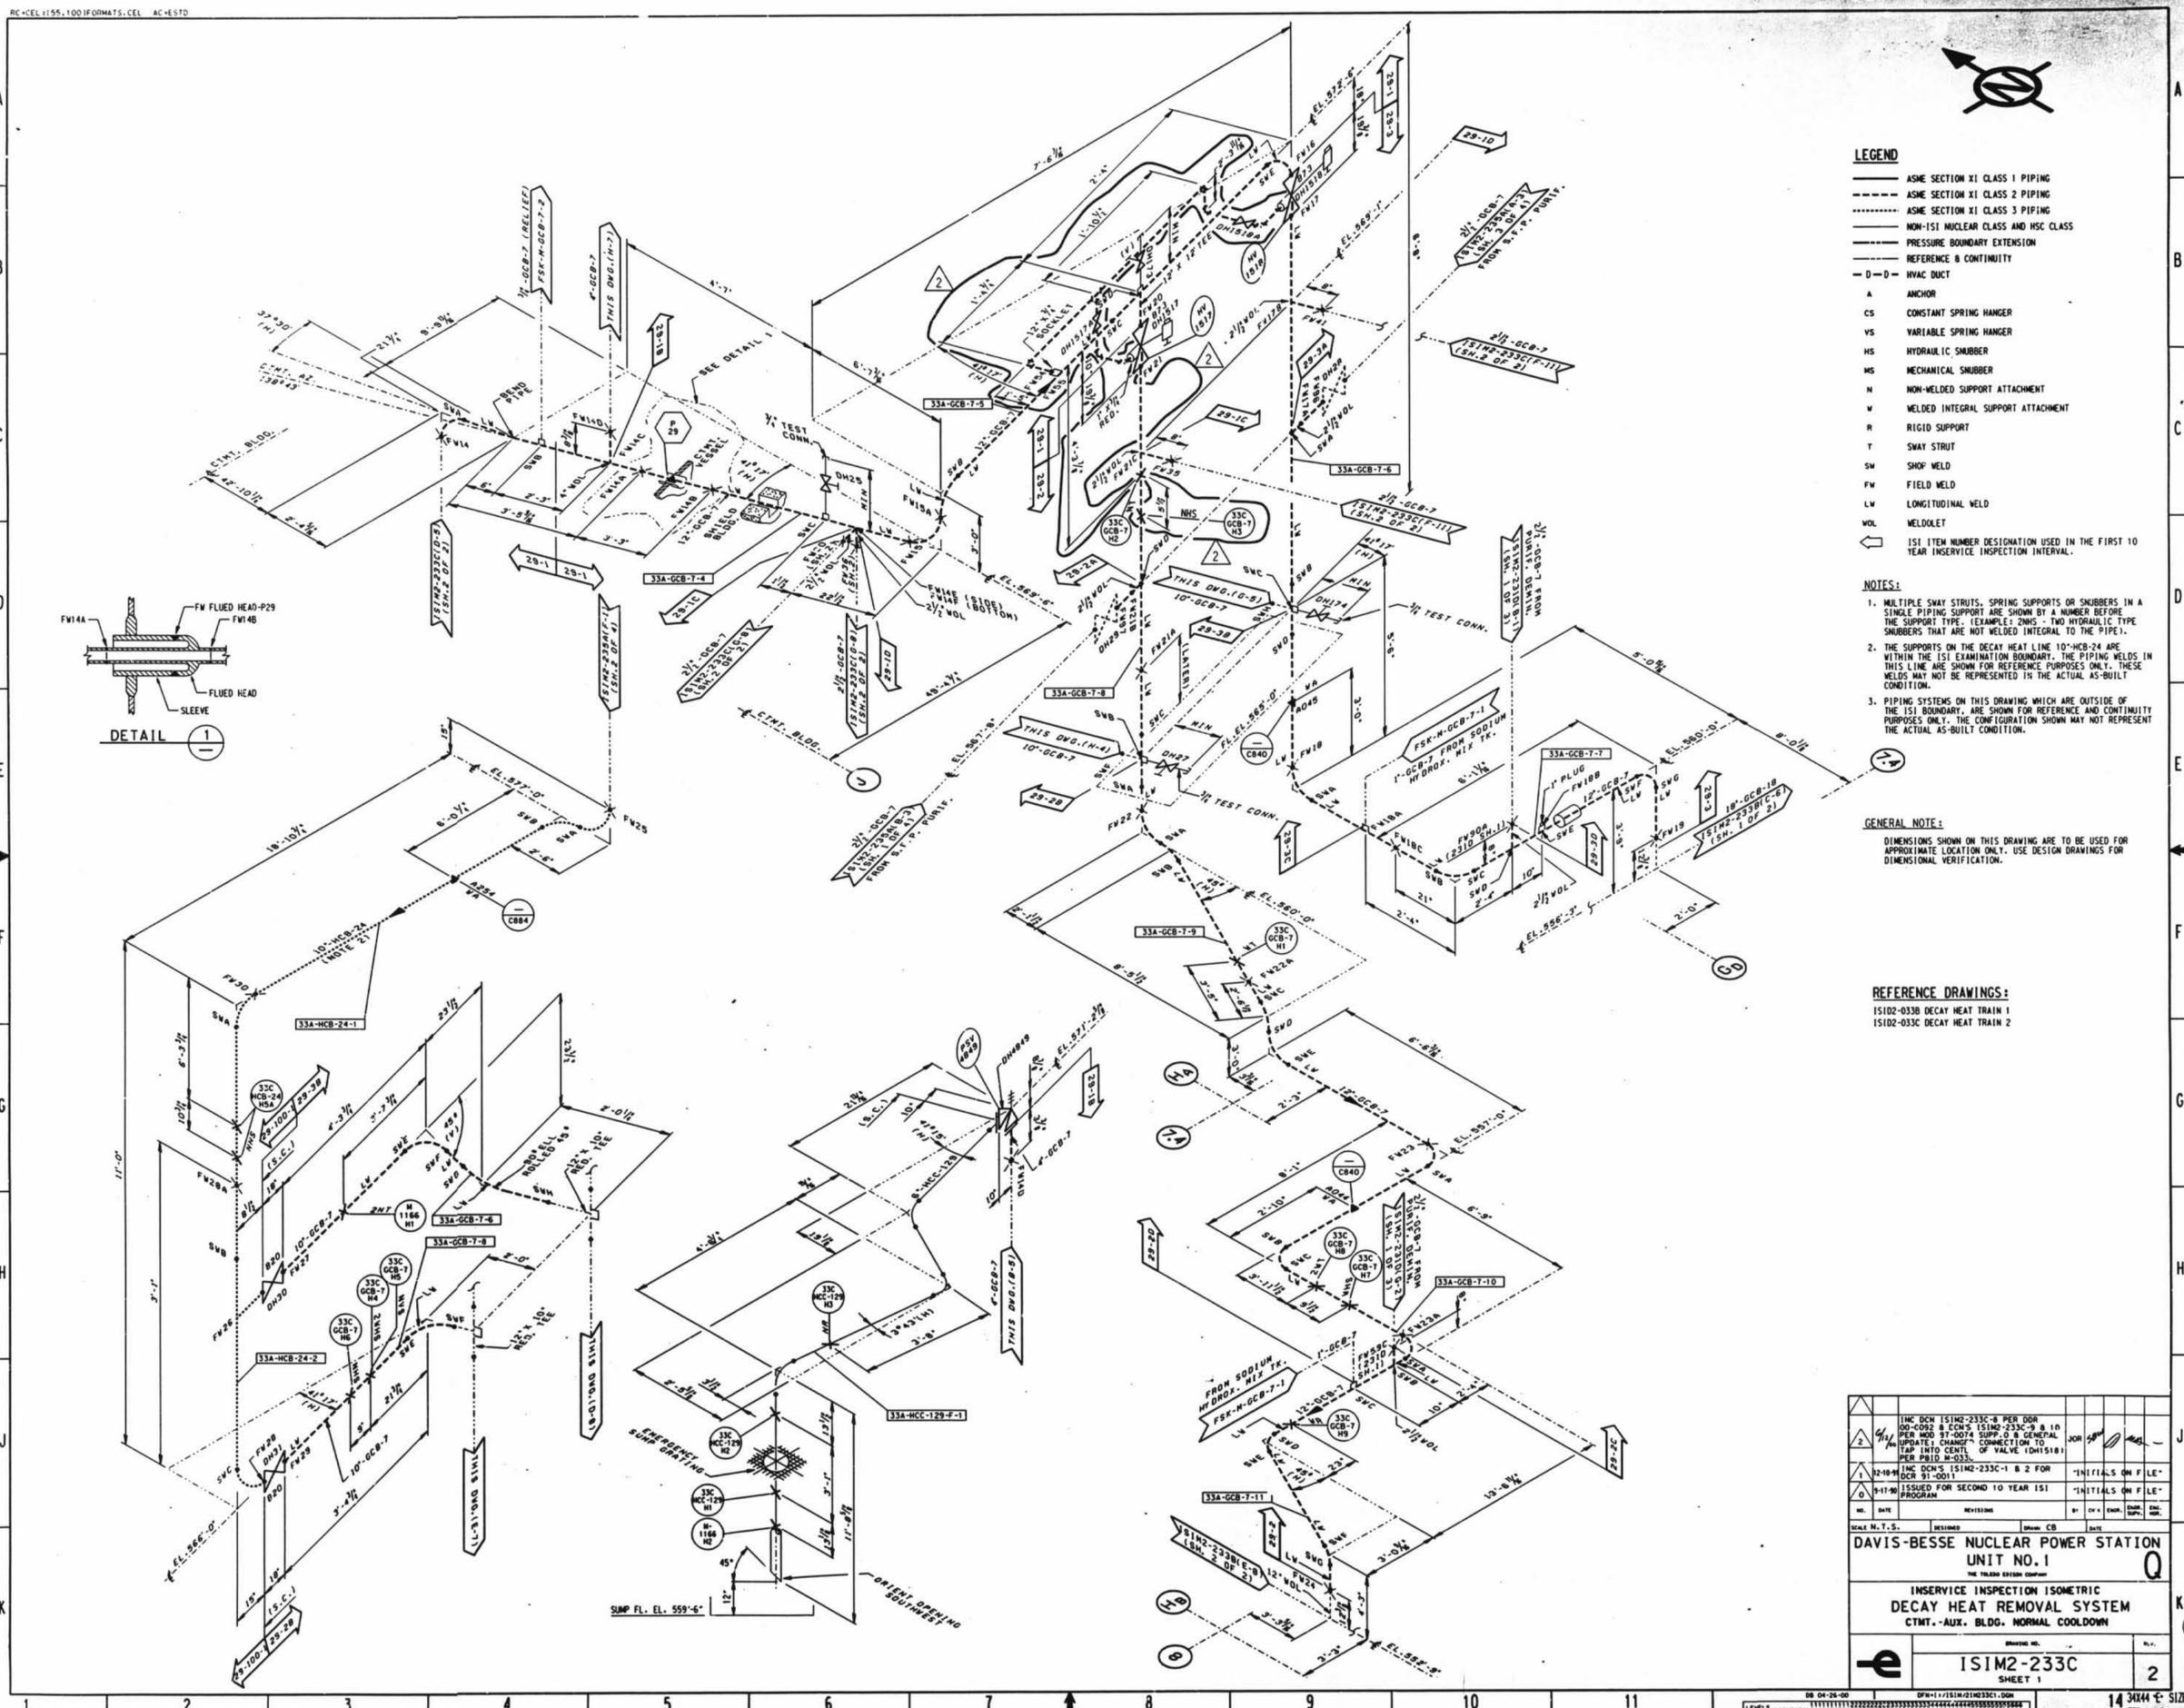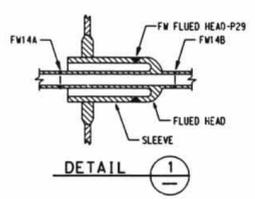

1	INC DCN 15102-233C-8 PER DDR 00-002 & ECHS 15102-233C-9 & 10 PER WOOD 97-0074 SUPP. & GENERAL UPDATE; CHANGE CONNECTION TO 15102-233C-11 (SHEET 1 OF 2) FROM 15102-233C-11 (SHEET 1 OF 2) PER PRD M-033.	DATE	REVISION	BY	CHKD	APP'D	REV.
2	INC DCN 15102-233C-1 & 2 FOR 15102-233C-11 (SHEET 1 OF 2) FROM 15102-233C-11 (SHEET 1 OF 2) PER PRD M-033.	DATE	REVISION	BY	CHKD	APP'D	REV.
STATE N.T.S. DESIGNED BY: CB DATE:							
DAVIS-BESSE NUCLEAR POWER STATION UNIT NO. 1 <small>THE TRUBO EXISTING EQUIPMENT</small>							
INSERVICE INSPECTION ISOMETRIC DECAY HEAT REMOVAL SYSTEM CTMT. -AUX. BLDG. NORMAL COOLDOWN							
DRAWING NO. 15102-233C SHEET 1							

D-24

7-11-00 Lisa Bowers 30X