



LEGEND

- ASME SECTION XI CLASS 1 PIPING
- - - ASME SECTION XI CLASS 2 PIPING
- ASME SECTION XI CLASS 3 PIPING
- NON-151 NUCLEAR CLASS AND HSC CLASS
- PRESSURE BOUNDARY EXTENSION
- REFERENCE & CONTINUITY
- D - D - HVAC DUCT
- A ANCHOR
- CS CONSTANT SPRING HANGER
- VS VARIABLE SPRING HANGER
- HS HYDRAULIC SNUBBER
- MS MECHANICAL SNUBBER
- N NON-WELDED SUPPORT ATTACHMENT
- W WELDED INTEGRAL SUPPORT ATTACHMENT
- R RIGID SUPPORT
- T SWAY STRUT
- SW SHOP WELD
- LW LONGITUDINAL WELD
- WOL WELDLET
- ◁ IS1 ITEM NUMBER DESIGNATION USED IN THE FIRST 10 YEAR INSERVICE INSPECTION INTERVAL.

NOTES:


1. MULTIPLE SWAY STRUTS, SPRING SUPPORTS OR SNUBBERS IN A SINGLE PIPING SUPPORT ARE SHOWN BY A NUMBER BEFORE THE SUPPORT TYPE. (EXAMPLE: 2MS - TWO HYDRAULIC TYPE SNUBBERS THAT ARE NOT WELDED INTEGRAL TO THE PIPE).
2. THE SUPPORTS ON THE MAINSTEAM AUX. FEED PUMP SUPPLY LINE 4" EBD-19, 6" EBD-19, AND 6" EBD-20 ARE WITHIN THE IS1 EXAMINATION BOUNDARY. THE PIPING WELDS IN THESE LINES ARE SHOWN FOR REFERENCE PURPOSES ONLY. THESE WELDS MAY NOT BE REPRESENTED IN THE ACTUAL AS-BUILT CONDITION.
3. PIPING SYSTEMS ON THIS DRAWING WHICH ARE OUTSIDE OF THE IS1 BOUNDARY, ARE SHOWN FOR REFERENCE AND CONTINUITY PURPOSES ONLY. THE CONFIGURATION SHOWN MAY NOT REPRESENT THE ACTUAL AS-BUILT CONDITION.

GENERAL NOTE

DIMENSIONS SHOWN ON THIS DRAWING ARE TO BE USED FOR APPROXIMATE LOCATION ONLY. USE DESIGN DRAWINGS FOR DIMENSIONAL VERIFICATION.

REFERENCE DRAWINGS:

IS1D2-003C MAIN STEAM AND REHEAT SYSTEM SHEET 3

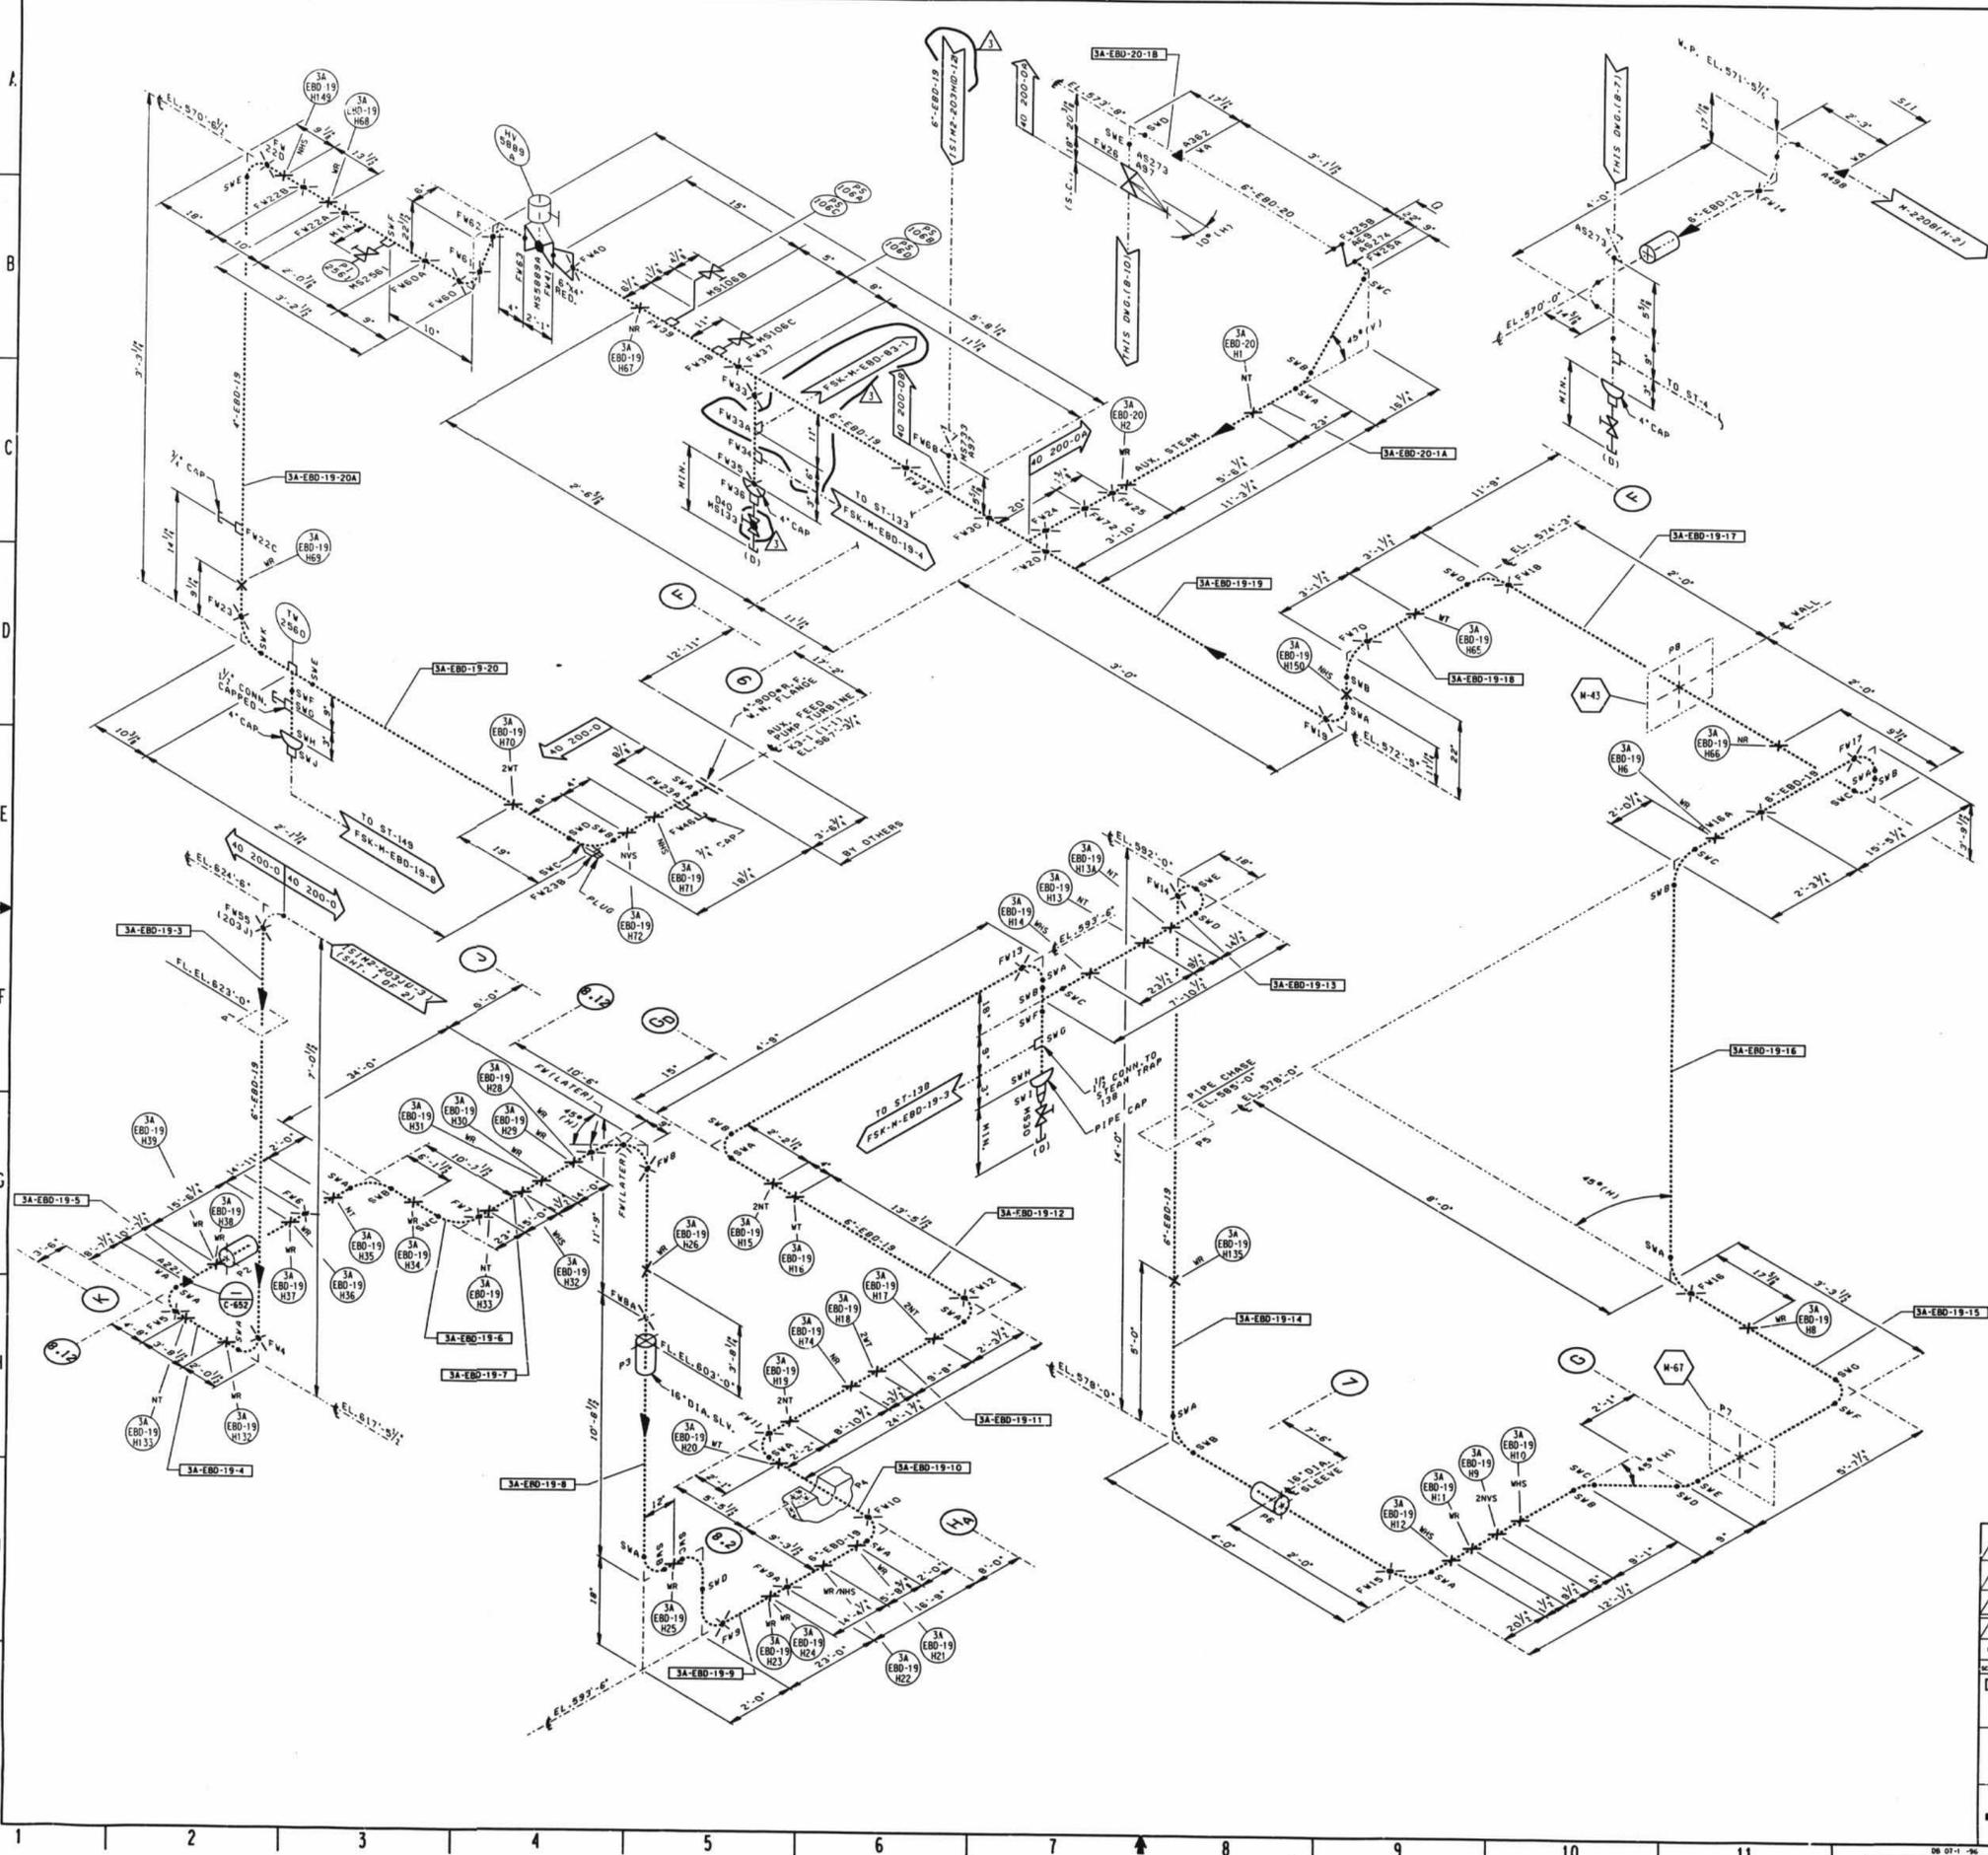

NO.	DATE	REVISIONS	BY	CHK'D	DATE
1	1/15/84	ISSUED FOR SECOND YEAR IS1 PROGRAM	CB	EFB	1/15/84
2	1/15/84	ISSUED FOR SECOND YEAR IS1 PROGRAM	CB	EFB	1/15/84
3	1/15/84	ISSUED FOR SECOND YEAR IS1 PROGRAM	CB	EFB	1/15/84

DAVIS-BESSE NUCLEAR POWER STATION
UNIT NO. 1

INSERVICE INSPECTION ISOMETRIC
MAIN STEAM SYSTEM
SUPPLY TO AUX. FEED PUMP TURBINE NO. 1-1

DRAWING NO. IS1M2-203F
REV. 3

D-97

1. CERTIFY THAT THE IMAGE CONTAINED ON THIS FRAME MAY BE USED FOR REPRODUCTION OF THE ORIGINAL DRAWING IN ANY MANNER WITHOUT THE WRITTEN PERMISSION OF THE ORIGINAL DRAWING AUTHOR. DATE: 8.14.96 BY: [Signature]