



LEGEND

- ASME SECTION XI CLASS 1 PIPING
- - - ASME SECTION XI CLASS 2 PIPING
- · · ASME SECTION XI CLASS 3 PIPING
- · · · · NON-ISI NUCLEAR CLASS AND HSC CLASS
- — — — — PRESSURE BOUNDARY EXTENSION
- - - - - REFERENCE & CONTINUITY
- D - D - HVAC DUCT
- A ANCHOR
- CS CONSTANT SPRING HANGER
- VS VARIABLE SPRING HANGER
- HS HYDRAULIC SNUBBER
- MS MECHANICAL SNUBBER
- N NON-WELDED SUPPORT ATTACHMENT
- W WELDED INTEGRAL SUPPORT ATTACHMENT
- R RIGID SUPPORT
- T SWAY STRUT
- SW SHOP WELD
- FW FIELD WELD
- LW LONGITUDINAL WELD
- WOL WELD-OLET
- ISI ITEM NUMBER DESIGNATION USED IN THE FIRST 10 YEAR INSERVICE INSPECTION INTERVAL.

NOTES:


1. PIPING SYSTEMS SHOWN ON THIS DRAWING ARE OUTSIDE OF THE ISI BOUNDARY. THEY ARE SHOWN FOR REFERENCE AND CONTINUITY PURPOSES ONLY. THE CONFIGURATION SHOWN MAY NOT REPRESENT THE ACTUAL AS-BUILT CONDITION.

GENERAL NOTE:

DIMENSIONS SHOWN ON THIS DRAWING ARE TO BE USED FOR APPROXIMATE LOCATION ONLY. USE DESIGN DRAWINGS FOR DIMENSIONAL VERIFICATION.

REFERENCE DRAWINGS:

- P B ID M-033B DECAY HEAT TRAIN 1
- P B ID M-033C DECAY HEAT TRAIN 2
- P B ID M-035 SPENT FUEL POOL COOLING SYSTEM

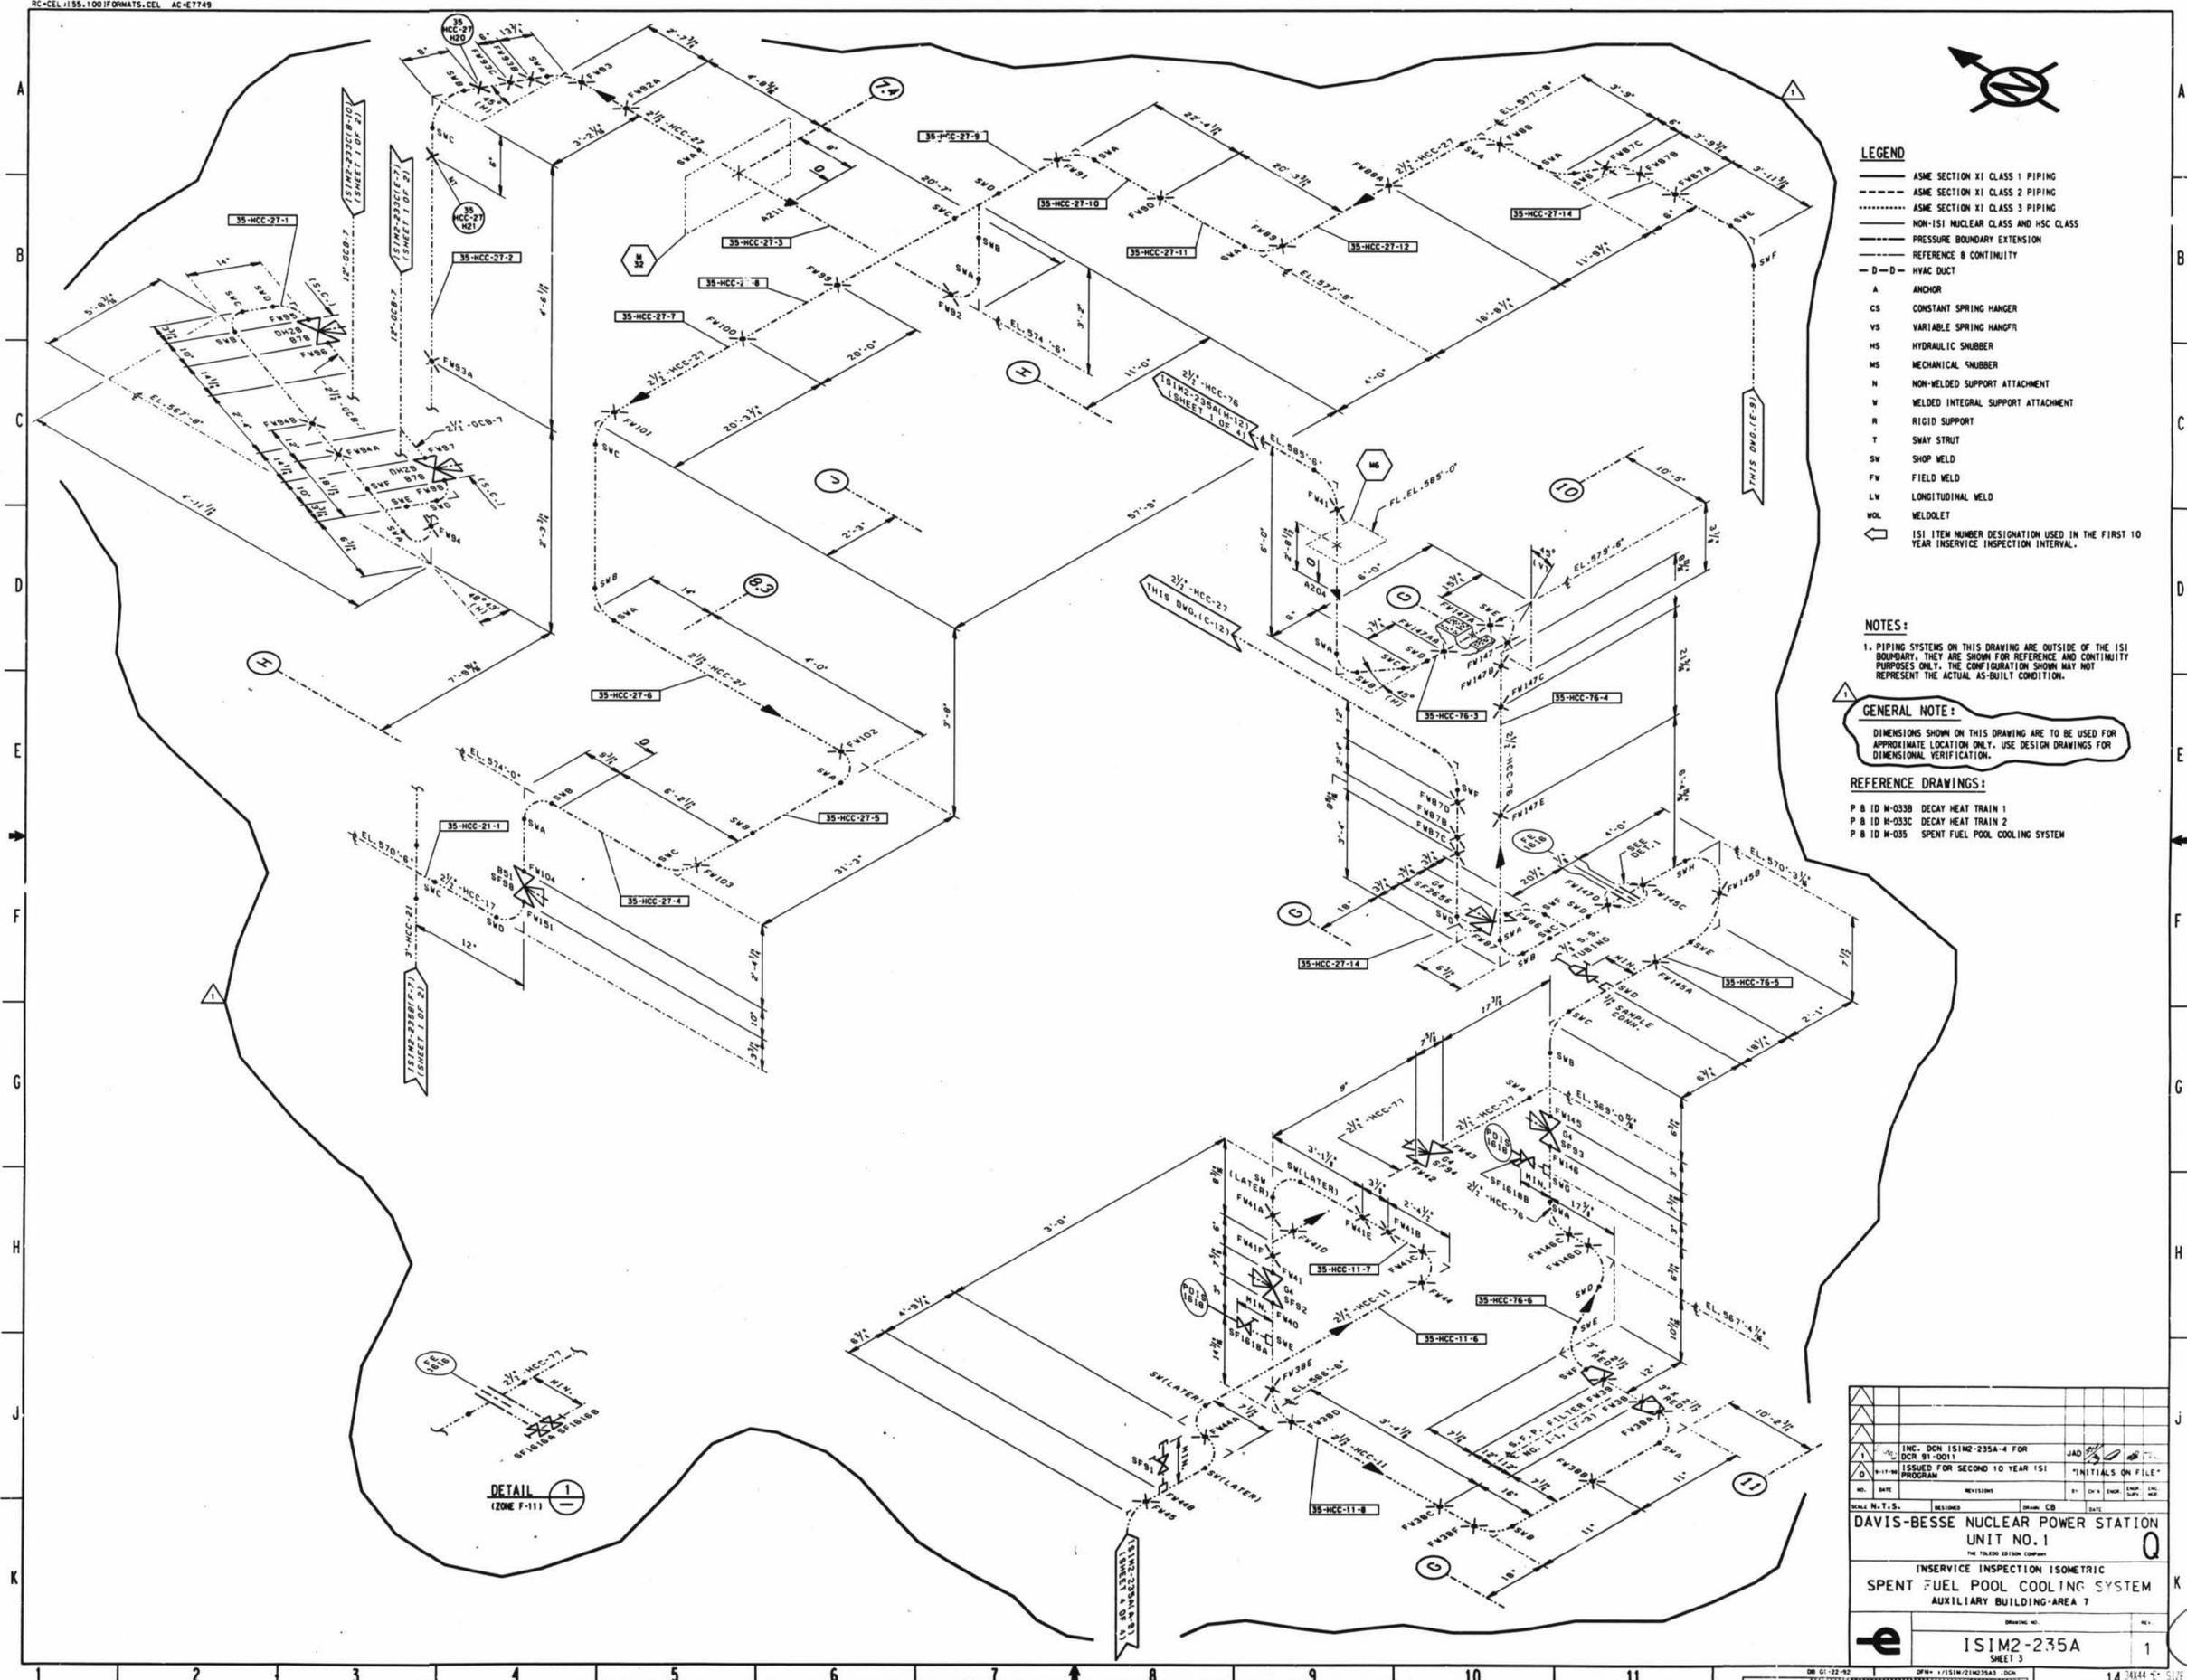

NO.	DATE	REVISIONS	BY	CHK	ENGR	DATE
SCALE: N.T.S. DESIGNED: _____ DRAWN: CB DATE: _____						
DAVIS-BESSE NUCLEAR POWER STATION UNIT NO. 1 THE YUKON DESIGN COMPANY						
INSERVICE INSPECTION ISOMETRIC SPENT FUEL POOL COOLING SYSTEM AUXILIARY BUILDING-AREA 7						
DRAWING NO. ISIM2-235A SHEET 3						1

D-46