

LEGEND

- ASME SECTION XI CLASS 1 PIPING
- - - ASME SECTION XI CLASS 2 PIPING
- ASME SECTION XI CLASS 3 PIPING
- NON-ISI NUCLEAR CLASS AND HSC CLASS
- PRESSURE BOUNDARY EXTENSION
- REFERENCE P CONTINUITY
- D - D HVAC DUCT
- A ANCHOR
- CS CONSTANT SPRING HANGER
- VS VARIABLE SPRING HANGER
- HS HYDRAULIC SHUBBER
- MS MECHANICAL SHUBBER
- N NON-WELDED SUPPORT ATTACHMENT
- W WELDED INTEGRAL SUPPORT ATTACHMENT
- R RIGID SUPPORT
- T SHAY STRUT
- SW SHOP WELD
- FW FIELD WELD
- LW LONGITUDINAL WELD
- WOL WELDOLET
- Ⓜ ISI ITEM NUMBER DESIGNATION USED IN THE FIRST 10 YEAR INSERVICE INSPECTION INTERVAL.

NOTES:


1. MULTIPLE SHAY STRUTS, SPRING SUPPORTS OR SHUBBERS IN A SINGLE PIPING SUPPORT ARE SHOWN BY A NUMBER BEFORE THE SUPPORT TYPE. (EXAMPLE: 2MS - TWO HYDRAULIC TYPE SHUBBERS THAT ARE NOT WELDED INTEGRAL TO THE PIPE).
2. THE SUPPORTS ON THE COMPONENT COOLING WATER LINE 6"-HBC-26, 6"-HBC-27, 18"-HBC-2 & 18"-HBC-23 ARE WITHIN THE ISI EXAMINATION BOUNDARY. THE PIPING WELDS IN THESE LINES ARE SHOWN FOR REFERENCE PURPOSES ONLY. THESE WELDS MAY NOT BE REPRESENTED IN THE ACTUAL AS-BUILT CONDITION.

GENERAL NOTE:

DIMENSIONS SHOWN ON THIS DRAWING ARE TO BE USED FOR APPROXIMATE LOCATION ONLY. USE DESIGN DRAWINGS FOR DIMENSIONAL VERIFICATION.

REFERENCE DRAWINGS:

15102-0368 COMPONENT COOLING WATER SYSTEM

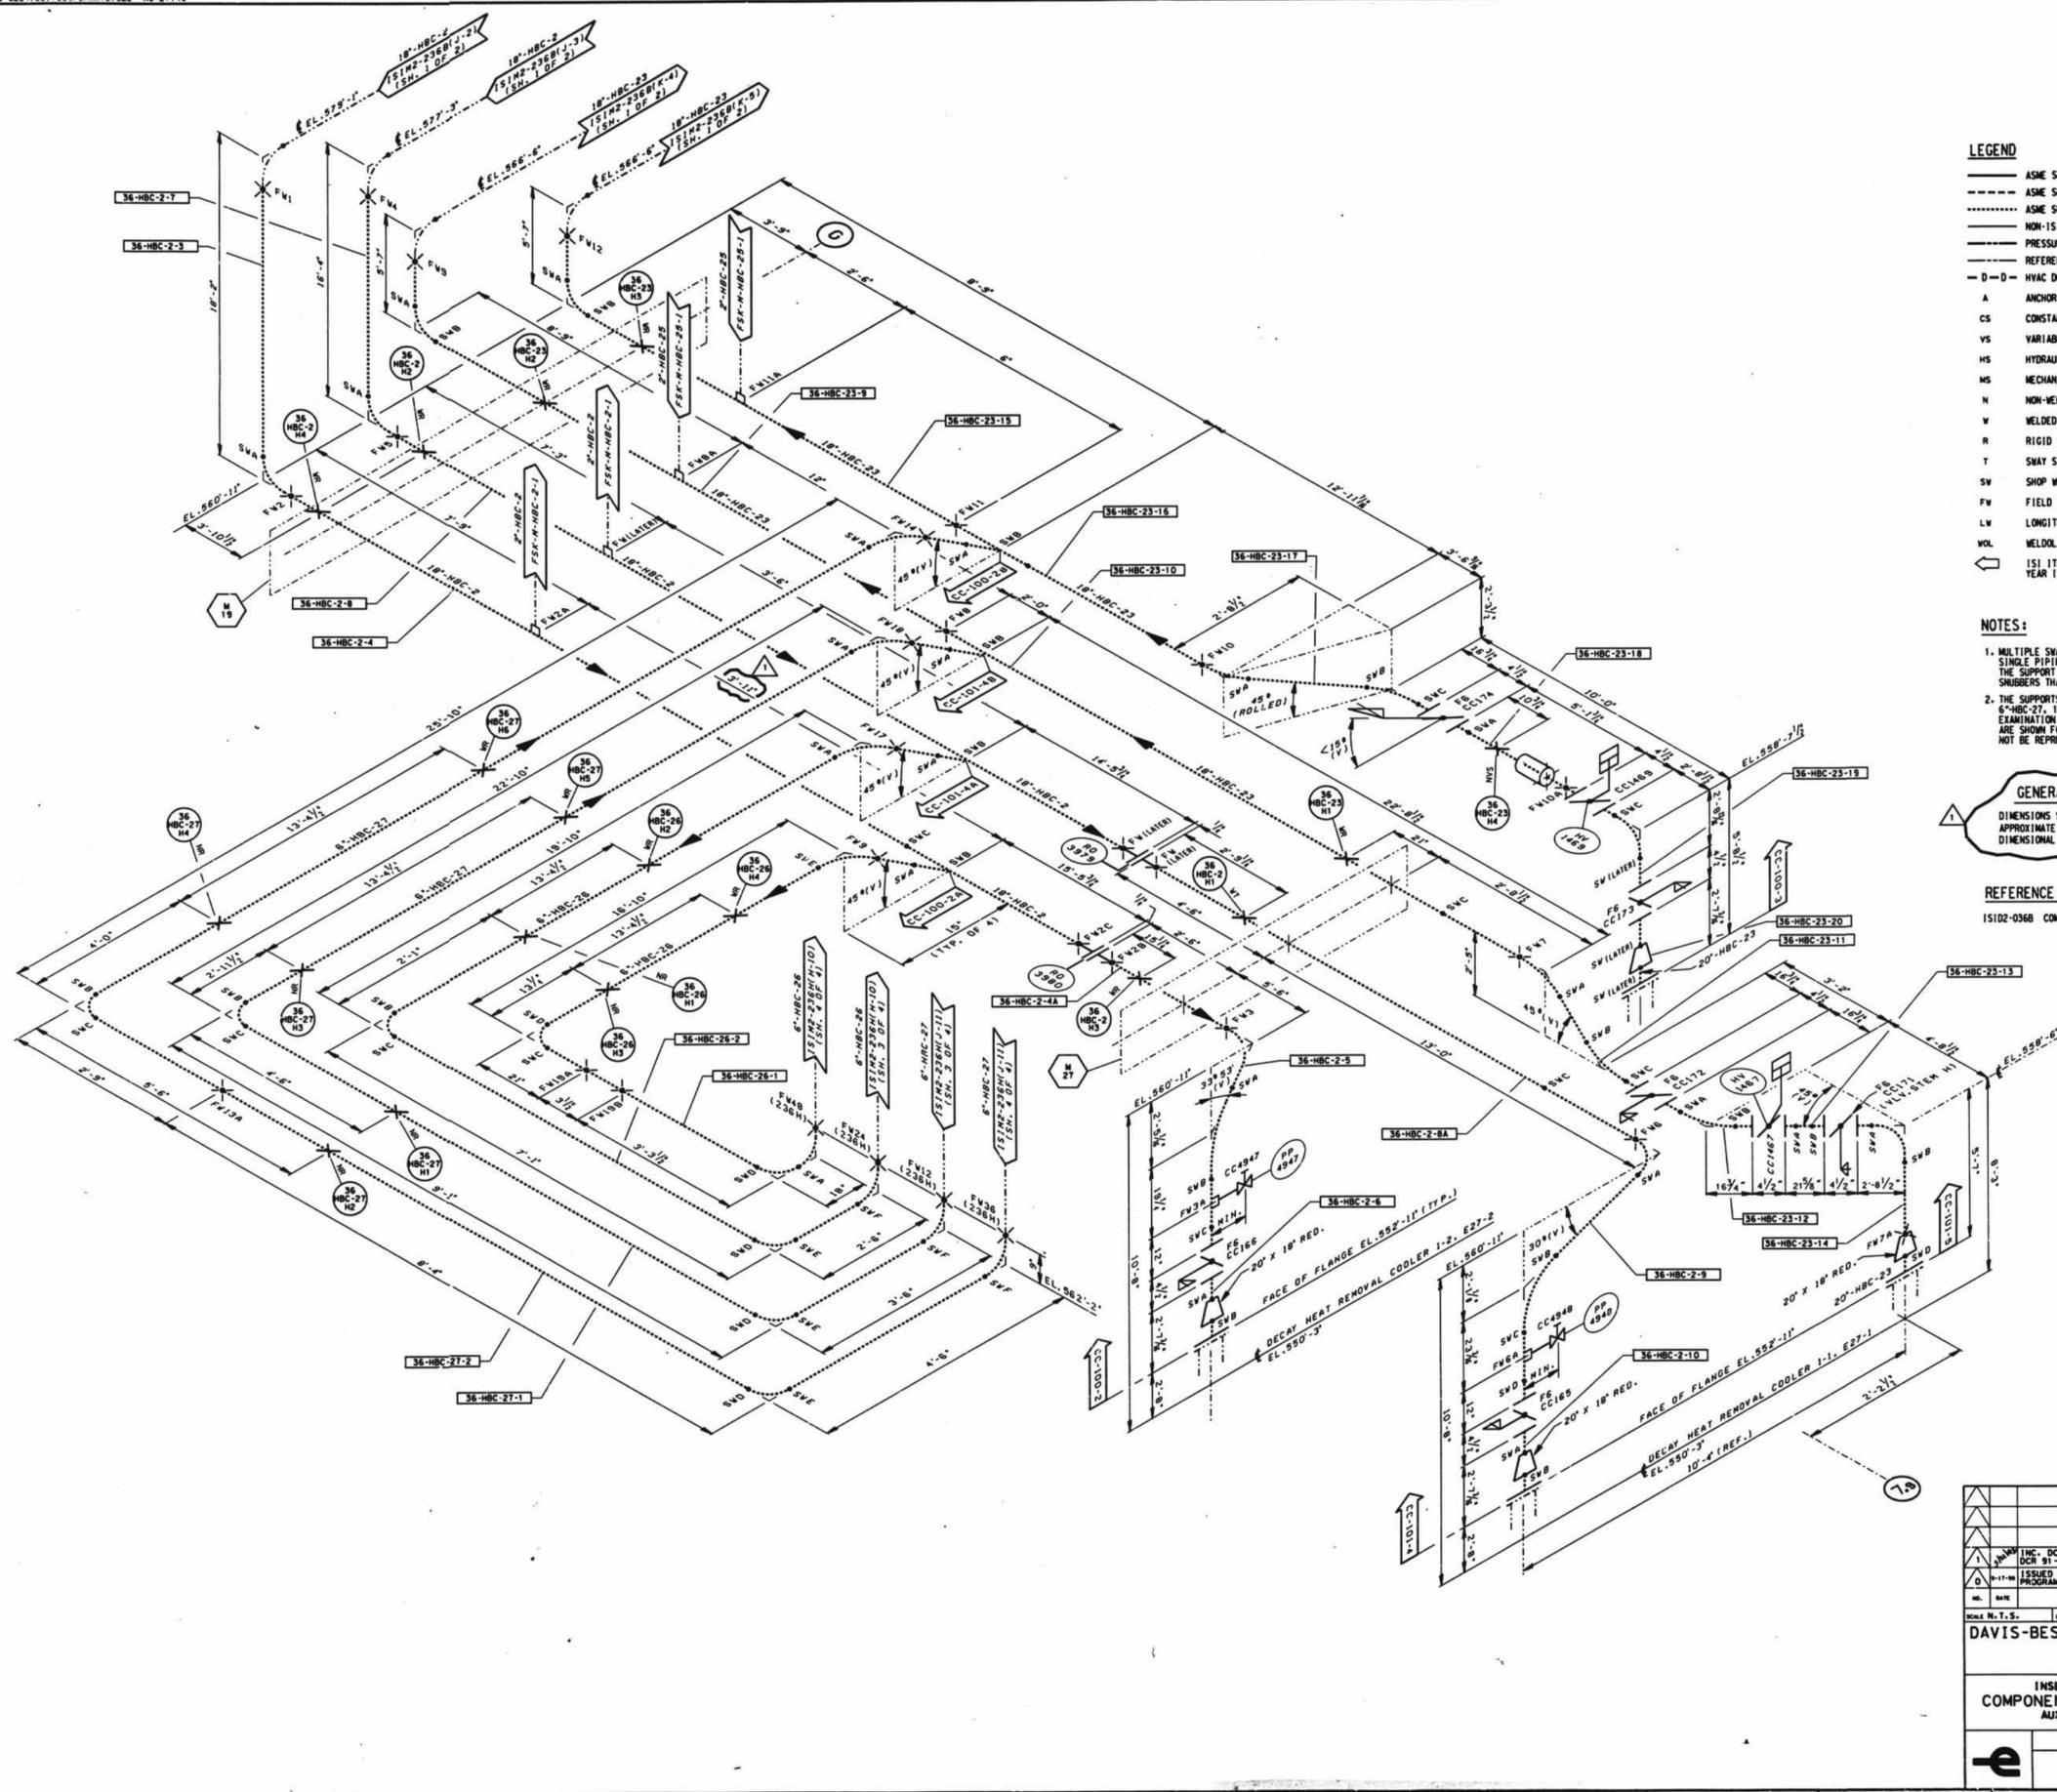

NO.	DATE	REVISION	BY	CHK'D	APP'D
SCALE: N.T.S. DESIGNED: DRAWN: CB DATE:					
DAVIS-BESSE NUCLEAR POWER STATION UNIT NO. 1					
INSERVICE INSPECTION ISOMETRIC COMPONENT COOLING WATER SYSTEM AUXILIARY BUILDING EL.545'-0"					
DRAWING NO. ISIM2-236A				REV. 1	

D-50