



**LEGEND**

- ASME SECTION XI CLASS 1 PIPING
- - - ASME SECTION XI CLASS 2 PIPING
- · · ASME SECTION XI CLASS 3 PIPING
- IS1 NUCLEAR CLASS AND NSC CLASS
- PRESSURE BOUNDARY EXTENSION
- REFERENCE & CONTINUITY
- D - D - HVAC DUCT
- A ANCHOR
- CS CONSTANT SPRING HANGER
- VS VARIABLE SPRING HANGER
- HS HYDRAULIC SNUBBER
- MS MECHANICAL SNUBBER
- N NON-WELDED SUPPORT ATTACHMENT
- W WELDED INTEGRAL SUPPORT ATTACHMENT
- R RIGID SUPPORT
- T SWAY STRUT
- SW SHOP WELD
- FW FIELD WELD
- LW LONGITUDINAL WELD
- WOL WELDOLET
- IS1 ITEM NUMBER DESIGNATION USED IN THE FIRST 10 YEAR INSERVICE INSPECTION INTERVAL.

**NOTES:**

1. MULTIPLE SWAY STRUTS, SPRING SUPPORTS OR SNUBBERS IN A SINGLE PIPING SUPPORT ARE SHOWN BY A NUMBER BEFORE THE SUPPORT TYPE. (EXAMPLE: 2MS - TWO HYDRAULIC TYPE SNUBBERS THAT ARE NOT WELDED INTEGRAL TO THE PIPE).
2. THE SUPPORTS ON THE AUXILIARY FEED PUMP DISCHARGE LINES 3" EBD-14 & 6" EBD-14 ARE WITHIN THE IS1 EXAMINATION BOUNDARY. THE PIPING WELDS IN THESE LINES ARE SHOWN FOR REFERENCE PURPOSES ONLY. THESE WELDS MAY NOT BE REPRESENTED IN THE ACTUAL AS-BUILT CONDITION.
3. PIPING SYSTEMS ON THIS DRAWING WHICH ARE OUTSIDE OF THE IS1 BOUNDARY, ARE SHOWN FOR REFERENCE AND CONTINUITY PURPOSES ONLY. THE CONFIGURATION SHOWN MAY NOT REPRESENT THE ACTUAL AS-BUILT CONDITION.

**GENERAL NOTE**


DIMENSIONS SHOWN ON THIS DRAWING ARE TO BE USED FOR APPROXIMATE LOCATION ONLY. USE DESIGN DRAWINGS FOR DIMENSIONAL VERIFICATION.

**REFERENCE DRAWINGS:**

1S102-006D AUXILIARY FEEDWATER SYSTEM

NO.	DATE	REVISIONS	BY	CHK'D	ENGR.	DATE
SCALE: N.T.S.    REVISIONS    DRAWN: CB    DATE						
<b>DAVIS-BESSE NUCLEAR POWER STATION</b> UNIT NO. 1						
THE YUKON REGION COMPANY						
INSERVICE INSPECTION ISOMETRIC AUXILIARY FEEDWATER SYSTEM AUX. FEED PUMP DISCH. TO STEAM GENERATORS						
DRAWING NO.				REV.		
1S1M2-206F				1		
SHEET 4				1		

D-106

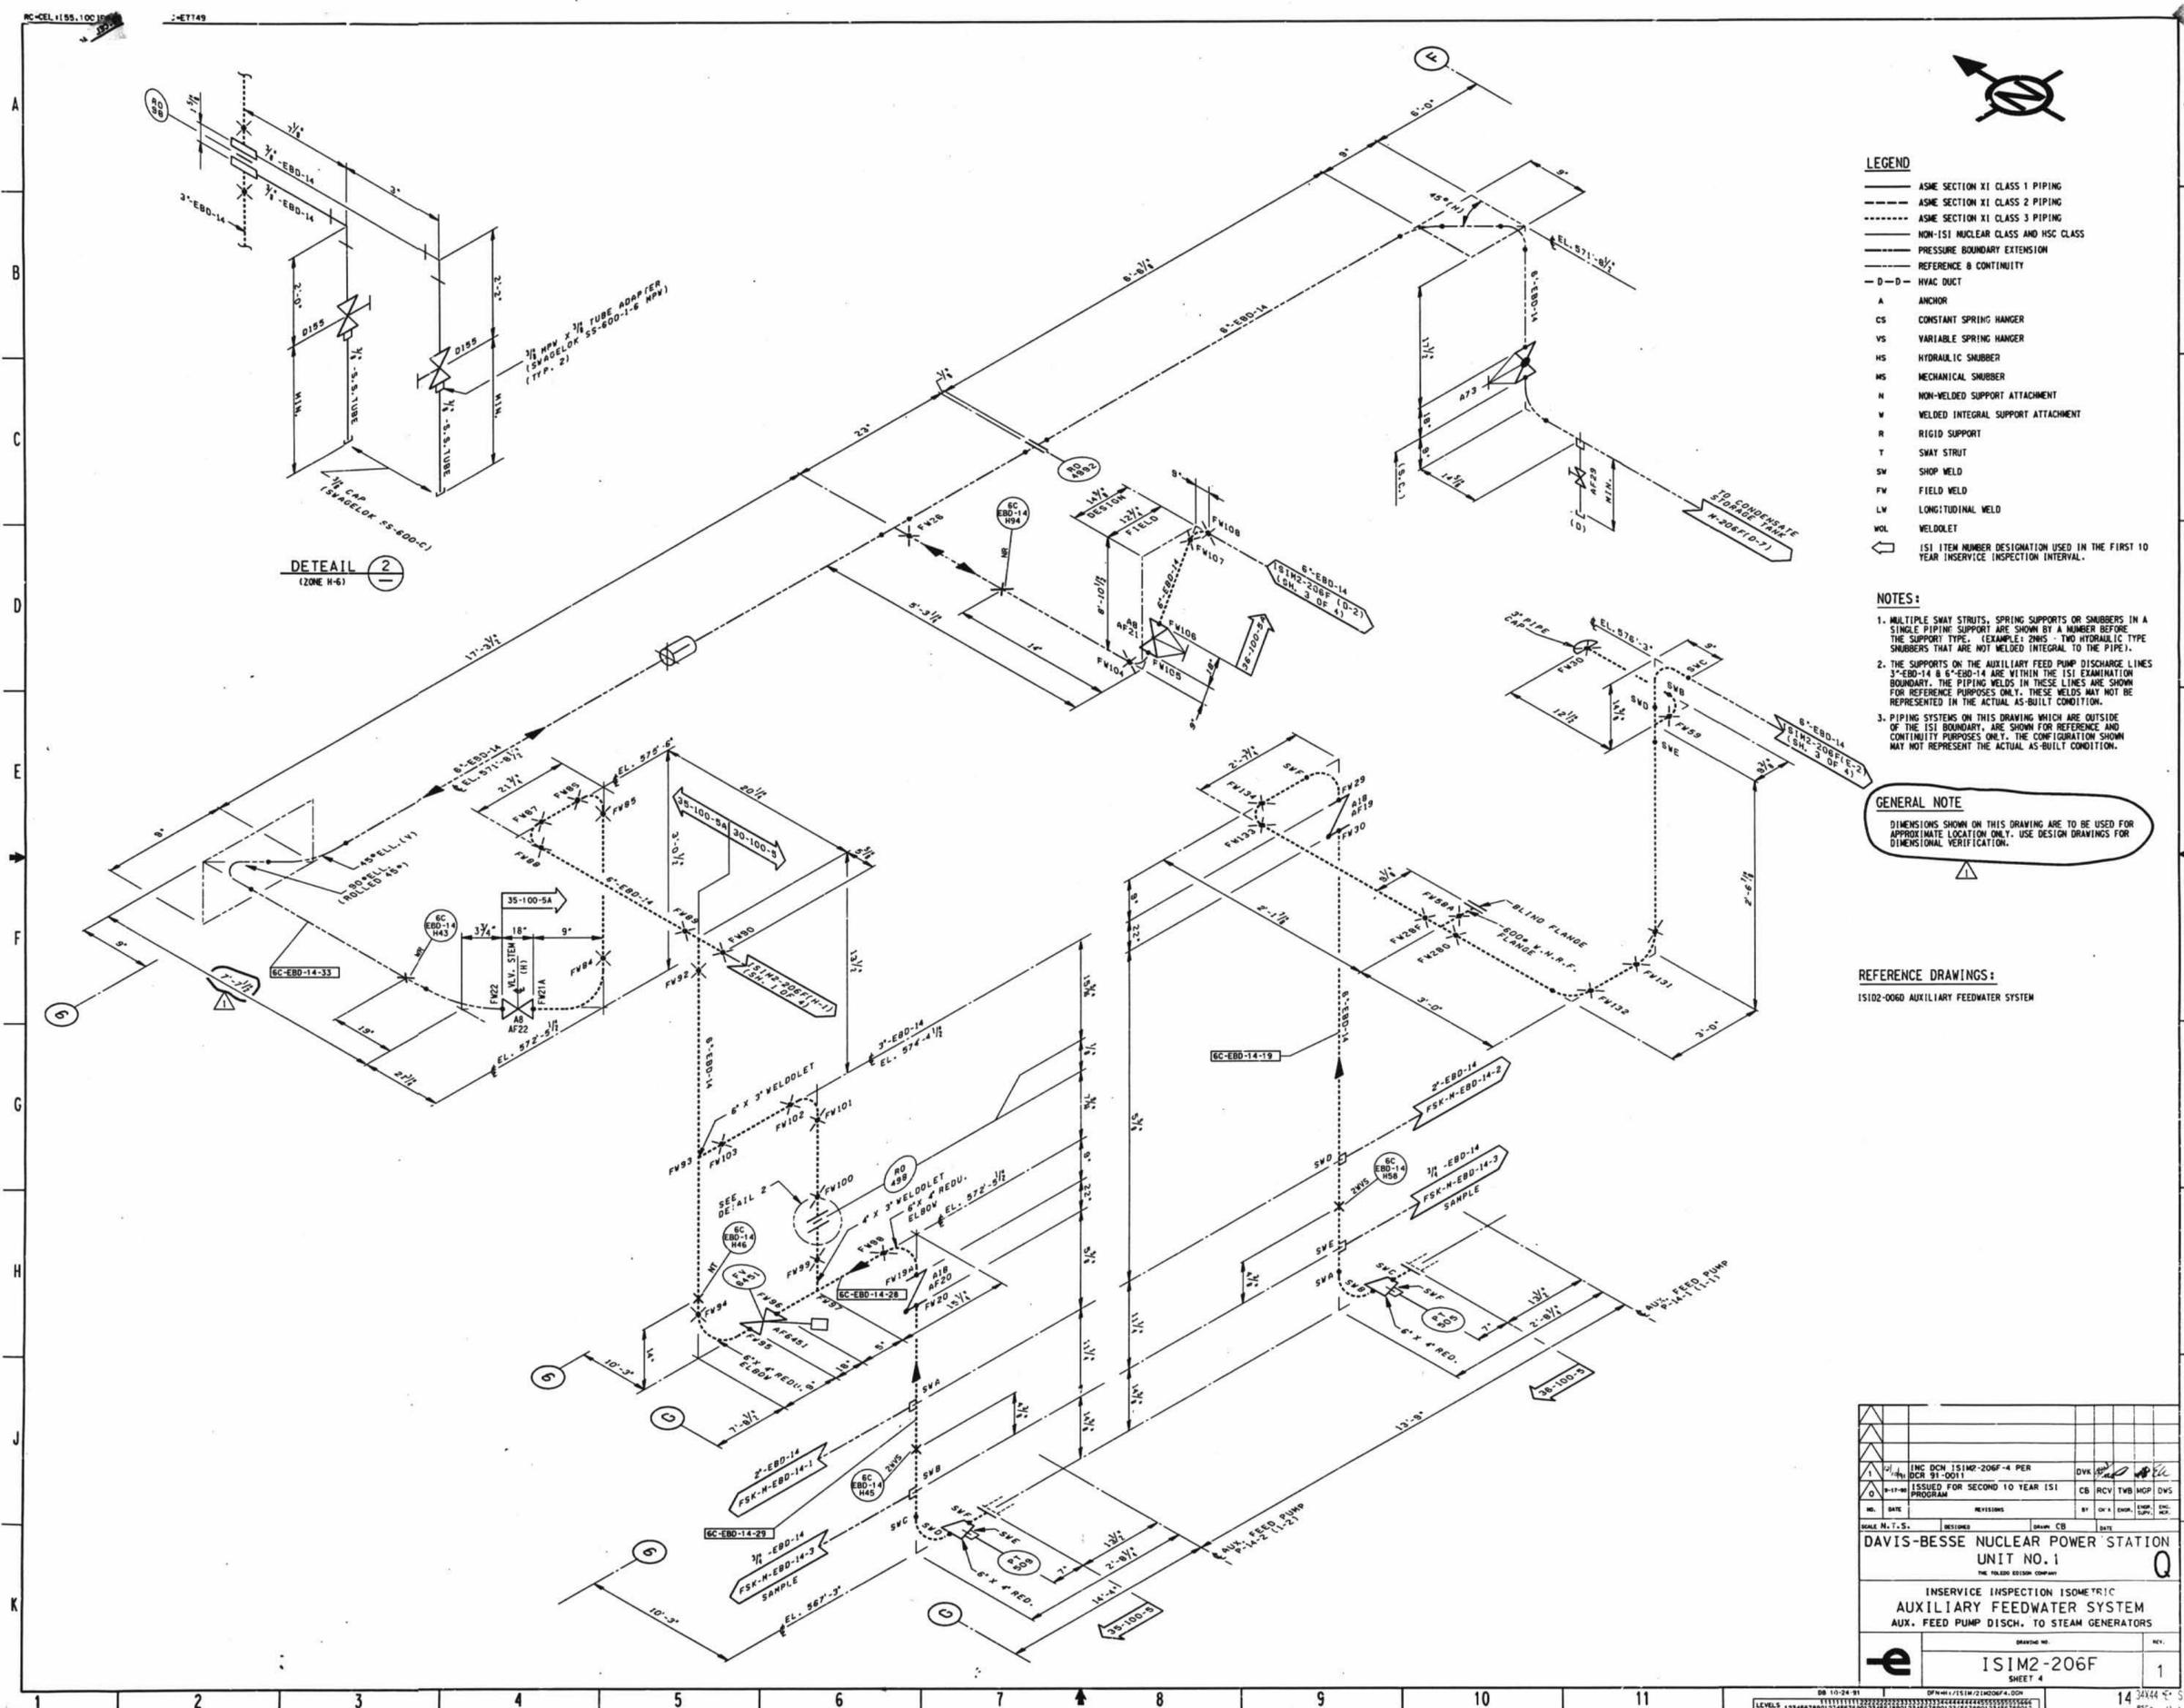

I CERTIFY THAT THE IMAGE CONTAINED IN THIS FILE IS AN ACCURATE REPRODUCTION OF THE ORIGINAL AND REGULAR COPY OF RECORDS, ON THE DATE STATED BELOW AND THAT IT IS AN ACCURATE REPRODUCTION OF THE RECORD(S).

DATE: 12-13-91 OPERATOR: [Signature] 30X