




**F**  
03 **5+00 N CROSS SECTION**  
HORIZONTAL SCALE: 1" = 100'  
VERTICAL SCALE: 1" = 10'

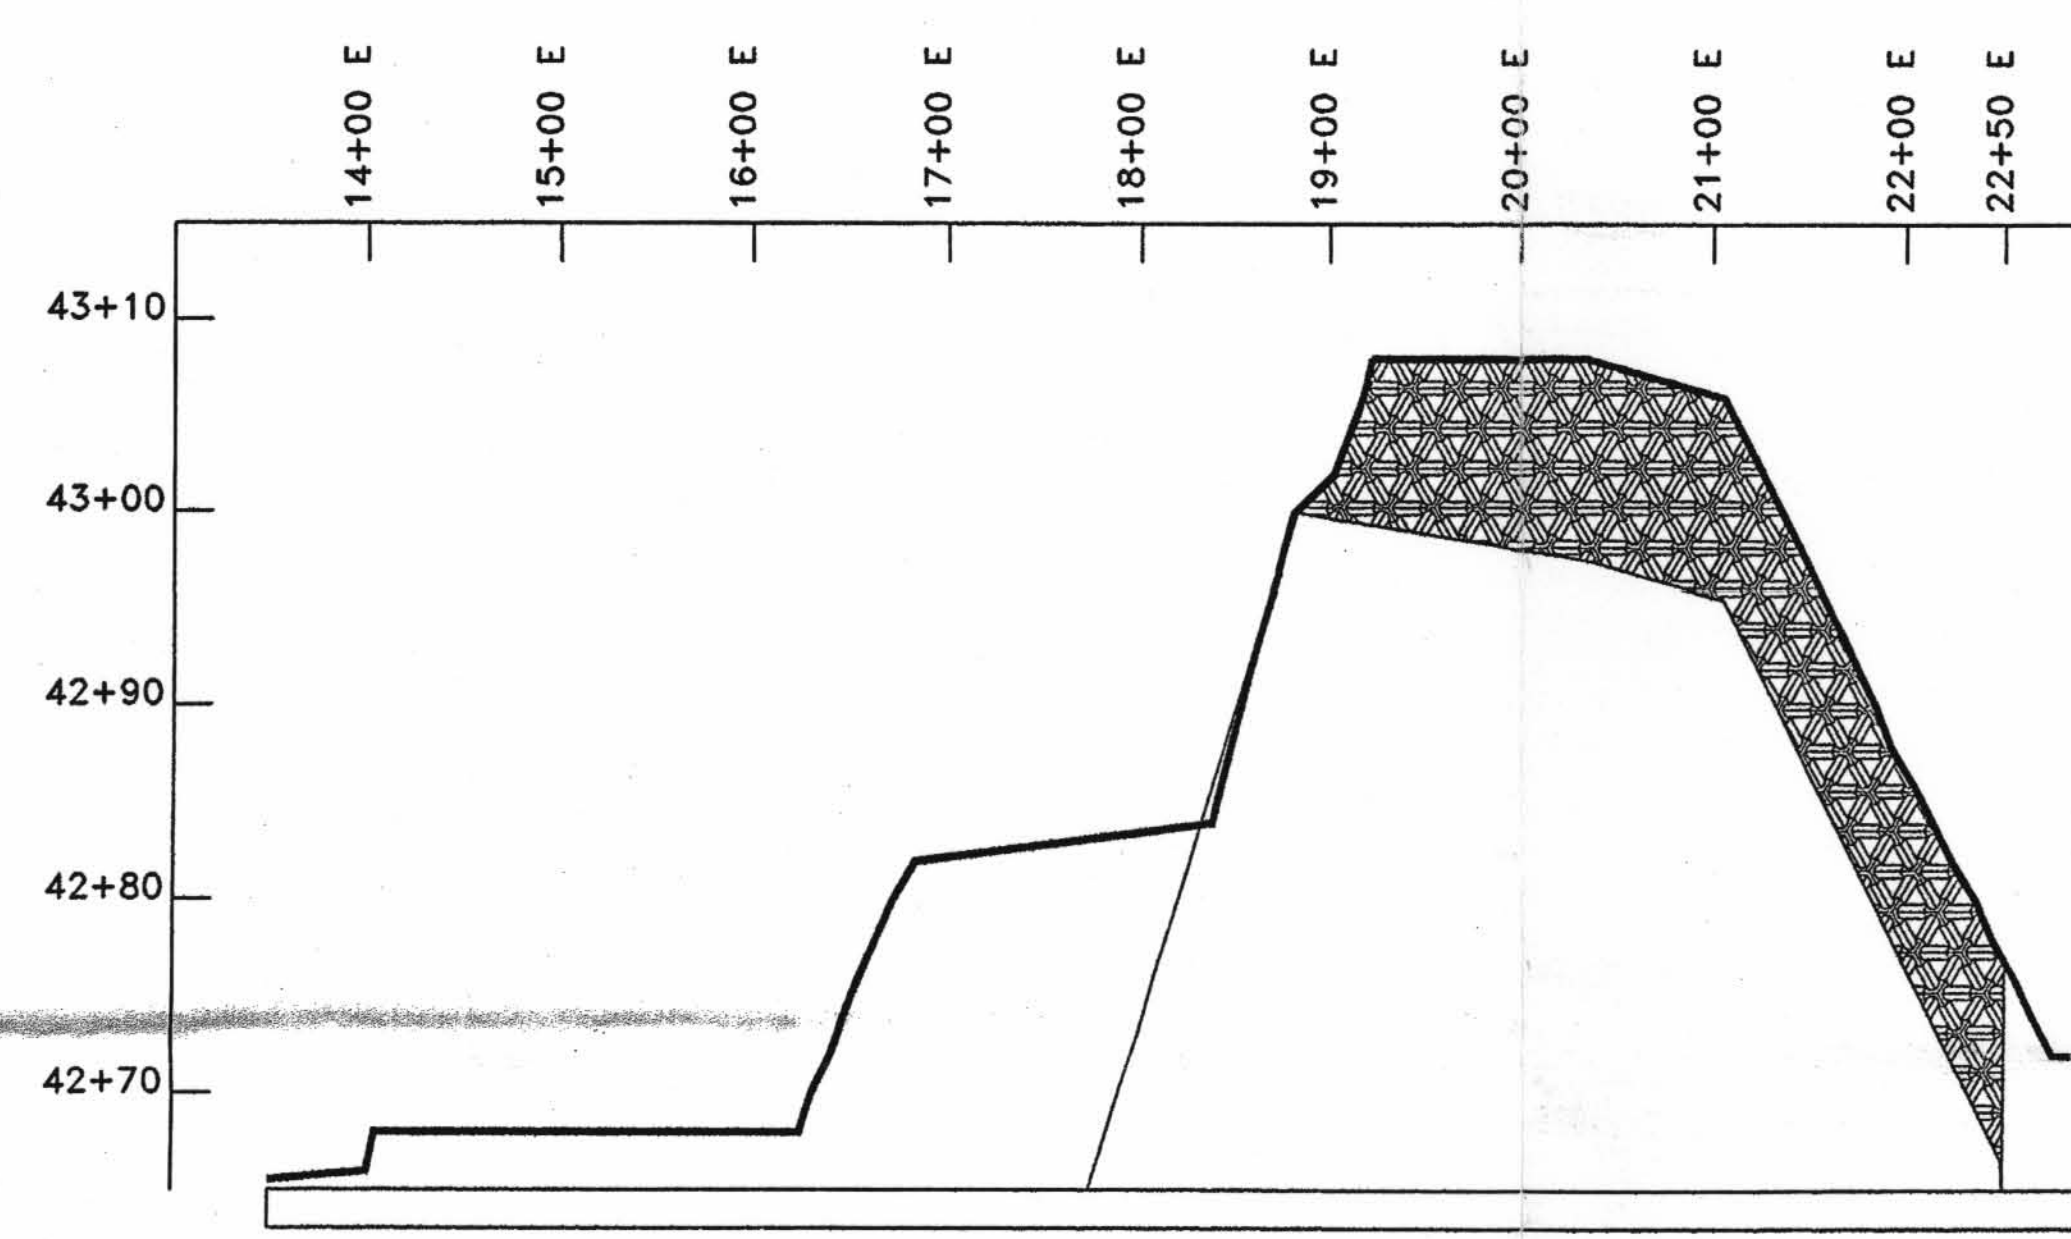



**H**  
03 **7+00 N CROSS SECTION**  
HORIZONTAL SCALE: 1" = 100'  
VERTICAL SCALE: 1" = 10'

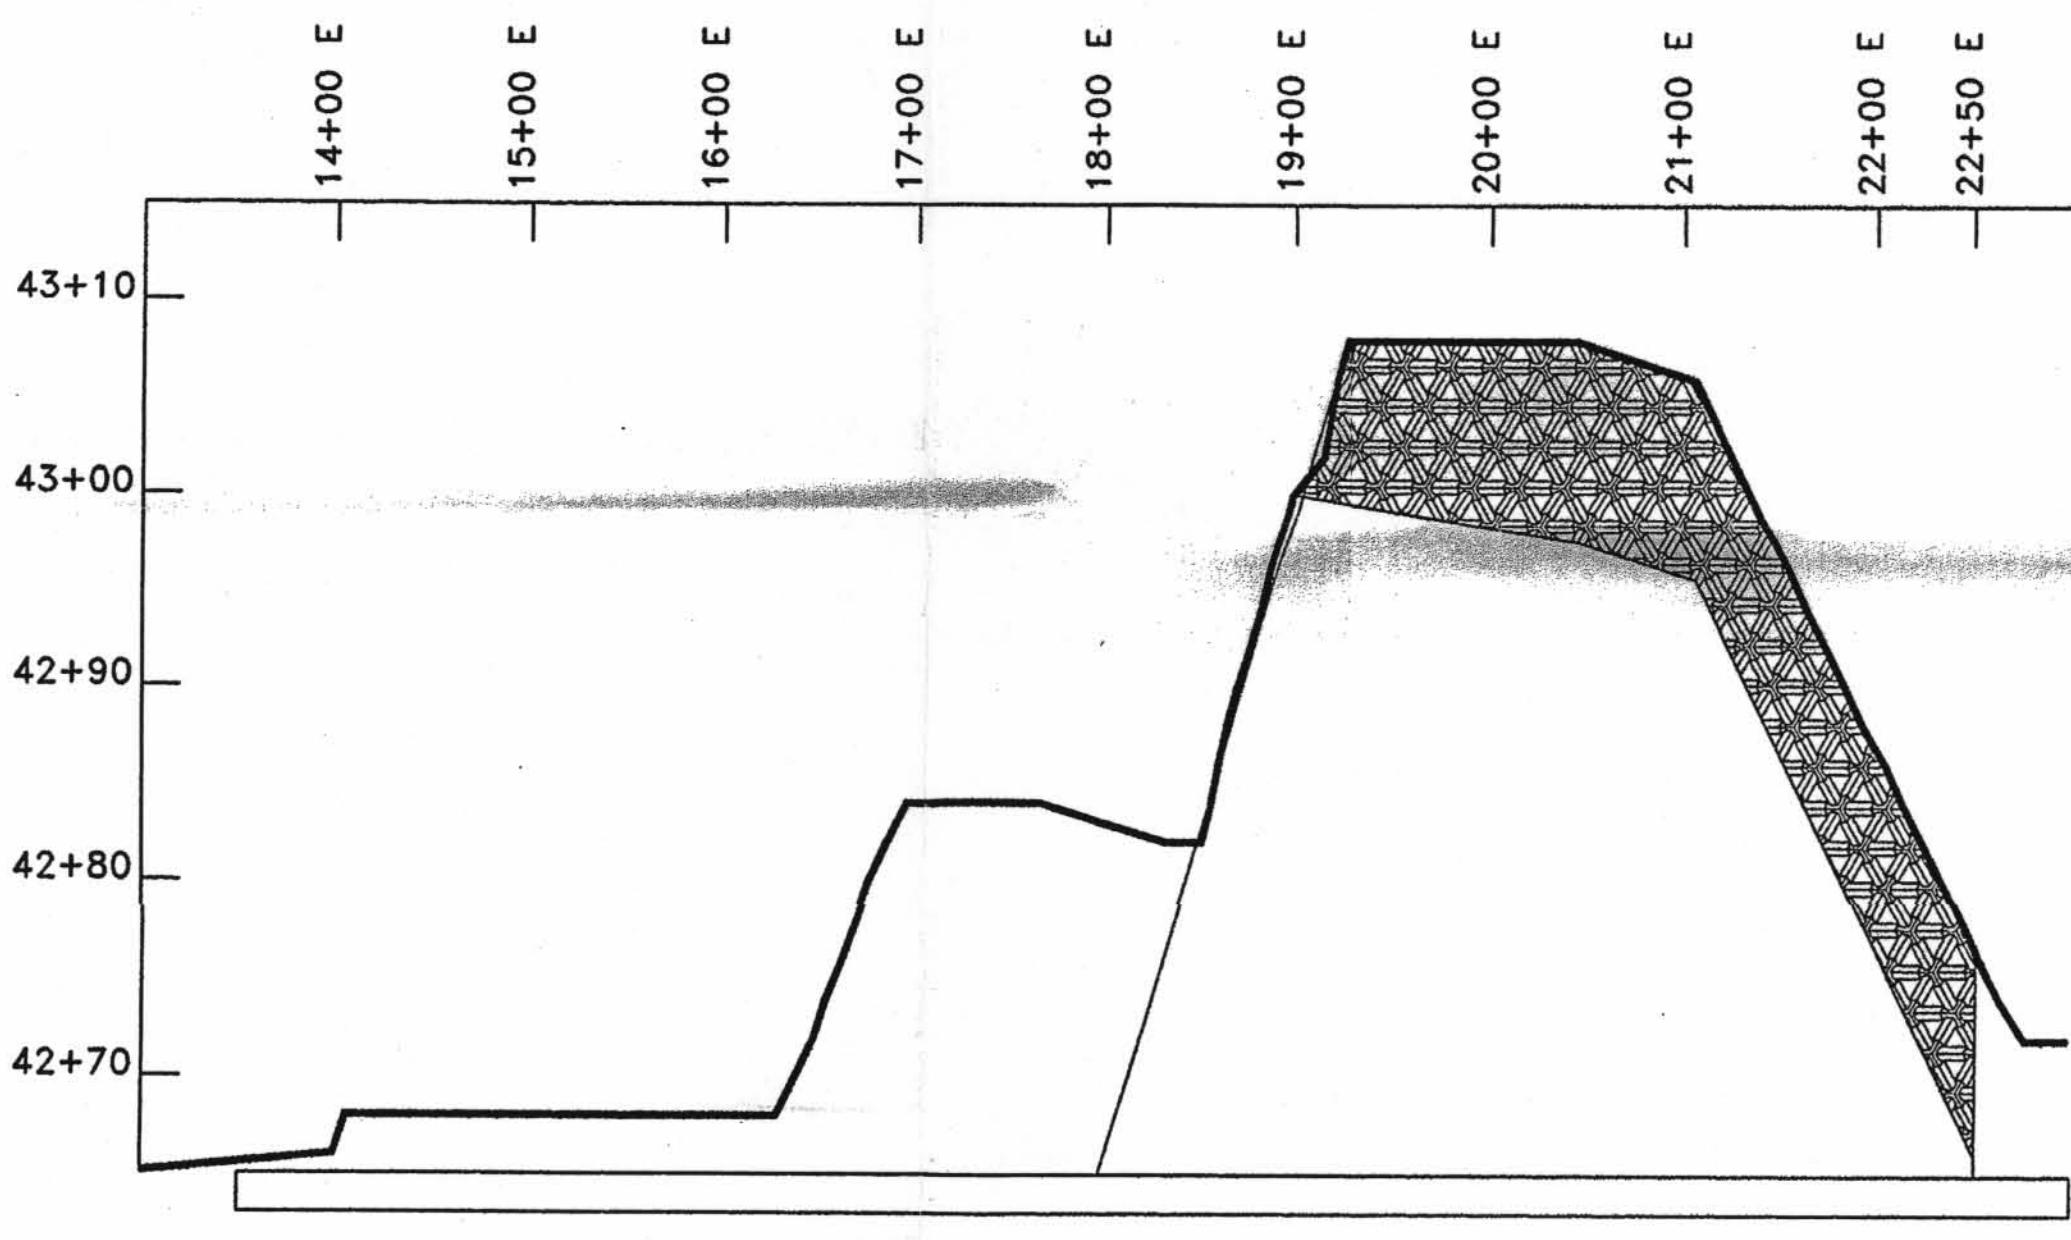


**G**  
03 **6+00 N CROSS SECTION**  
HORIZONTAL SCALE: 1" = 100'  
VERTICAL SCALE: 1" = 10'

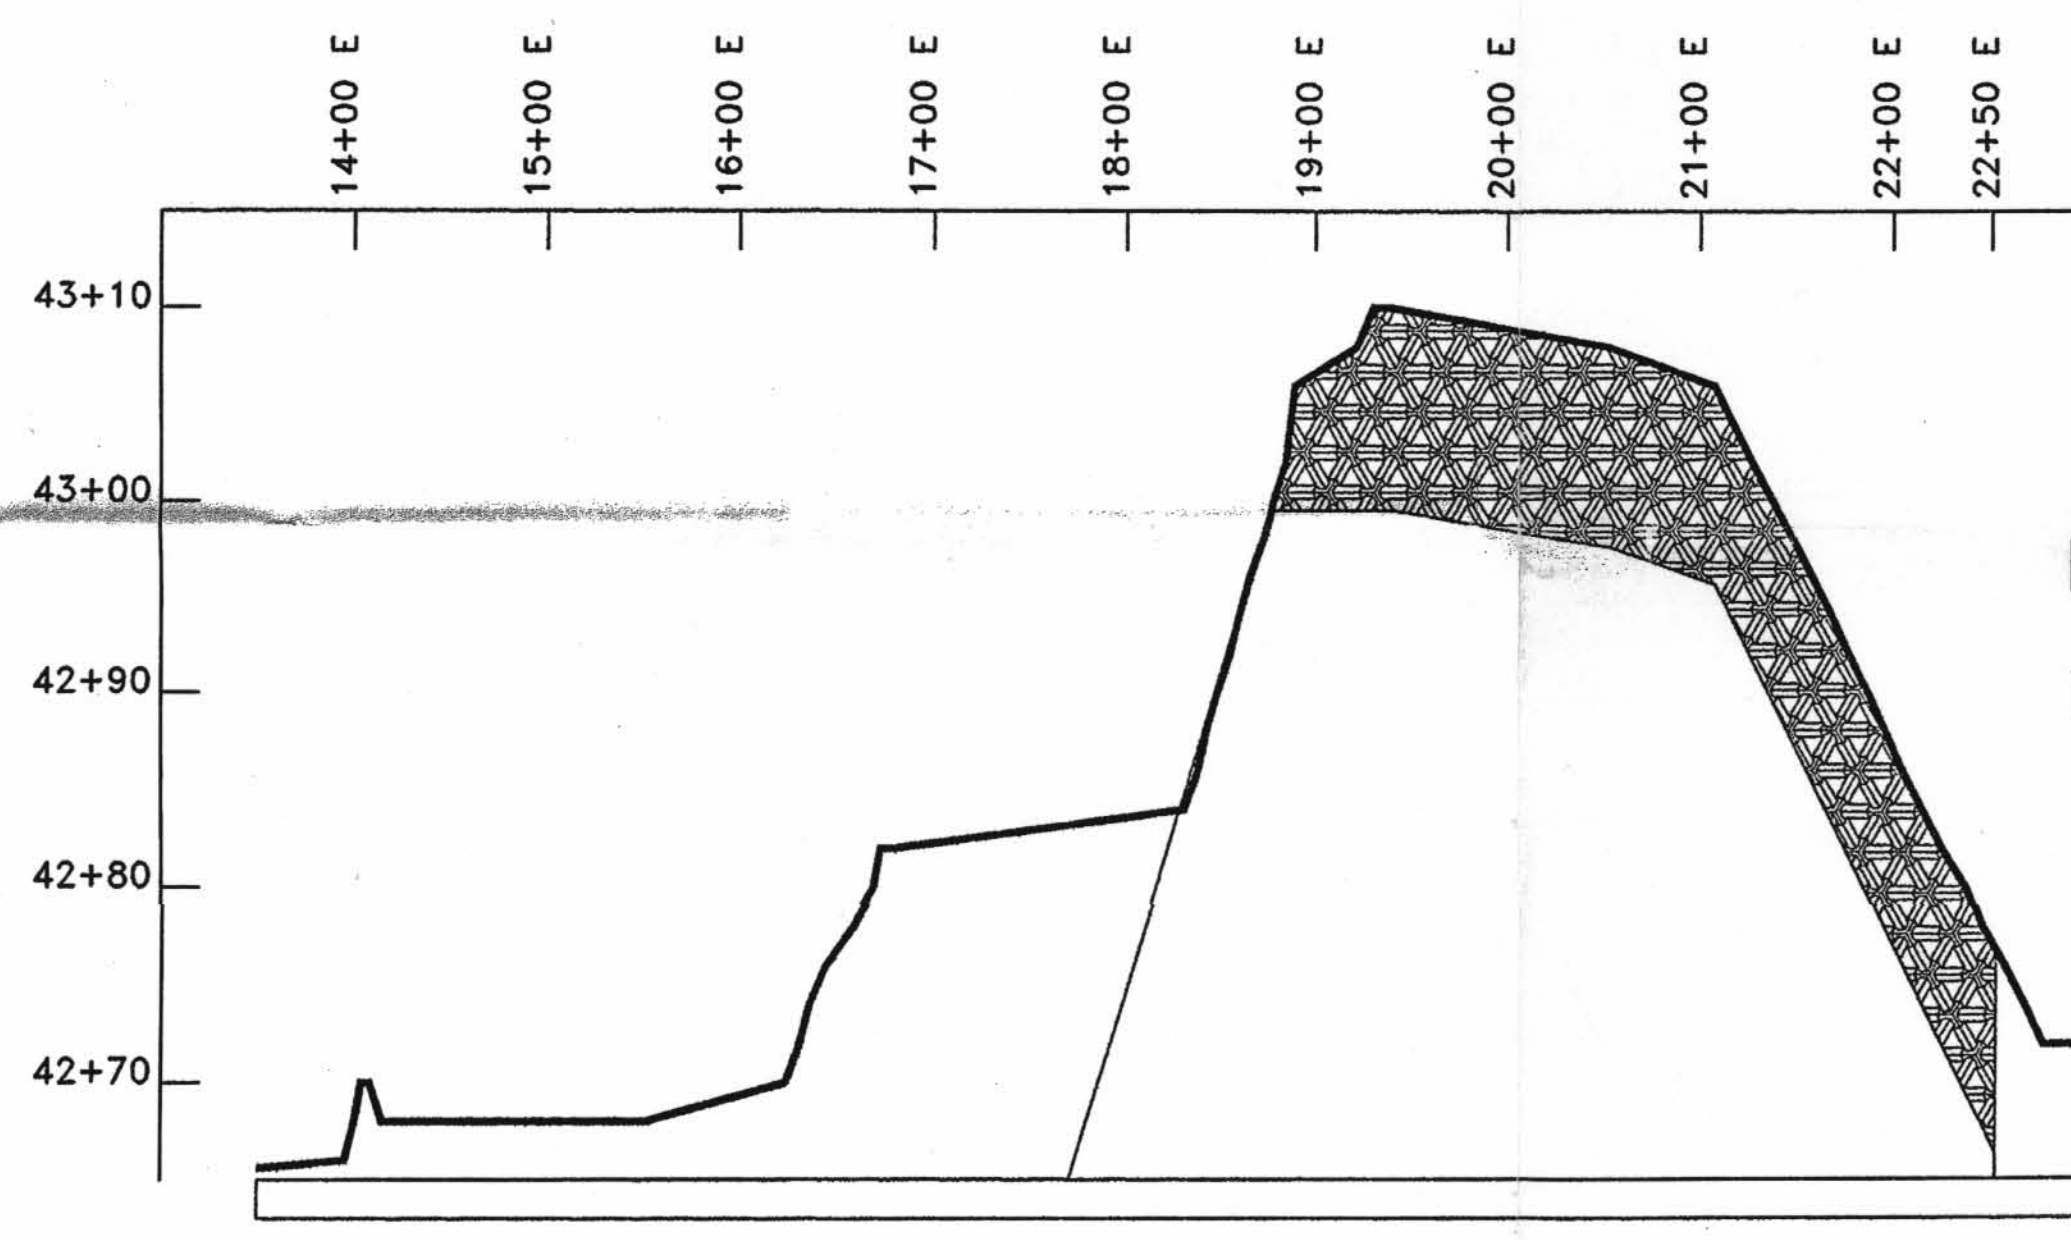


**I**  
03 **8+00 N CROSS SECTION**  
HORIZONTAL SCALE: 1" = 100'  
VERTICAL SCALE: 1" = 10'

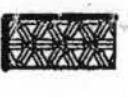**KEY:**  
 AREAS OF THE EMBANKMENT IN WHICH THE FINAL COVER HAS BEEN CONSTRUCTED. WASTE IN THESE AREAS HAS BEEN DISPOSED OF IN ACCORDANCE WITH THE FINISHED DESIGN REQUIREMENTS.  
 AREAS OF THE EMBANKMENT IN WHICH TEMPORARY COVER HAS BEEN CONSTRUCTED. WASTE IN THESE AREAS HAS BEEN DISPOSED OF IN ACCORDANCE WITH THE FINISHED DESIGN REQUIREMENTS.  
**NOTE:**  
 CONTOUR MAPS ARE BASED ON A SITE SURVEY PERFORMED BY AERO-GRAPHICS, INC. ON DECEMBER 18, 2000.

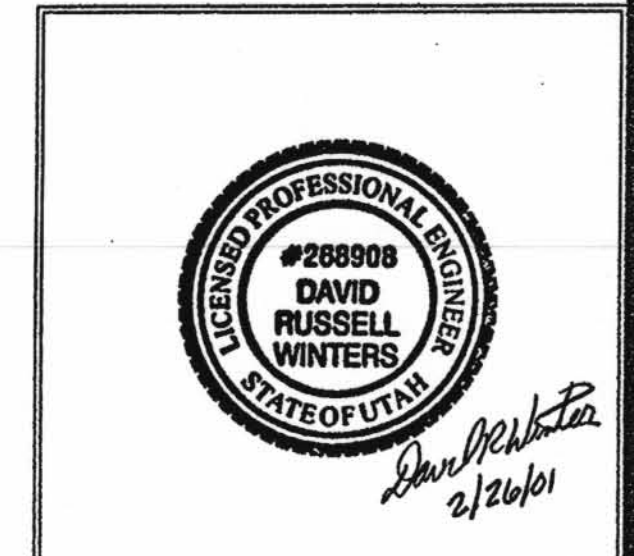

D-3

		PK: LUTZ DESIGNED BY: D. WINTERS	11e(2) DISPOSAL CELL ANNUAL AS-BUILT DRAWING CROSS SECTIONS CLIVE, UTAH	AS NOTED DATE: 02/15/01 0104-03	
DATE	INIT.	DESCRIPTION OF CHANGE			