




R 17+00 N CROSS SECTION
 HORIZONTAL SCALE: 1" = 100'
 VERTICAL SCALE: 1" = 10'

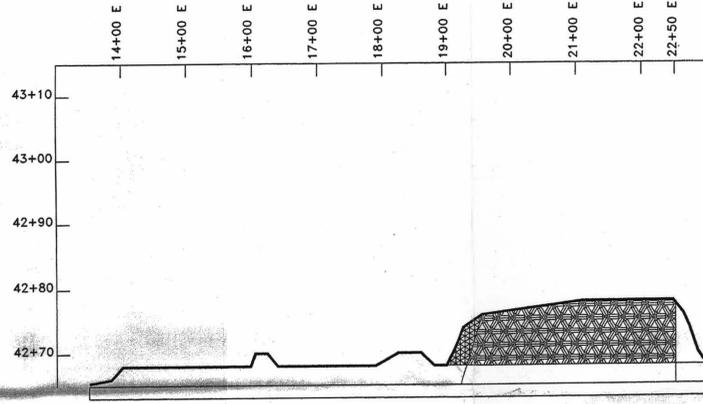

S 17+75 N CROSS SECTION
 HORIZONTAL SCALE: 1" = 100'
 VERTICAL SCALE: 1" = 10'

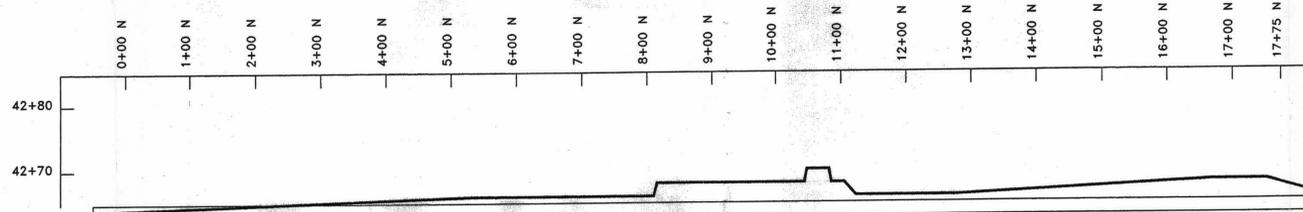


A-A 14+00 E CROSS SECTION
 HORIZONTAL SCALE: 1" = 100'
 VERTICAL SCALE: 1" = 10'

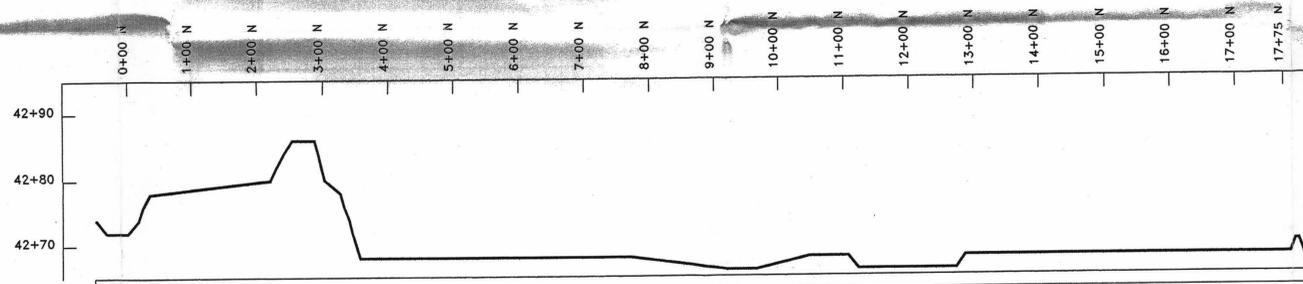

B-B 15+00 E CROSS SECTION
 HORIZONTAL SCALE: 1" = 100'
 VERTICAL SCALE: 1" = 10'

KEY:
 AREAS OF THE EMBANKMENT IN WHICH THE FINAL COVER HAS BEEN CONSTRUCTED. WASTE IN THESE AREAS HAS BEEN DISPOSED OF IN ACCORDANCE WITH THE FINISHED DESIGN REQUIREMENTS.
 AREAS OF THE EMBANKMENT IN WHICH TEMPORARY COVER HAS BEEN CONSTRUCTED. WASTE IN THESE AREAS HAS BEEN DISPOSED OF IN ACCORDANCE WITH THE FINISHED DESIGN REQUIREMENTS.
NOTE:
 CONTOUR MAPS ARE BASED ON A SITE SURVEY PERFORMED BY AERO-GRAPHICS, INC. ON DECEMBER 18, 2000.

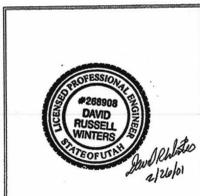

D-6

DATE	INIT.	DESCRIPTION OF CHANGE

ENVIROCARE
 OF UTAH, INC.
 THE SAFE ALTERNATIVE

DESIGNED BY K. LUTZ	PROJECT 11e(2) DISPOSAL CELL
DRAWN BY D. WINTERS	ANNUAL AS-BUILT DRAWING
	CROSS SECTIONS
	CLIVE, UTAH

DATE AS NOTED	DATE 02/15/01
PROJECT NO. 0104-06	