



E-E 18+00 E CROSS SECTION
 HORIZONTAL SCALE: 1" = 100'
 VERTICAL SCALE: 1" = 10'

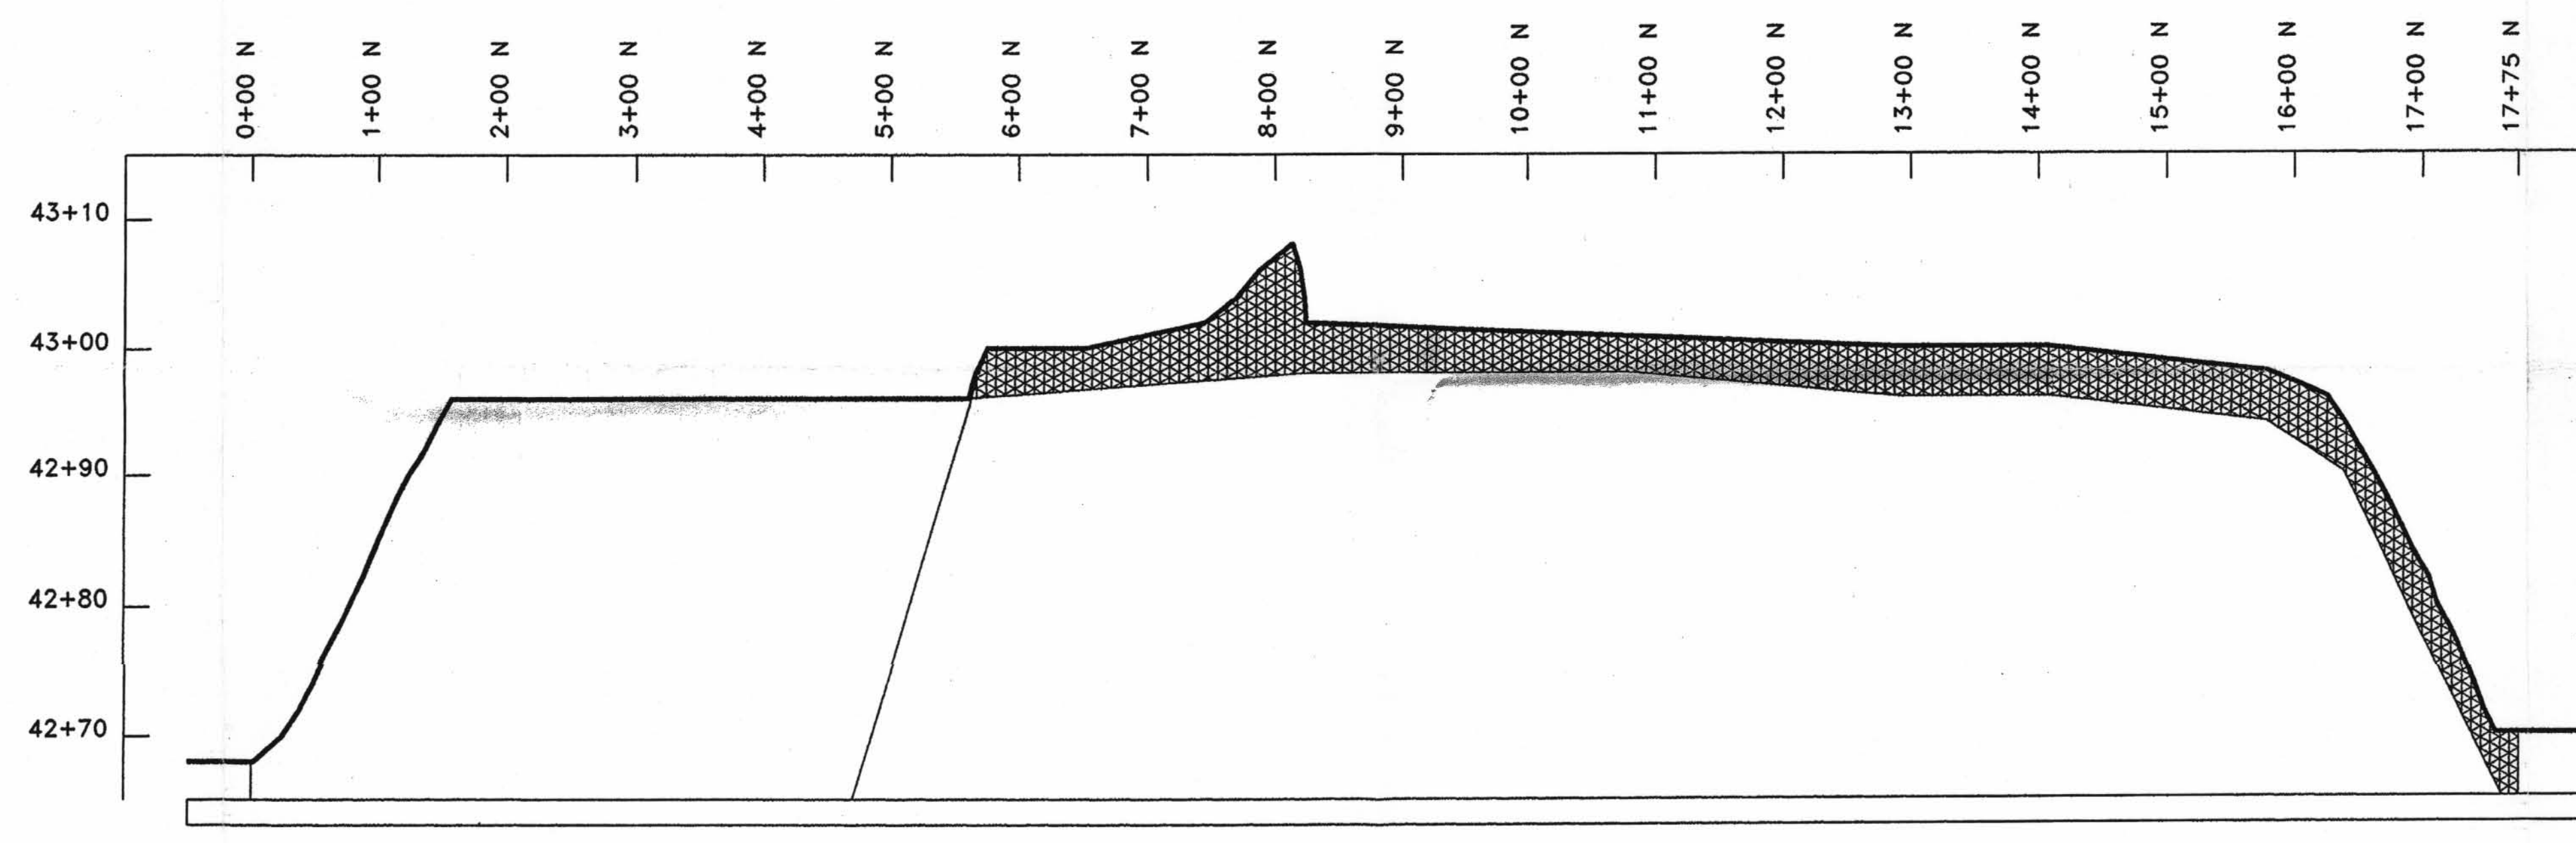

F-F 19+00 E CROSS SECTION
 HORIZONTAL SCALE: 1" = 100'
 VERTICAL SCALE: 1" = 10'

KEY:
 AREAS OF THE EMBANKMENT IN WHICH THE FINAL COVER HAS BEEN CONSTRUCTED. WASTE IN THESE AREAS HAS BEEN DISPOSED OF IN ACCORDANCE WITH THE FINISHED DESIGN REQUIREMENTS.
 AREAS OF THE EMBANKMENT IN WHICH TEMPORARY COVER HAS BEEN CONSTRUCTED. WASTE IN THESE AREAS HAS BEEN DISPOSED OF IN ACCORDANCE WITH THE FINISHED DESIGN REQUIREMENTS.
NOTE:
 CONTOUR MAPS ARE BASED ON A SITE SURVEY PERFORMED BY AERO-GRAPHICS, INC. ON DECEMBER 18, 2000.

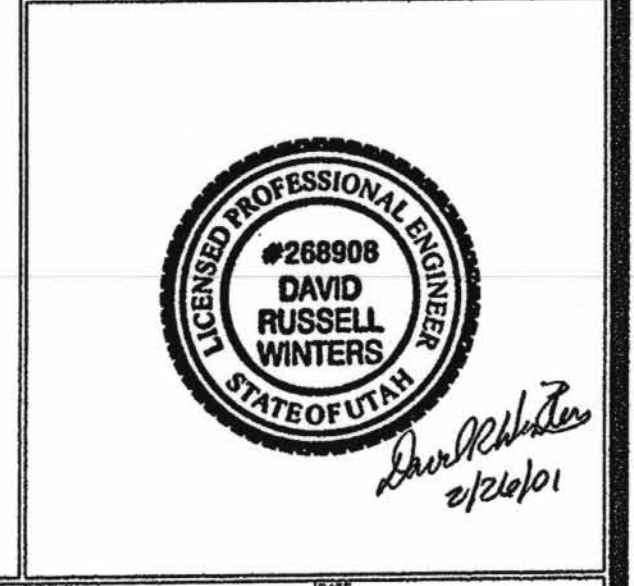

D-8

| | | | | | |
|-------------------------------------|--|--------------------------|---|------------------------|------------------|
| DATE INIT. DESCRIPTION OF CHANGE | ENVIROCARE OF UTAH, INC. THE SAFE ALTERNATIVE | DRAWN BY K. LUTZ | PROJECT NO. 11e(2) DISPOSAL CELL | DATE AS NOTED | DATE 02/15/01 |
| | | CHECKED BY D. WINTERS | DRAWING TITLE ANNUAL AS-BUILT DRAWING CROSS SECTIONS CLIVE, UTAH | DRAWING NO. 0104-08 | |