


E-E 18+00 E CROSS SECTION
 HORIZONTAL SCALE: 1" = 100'
 VERTICAL SCALE: 1" = 10'

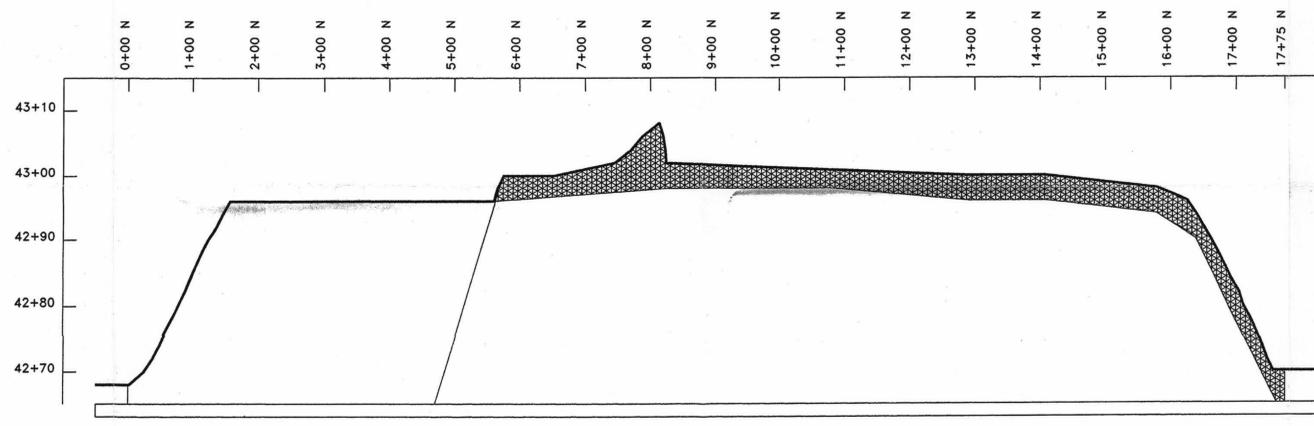

F-F 19+00 E CROSS SECTION
 HORIZONTAL SCALE: 1" = 100'
 VERTICAL SCALE: 1" = 10'

KEY:
 AREAS OF THE EMBANKMENT IN WHICH THE FINAL COVER HAS BEEN CONSTRUCTED. WASTE IN THESE AREAS HAS BEEN DISPOSED OF IN ACCORDANCE WITH THE FINISHED DESIGN REQUIREMENTS.
 AREAS OF THE EMBANKMENT IN WHICH TEMPORARY COVER HAS BEEN CONSTRUCTED. WASTE IN THESE AREAS HAS BEEN DISPOSED OF IN ACCORDANCE WITH THE FINISHED DESIGN REQUIREMENTS.
NOTE:
 CONTOUR MAPS ARE BASED ON A SITE SURVEY PERFORMED BY AERO-GRAPHICS, INC. ON DECEMBER 18, 2000.

D-8



DATE INIT DESCRIPTION OF CHANGE	ENVIROCARE OF UTAH, INC. THE SAFE ALTERNATIVE	DRAWN BY: K. LUTZ	PROJECT: 11e(2) DISPOSAL CELL	DATE: AS NOTED	DATE: 02/15/01
		CHECKED BY: D. WINTERS	DRAWING: ANNUAL AS-BUILT DRAWING	0104-08	
			CROSS SECTIONS		
			CLIVE, UTAH		