


- NOTES:**
1. FIELD WELDS REFERENCED TO THIS NOTE ARE TO BE MADE AFTER PIPE IS CUT, PREALIGNED & ENDS HAVE BEEN PREPARED FOR WELDING TO SUIT AS BUILT CPU.
 2. SPOOL TO BE FABRICATED WITH 6" EXTRA PIPE AND PLAIN END TO FACILITATE INSTALLATION.
 3. USE CRANE 425A COMPOUND OR GRINNELL 1698 ON ALL THREADED CONNS.
 4. WELD PROCEDURE AS FOLLOWS:
 C/3 2 1/2" & UNDER - C3-6
 C/3 3" & OVER UP TO 3/4" WALL - C3-1 OR C3-2
 3/4" WALL & UP - C3-5

ISO SHT. NO. 1703

QSL	ITEM	QTY	SIZE	MATERIAL DESCRIPTION	TAG No. OR ASTM MATL.	HEAT NO.
01	1	1	2 1/2"	125# C.I. FLGD. GATE VA	12GF25RE	
	2	2	2 1/2"	1/4" THK. FULL FACE COMP. ASBESTOS RUBBER BONDED GASKET.		
	3	8	3/8"	3 LG. HEX. HD. MACH. BOLT	A-307 GR. B	
	4	8	5/8"	HEAVY HEX. NUT CL. 2 TOL.	A-307 GR. B	
	5	1	1 1/2"	150# R.F.S.W. FLG.	A-181 GR. I OR II	
	6	4	3/4"	2 1/2 LG. HEX. HD. MACH. BOLT	A-307 GR. B	
	7	4	1/2"	HEAVY HEX. NUT CL. 2 TOL.	A-307 GR. B	
	8	1	1 1/2"	1/4" THK. FULL FACE COMP. ASBESTOS RUBBER BONDED GASKET		
	9	1	1 1/2"	3000# C.S. S.W. 90° ELL.	A-181 GR. I OR II	
	10	AS REQD	1 1/2"	PIPE (SCH. 80) SMLS. C.S.	A-106 GR. B	
	11	1	1"	200# THD GLOBE VALVE OR BRASS	Y100T23	
	12	1	1"	3000# SW C.S. ELBOLET	A-181 GR. I OR II	
	13	1	1"	3000# THD C.S. CAP	A-181 GR. I OR II	
	14	AS REQD	1"	PIPE (SCH. 80) SMLS C.S.	A-106 GR. B	

REVISION RECORD

NO.	DATE	BY	CHK	DESCRIPTION	REMARKS
1	3.20.73	JR	LR	REVISED BY N.P.S. DESIGNS. ADDED ITEM'S 11 THRU 14 TO B/M, LIVSEY SPOOL 1-NSW-176-DWG 1-5702 REV. 7	FIELD ACTION REQ'D
2	8.10.73	JR	FW	REVISED BY N.P.S. DESIGNS. REVISED P.C.MKS 1-NSW-176-3, 4, 5 & 6. DELETED PT. 275. PT. 250-12-55-55-4. PT. 262-36-29-54-16. EL. 619'-3". EL. 623'-3". 2 1/2" DIM. 20 1/16". 4.45" V. 7.5" T.L. 5'-2 1/2" DIM. 4.53" H. 38" 22". 52'-9 1/2" H. 1 3/4" WAS 7 1/8" PER AS-BUILT DIM'S. A.E.P. ARRGT. DWG. 1-5702 REV. 7	NO ACTION REQ'D

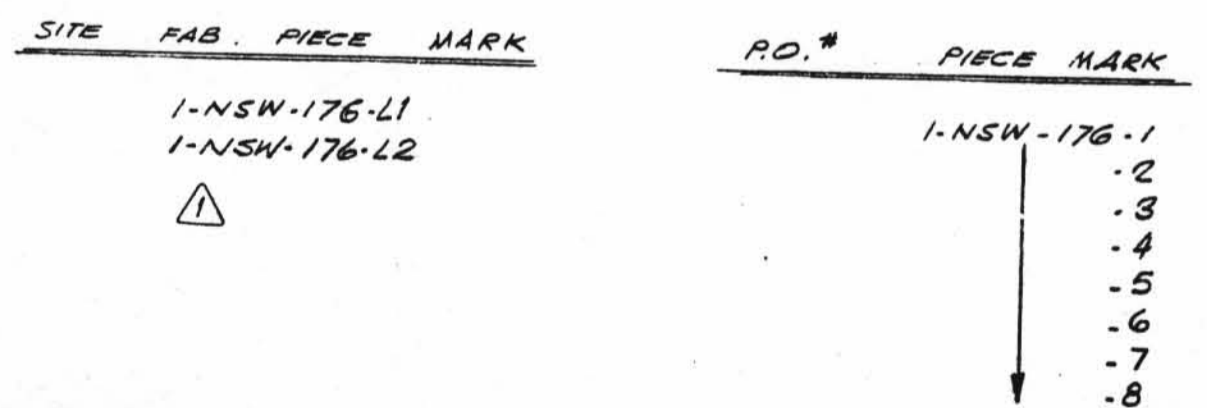

SIZE	QTY	TW
4"	-	1
2 1/2"	53	6
1 1/2"	2	1
1"	1	2

DESIGN SPEC.		SEE		S.P. - WORKING POINT		B.B.E. - BEVEL BOTH ENDS		P.W. - FIELD WELD		B. - FIELD WELD				
HANGER SEISMIC CLASS	I	DESIGN		T.O.E. - TYPED ONE END		P.O.E. - PLAIN ONE END		H - HORIZONTAL		O - AUTOMATIC SHOP WELD				
TEST REQUIREMENTS	CODE	CODE		T.B.E. - TYPED BOTH ENDS		P.B.E. - PLAIN BOTH ENDS		V - VERTICAL		S - MANUAL SHOP WELD				
WELD PROCEDURE	SEE NOTE 4	CODE		B.O.E. - BEVEL ONE END		S.O.E. - SHAPE ONE END		SW - SHOP WELD		F - VERIFY DIMENSION IN FIELD				
QSL - 02	TESTING 100% RT. B.W.	STAMP		T.O.P. - TOP OF PIPE ELEV.		B.O.P. - BOTTOM OF PIPE ELEV.		FW - FIELD WELD						
PIPE		FITTINGS		TESTING		ADDITIONAL								
A-53	A-106	A-375	A-312	A-105	A-234	A-182	N.D.T. SEE DESIGN CODE STAMP							
STD.	XY	XXY	10	20	30	40	60	80	100	120	140	160		
SMLS	WLD													
				PRESSURE TEST										
				MED.		PRESS.		DURATION						

POUR/ZONE No. 1C6 FLOW DIAGRAM I-E-SHA A
 REQUIRED COMPLETION DATE _____ O.S.L. SEE DESIGN
 FABRICATED BY TUBECO WELD PROCEDURE CODE STAMP

NPS DESIGNS INC.
 NEW YORK, N.Y.

LIVSEY & COMPANY, INC.
 INDIANA & MICHIGAN ELECTRIC CO.
 DONALD C. COOK NUCLEAR PLANT

FABRICATOR NOTE:
 FABRICATION MUST CONFORM TO LATEST A.E.P. ARRGT. DWGS.

DWN: S.G. DATE: 1-5-73 CONTAINMENT BLDG
 CKD: WP DATE: 7-2-73 DWG. NO. 1-NSW-176
 ISSUED REV. 2
 REF. DWG. 1-5702