



**LEGEND**

- ASME SECTION XI CLASS 1 PIPING
- - - ASME SECTION XI CLASS 2 PIPING
- ..... ASME SECTION XI CLASS 3 PIPING
- NON-ISI NUCLEAR CLASS AND HSC CLASS
- PRESSURE BOUNDARY EXTENSION
- REFERENCE & CONTINUITY
- D - D - HYDRAULIC DUCT
- A ANCHOR
- CS CONSTANT SPRING HANGER
- VS VARIABLE SPRING HANGER
- HS HYDRAULIC SNUBBER
- MS MECHANICAL SNUBBER
- N NON-WELDED SUPPORT ATTACHMENT
- W WELDED INTEGRAL SUPPORT ATTACHMENT
- R RIGID SUPPORT
- T SWAY STRUT
- SW SHOP WELD
- FW FIELD WELD
- LW LONGITUDINAL WELD
- WOL WELDOLET
- ◁ ISI ITEM NUMBER DESIGNATION USED IN THE FIRST 10 YEAR INSERVICE INSPECTION INTERVAL.

**NOTES:**


1. MULTIPLE SWAY STRUTS, SPRING SUPPORTS OR SNUBBERS IN A SINGLE PIPING SUPPORT ARE SHOWN BY A NUMBER BEFORE THE SUPPORT TYPE. (EXAMPLE: PMS - TWO HYDRAULIC TYPE SNUBBERS THAT ARE NOT WELDED INTEGRAL TO THE PIPE.)
2. PIPING SYSTEMS ON THIS DRAWING WHICH ARE OUTSIDE OF THE ISI BOUNDARY, ARE SHOWN FOR REFERENCE AND CONTINUITY PURPOSES ONLY. THE CONFIGURATION SHOWN MAY NOT REPRESENT THE ACTUAL AS-BUILT CONDITION.
3. FOR ISI PURPOSES, FLOW IS OUT OF CONTAINMENT.
4. THE LOW PRESSURE INJECTION LINE B-HCB-9 WELDS AND SUPPORTS ARE EXEMPT FROM INSERVICE EXAMINATION REQUIREMENTS PER 100.1220. THE WELDS AND SUPPORTS SHOWN MAY NOT REPRESENT THE ACTUAL AS-BUILT CONDITION.

**GENERAL NOTE:**

DIMENSIONS SHOWN ON THIS DRAWING ARE TO BE USED FOR APPROXIMATE LOCATION ONLY. USE DESIGN DRAWINGS FOR DIMENSIONAL VERIFICATION.

**REFERENCE DRAWINGS:**

15102-033B DECAT FUEL TRAIN 1

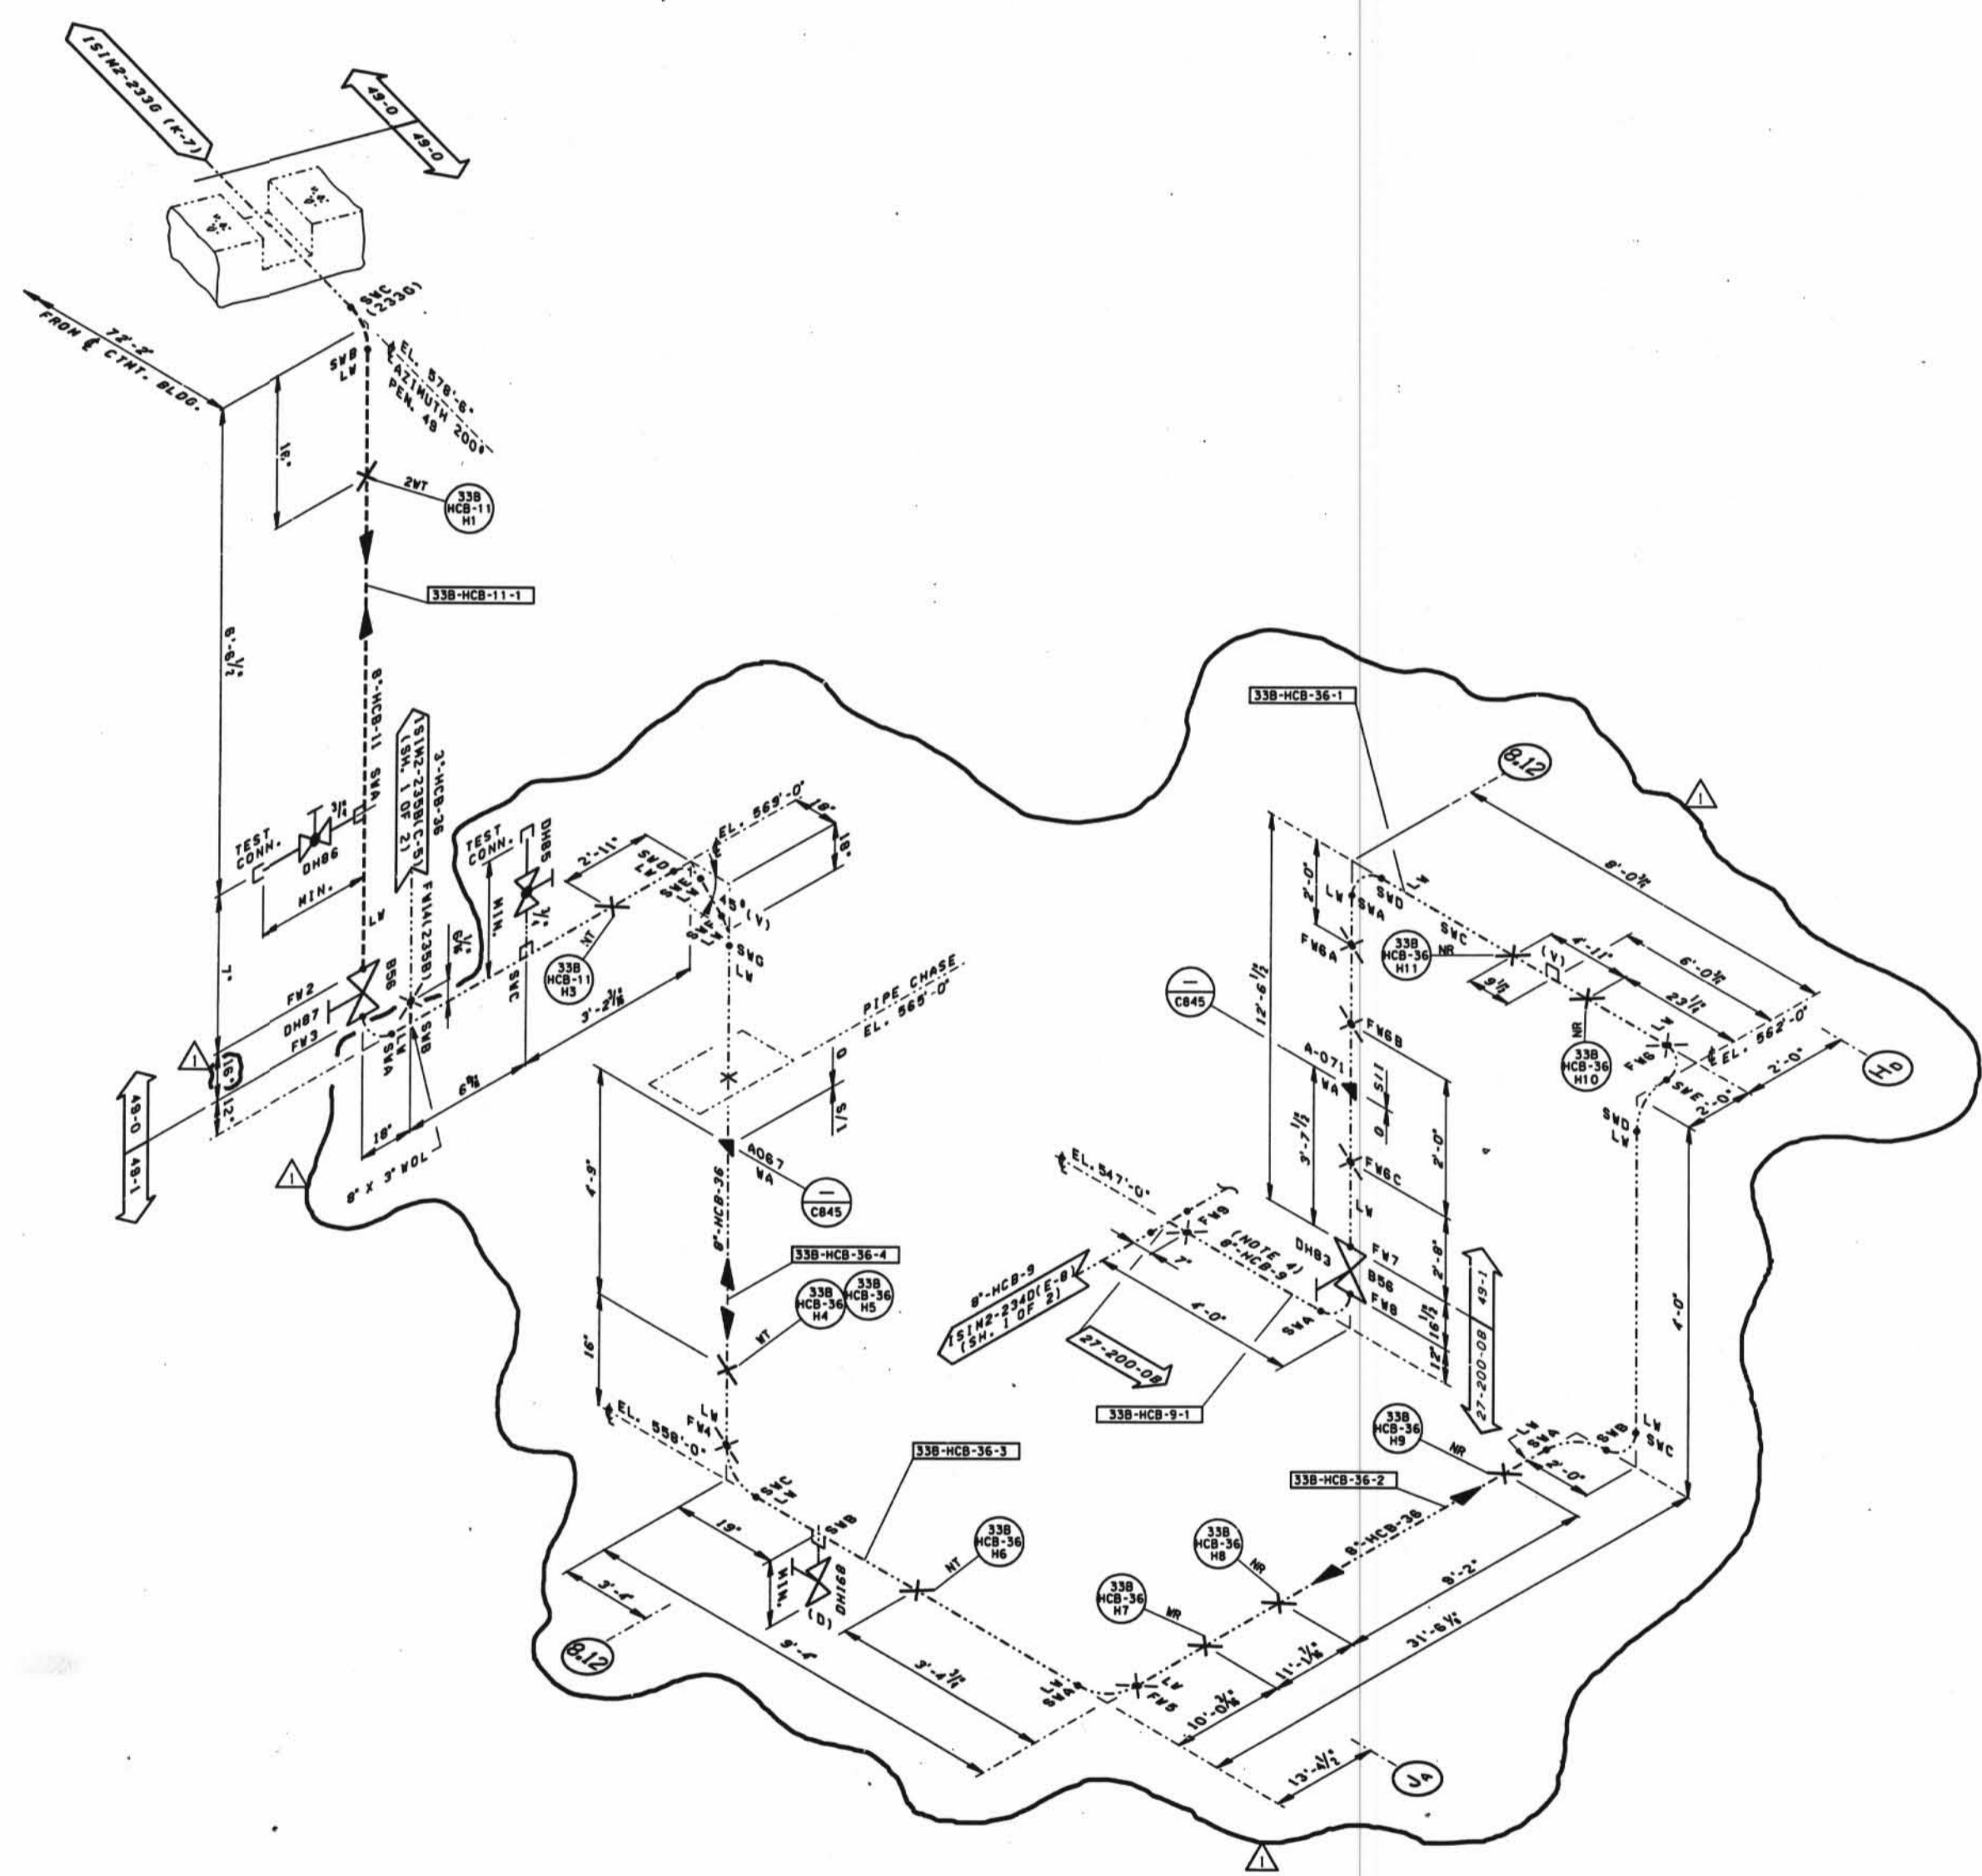

D-091

NO.	REV.	DATE	BY	CHKD.	APP.
1					
INC. DCN'S 15102-233F-4 & 6 FOR DER 81-0011 GEN. UPDATE 4-88 LEADER DIT FROM JUNE 73 DER B CORRECT 6'-0\"/>					
ISSUED FOR SECOND 10 YEAR ISI PROGRAM					
DAVIS-BESSE NUCLEAR POWER STATION UNIT NO. 1			CB EFB LLC MDP ECC		
INSERVICE INSPECTION ISOMETRIC LOW PRESSURE INJECTION SYSTEM AUXILIARY BUILDING					
ISIM2-233F SMT. 3					1