



LEGEND

- ASME SECTION XI CLASS 1 PIPING
- - - ASME SECTION XI CLASS 2 PIPING
- ..... ASME SECTION XI CLASS 3 PIPING
- ..... NON-151 NUCLEAR CLASS AND HSC CLASS
- PRESSURE BOUNDARY EXTENSION
- REFERENCE B CONTINUITY
- D - D HVAC DUCT
- A ANCHOR
- CS CONSTANT SPRING HANGER
- VS VARIABLE SPRING HANGER
- HS HYDRAULIC SHUBBER
- MS MECHANICAL SHUBBER
- N NON-WELDED SUPPORT ATTACHMENT
- W WELDED INTEGRAL SUPPORT ATTACHMENT
- R RIGID SUPPORT
- T SHAY STRUT
- SW SHOP WELD
- FW FIELD WELD
- LW LONGITUDINAL WELD
- WOL WELDLET
- IS1 ITEM NUMBER DESIGNATION USED IN THE FIRST 10 YEAR INSERVICE INSPECTION INTERVAL.

NOTES:


1. MULTIPLE SHAY STRUTS, SPRING SUPPORTS OR SHUBBERS IN A SINGLE PIPING SUPPORT ARE SHOWN BY A NUMBER BEFORE THE SUPPORT TYPE. (EXAMPLE: 2MS - TWO HYDRAULIC TYPE SHUBBERS THAT ARE NOT WELDED INTEGRAL TO THE PIPE).
2. THE SUPPORTS ON THE SERVICE WATER LINE 8" HBC-37 ARE WITHIN THE 1ST EXAMINATION BOUNDARY. THE PIPING WELDS IN THIS LINE ARE SHOWN FOR REFERENCE PURPOSES ONLY. THESE WELDS MAY NOT BE REPRESENTED IN THE ACTUAL AS-BUILT CONDITION.

GENERAL NOTE


DIMENSIONS SHOWN ON THIS DRAWING ARE TO BE USED FOR APPROXIMATE LOCATION ONLY. USE DESIGN DRAWINGS FOR DIMENSIONAL VERIFICATION.

REFERENCE DRAWINGS:

- 15102-0418 PRIMARY SERVICE WATER SYSTEM
- 15102-041C SERVICE WATER SYSTEM FOR CONTAINMENT AIR COOLERS

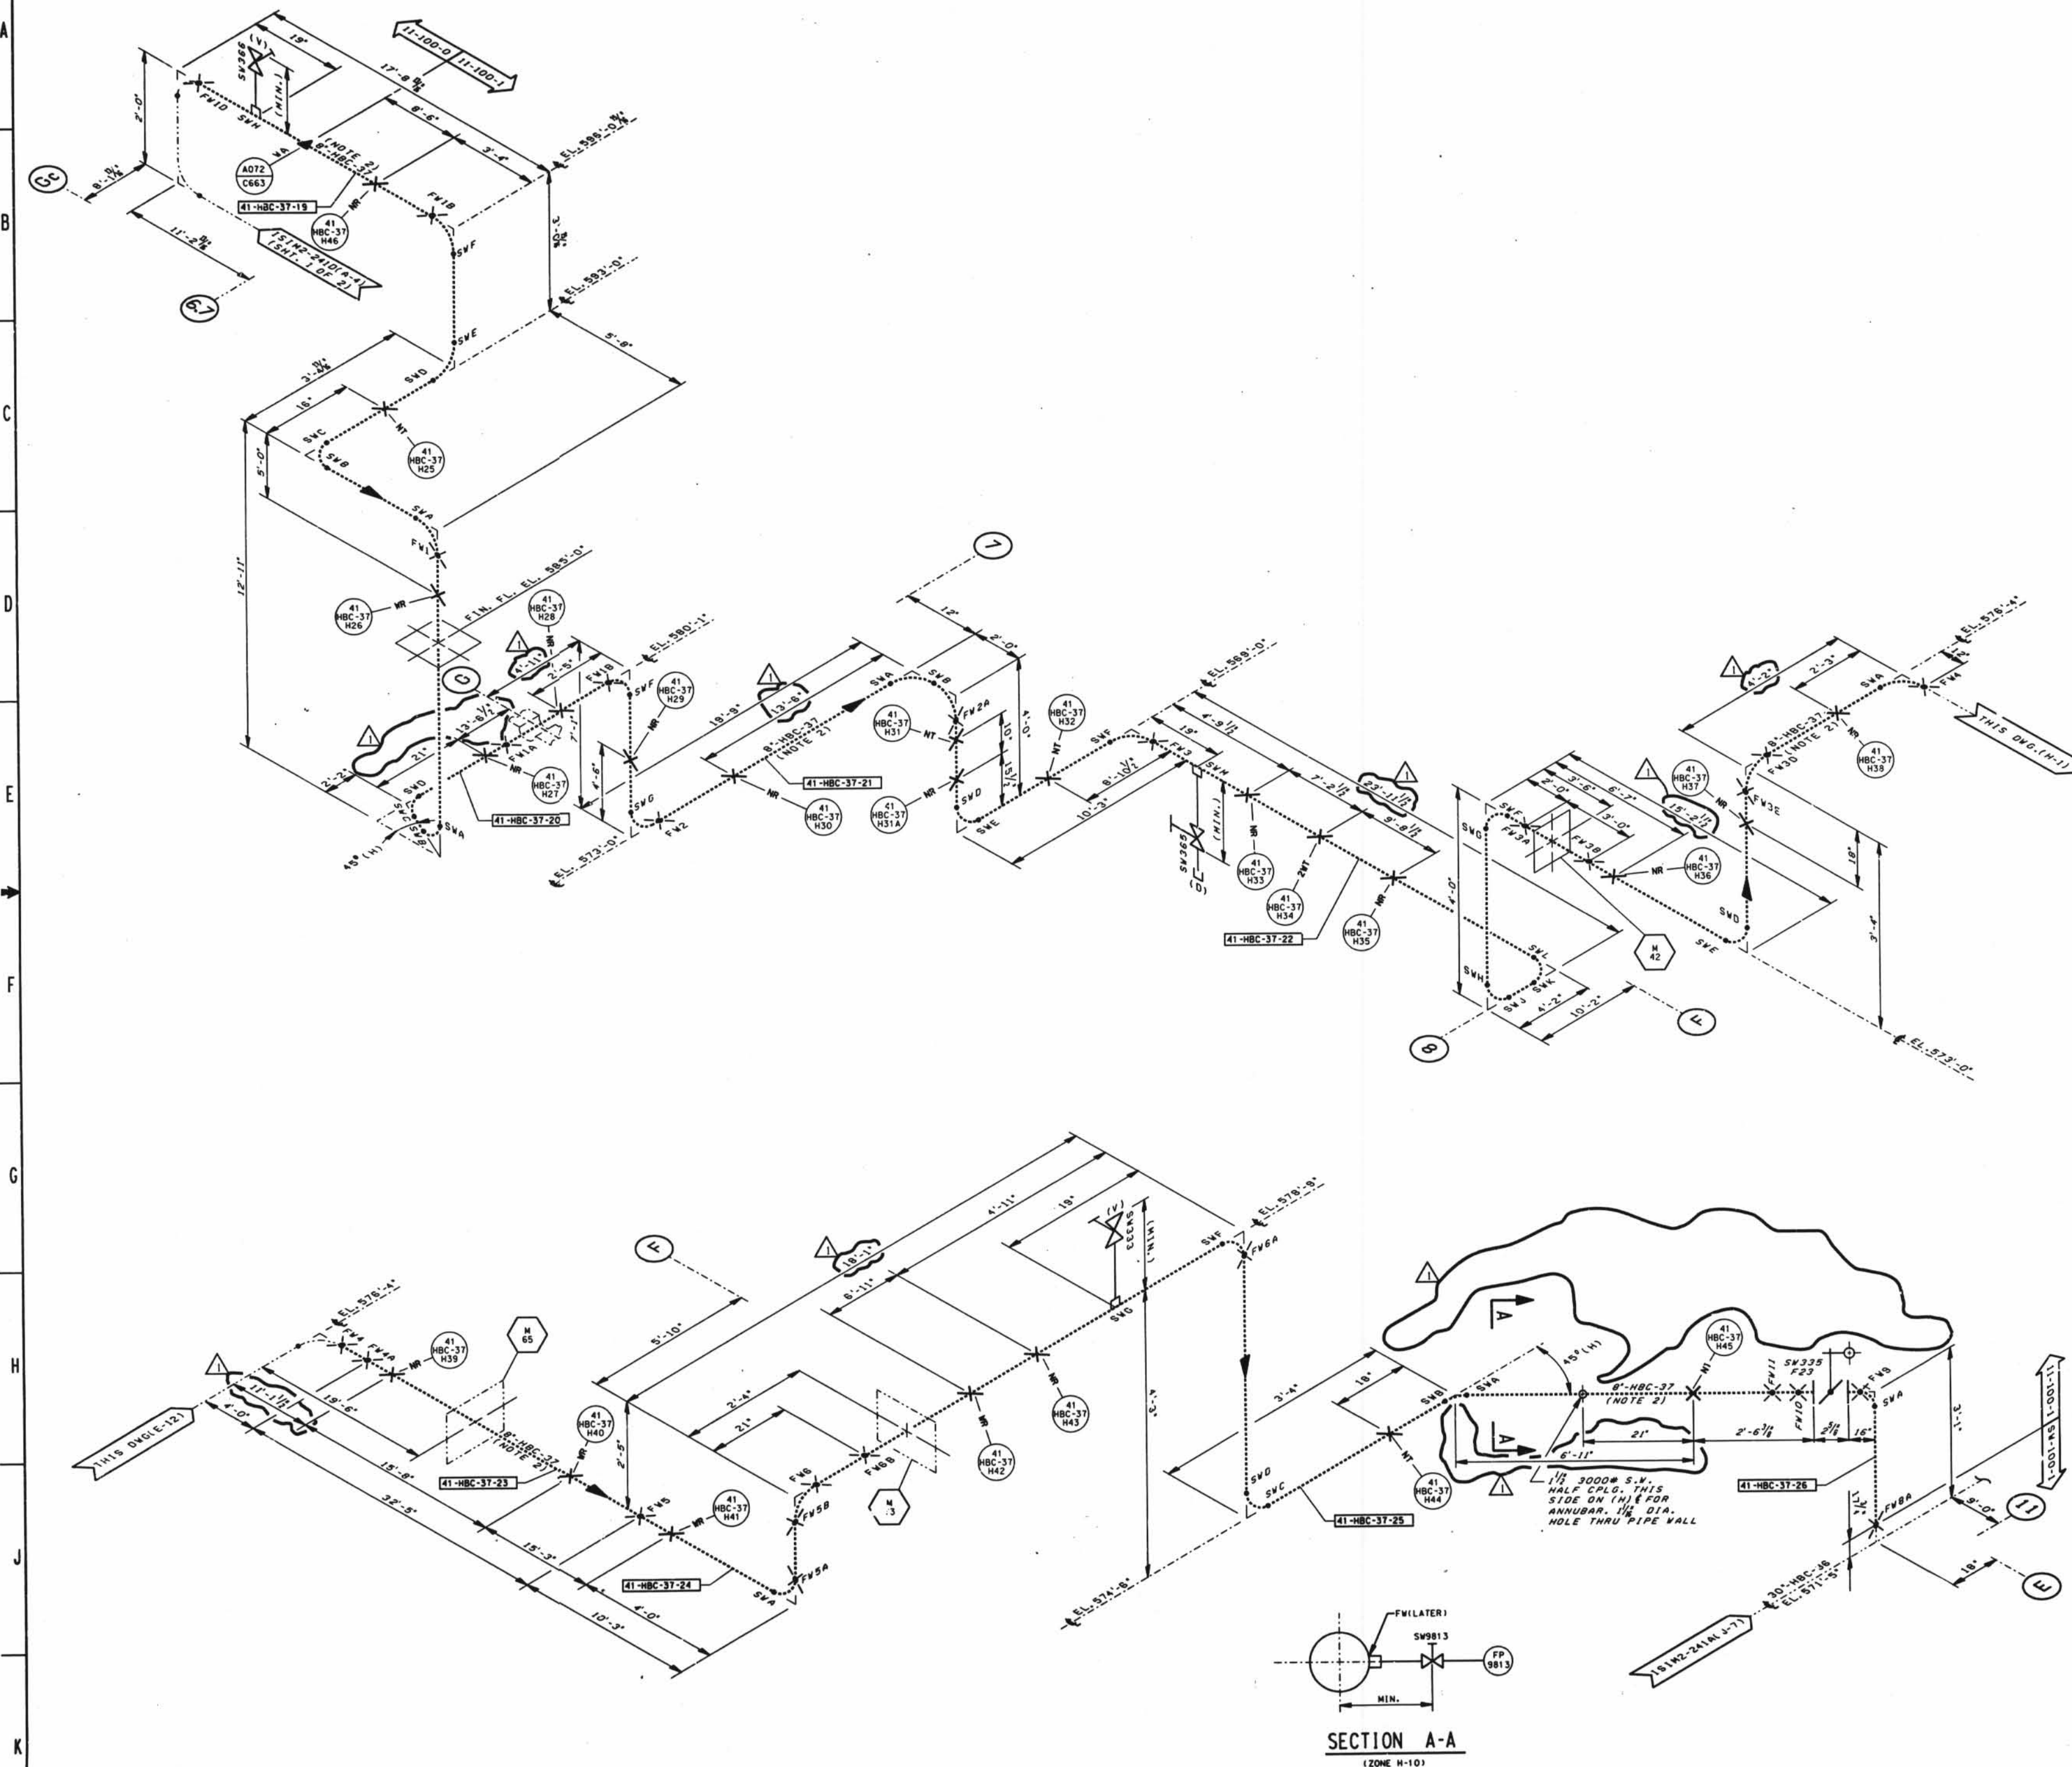

D-146

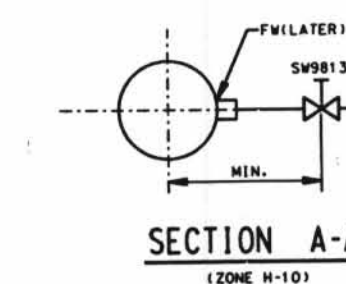

DATE	BY	CHKD	APP'D	REV	DESCRIPTION
12/15/01	JPS	JPS	JPS	1	ISSUED FOR SECOND TO YEAR 151 PROGRAM
12/15/01	JPS	JPS	JPS	2	ISSUED FOR SECOND TO YEAR 151 PROGRAM
12/15/01	JPS	JPS	JPS	3	ISSUED FOR SECOND TO YEAR 151 PROGRAM
12/15/01	JPS	JPS	JPS	100	ISSUED FOR SECOND TO YEAR 151 PROGRAM

ISIM2-241L 1