
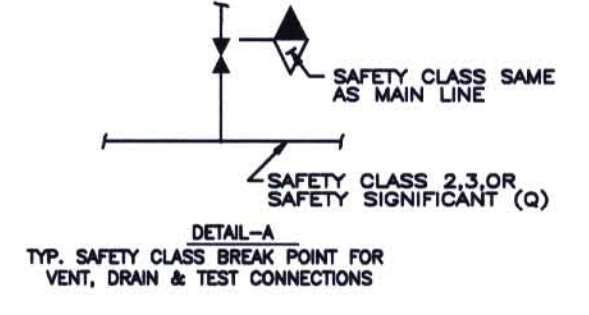


CFRC	COOLING COIL	DRAIN VALVES			
A	ACA10	4580A	4580B	4580C	4580D
B	ACA07	4582A	4582B	4582C	4582D
C	ACA08	4584A	4584B	4584C	4584D
D	ACA09	4586A	4586B	4586C	4586D

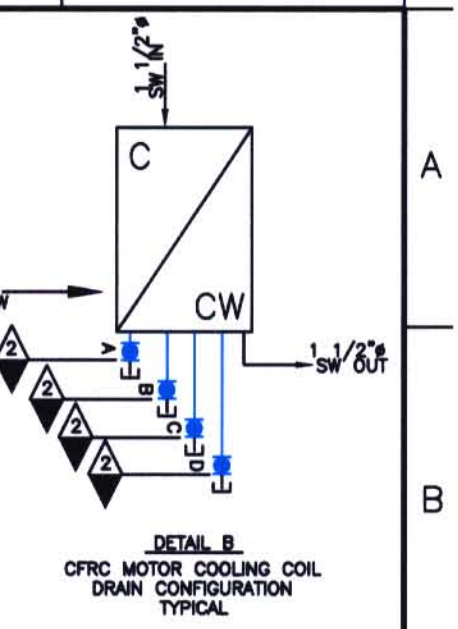

D-18

THOSE PORTIONS OF THIS DRAWING WHICH ARE COLORED CYAN INDICATE THAT THE COLORED ITEM IS SUBJECT TO AGING MANAGEMENT REVIEW

- NOTES:
- FOR GENERAL NOTES REFER TO DRAWING 33013-2241
 - REVISION "D" OF THIS DRAWING SUPERSEDED PORTIONS OF 33013-1250, REV.8
 - EXCEPT WHERE OTHERWISE INDICATED, SAFETY CLASS BREAKS FOR ALL VENT, DRAIN & TEST CONNECTION SHALL BE AT THE ROOT VALVE IN ACCORDANCE WITH DETAIL "A".
 - ALL SAFETY CLASS LINES ARE SEISMIC CATEGORY I.
 - EXCEPT WHERE OTHERWISE INDICATED, SAFETY CLASS FOR INSTRUMENT AIR AND NITROGEN LINES AND COMPONENTS IS BASED ON UPSTREAM INSTRUMENT AIR/NITROGEN VALVE. REFER TO INTERFACING AIR/NITROGEN DRAWING FOR SAFETY CLASS.

REVISED PER	DATE	BY	CHKD	APP'D
TYPOGRAPHIC	12/12/01	12/17/01	12/18/01	12/18/01
DRWN	12/12/01	12/17/01	12/18/01	12/18/01
CHKD	12/12/01	12/17/01	12/18/01	12/18/01
APP'D	12/12/01	12/17/01	12/18/01	12/18/01
GAD FILE NAME: 3P125003				
CONSTRUCTION				
LIMITED CONSTRUCTION AS NOTED				
PRELIMINARY NOT FOR CONSTRUCTION				
RECORDING PURPOSES				
15/18/01	AS BUILT	GW		
DATE	RELEASED FOR	ENGR.		
BY: GINNA STA.	Reviewed On a Design Comp.			
SCALE: NONE				
STATION SERVICE COOLING WATER				
SAFETY RELATED				
(SW)				
P&ID				
JOB NO.	DRAWING NO.	REV.		
EWR 3391E	33013-1250 SHEET 3 OF 3-LR			
CCD 01	CONTROL COPY #			