


D-25

- NOTES:
1. FOR GENERAL NOTES SEE DRAWING 33013-2241.
 2. THIS DRAWING SUPERSEDES CATALYTIC DRAWING A-202.
 3. CHECK VALVES 8630A AND 8630B ARE PROVIDED WITH ORIFICES IN THEIR DISKS TO ALLOW CONTROLLED CLOSURE OF THE PORY'S, REFERENCE EWR 1980.
 4. EXCEPT WHERE OTHERWISE INDICATED, SAFETY CLASS BREAKS FOR ALL VENT, DRAIN, AND TEST CONNECTIONS SHALL BE AT THE ROOT VALVE IN ACCORDANCE WITH DETAIL "A".

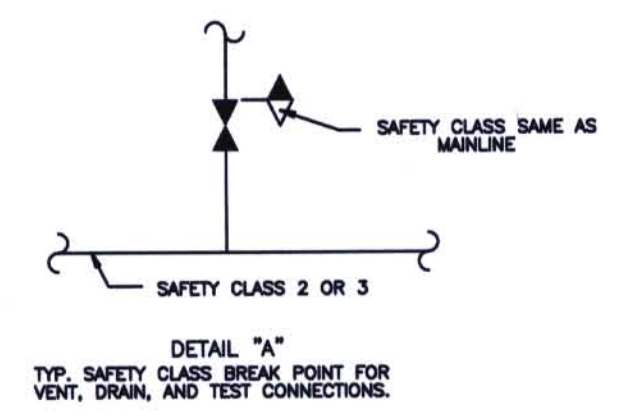

REVISED FOR	DATE	BY	CHKD	APP
33013-1283-LR	10/11/2010/4/00	JEP	JEP	JEP
CDT FILE NAME:	32124301			
CONSTRUCTION				
LIMITED CONSTRUCTION AS NOTED				
PRELIMINARY NOT FOR CONSTRUCTION				
DESIGN PURPOSE				
DATE	AS BUILT	JEP		
RELEASED FOR	DATE			
BY	FOR	PROJECT	DATE	COMP.
NONE		RCS Overpressure Protection Nitrogen Accumulator System		
P & ID				
JOB NO.	DRAWING NO.	REV.		
EWR 3391E	33013-1283-LR	1		
CCD 01	CONTROL COPY #			