


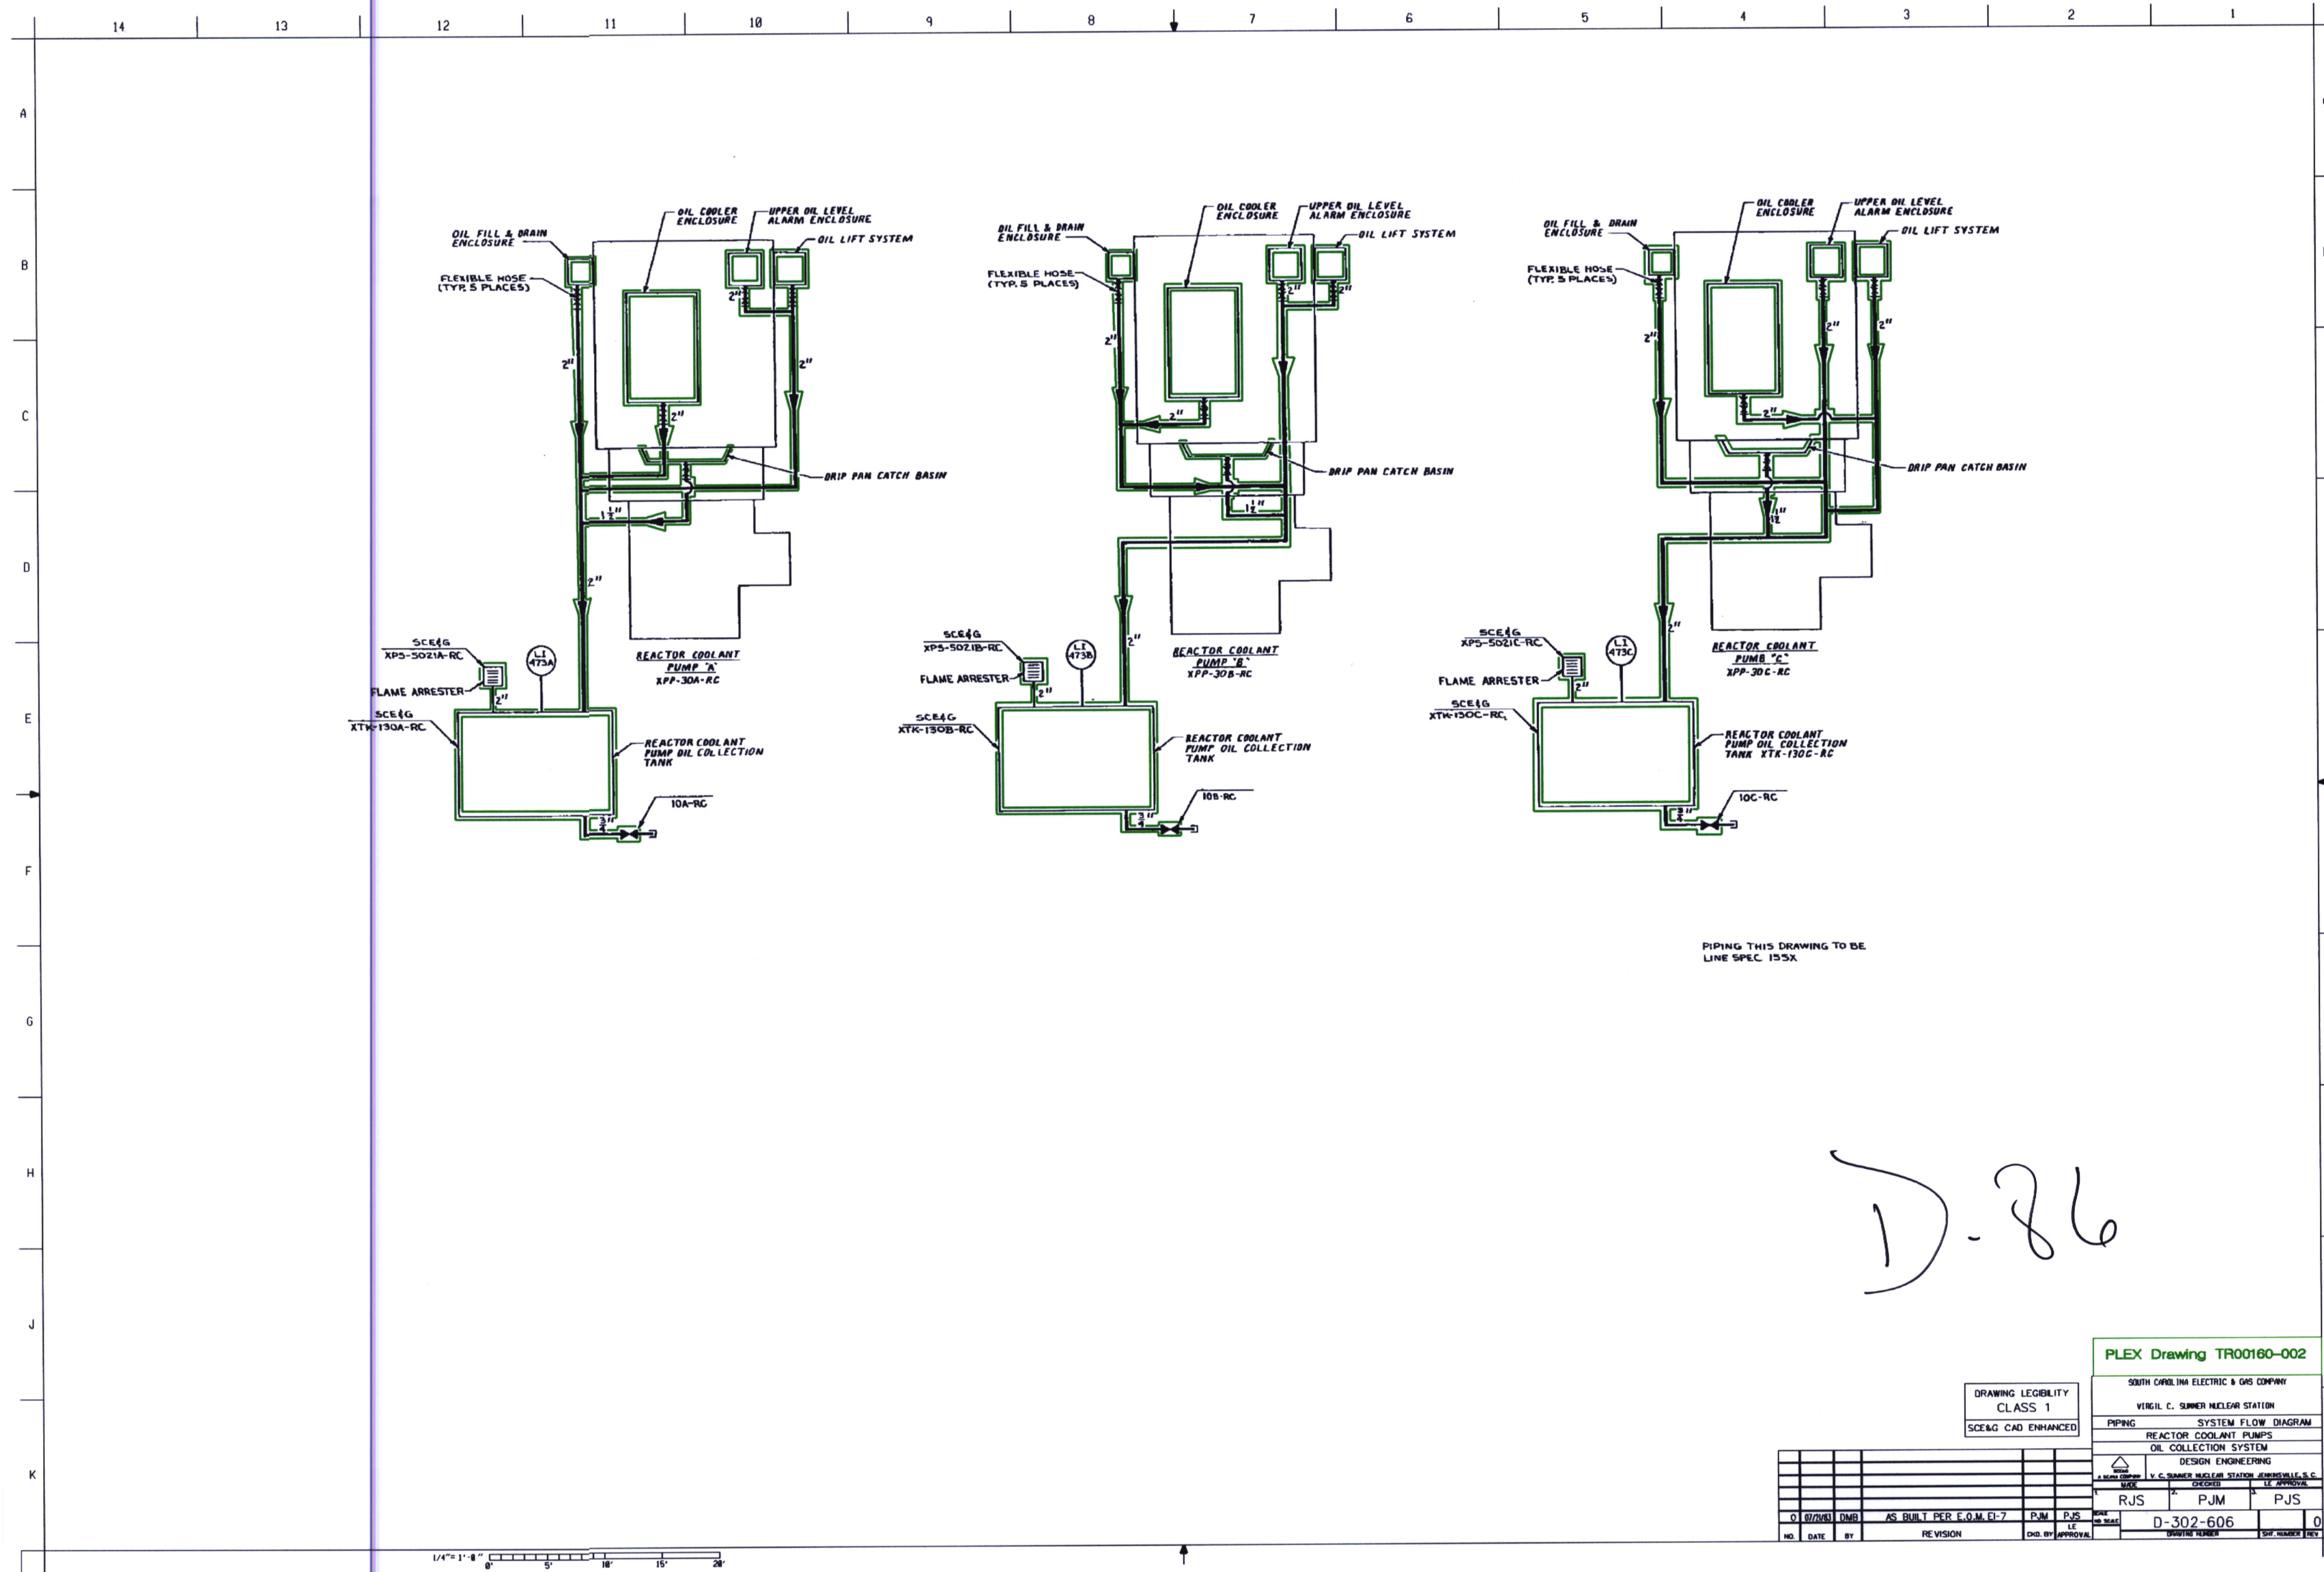

PIPING THIS DRAWING TO BE
LINE SPEC. 155X

D-86

DRAWING LEGIBILITY
CLASS 1
SCE&G CAD ENHANCED

PLEX Drawing TR00160-002

SOUTH CAROLINA ELECTRIC & GAS COMPANY
VIRGIL C. SUMNER NUCLEAR STATION
PIPING SYSTEM FLOW DIAGRAM
REACTOR COOLANT PUMPS
OIL COLLECTION SYSTEM

DESIGN ENGINEERING
V. C. SUMNER NUCLEAR STATION JENNINGSVILLE, S.C.
CHECKED BY: RJS
DESIGNED BY: PJM
APPROVED BY: PJS

NO.	DATE	BY	REVISION	CHK. BY	APPROVAL
0	8/7/83	DMR	AS BUILT PER I.O.M. 12-7	PJM	PJS

D-302-606
BRIDGE NUMBER
SHEET NUMBER