


- NOTES:**
- PROJECT SURVEY CONTROL POINT (N 60,000, E 60,000) IS LOCATED AT THE NORTHEAST CORNER OF SECTION 22, T.21S. R.16E. SALT LAKE BASE AND MERIDIAN.
  - COORDINATES OF SURVEY MONUMENTS, BOUNDARY MONUMENTS AND SITE MARKERS ARE AS SHOWN. (AS-BUILT).
  - PROJECT SURVEY CONTROL POINT LOCATION BY STATE PLANE COORDINATES IS N 238,371.48, E 2,388,479.92 PIN ELEVATION 4110.9.
  - THIS DRAWING IS BASED ON OF DRAWING NUMBER GRN-PS-10-0601 OF THE GREEN RIVER SITE, GREEN RIVER, UTAH. THE ORIGINAL DRAWING WAS PRODUCED BY MORRISON-KNUDSEN ENGINEERS INC. FOR THE DEPARTMENT OF ENERGY UMTRA PROJECT OFFICE.

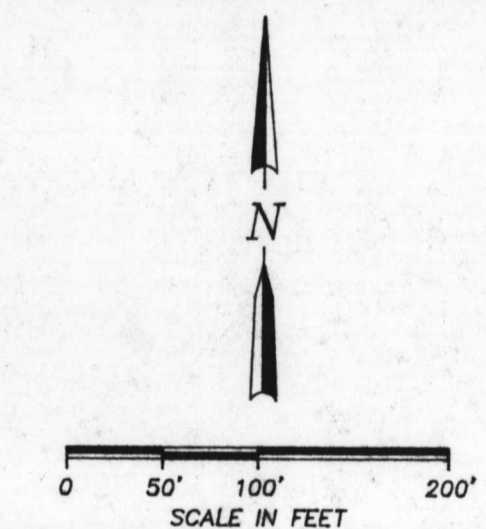

- LEGEND**
- 1 SURVEY MONUMENT
  - 810 MONITOR WELLS
  - NA-4 NEUTRON ACCESS HOLES
  - 2 BOUNDARY MONUMENT
  - 1 SITE MARKER
  - 130 PHOTOGRAPH LOCATION
  - PROPERTY BOUNDARY
  - P1 PERIMETER SIGN
  - E ENTRANCE SIGN
  - BUILDINGS

SI  
APERTURE  
CARD

1991 PRELICENSING INSPECTION  
GREEN RIVER, UTAH DISPOSAL SITE  
CONDUCTED JULY 15 AND 16, 1991

9301210299

NO.	DATE	REVISIONS	DWN.	CKD.	SUB.	NO.	DATE	REVISIONS	DWN.	CKD.	SUB.

**U.S. DEPARTMENT OF ENERGY**  
GRAND JUNCTION PROJECTS OFFICE, COLORADO

**PLATE 1**  
**GREEN RIVER, UTAH INSPECTION DRAWING,**  
**1991 PRELICENSING INSPECTION**

DRN: ESN 8/7/92  
 CHIEF INSPECTOR: MJP 8/7/92  
 PROJECT: 8-7-92

CN Geotech, Inc. PROJECT NO. ENG-111-0011-00-000 DWG. NO. E0086800 SHT. OF 001 OF 001