

**From:** "Browne, Andrea" <ABrowne@ecommunity.com>  
**To:** "Toye Simmons" <TLS@nrc.gov>  
**Date:** 5/24/05 3:21PM  
**Subject:** RE: Amendment request to delete 6.I., 6.J., and 6.L.of yourlicense

In response to your request for more information:

1. The Ir-192 sources were returned to Cordis. No Novoste units were ever possessed.
2. A pdf file is attached with two drawings. The first is a blueprint of the area encompassing the hot lab. The second is a scaled drawing of the hot lab with letter keys indicating sites for the wipe survey.
3. The key has been transferred to a document with the data previously submitted indicating the results of the area and wipe survey.
4. Per the memo from Eric Slessinger submitted with the initial request (4/1/05) I am verifying that all radioactive material has been removed.

If more information is required, or if this information must be transmitted in hard copy, please contact me. Thank you for your assistance.

Andrea D. Browne, Ph.D.  
Radiation Safety Officer  
Diagnostic Imaging Physicist  
Community Health Network  
ABrowne@ecommunity.com  
(317) 355-5865

-----Original Message-----

From: Toye Simmons [mailto:TLS@nrc.gov]  
Sent: Tuesday, May 24, 2005 9:42 AM  
To: Browne, Andrea  
Subject: Amendment request to delete 6.I., 6.J., and 6.L.of yourlicense

\*\* PRIVATE \*\*

In order to complete your request for amendment, I need more information:

(1) Please provide disposal information for the Ir-194 and Sr-90 sources as well as for the Cordis and Novoste units, (2) Please provide a proper diagram of the facility showing the areas covered by the close-out survey, and (3) provide a close-out survey of The Indiana Heart Hospital (include diagram of use area) and confirm that all radioactive material has been removed.

Feel free to call me at 630-829-9842 My fax # is 630-829-9782

PLEASE RESPOND WITHIN 15 DAYS OF THIS EMAIL


Survey results keyed to drawing. Copy of the original document was sent with the initial 4/1/05 amendment request.

Close-out area survey conducted on 5/24/04 with a Victoreen 450B survey meter calibrated on 10/20/2003.

Area	mR/hr
Bkg	0.02
A Floor	~0.02
B Counter	~0.02
C Shelf	~0.02

Wipe Survey conducted 5/24/04. Wipes counted in Searle 1185 Autowell counter.

Area	Net cpm
Bkg	40
A Floor	7
B Counter	5
C Shelf	4

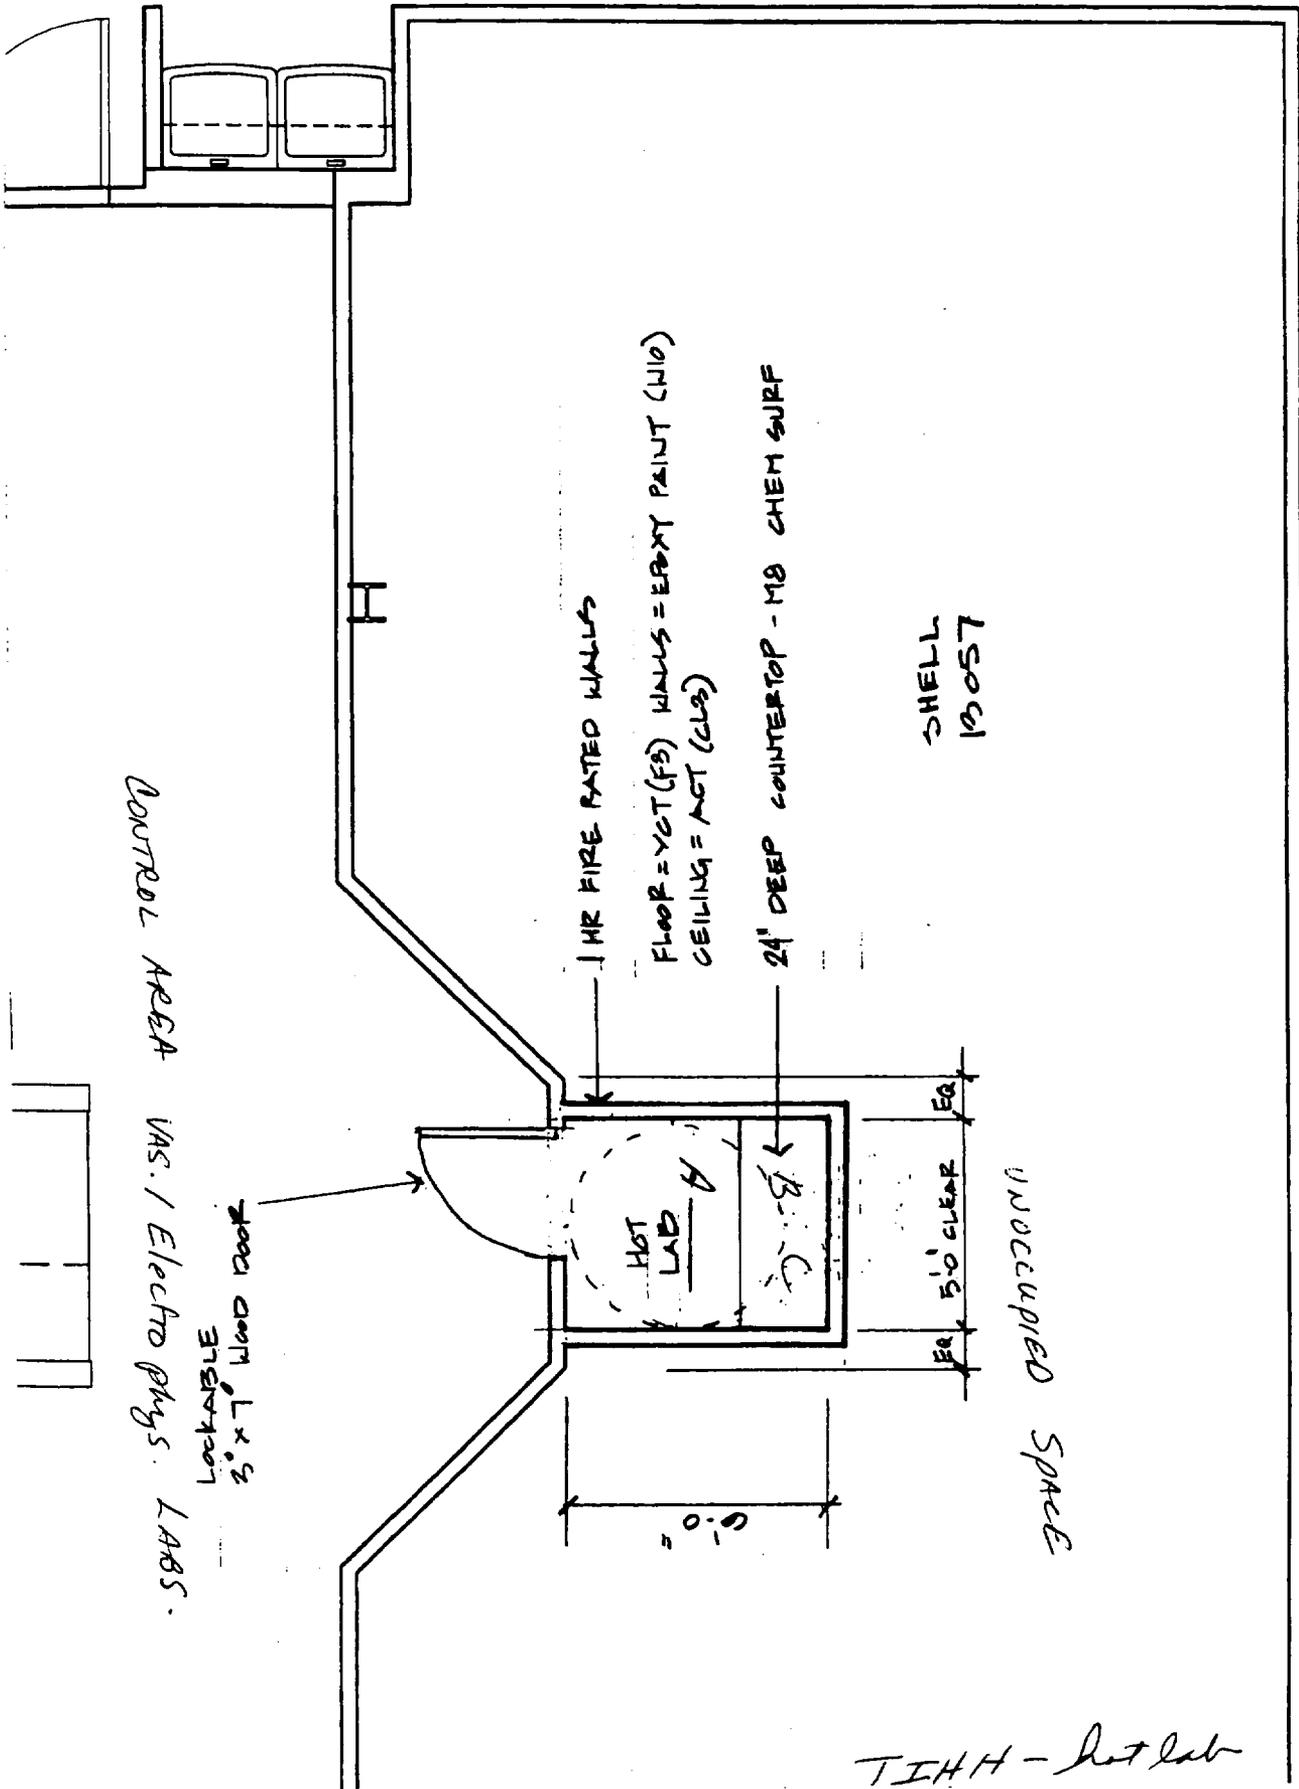

CONTROL AREA VAC. / Electro phys. LABS.

WOOD DOOR  
LOCKABLE  
ELECTRICAL

1 HR FIRE RATED WALLS

FLOOR = YGT (FS) WALLS = EPOXY PAINT (N10)  
CEILING = AGT (CLG)


24" DEEP COUNTERTOP - MB CHEM SURF

SHELL  
19057

UNOCCUPIED SPACE

TIHH - hot lab  
for IUB sources

Scale: 1/4" = 1'

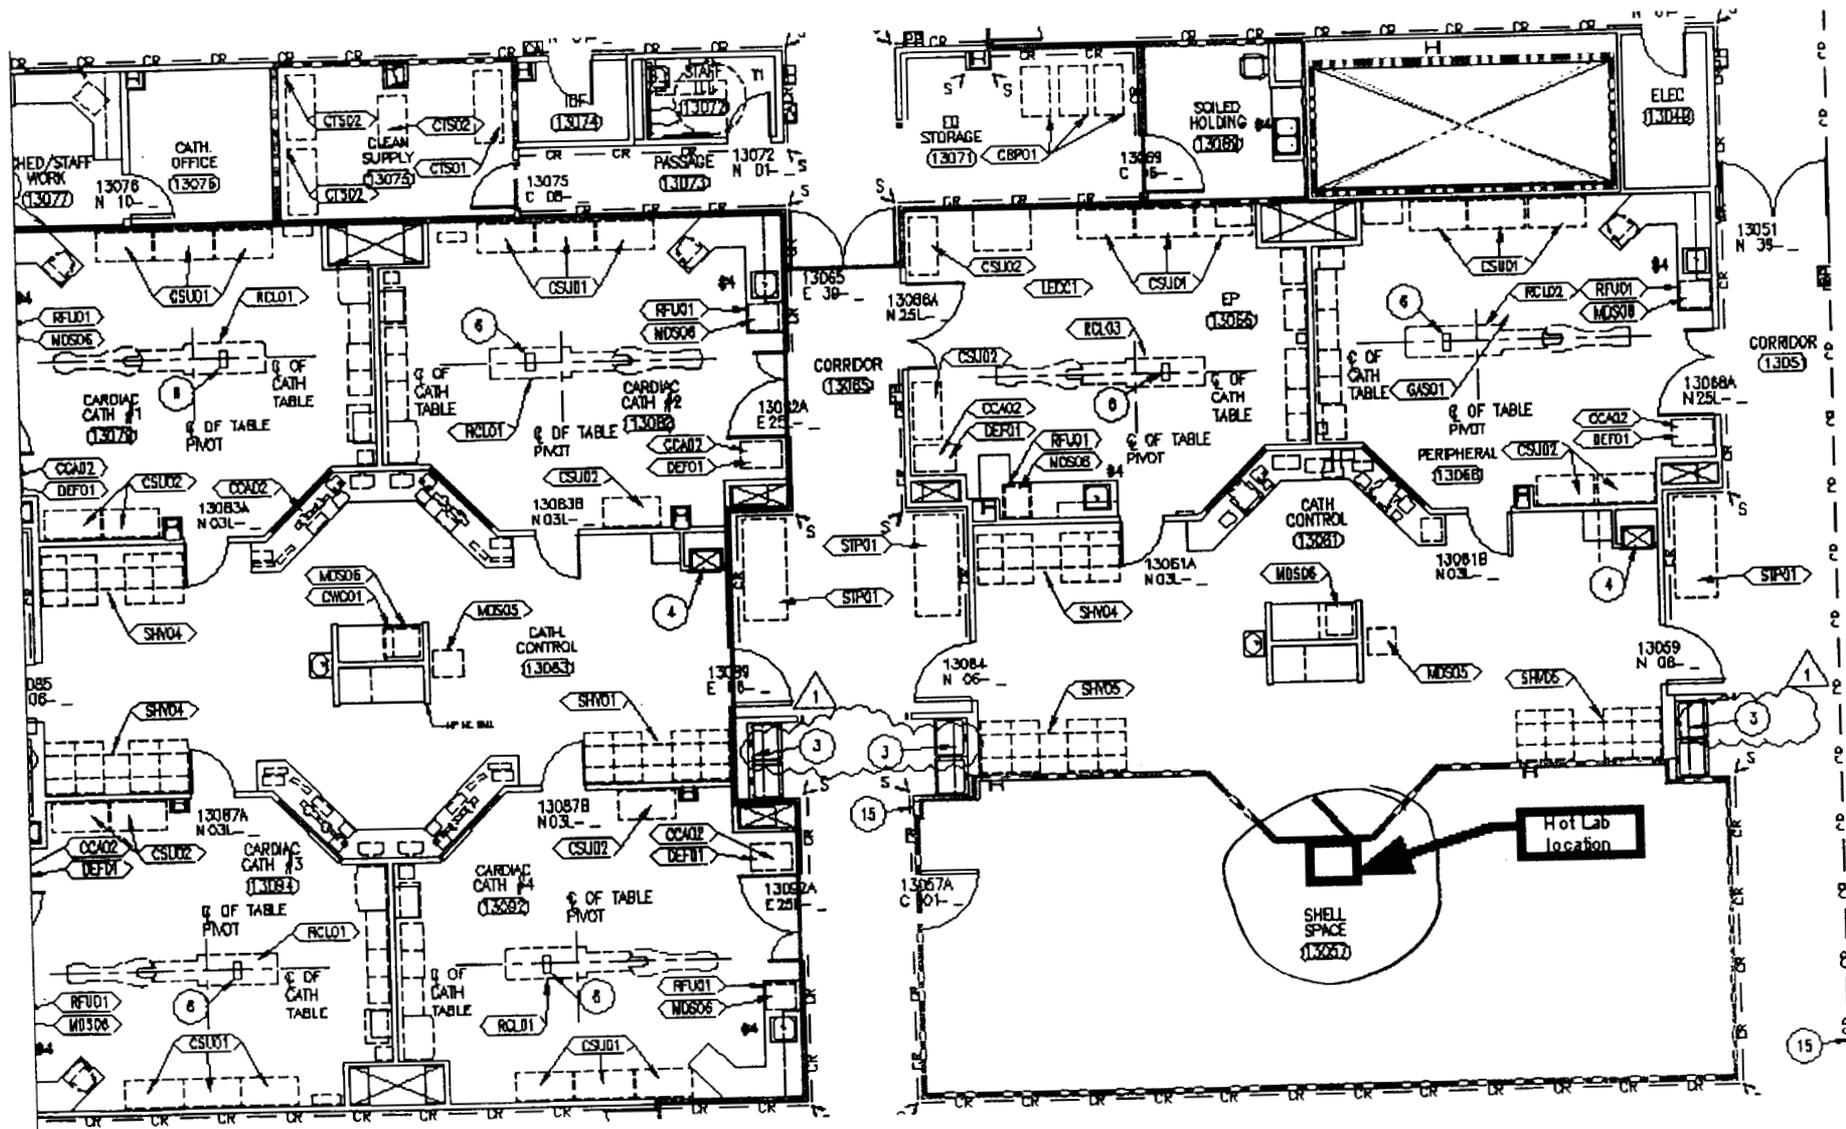

**Mail Envelope Properties** (42938CBA.A6F : 18 : 10863)

**Subject:** RE: Amendment request to delete 6.I., 6.J., and 6.L.of yourlicense  
**Creation Date:** 5/24/05 3:20PM  
**From:** "Browne, Andrea" <ABrowne@ecommunity.com>

**Created By:** ABrowne@ecommunity.com

**Recipients**

nrc.gov  
ch\_po.CH\_DO  
TLS (Toye Simmons)

**Post Office**  
ch\_po.CH\_DO

**Route**  
nrc.gov

<b>Files</b>	<b>Size</b>	<b>Date &amp; Time</b>
MESSAGE	1698	05/24/05 03:20PM
TIHH Hot Lab.pdf	221556	
Survey results keyed to drawing.doc		20480
Mime.822	335455	

**Options**

**Expiration Date:** None  
**Priority:** Standard  
**Reply Requested:** No  
**Return Notification:** None

**Concealed Subject:** No  
**Security:** Standard