


Date 12-25-91
 I, John J. [illegible]
 certify that the above contained on this form was made in the normal and regular course of business,
 and the date stated below and that it is a correct reproduction of the document submitted to Microfilm.
 Microfilming Witness [Signature]

its having not been induced by ANP and is the property of the participants in the Arizona Nuclear Power Project. Use of the drawing and the specific design depicted thereon for any purpose other than that related to the Arizona Nuclear Power Project is not authorized by the Owners.

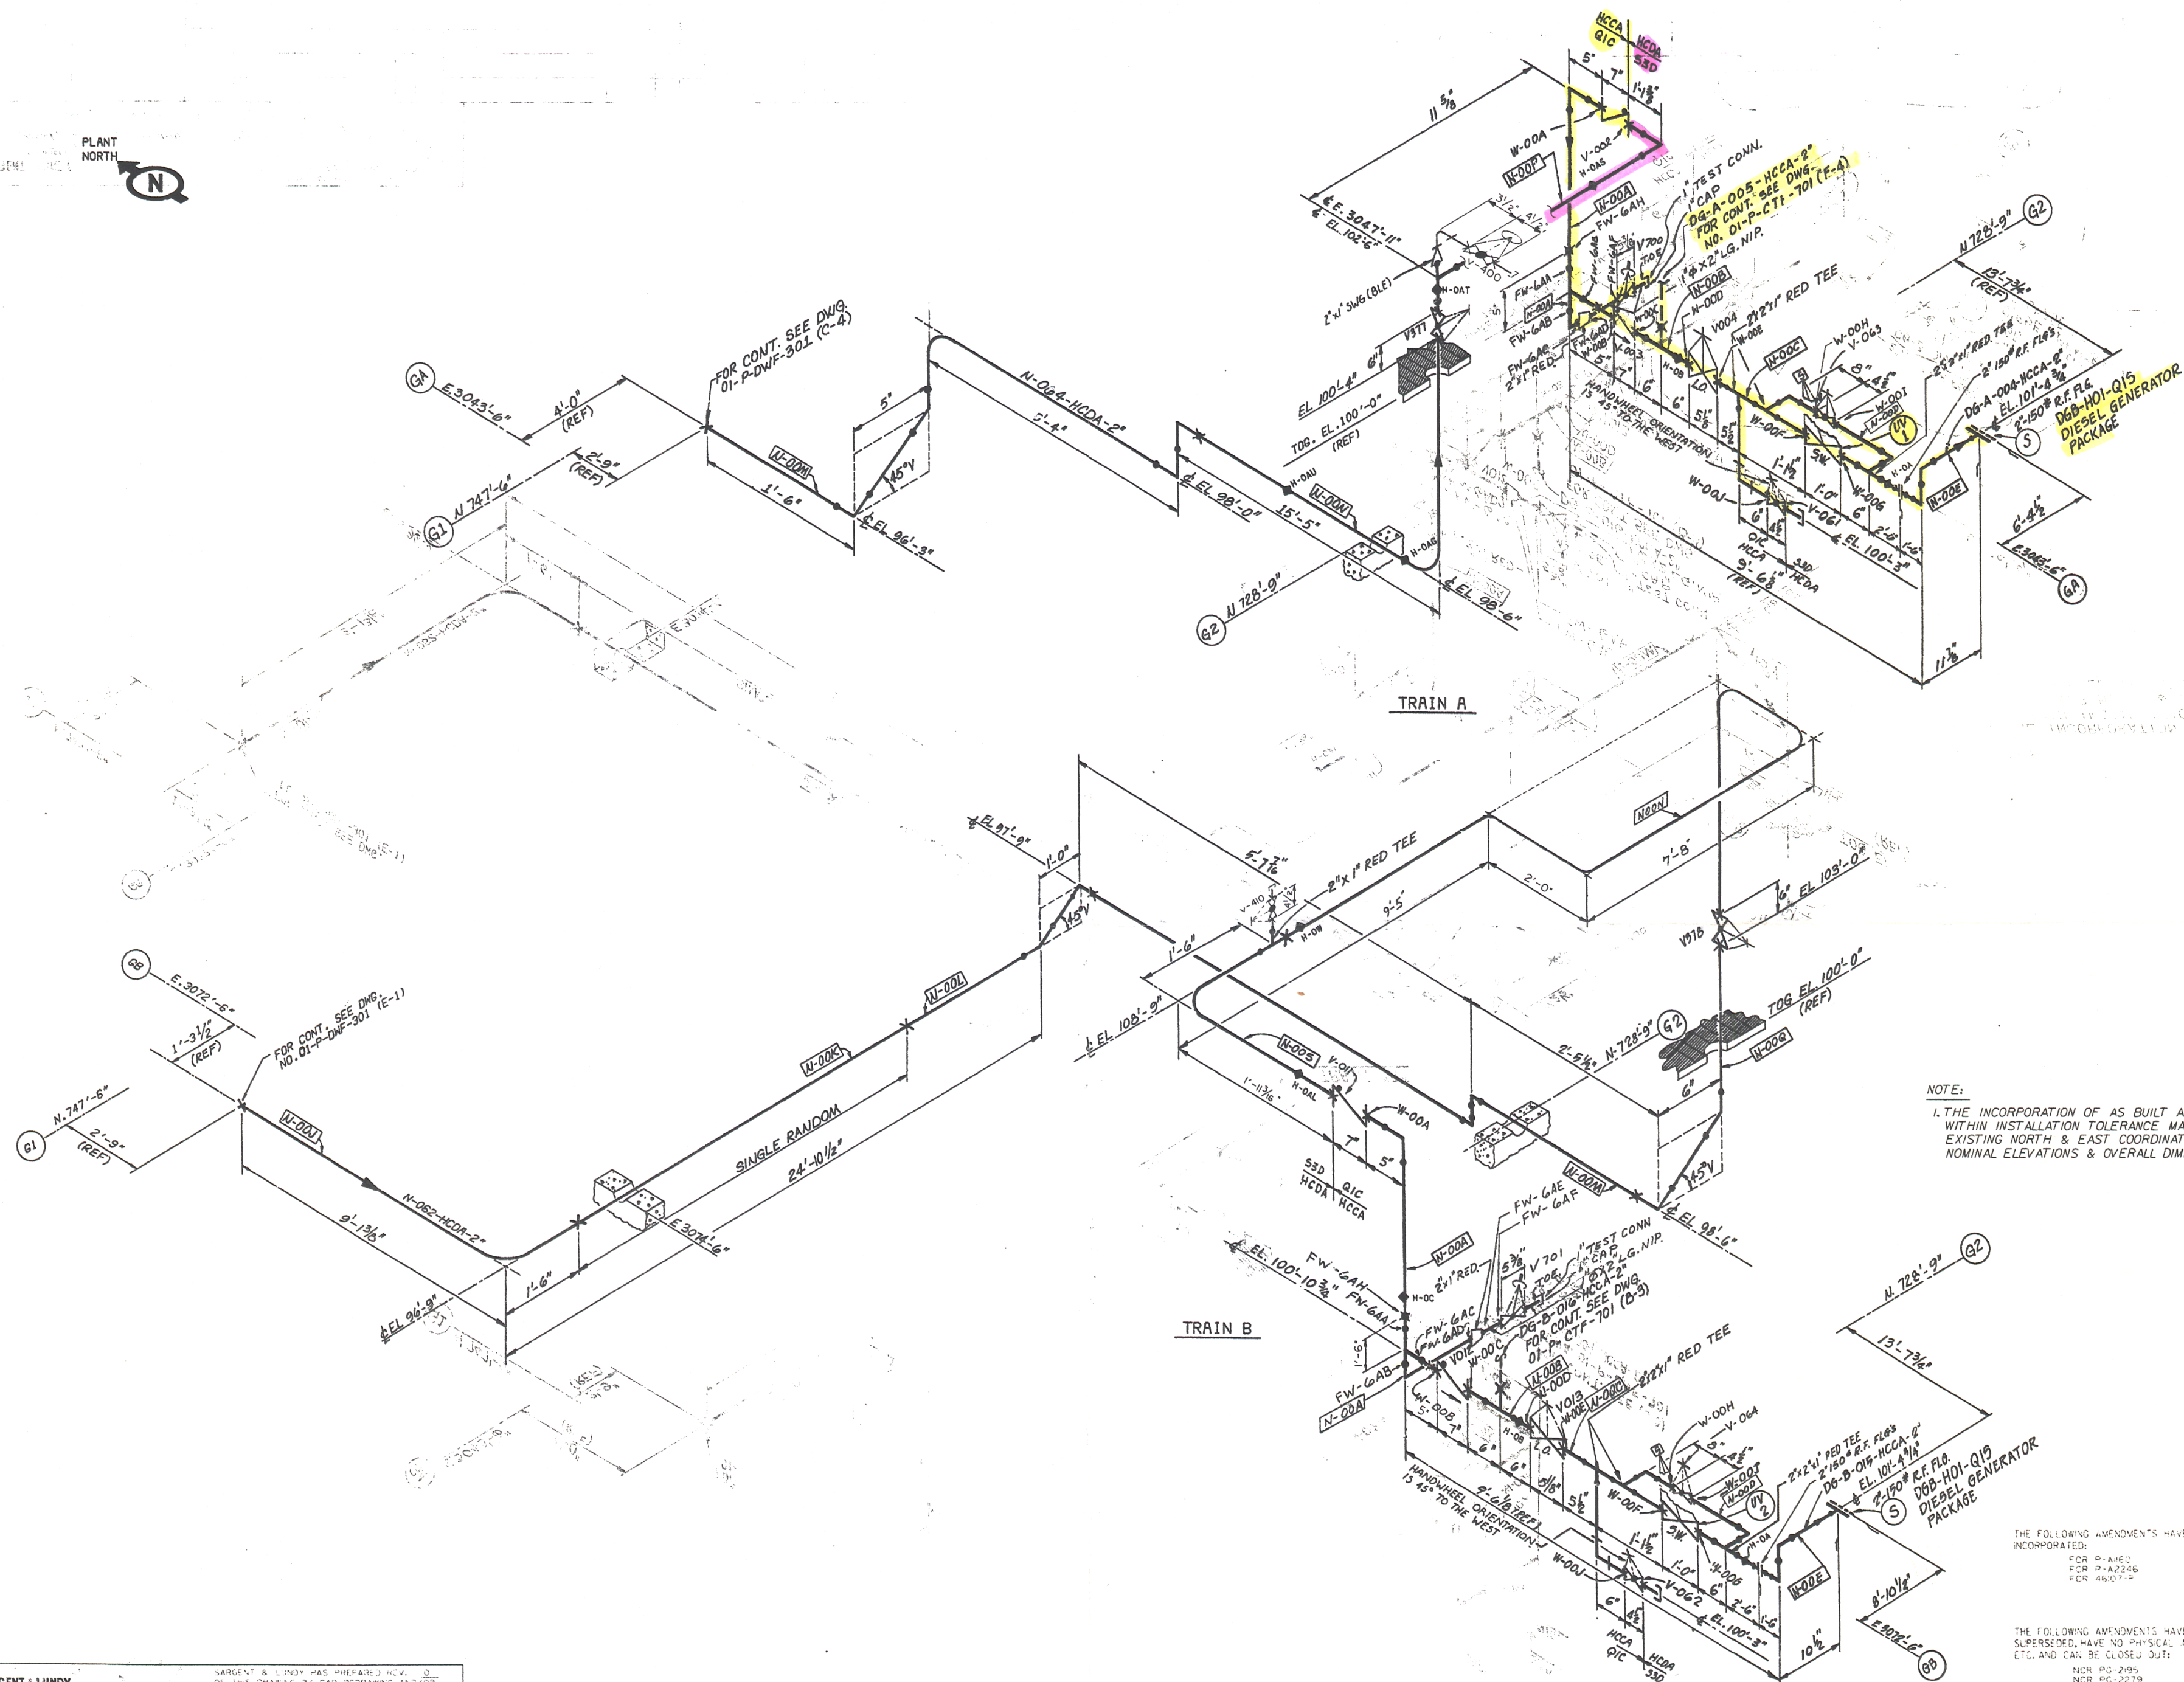

NOTE:

1. THE INCORPORATION OF AS BUILT AMENDMENTS WITHIN INSTALLATION TOLERANCE MAY AFFECT EXISTING NORTH & EAST COORDINATES, NOMINAL ELEVATIONS & OVERALL DIMENSIONS.

THE FOLLOWING AMENDMENTS HAVE BEEN
INCORPORATED:

FCR P-A1160
FCR P-A2246
FCR 46107-F

THE FOLLOWING AMENDMENTS HAVE BEEN
SUPERSEDED, HAVE NO PHYSICAL IMPACT OR
ETC. AND CAN BE CLOSED OUT:

NCR PG-2195
NCR PG-2279
NCR Px 9460
SFR IDW-003

ALL DCNS INCORPORATED ON THIS DRAWING ARE
THOSE ISSUED AGAINST THE CORRESPONDING IS
DRAWING.

TRAIN "A" & "B"

SEE MICROFILM FOR ACTUAL SIGNATURES



Arizona Nuclear Power Project

DIESEL GENERATOR BLDG. ISO
DEMINERALIZED WATER SYSTEM

| | | | |
|-------|---------|--------------|------|
| SCALE | JOB NO. | DRAWING NO. | REV. |
| NONE | | 01-P-DWF-701 | 0 |

[illegible]

10-05

34X44 'E' SIZE