

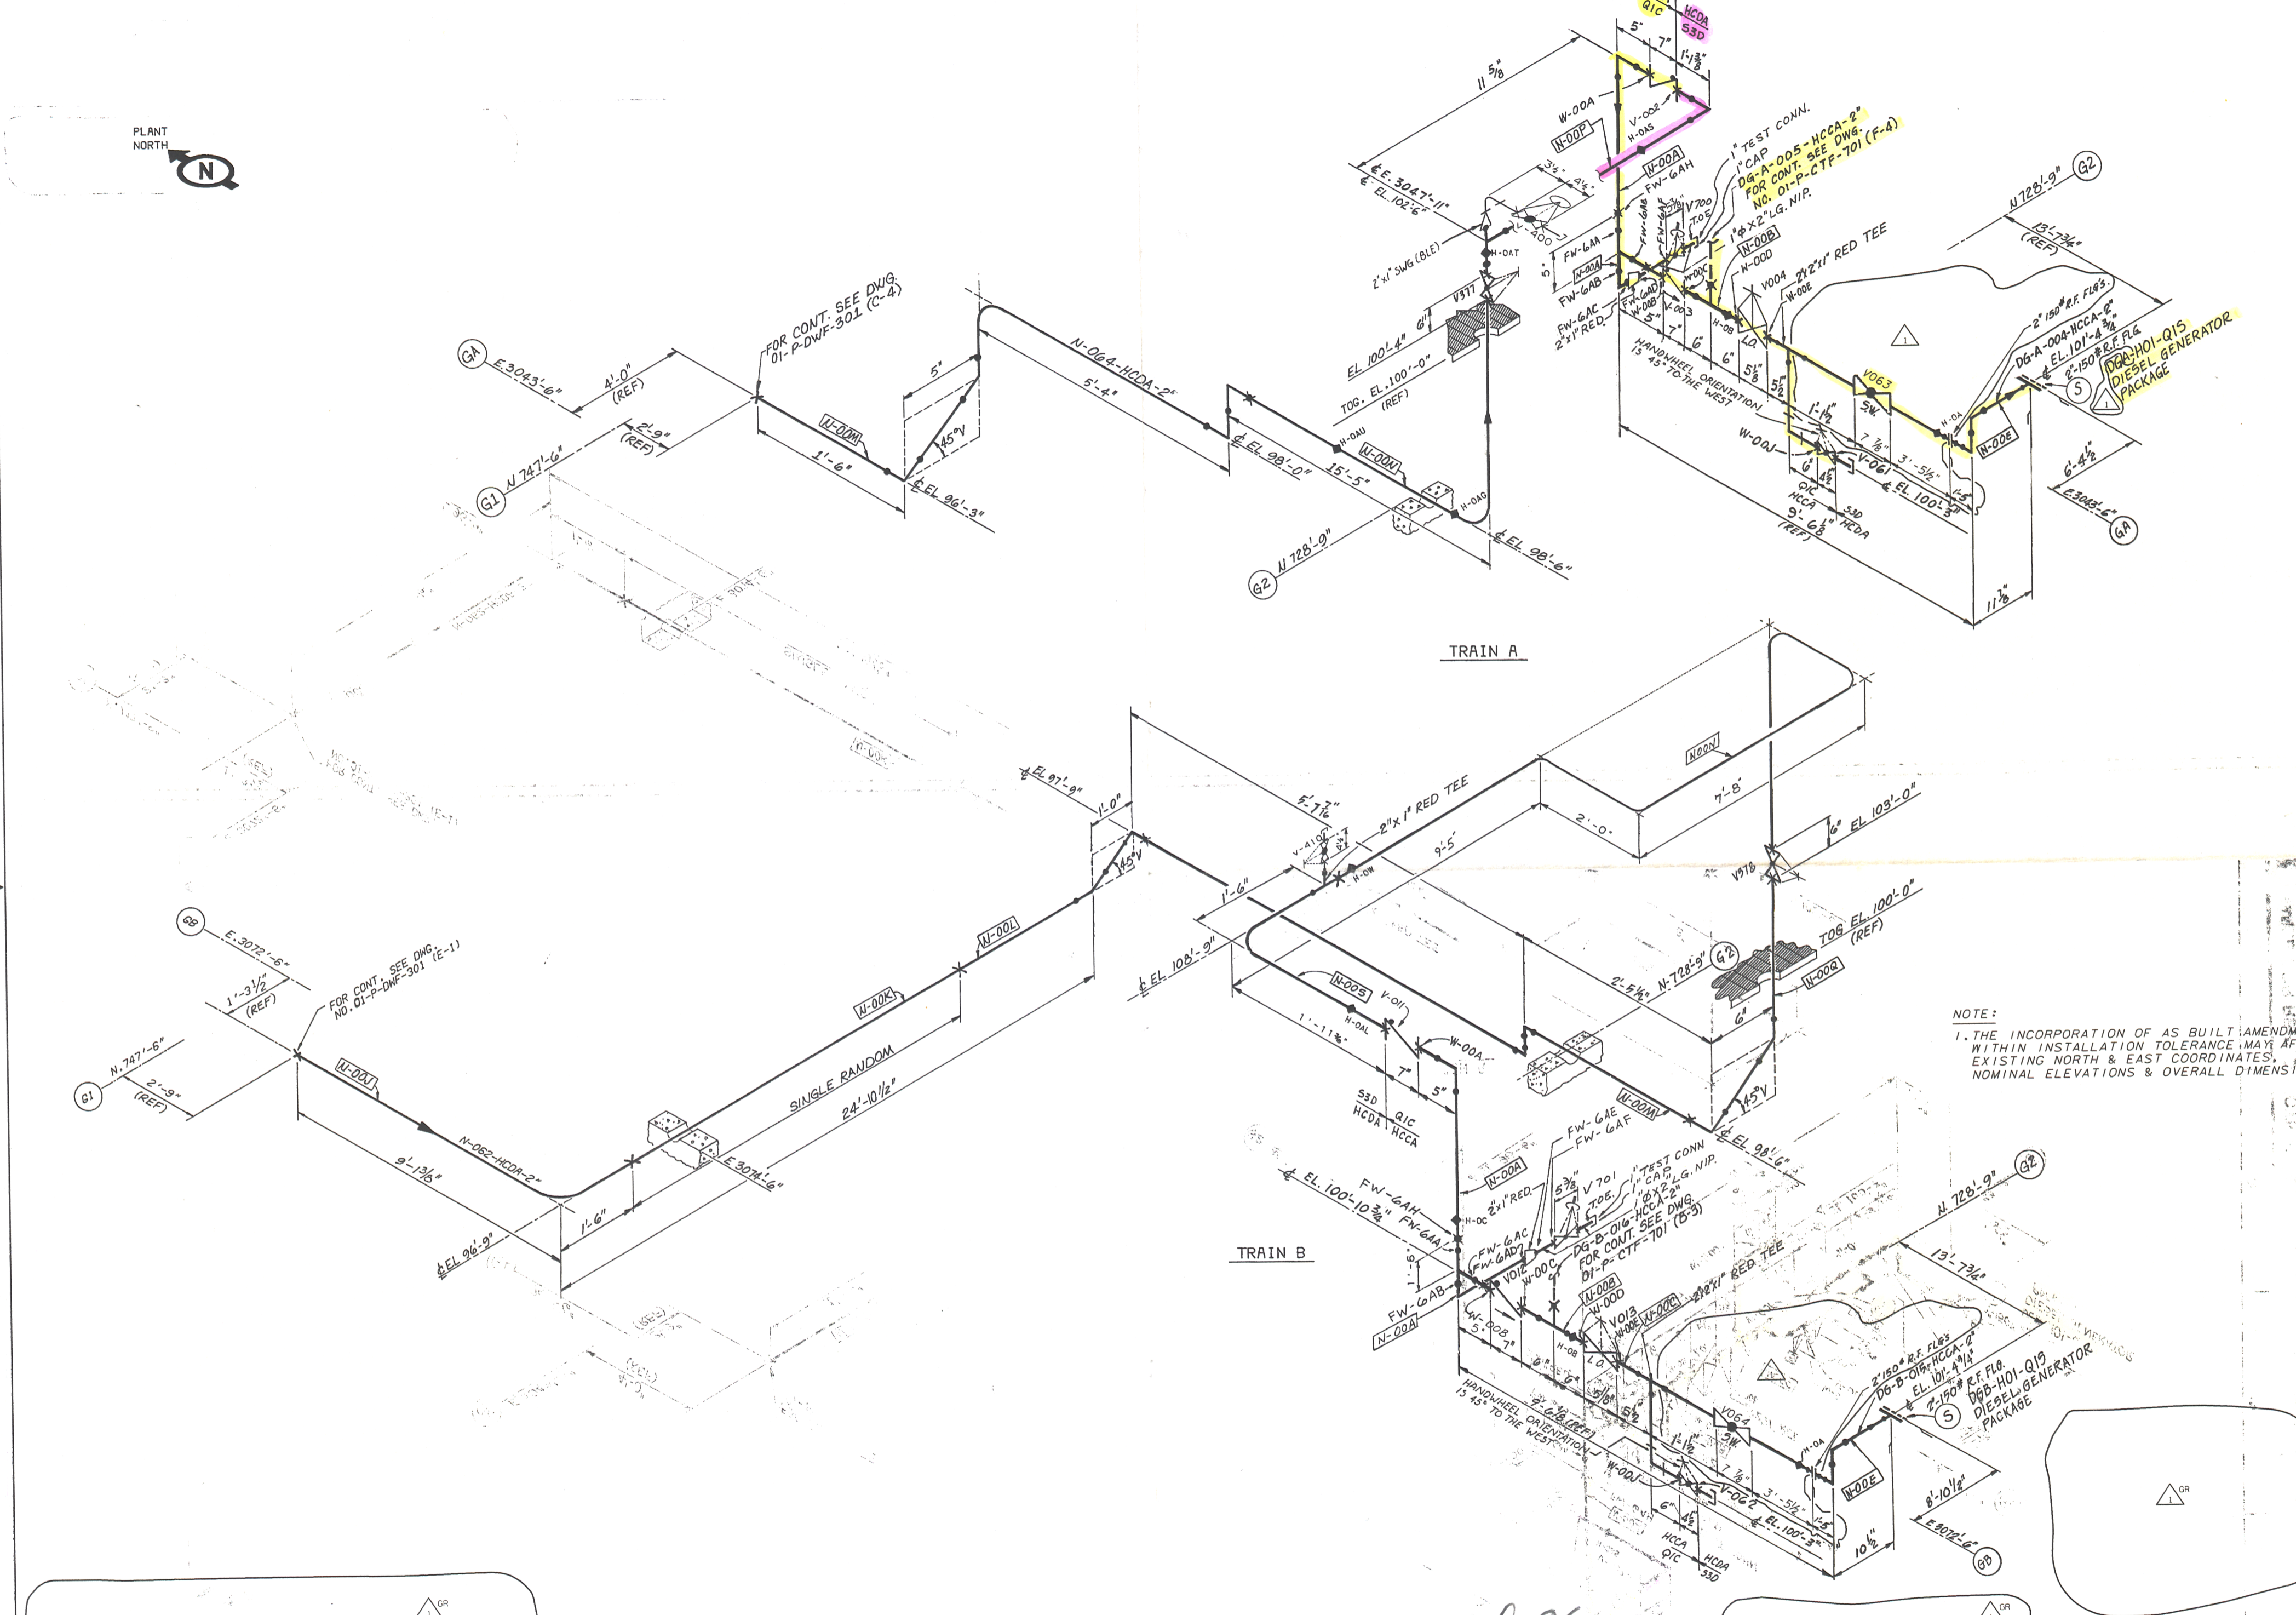


This drawing has been produced by ANPP and is the property of the PARTICIPANTS in the ARIZONA NUCLEAR POWER PROJECT. Use of the drawing and the specific design depicted thereon for any purpose other than that related to the Arizona Nuclear Power Project is not authorized by the Owners.

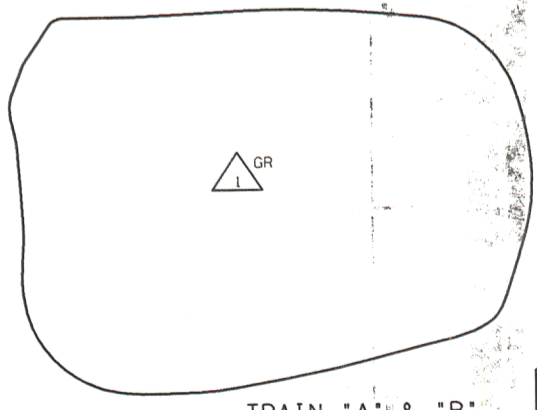

NOTE:  
 1. THE INCORPORATION OF AS BUILT AMENDMENTS WITHIN INSTALLATION TOLERANCE MAY AFFECT EXISTING NORTH & EAST COORDINATES, NOMINAL ELEVATIONS & OVERALL DIMENSIONS.

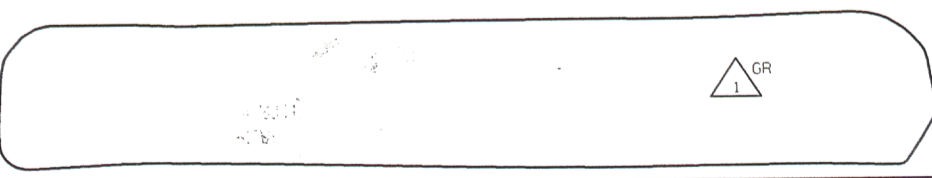

DWG. NO.	REFERENCE

NO.	DATE	REVISIONS	DR	CHK	ENG	IV	X-DISCIP.	MISC.	NAE
1	06/12/2003	INC. EDC# 2002-00097 & 98 GR TO DEL. S&L DISCLAIMER AND AMEND. LIST SEE MICROFILM FOR SIGNATURES							

Digitally signed by: Hillenbrand, James (ZH0889)  
 Date: 06/12/2003 12:15:52  
 Reason: Signatures are N/A  
 Location: PVNGS

PALO VERDE  
 NUCLEAR GENERATING STATION

SCALE	JOB NO.	DRAWING NO.	REV.
		01-P-DWF-701	1