



June 21, 2006

RECEIVED  
REGION 1

2006 JUN 26 AM 10:10

*noted*

U.S. Nuclear Regulatory Commission  
Region I  
Nuclear Materials Safety Branch  
475 Allendale Road  
King of Prussia, PA 19406-1415

Re: NRC License No. 37-30517-01

*03035010*

To Whom It May Concern:

We are anticipating the purchase of an E-Cam Dual Head Nuclear Camera. The room, where our existing Nuclear Camera is housed, is too small to accommodate the E-Cam.

We would like to use the room across the hall for the E-Cam. This room, in the past, housed a fluoroscopy/X-ray unit.

I am including a proposed drawing of the room and surrounding area for your approval.

In the drawing you will see that the Hot lab is proposed to be located in the new room. The doors to the room will be locked when not attended and the cabinet under the counter will also be locked at all times.

Once the E-Cam would be operational, we would de-install our existing ADAC Genesys / Pegasys and sell it.

The physicist will survey the old camera room prior to releasing it as a Nuclear Medicine exam room.

In the room that currently houses the ADAC, we would like to purchase a bone density unit and store our portable x-ray equipment there also. This would add a tube to our existing list.

Thank you for your consideration to this project. We would appreciate you expediting this process since our timeline is a very tight one and we don't want to compromise patient care by adding any unnecessary delays to this moving process. The anticipated delivery of the equipment is mid September. We will await your approval.

If you need any other information please contact me by phone at 724-626-2243.


Respectfully,

A handwritten signature in cursive script that reads 'Kathleen D Schiller'.

Kathleen D. Schiller

Cc: Michelle Cunningham, CEO

*139050*  
NMSS/RONI MATERIALS-002

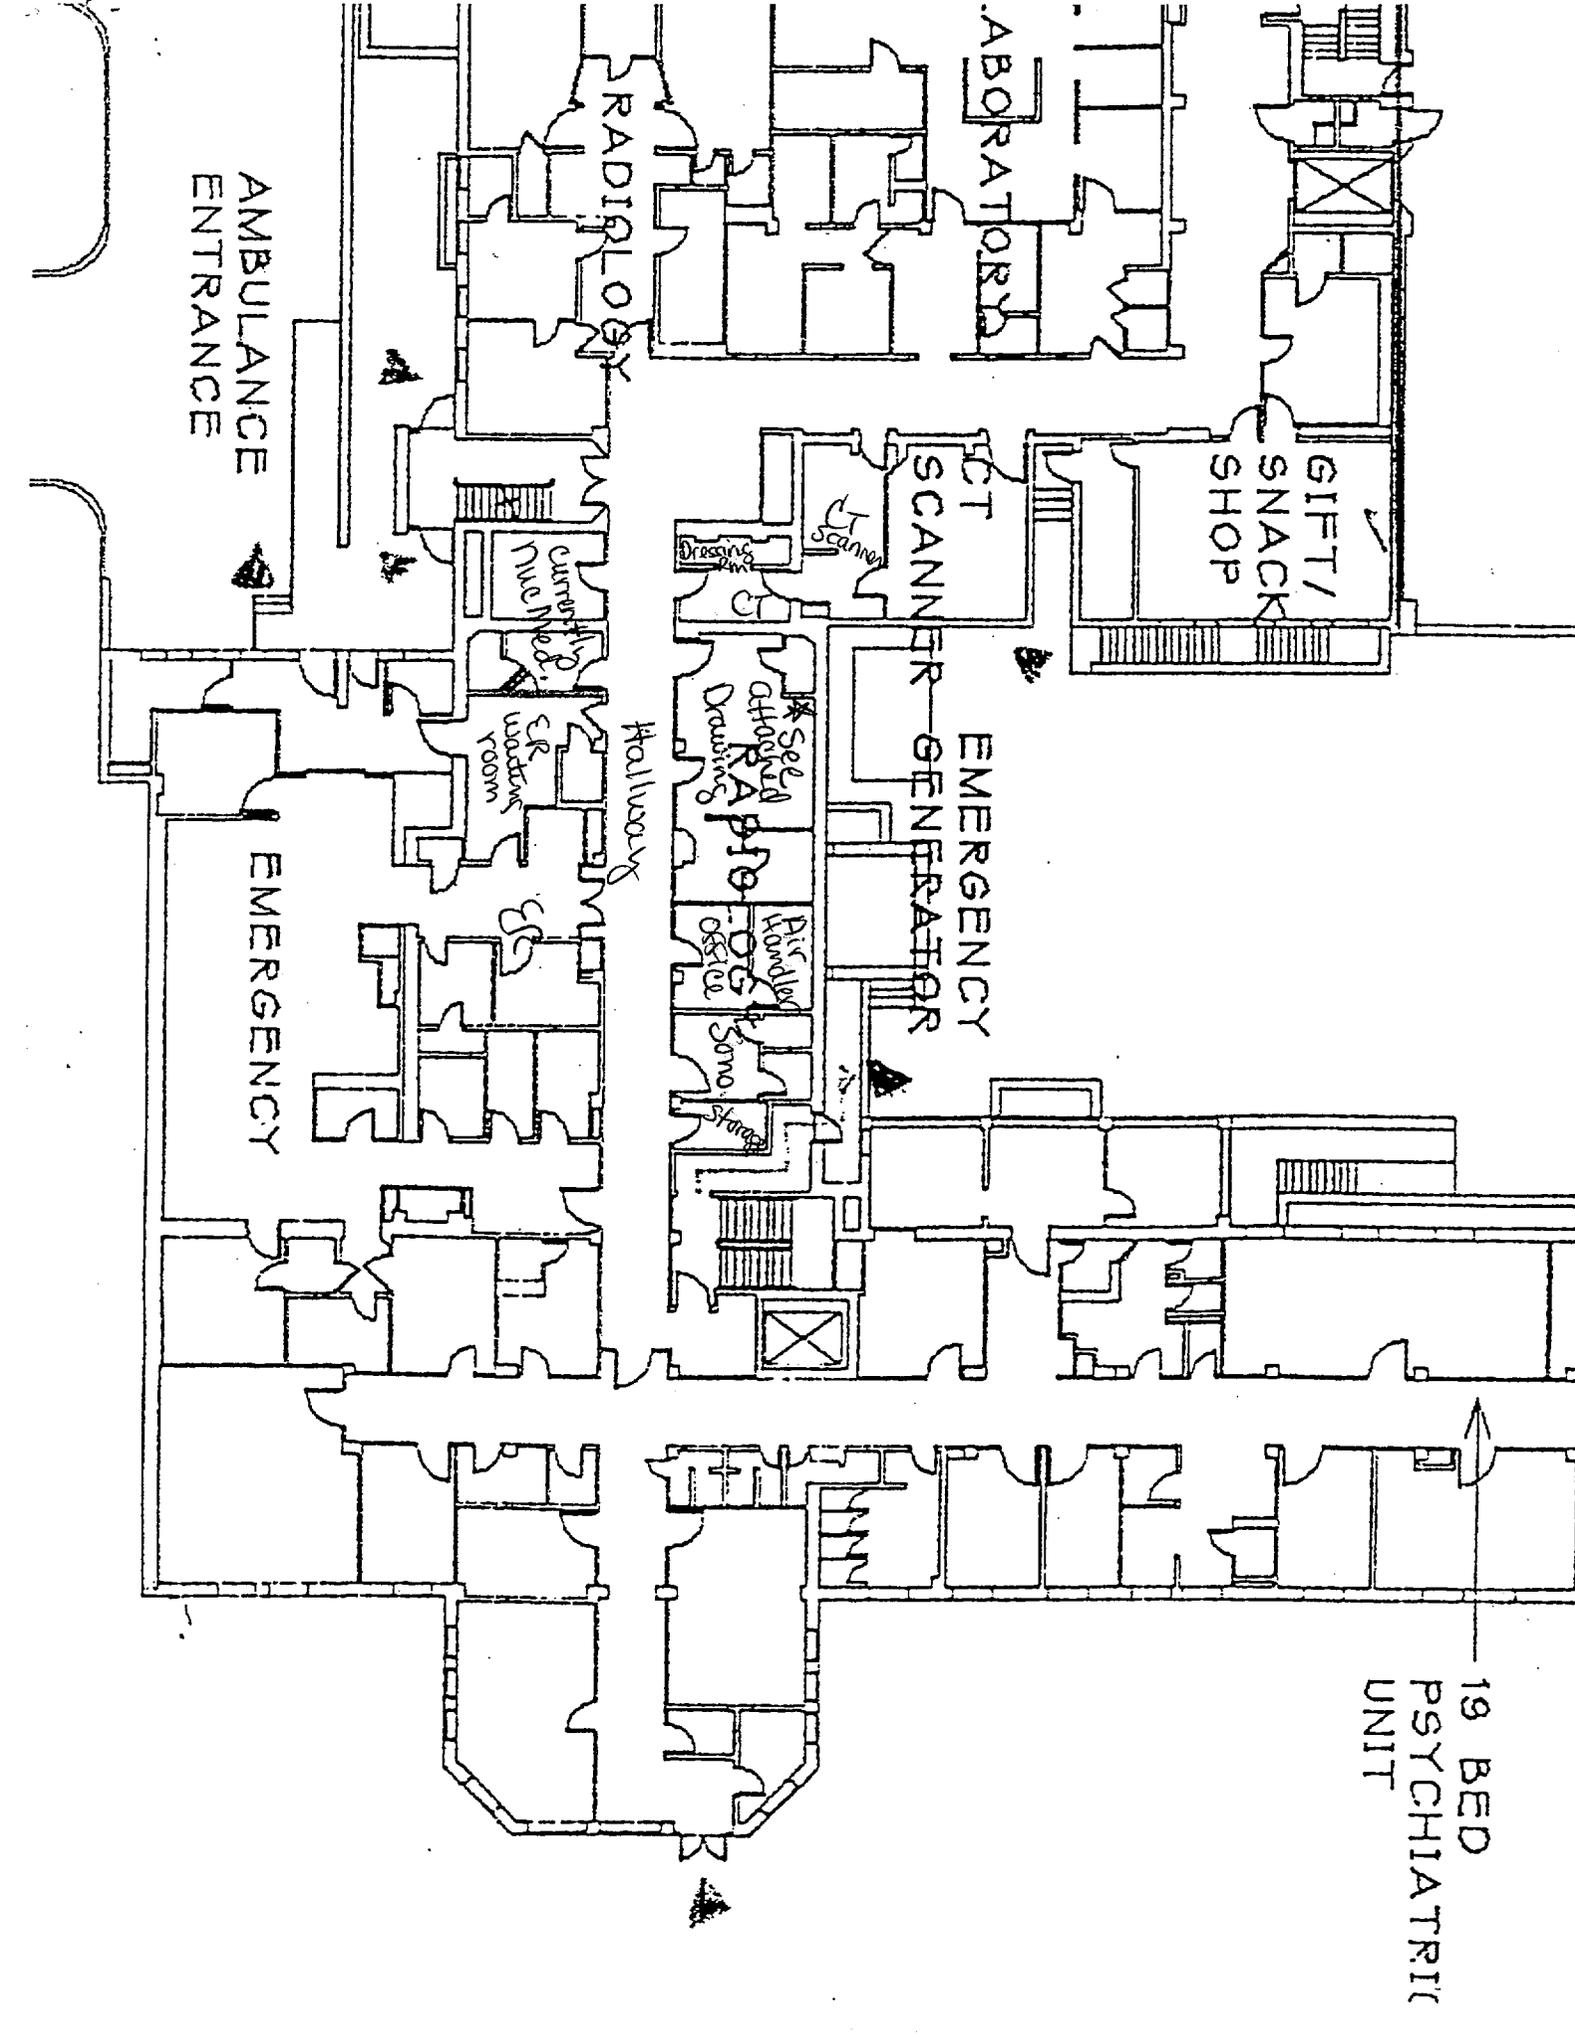

AMBULANCE  
ENTRANCE

RADIOLOGY

LABORATORY

GIFT/  
SNACK  
SHOP

CT  
SCANNER

EMERGENCY  
GENERATOR

Hallway


EMERGENCY

19 BED  
PSYCHIATRIC  
UNIT

### FINAL LAYOUT REVIEW

I HAVE REVIEWED THE ATTACHED PLAN(S) AND UNDERSTAND AND AGREE TO THE PROPOSED EQUIPMENT ARRANGEMENT. I HEREBY AUTHORIZE THE PREPARATION OF A COMPLETE SET OF PLANS BASED ON THESE PLANS. I AM AWARE THAT ANY CHANGES MADE AFTER THIS DATE COULD RESULT IN ADDITIONAL EXPENSES BEING INCURRED.

NAME: \_\_\_\_\_ DATE: \_\_\_\_\_

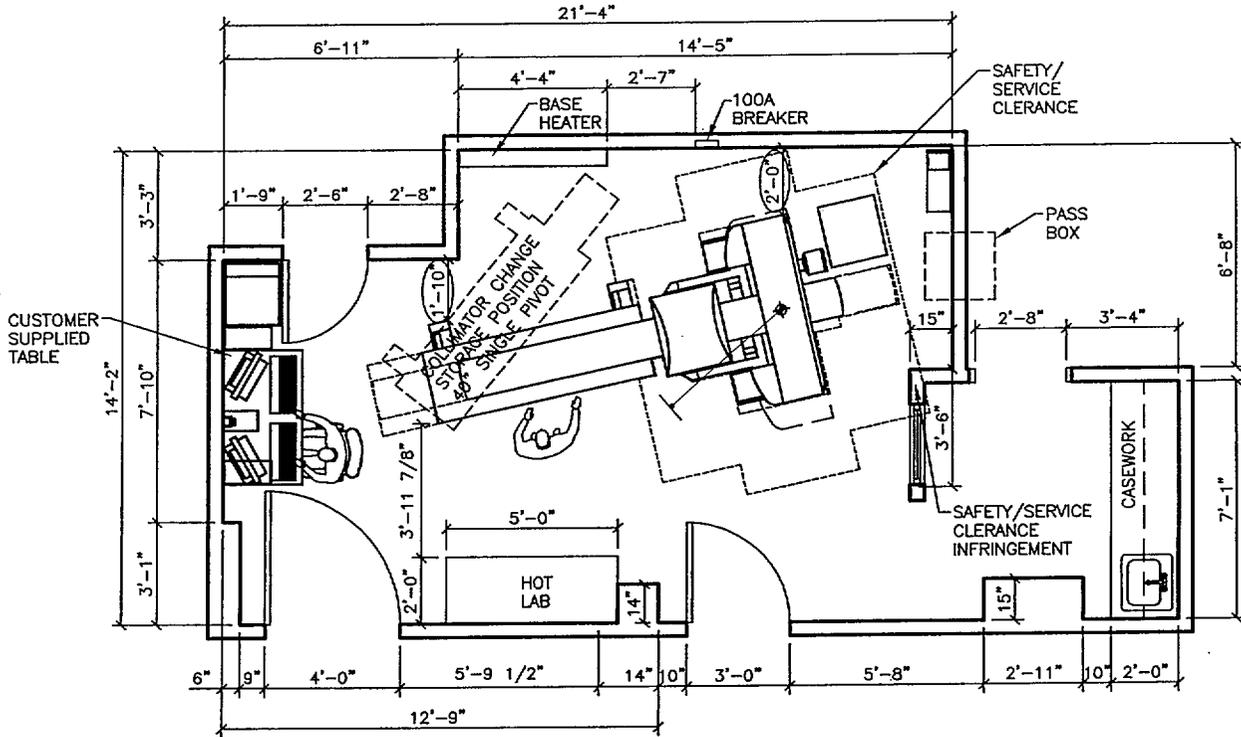

COLLIMATOR CART LOCATED AT CUSTOMER DISCRETION

SAFETY/SERVICE CLEARANCE ARE INFRINGED ON BUT WILL NOT AFFECT THE CAMERA'S FUNCTION.

CIRCLED DIMENSIONS ARE INADEQUATE SPACE FOR WALKING PATHS.

PM MUST VERIFY ALL DIMENSIONS

Per telephone conversation on 6-27-06 with Kathy Schiller, Radiology Manager, Siemens has authorized release of this document.

Abbaheel  
6-27-06

### PRELIMINARY EQUIPMENT PLAN

SCALE: 3/16" = 1'-0"

|                  |          |                               |                                                                                                                                                      |         |                |          |
|------------------|----------|-------------------------------|------------------------------------------------------------------------------------------------------------------------------------------------------|---------|----------------|----------|
|                  |          |                               | PROJECT MANAGER: ROBERT ENGLISH<br>TEL: (610) 325-6640<br>VMAIL: (800) 876-8086 EXT:3055<br>FAX: (724) 846-8722<br>EMAIL: ROBERT.ENGLISH@SIEMENS.COM |         | <b>SIEMENS</b> |          |
|                  |          |                               | <b>HIGHLANDS HOSPITAL AND HEALTH CENTER</b><br>401 EAST MURPHY AVENUE CONNELLSVILLE, PA 15425<br>EXTENDED GANTRY ECAM VARIABLE                       |         |                |          |
| △                | 06/19/06 | ROOM DIMENSIONS CHANGED - CLM | THE USE OR REPRODUCTION OF THIS TITLE BLOCK WITHOUT SIEMENS' AUTHORIZATION WILL RESULT IN PROSECUTION UNDER FULL EXTENT OF THE LAW.                  |         | PROJECT #:     | SHEET:   |
| △                | 06/13/06 | ORIGINAL PRELIM LAYOUT - CLM  |                                                                                                                                                      |         | 06ERE43        | R-101A   |
| SYM              | DATE     | DESCRIPTION                   | SCALE:                                                                                                                                               | REF. #: | DATE:          | CHECKED: |
| -REVISION BLOCK- |          |                               | AS NOTED                                                                                                                                             | 1-4KFR  | 06/19/06       |          |

This is to acknowledge the receipt of your letter/application dated

6/21/2006, and to inform you that the initial processing which includes an administrative review has been performed.

APPROV. 37-30517-01  
There were no administrative omissions. Your application was assigned to a technical reviewer. Please note that the technical review may identify additional omissions or require additional information.

Please provide to this office within 30 days of your receipt of this card

---

A copy of your action has been forwarded to our License Fee & Accounts Receivable Branch, who will contact you separately if there is a fee issue involved.

Your action has been assigned Mail Control Number 139050.  
When calling to inquire about this action, please refer to this control number.  
You may call us on (610) 337-5398, or 337-5260.