



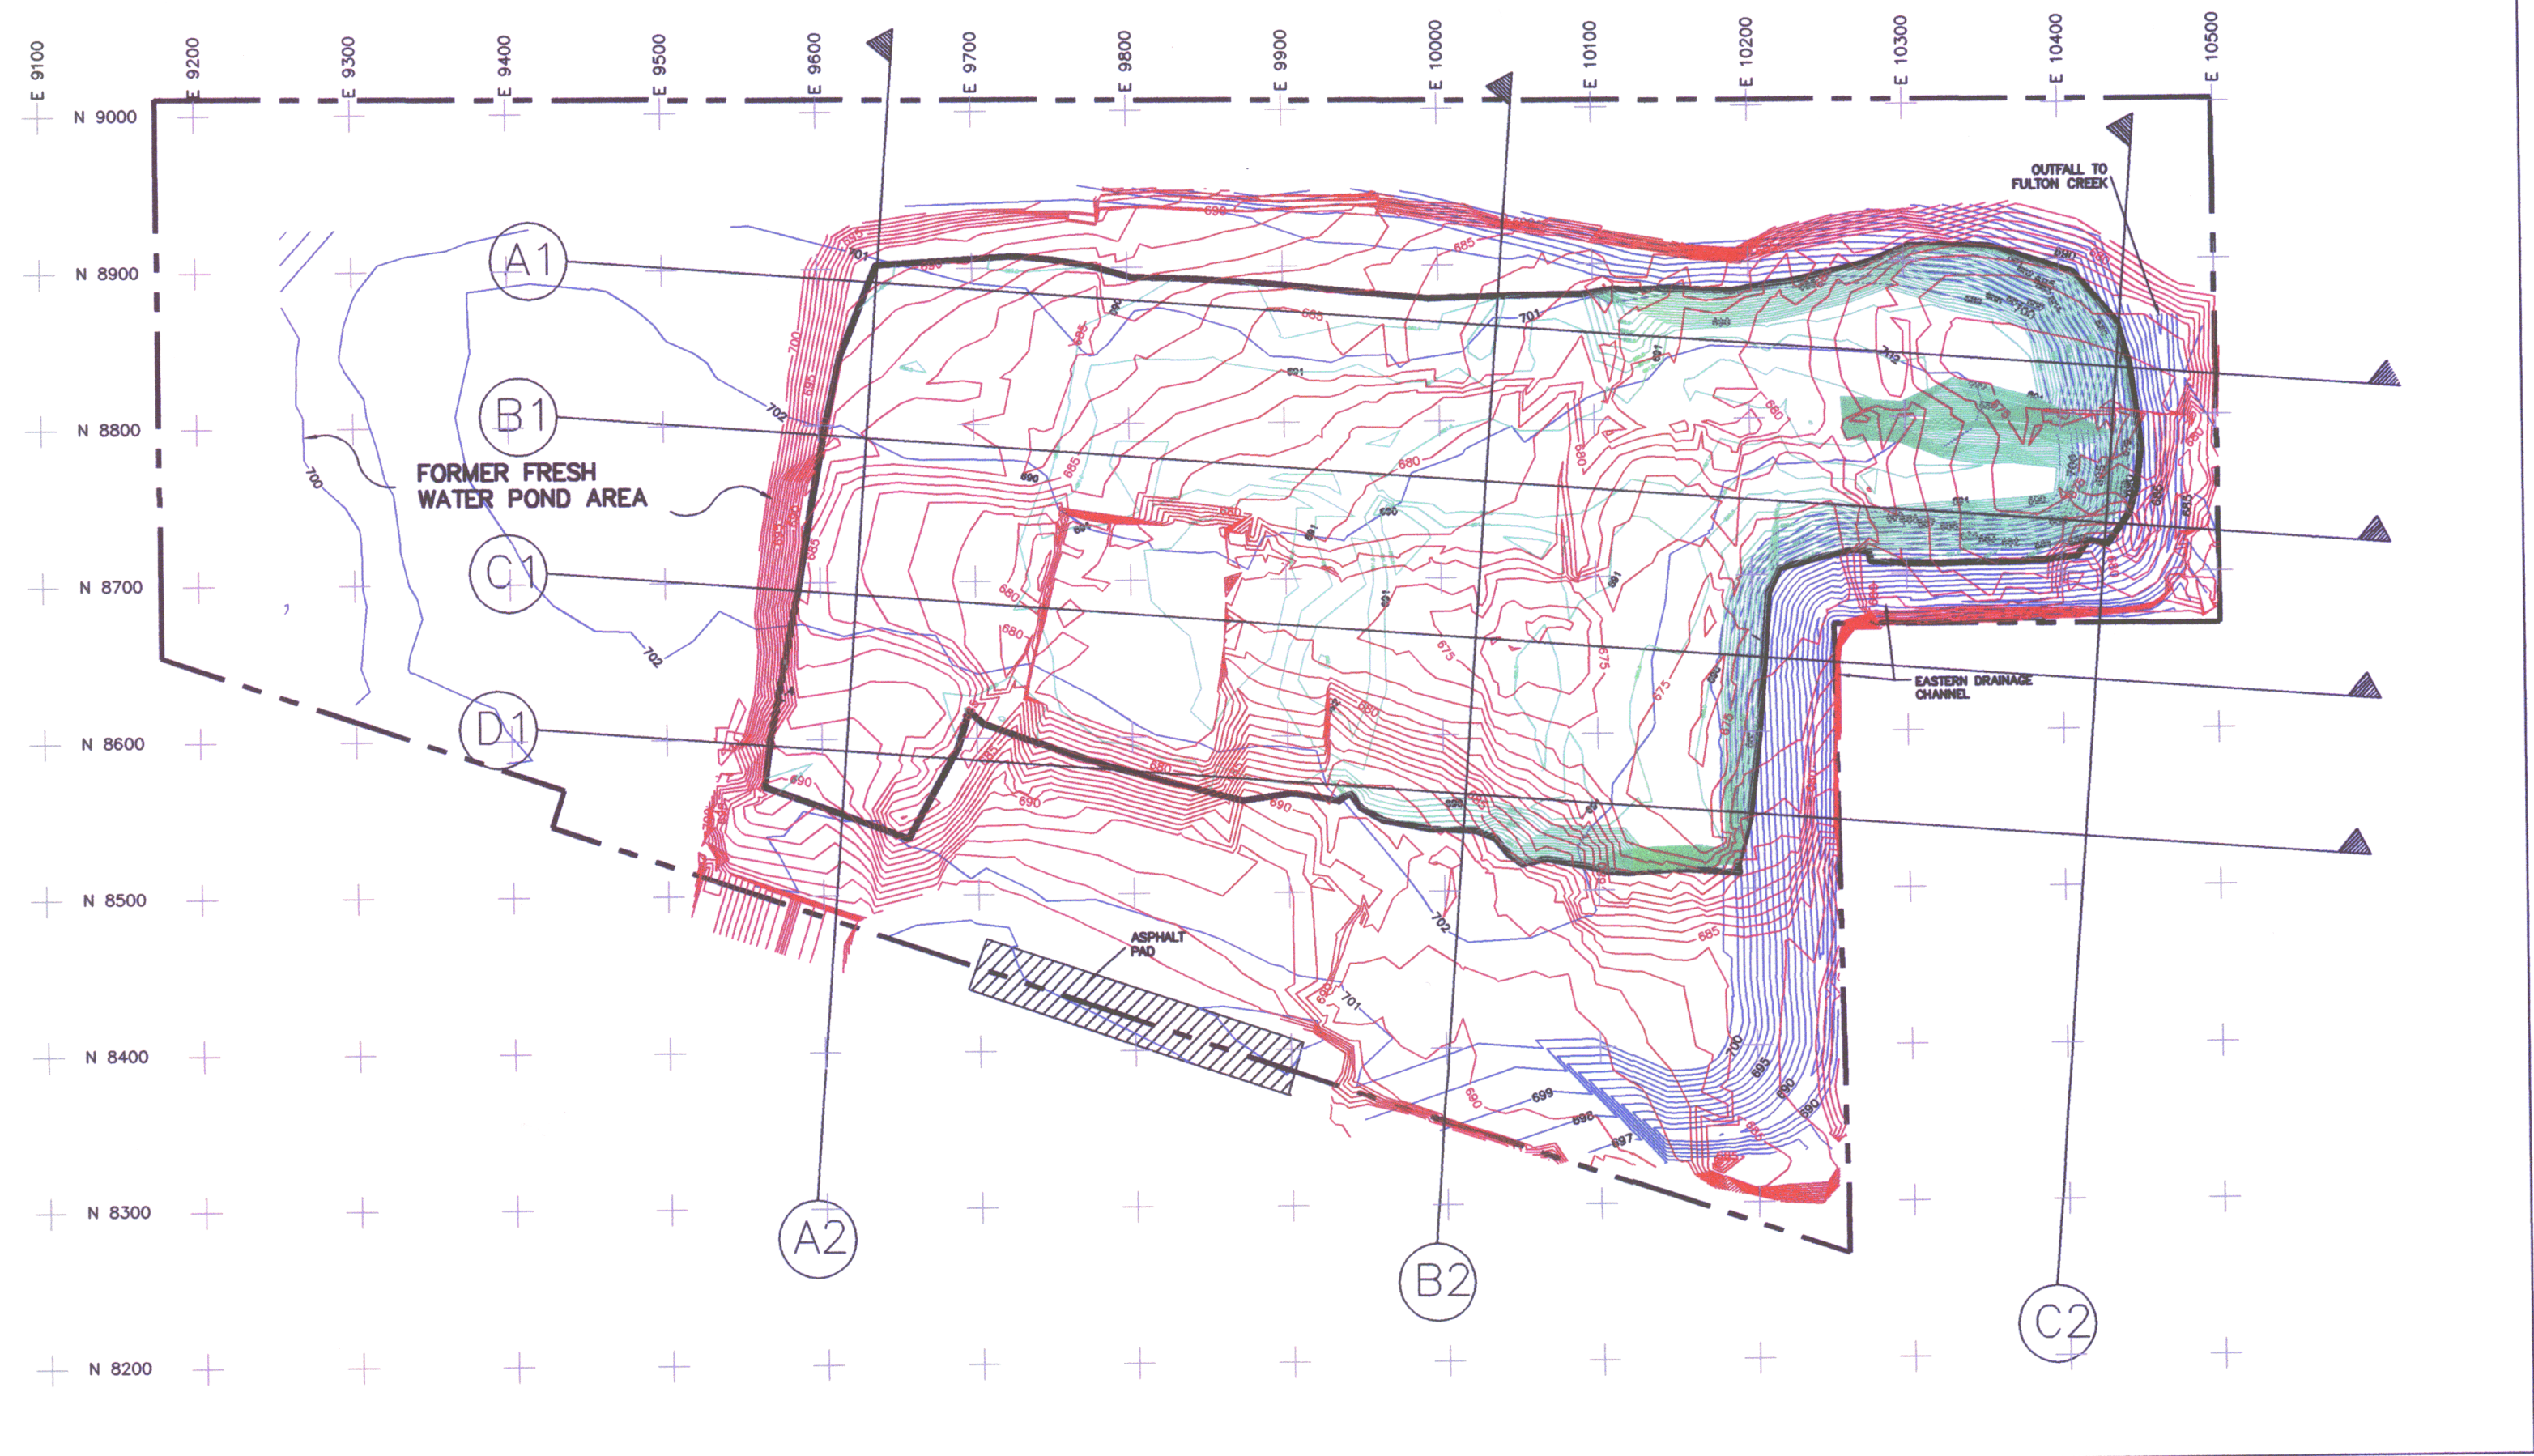

- LEGEND**
- FINAL GRADE AS-BUILT
 - EXCAVATION BOTTOM AS-BUILT
 - TOP OF BCM AS-BUILT
 - LATERAL EXTENT OF BCM PLACEMENT
 - PROPERTY LINE
 - POND PARCEL EXCAVATION/BACKFILL CROSS SECTION LOCATION

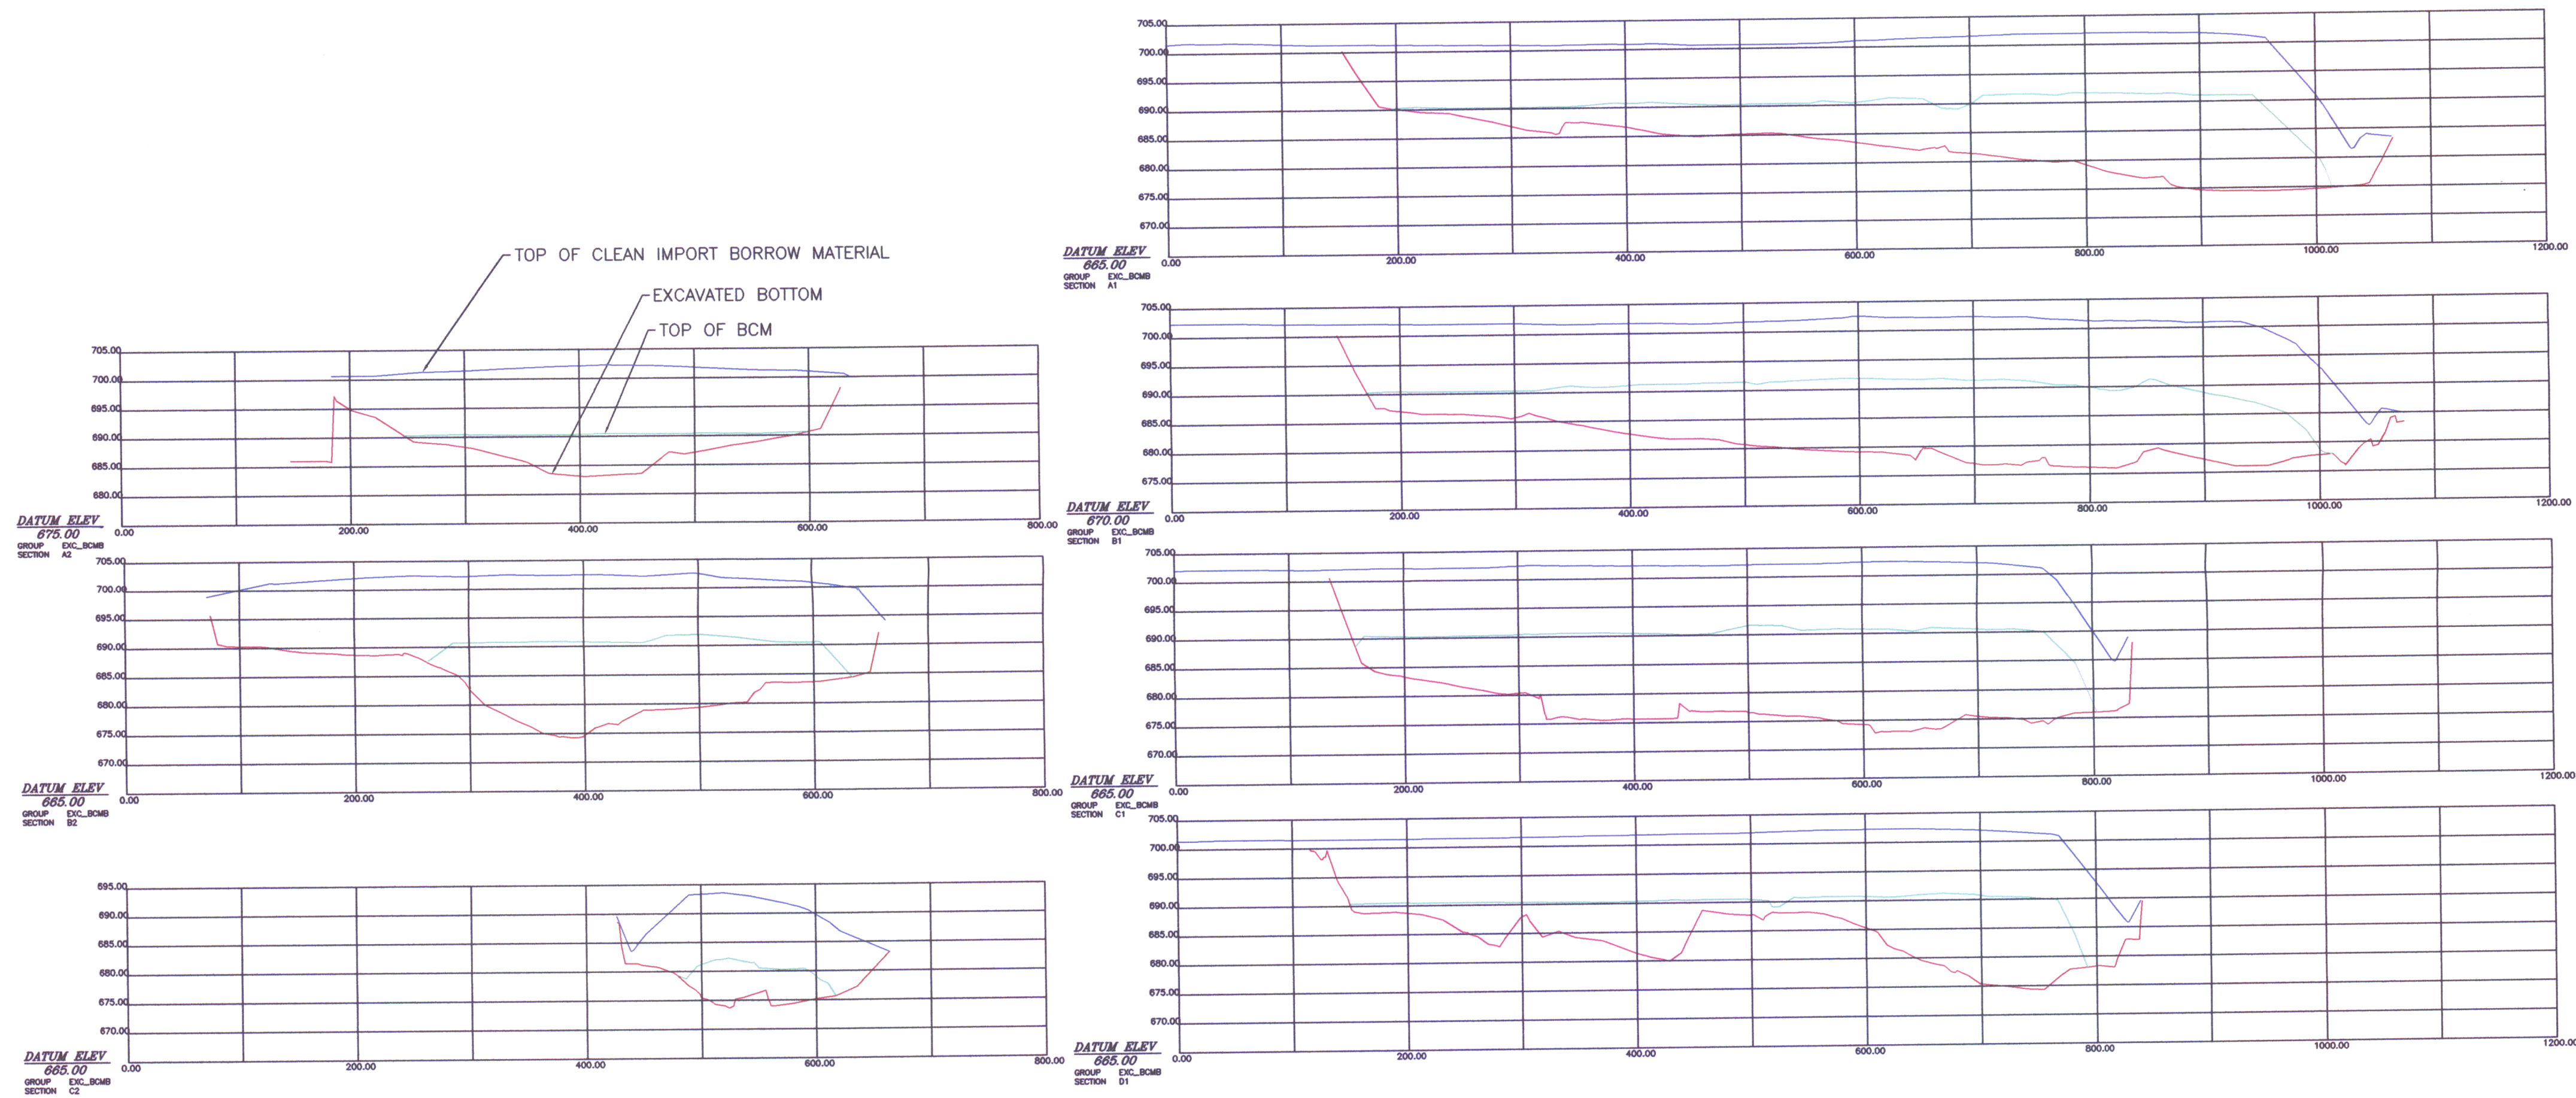

REFERENCE
RECON DRAWING "AS-BUILT OF EXCAVATED BOTTOM,
BCM, FINAL GRADE, AND TOP CROSS SECTIONS", DATED 9-14-06.

SCALE - FEET
0 100 200 300

REVISION	DATE	DESCRIPTION
FIGURE G-3 CROSS SECTIONS POND PARCEL THORIUM REMEDIATION PROJECT TULSA, OKLAHOMA FACILITY		
PREPARED FOR KAISER ALUMINUM & CHEMICAL CORPORATION TULSA, OKLAHOMA		
APPROVED	RFD 9-14-06	 Penn E&R Environmental & Remediation, Inc.
CHECKED	RFD 9-14-06	
DRAWN	DEB 9-13-06	
DRAWING NUMBER PA4072406		