



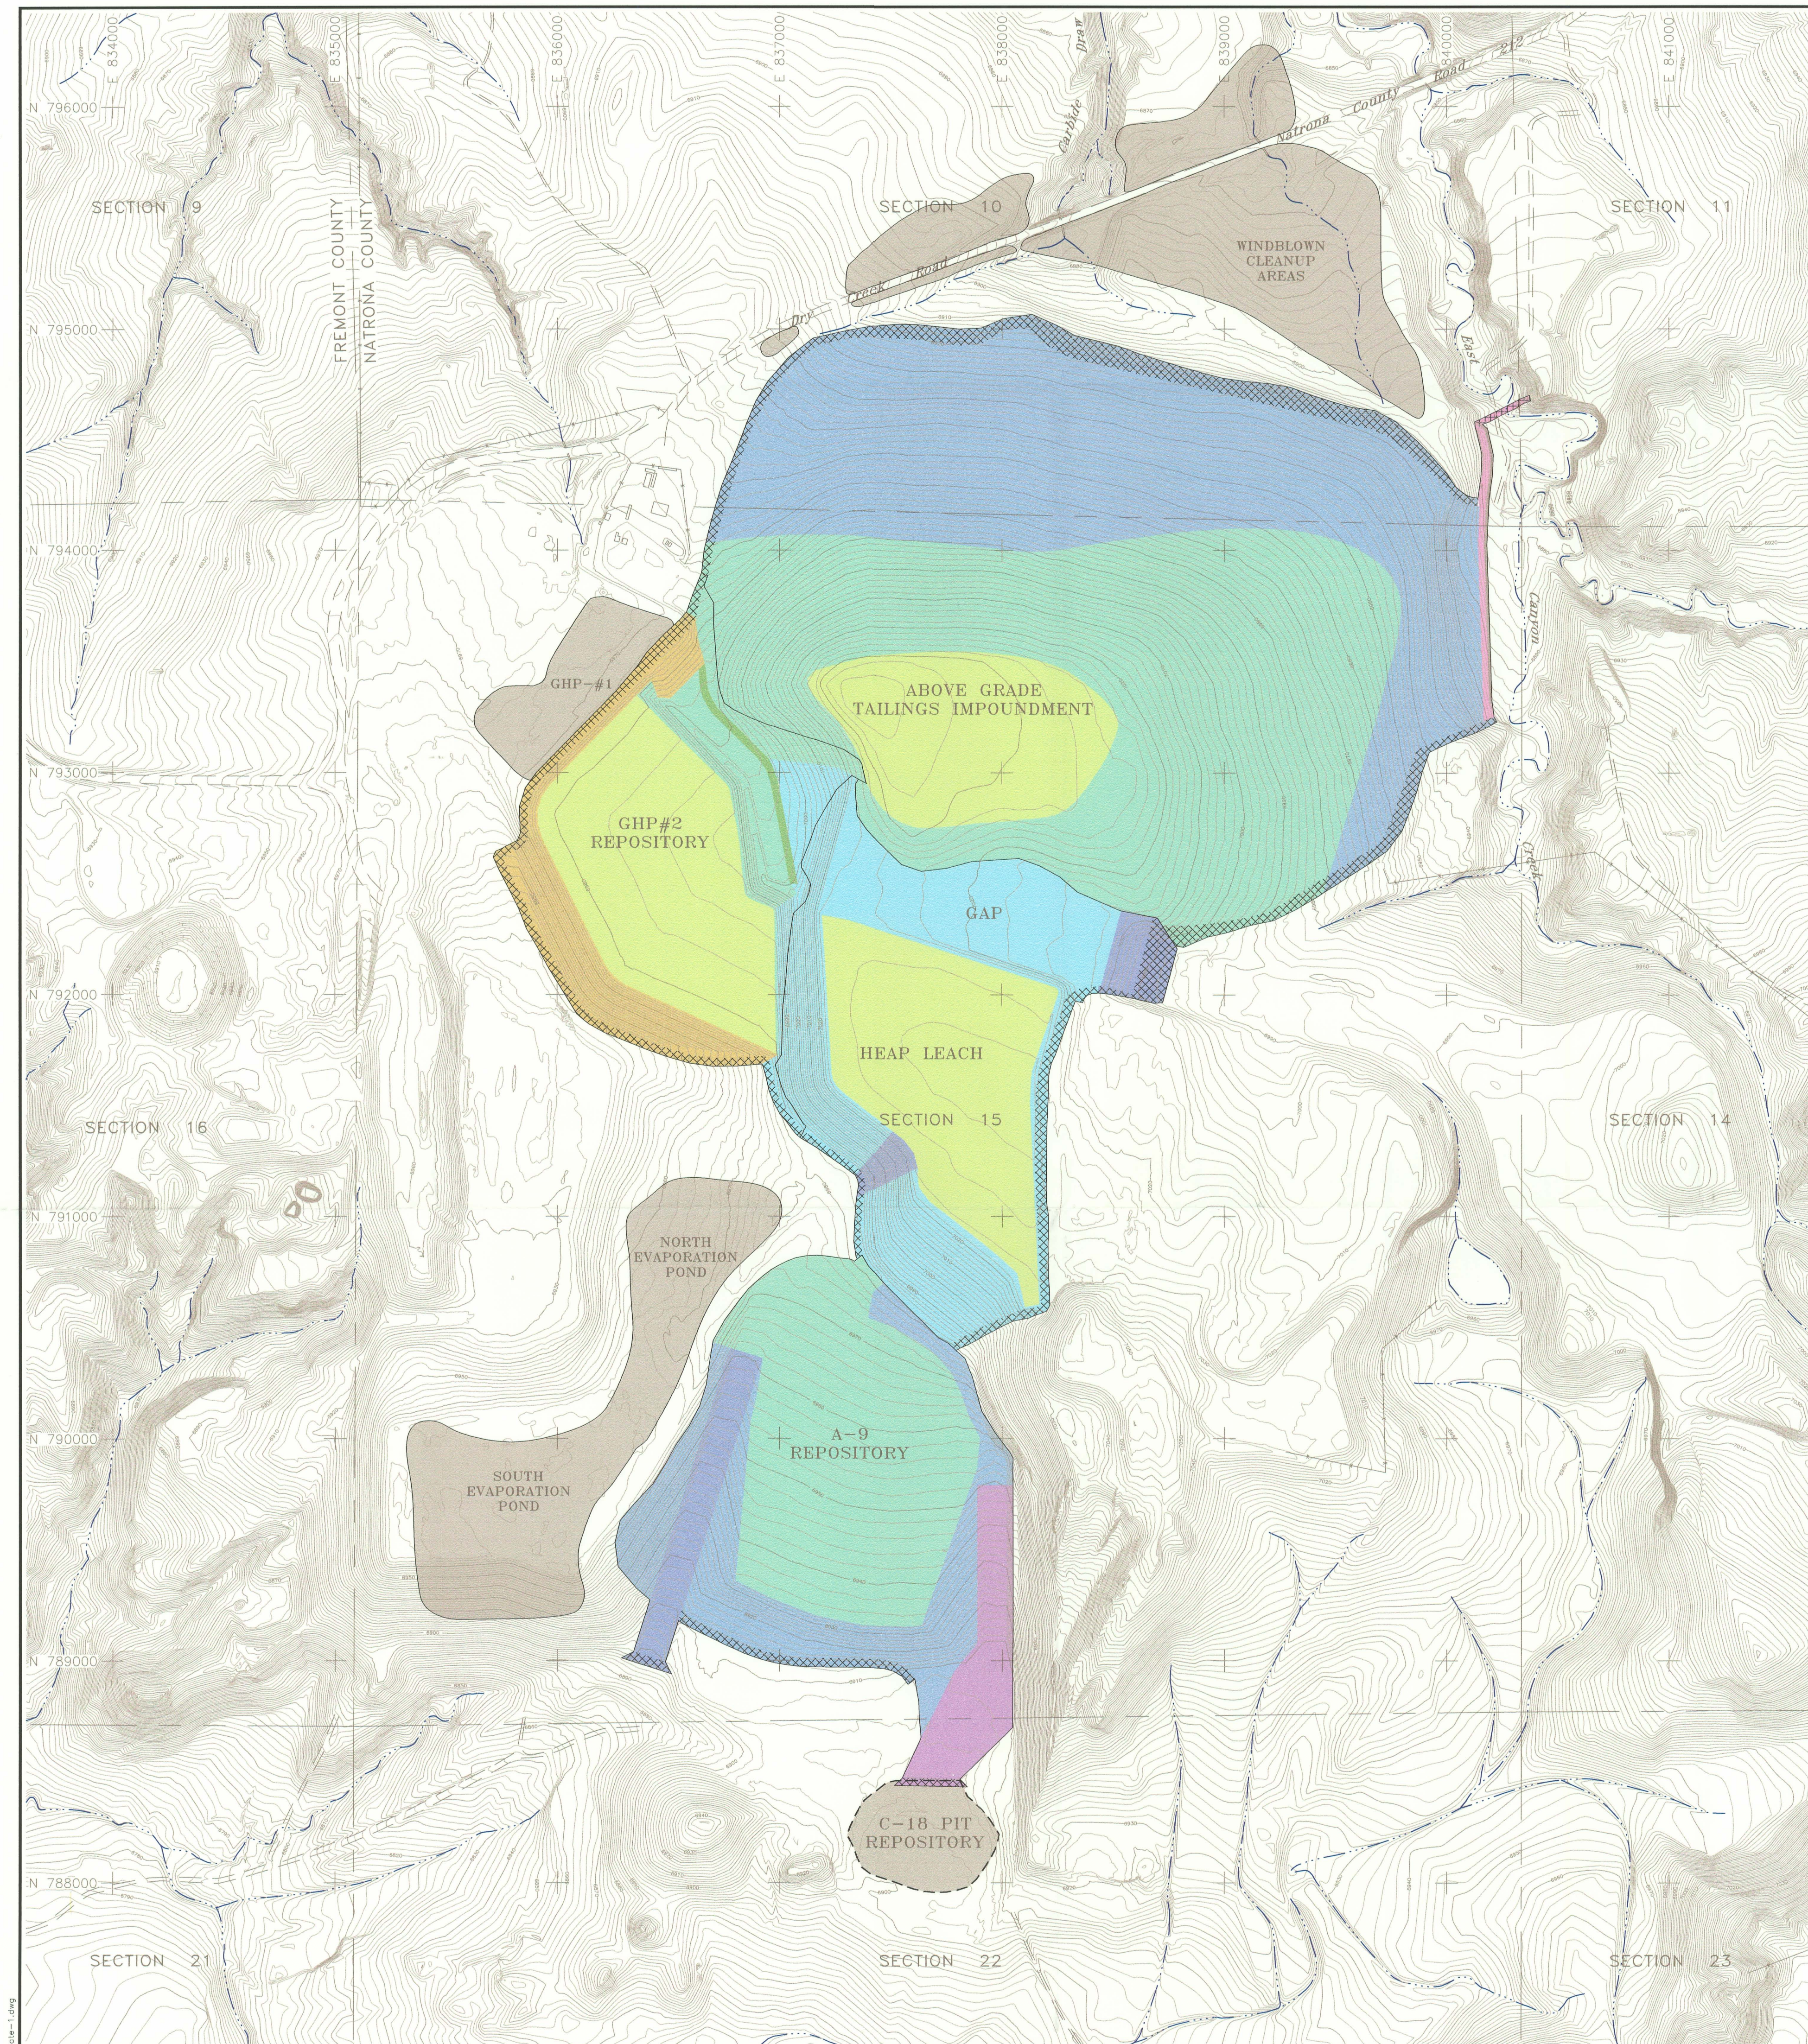

LEGEND

- 7000
DRAINAGE PATH/PONDED WATER
UN-PAVED ROADS
UMETCO 1000' SITE GRID
- 6-INCHES OF RIPRAP TYPE "A" $D_{50} = 0.5$ INCH
6-INCHES OF RIPRAP TYPE "B" $D_{50} = 3.0$ INCH
6-INCHES OF RIPRAP TYPE "B" $D_{50} = 3.0$ INCH
WITH 6-INCHES OF FILTER TYPE "A" $D_{50} = 0.5$ INCH
6-INCHES OF RIPRAP TYPE "B" $D_{50} = 3.0$ INCH
WITH 3-INCHES OF FILTER TYPE "A" $D_{50} = 0.5$ INCH
12-INCHES OF RIPRAP TYPE "C" $D_{50} = 6.0$ INCH
12-INCHES OF RIPRAP TYPE "C" $D_{50} = 6.0$ INCH
WITH 6-INCHES OF FILTER TYPE "A" $D_{50} = 0.5$ INCH
10-INCHES OF RIPRAP TYPE "C" $D_{50} = 6.0$ INCH
WITH 3-INCHES OF FILTER TYPE "A" $D_{50} = 0.5$ INCH
24-INCHES OF RIPRAP TYPE "D" $D_{50} = 16.0$ INCH
WITH 6-INCHES OF FILTER TYPE "A" $D_{50} = 0.5$ INCH
LAUNCHED STONE EMBANKMENT TYPE "E" $D_{50} = 30.0$ INCH
BELOW-GRADE APRON

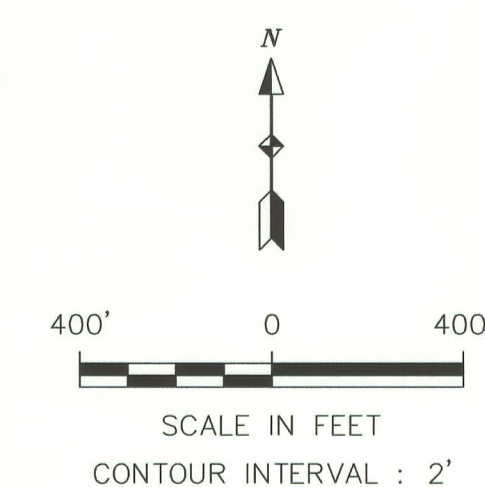

Umetco Minerals Corporation
2754 COMPASS DRIVE, SUITE 280, GRAND JUNCTION, CO 81506

AS BUILT

FINAL SITE PLAN
REFLECTING
CONSTRUCTION COMPLETION

GAS HILLS, WYOMING

JUNE 2007

PLATE 1

D-01