






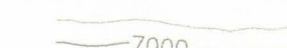



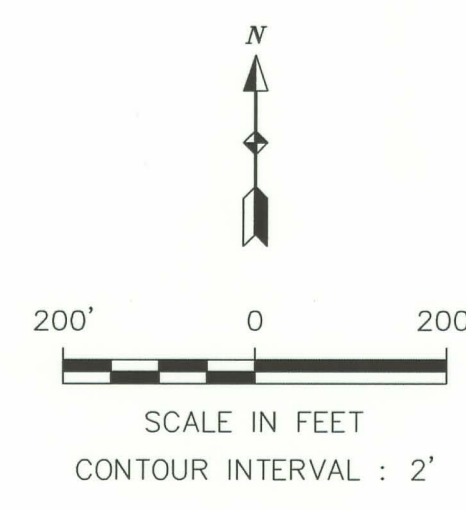



LEGEND:

-  EXISTING 1997 AERIAL TOPOGRAPHY
-  DRAINAGE PATH/PONDED WATER
-  UN-PAVED ROADS
-  UMETCO 1000' SITE GRID
-  FINISH GRADE TOPOGRAPHY
-  CONTAMINATED FILL AREA
-  LIMIT OF A-9 REPOSITORY
-  CONTAMINATED SOILS
-  C201-208
CONTAMINATED FILL COMPACTION TEST LOCATIONS. 2001 FILL MATERIAL FROM THE RESHAPING OF THE EXISTING A-9 REPOSITORY CONTAMINATED FILL, THE STOCKPILED FILL FROM THE GHP-1 LINER REMOVAL, AND THE WINDBLOWN CLEANUP MATERIAL. FILL MATERIAL PLACED, COMPACTED AND TESTED IN 1 FOOT LIFTS - APPROX. 8 LIFTS
-  C209-222
CONTAMINATED FILL COMPACTION TEST LOCATIONS. 2002 FILL MATERIAL FROM THE RESHAPING OF THE EXISTING A-9 REPOSITORY CONTAMINATED FILL, CONTAMINATED FILL FROM THE CONSTRUCTION WATER PIPELINE TRENCH CLEANUP, THE GHP-1 CLEANUP AREA AND THE WINDBLOWN CLEANUP MATERIAL. FILL MATERIAL PLACED, COMPACTED AND TESTED IN 1 FOOT LIFTS - APPROX. 22 LIFTS
-  C223-235
CONTAMINATED FILL COMPACTION TEST LOCATIONS. 2003 FILL MATERIAL FROM THE RESHAPING OF THE EXISTING A-9 REPOSITORY CONTAMINATED FILL. FILL MATERIAL PLACED, COMPACTED AND TESTED IN 1 FOOT LIFTS - APPROX. 8 LIFTS

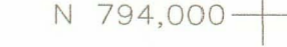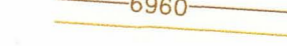

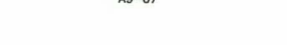 Umetco Minerals Corporation <small>2754 COMPASS DRIVE, SUITE 280, GRAND JUNCTION, CO 81506</small>
AS BUILT
A-9 REPOSITORY 2001, 2002 AND 2003 COMPACTION TEST LOCATIONS CONTAMINATED FILL AREA
GAS HILLS, WYOMING
DATE: JUNE 2007 DWG: GH-A9-04-AB SHEET 4 OF 12

D-04