


LEGEND:

	EXISTING 1997 AERIAL TOPOGRAPHY
	DRAINAGE PATH/PONDED WATER
	UN-PAVED ROADS
	UMETCO 1000' SITE GRID
	FINISH GRADE TOPOGRAPHY RADON BARRIER FILL AREA
	LIMIT OF RADON BARRIER SOILS
	RADON BARRIER FILL COMPACTION TEST LOCATION - FIRST LIFT
	RADON BARRIER FILL COMPACTION TEST LOCATION - SECOND LIFT
	RADON BARRIER FILL COMPACTION TEST LOCATION - THIRD LIFT

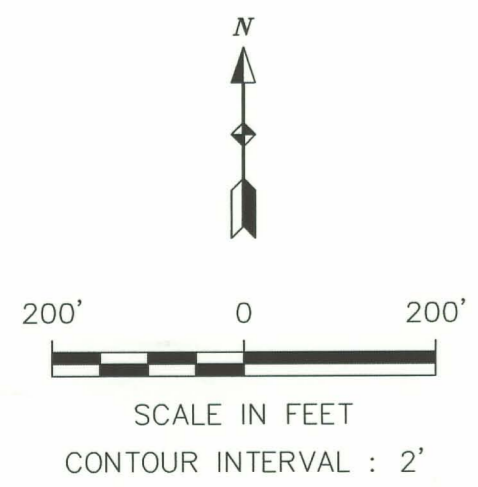

Umetco Minerals Corporation
2754 COMPASS DRIVE, SUITE 280, GRAND JUNCTION, CO 81506

AS BUILT

**A-9 REPOSITORY
COMPACTION TEST LOCATIONS
RADON BARRIER**

GAS HILLS, WYOMING

DATE: JUNE 2007 dwg: GH-AG-06-AB SHEET 6 OF 12

D-06