


- PROFILE LEGEND:**
- EXISTING GRADE 1997 AERIAL TOPOGRAPHY
  - TOP OF THE CONTAMINATED FILL
  - 18" RADON BARRIER
  - 54" FROST PROTECTION FILL
  - FINISHED GRADING OUTSIDE REPOSITORY
  - 6" EROSION PROTECTION TYPE A BEDDING

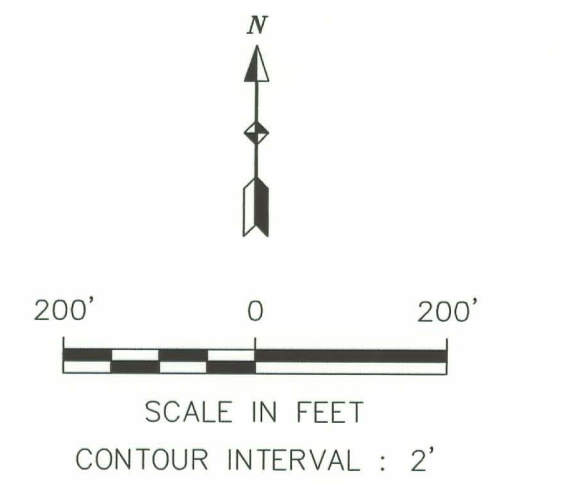

- LEGEND:**
- 2000 AERIAL TOPOGRAPHY UPDATED WITH 2006 SURVEYS
  - DRAINAGE PATH/PONDED WATER
  - UN-PAVED ROADS
  - UMETCO 1000' SITE GRID
  - FINISH GRADE TOPOGRAPHY OF THE A-9 REPOSITORY FROST PROTECTION LAYER
  - FINISH GRADE TOPOGRAPHY OF THE A-9 REPOSITORY TOE APRON EXCAVATION
  - TYPE "A" RIPRAP BEDDING SURVEY VERIFICATION POINT
  - LIMIT OF RADON BARRIER SOILS
- EROSION PROTECTION**
- 6-INCHES OF TYPE "A" BEDDING  
D<sub>50</sub> = 0.5 INCH

**Umetco Minerals Corporation**  
2754 COMPASS DRIVE, SUITE 280, GRAND JUNCTION, CO 81506

**AS BUILT**

**A-9 REPOSITORY  
SURVEY VERIFICATION POINTS  
TYPE "A" BEDDING  
EROSION PROTECTION PLACEMENT**

**GAS HILLS, WYOMING**

DATE: JUNE 2007    DWG: GH-A9-10-AB    SHEET 10 OF 12

D-10