




SHEET NO.	TITLE
1 OF 4	FINAL C-18 PIT RECLAMATION SITE PLAN REFLECTING POST-RECLAMATION CONSTRUCTION FINAL GRADES
2 OF 4	RECLAMATION OF THE C-18 PIT COMPACTION TEST LOCATIONS BACKFILL MATERIAL ELEVATION 6844 TO ELEVATION 6863
3 OF 4	RECLAMATION OF THE C-18 PIT COMPACTION TEST LOCATIONS BACKFILL MATERIAL ELEVATION 6864 TO ELEVATION 6883
4 OF 4	RECLAMATION OF THE C-18 PIT FINAL CONTOURS AND COMPACTION TEST LOCATIONS BACKFILL MATERIAL ELEVATION 6884 TO ELEVATION 6902

LEGEND

- 7000 2006 FINISHED GRADE TOPOGRAPHY
- DRAINAGE PATH/PONDED WATER
- UN-PAVED ROADS
- N 794,000 UMETCO 1000' SITE GRID
- C-18 BOUNDARY

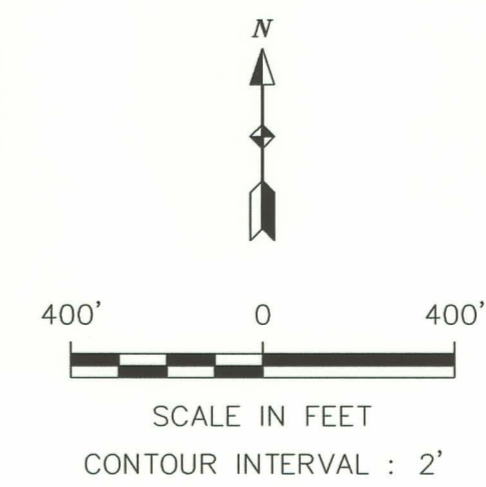

<p>Umetco Minerals Corporation 2754 COMPASS DRIVE, SUITE 280, GRAND JUNCTION, CO 81506</p>	
<p>AS BUILT</p>	
<p>FINAL C-18 PIT RECLAMATION SITE PLAN REFLECTING POST-RECLAMATION CONSTRUCTION FINAL GRADES</p>	
<p>GAS HILLS, WYOMING</p>	
DATE: JUNE 2007	SHEET 1 OF 4

D-13