





PROFILE LEGEND:


- EXISTING GRADE 1997 TOPOGRAPHY
- EXISTING RADON BARRIER
- TOP OF THE CONTAMINATED FILL
- 18" NEW RADON BARRIER
- NEW FROST PROTECTION MATERIAL
- TYPE "A" BEDDING
D₅₀ = 0.5-INCH

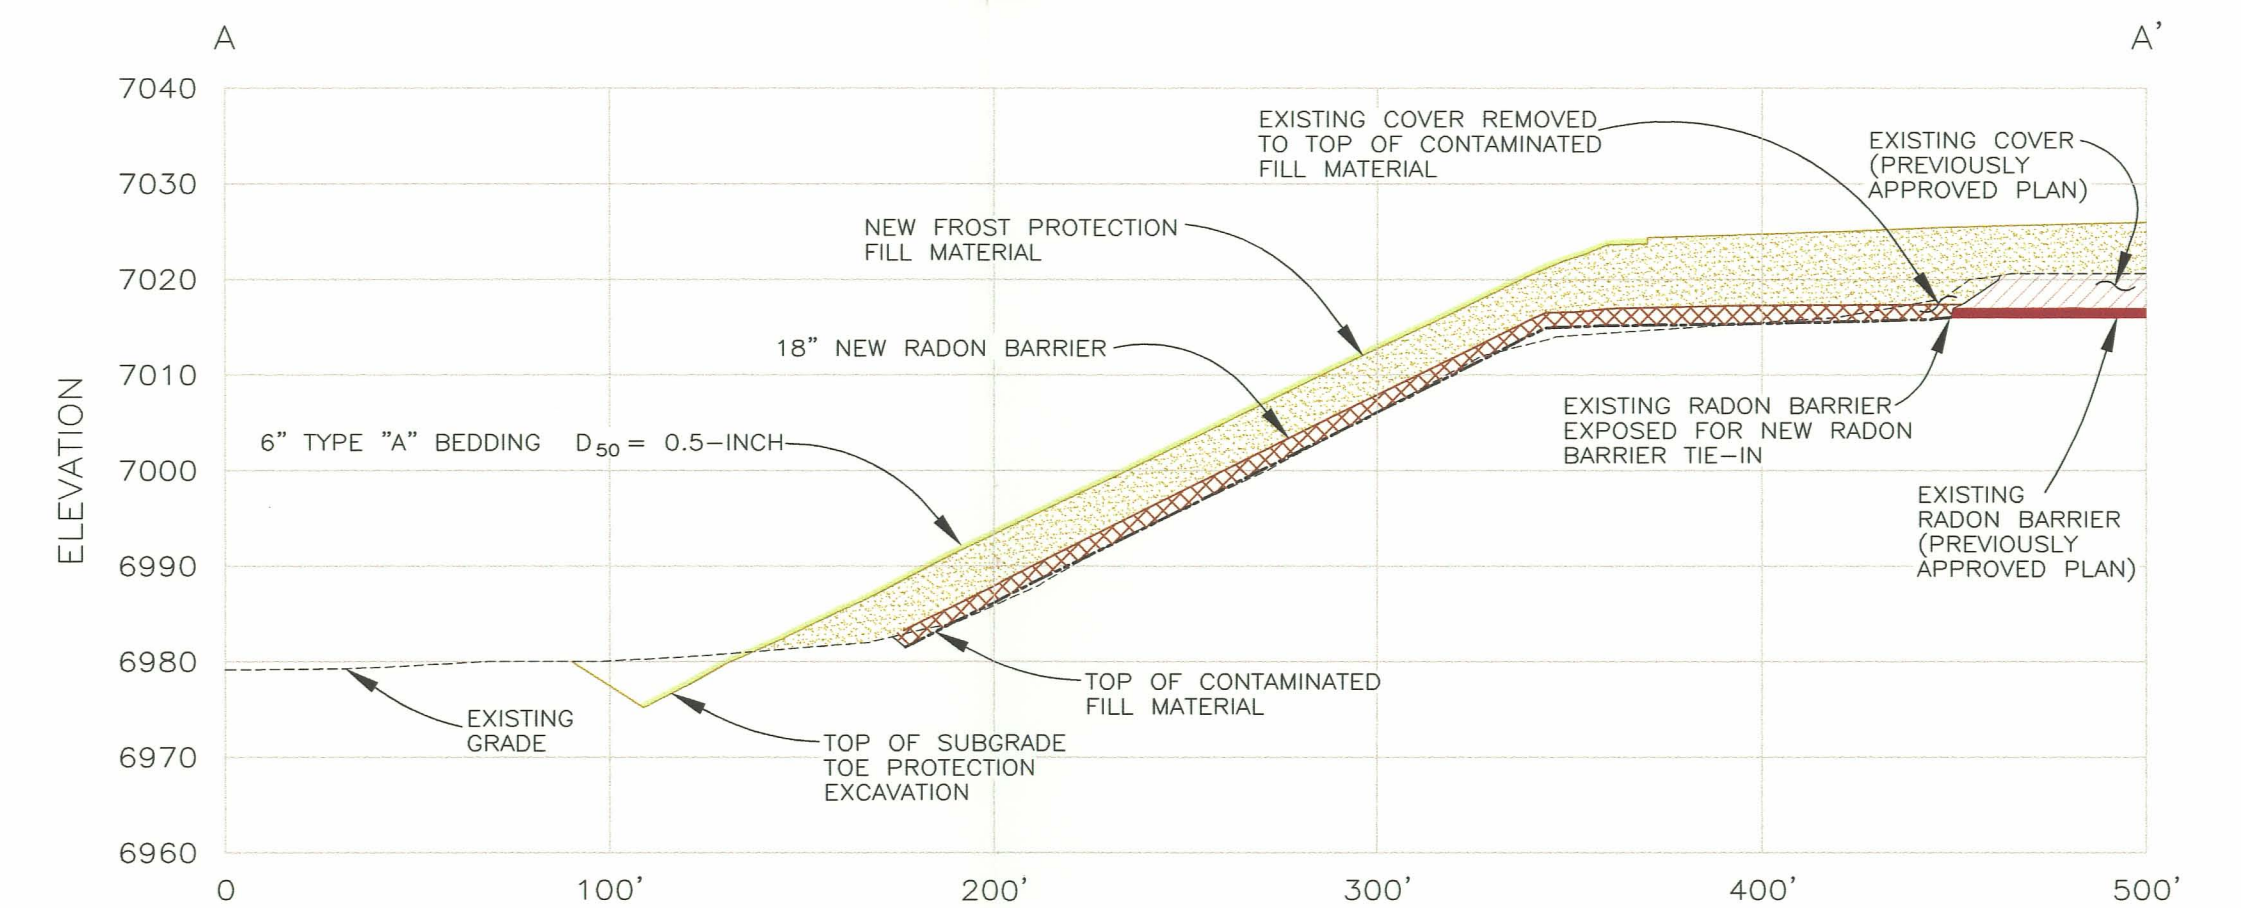


SECTION A-A'
SCALE: HORIZ. 1" = 50'
VERT. 1" = 20'

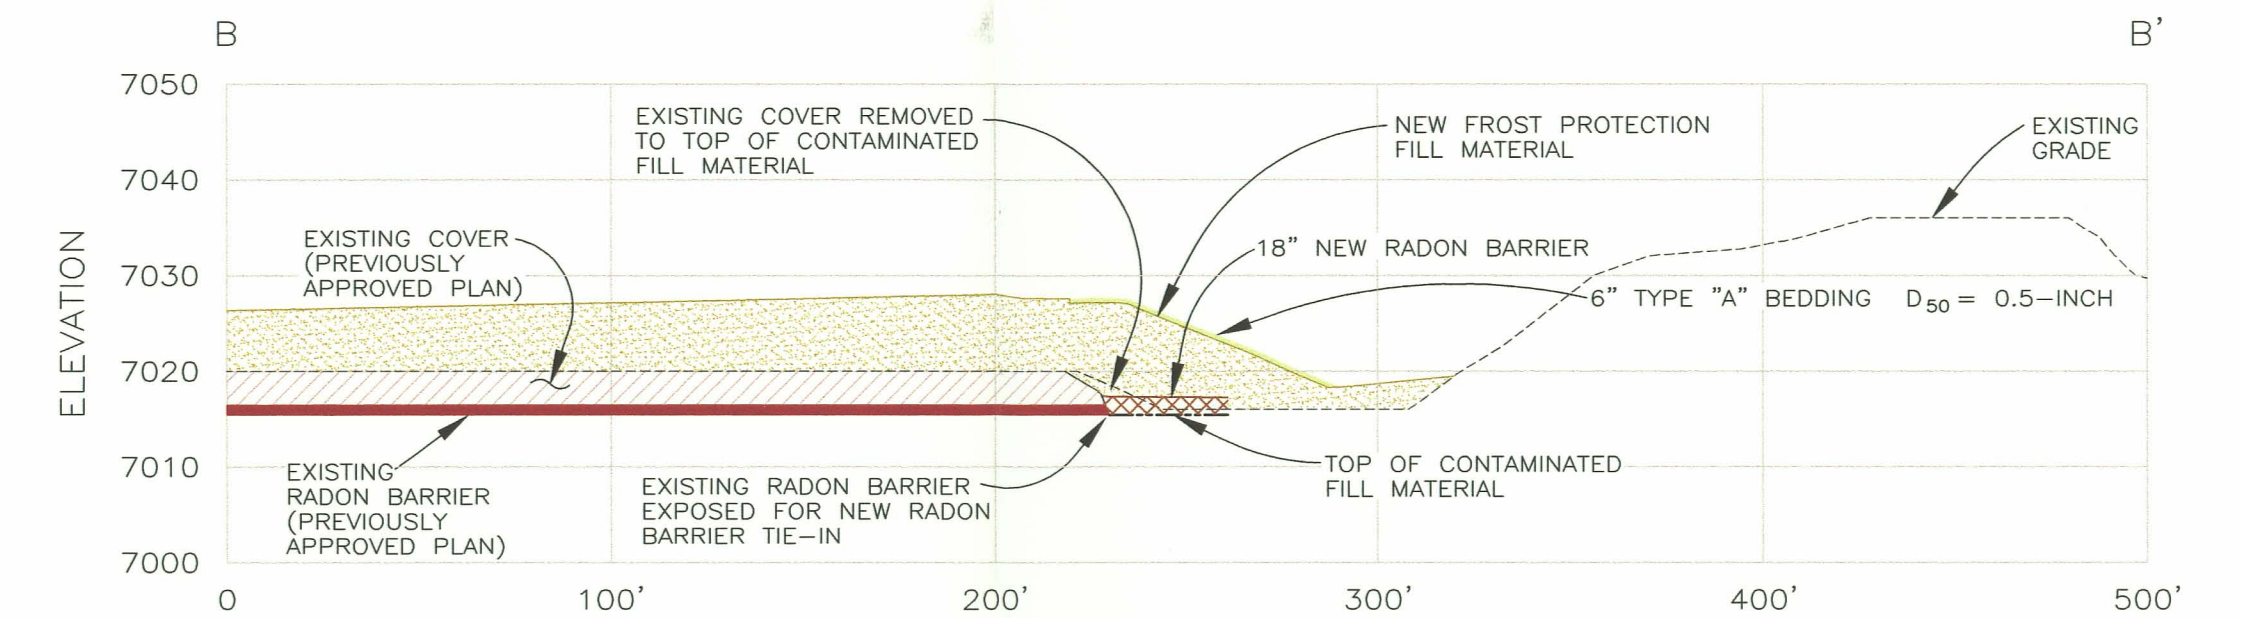


SECTION B-B'
SCALE: HORIZ. 1" = 50'
VERT. 1" = 20'

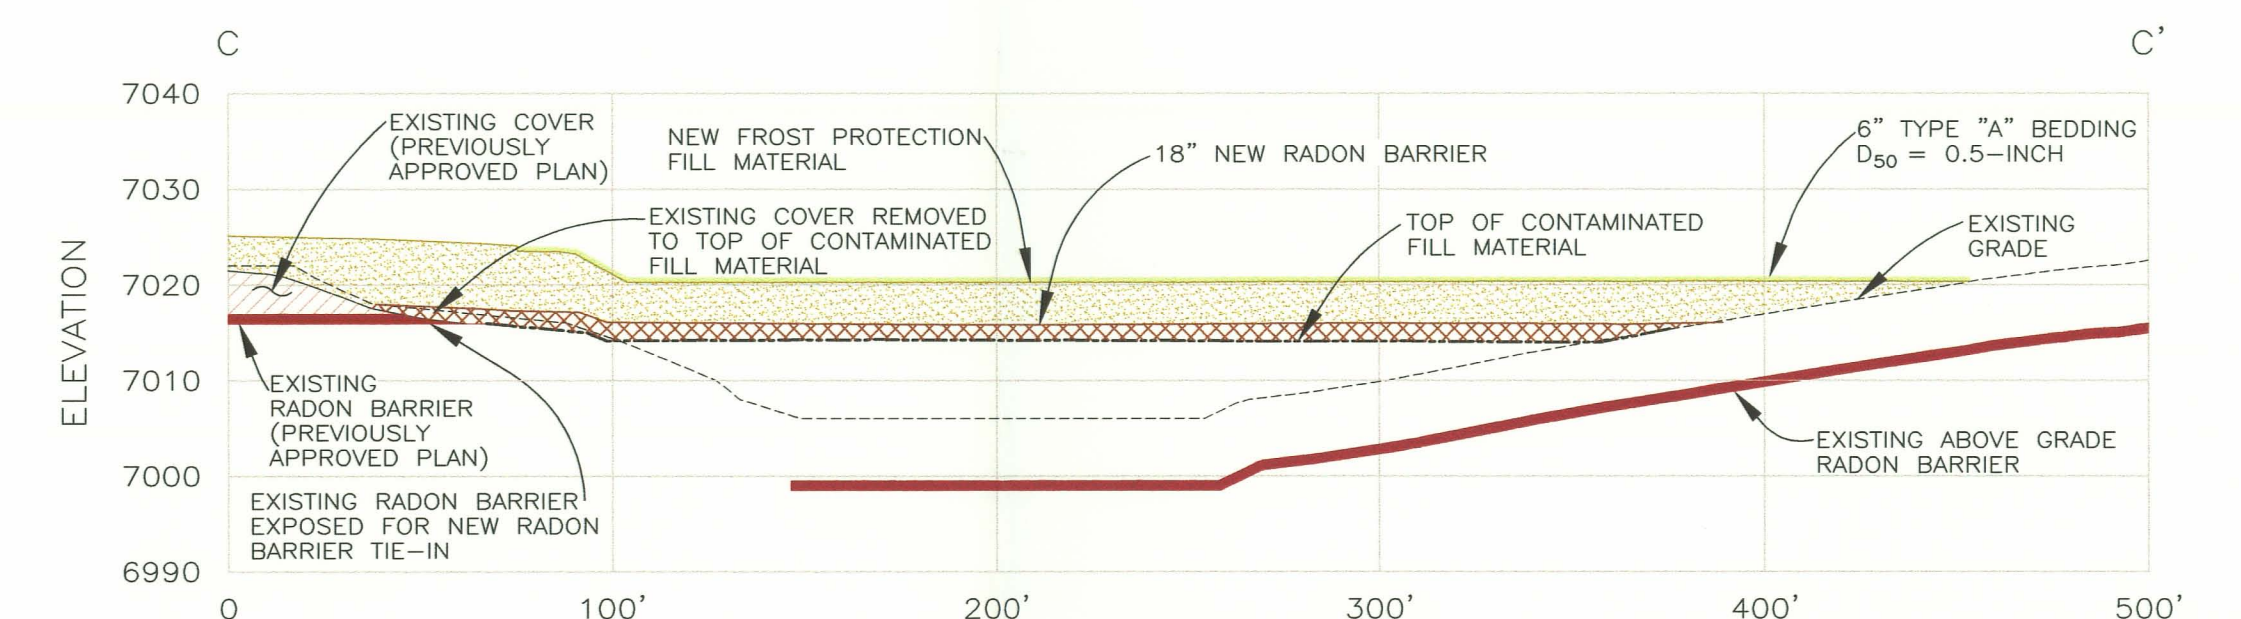

SECTION C-C'
SCALE: HORIZ. 1" = 50'
VERT. 1" = 20'

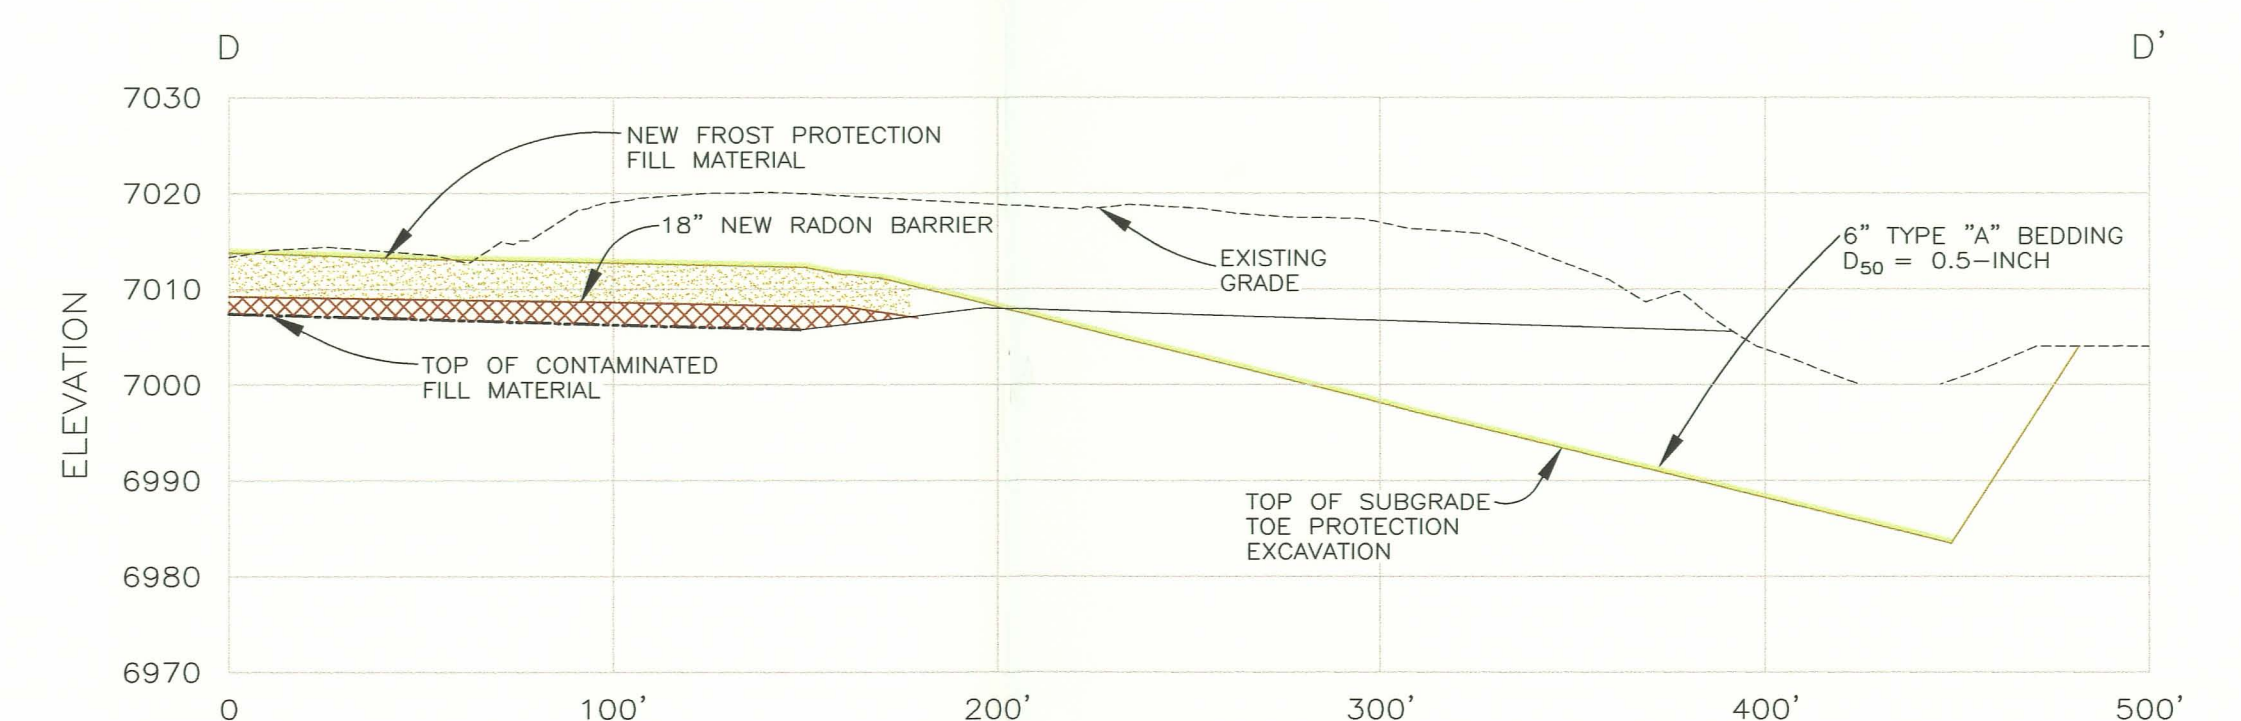

SECTION D-D'
SCALE: HORIZ. 1" = 50'
VERT. 1" = 20'

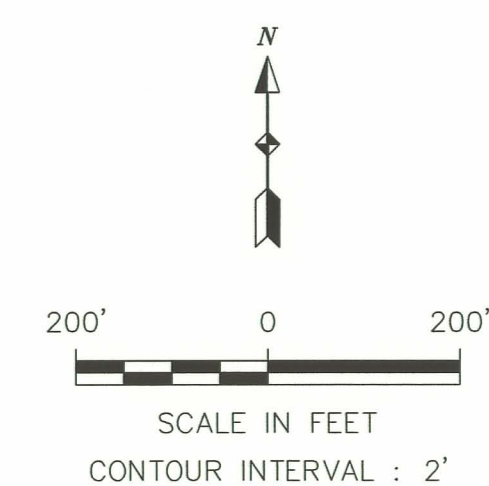

LEGEND:

- EXISTING 1997 AERIAL TOPOGRAPHY
- DRAINAGE PATH/PONDED WATER
- UN-PAVED ROADS
- UMETCO 1000' SITE GRID
- FINISH GRADE TOPOGRAPHY
- FROST PROTECTION FILL AREA
- TYPE "A" BEDDING FILL SURVEY VERIFICATION POINT
- TYPE "A" BEDDING
D₅₀ = 0.5-INCH

Umetco Minerals Corporation
2754 COMPASS DRIVE, SUITE 280, GRAND JUNCTION, CO 81506

AS BUILT

HEAP LEACH/GAP RECLAMATION
SURVEY VERIFICATION POINTS
EROSION PROTECTION
TYPE "A" BEDDING MATERIAL

GAS HILLS, WYOMING