
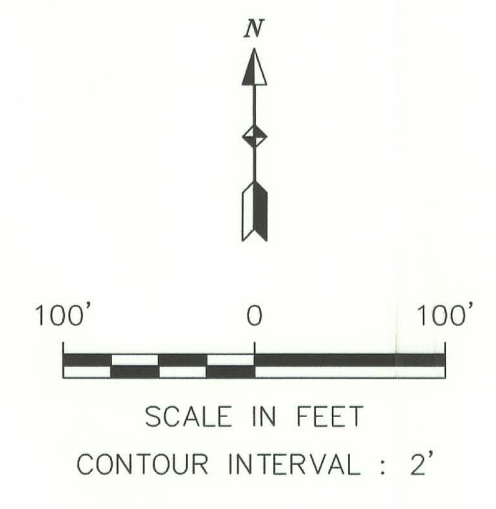


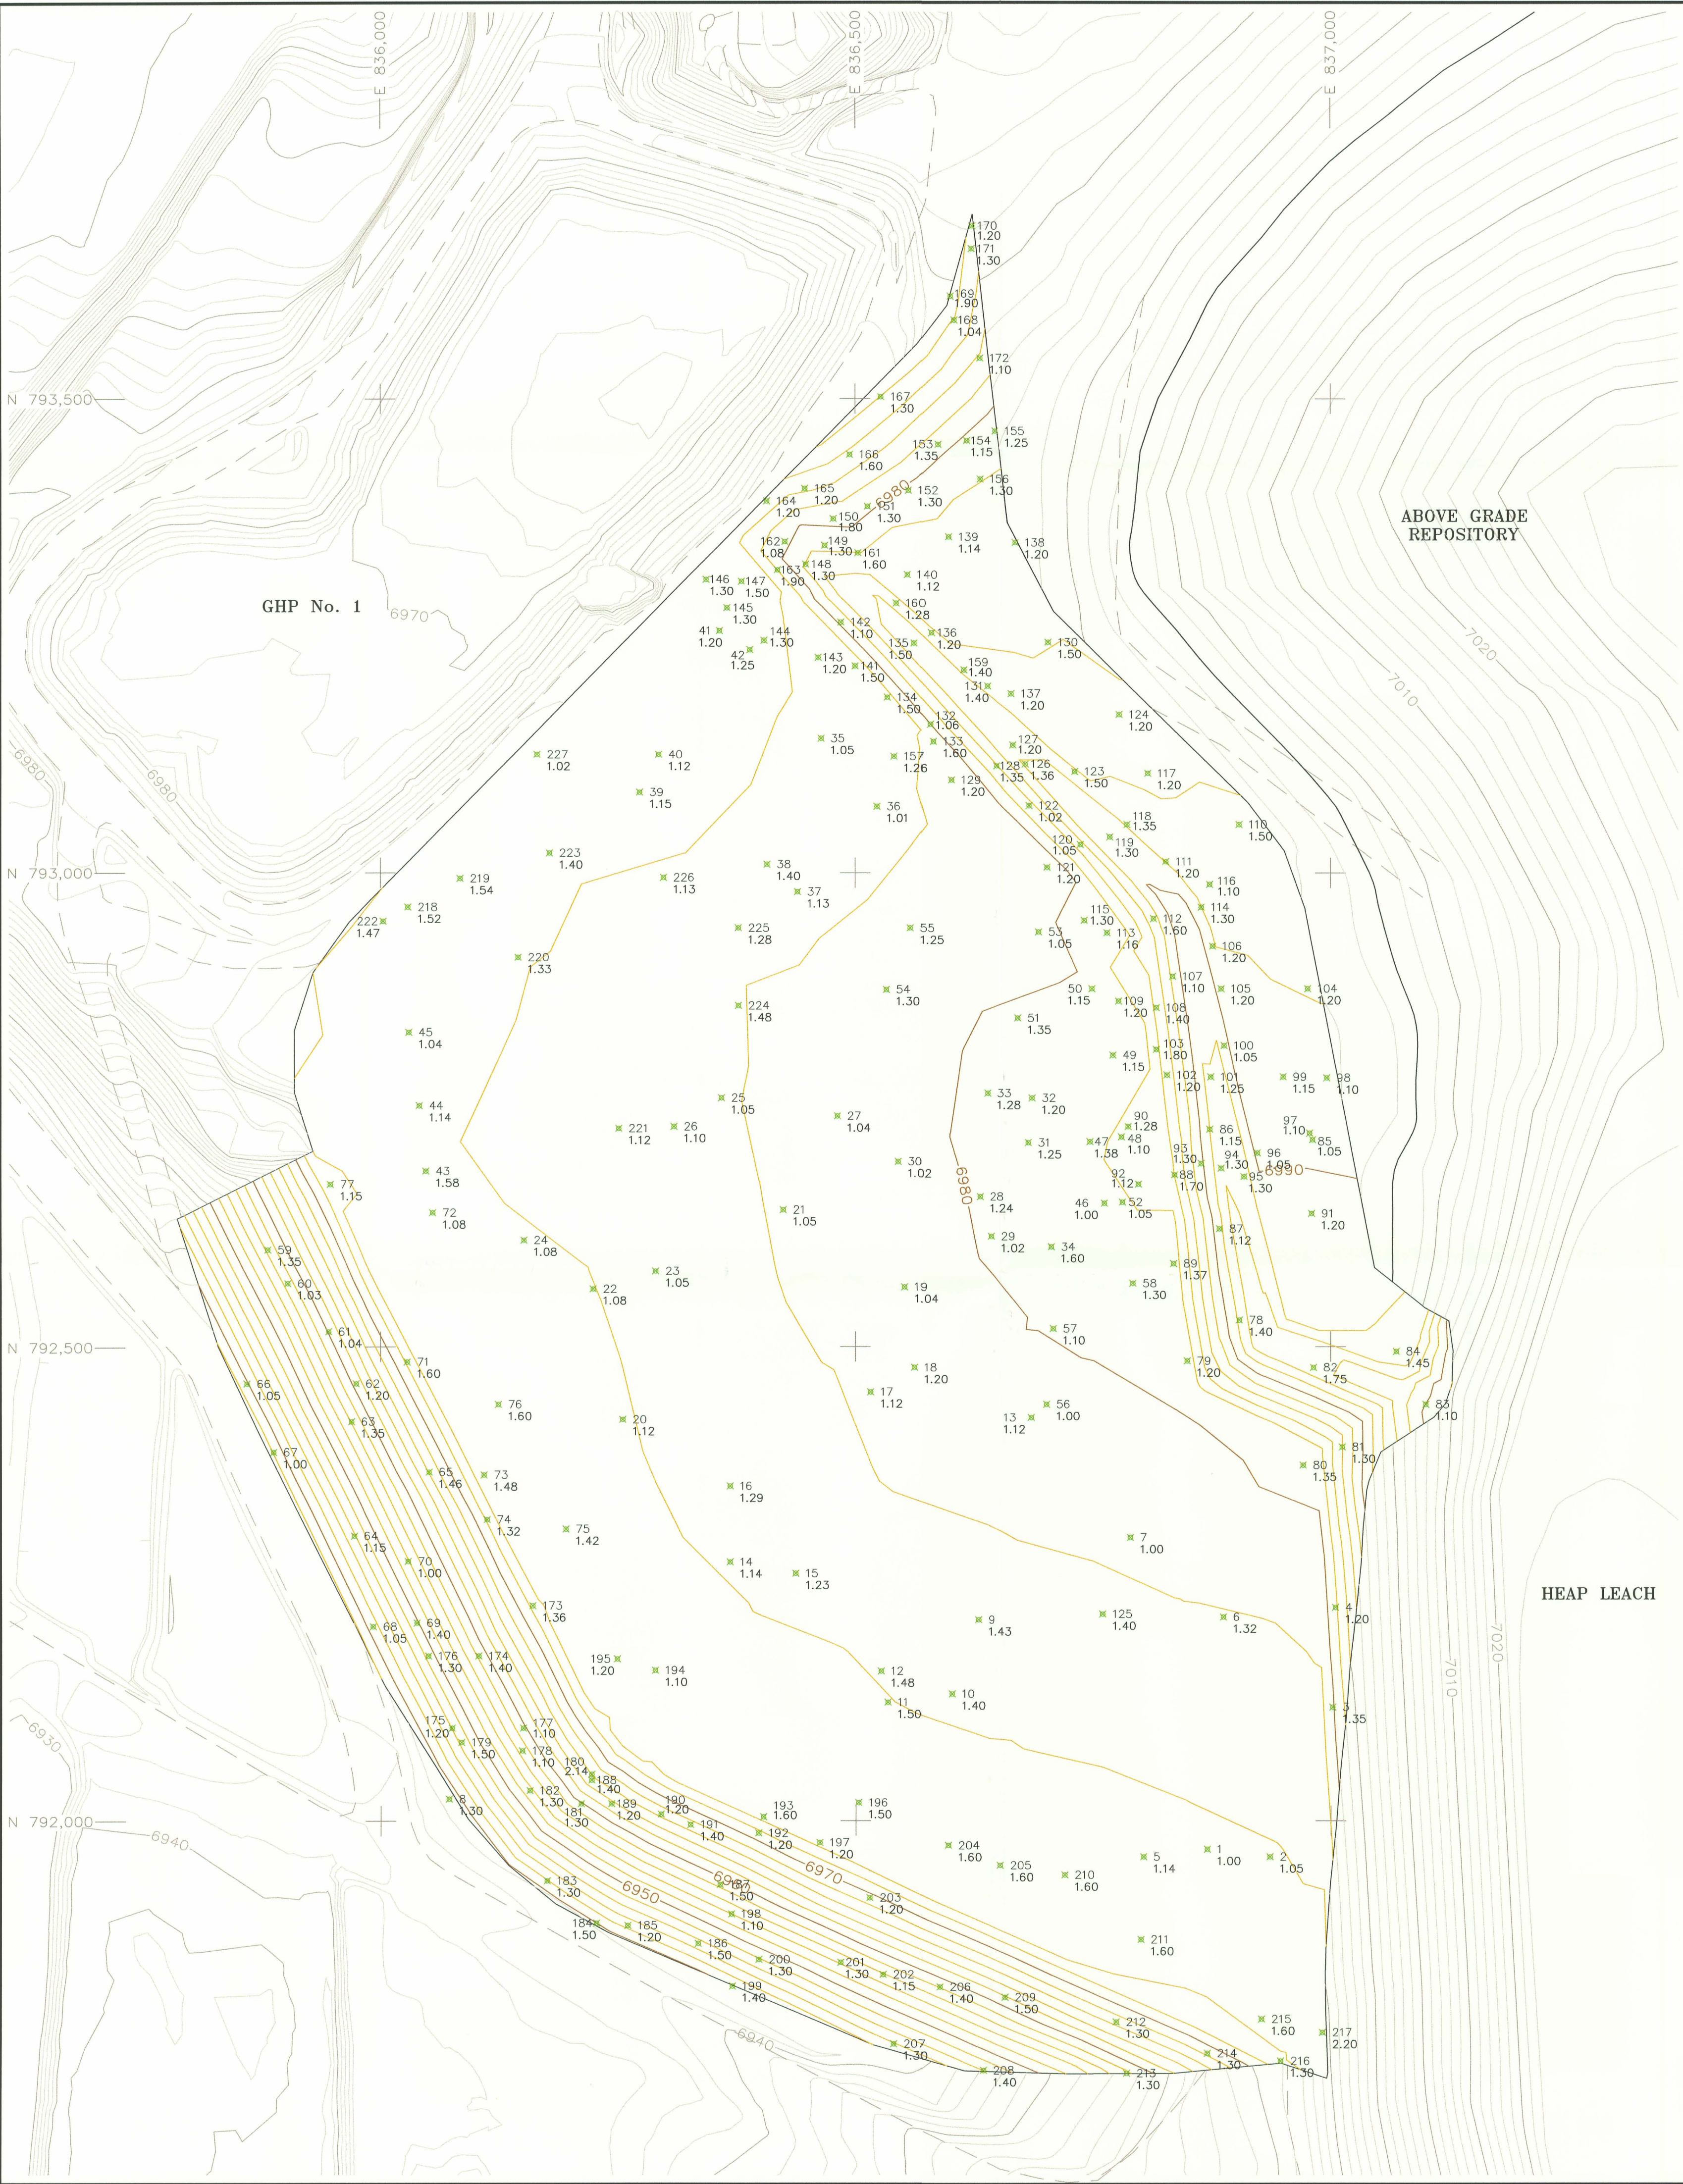

- LEGEND:**
- 2000 AERIAL TOPOGRAPHY
UPDATED WITH 2002 SURVEYS
 - DRAINAGE PATH/PONDED WATER
 - UN-PAVED ROADS
 - UMETCO 1000' SITE GRID
 - EXISTING RADON BARRIER
LIMITS FOR THE ABOVE-GRADE
AND HEAP LEACH REPOSITORIES
 - FINISH GRADE TOPOGRAPHY
RADON BARRIER FILL AREA
 - RADON BARRIER FILL
VISUAL DEPTH CHECK
49 = TEST LOCATION NUMBER
1.15 = MEASURED THICKNESS

**Umetco Minerals Corporation**
2754 COMPASS DRIVE, SUITE 280, GRAND JUNCTION, CO 81506

AS BUILT

**GHP-2 REPOSITORY
VISUAL DEPTH CHECK LOCATIONS
RADON BARRIER FILL**

GAS HILLS, WYOMING

DATE: JUNE 2007 DWG: GH-GHP2-06-AB SHEET **6** OF 13

D-06