



Docket # 50-390
Control # 3203170337
Date 3/11/82 of Document
REGULATORY DOCKET FILE

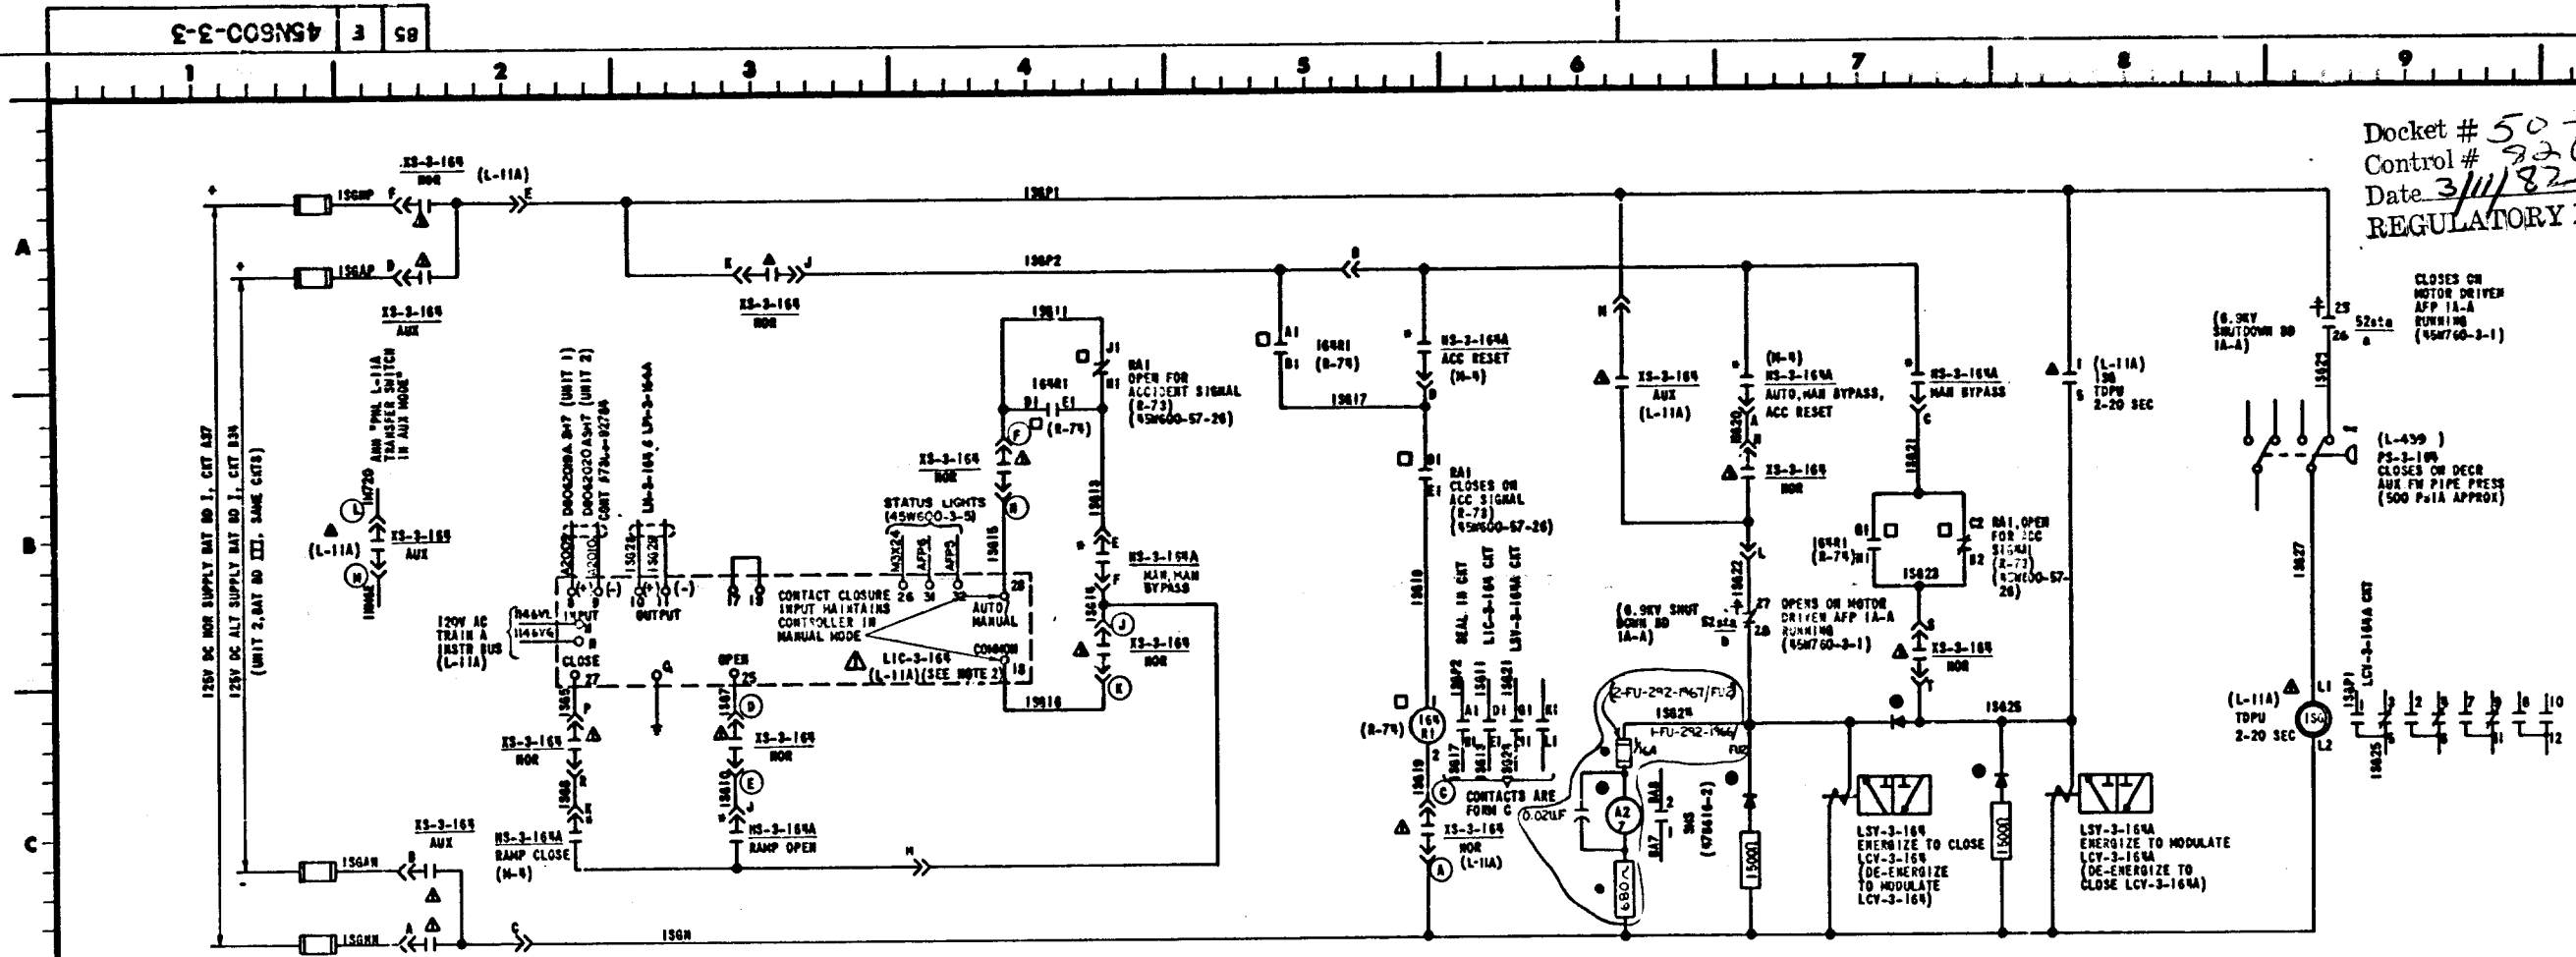

LCV-3-164 AND LCV-3-164A
MOTOR DRIVEN AUXILIARY FEEDWATER PUMP STEAM GENERATOR 1 LEVEL CONTROL AND BYPASS CONTROL VALVES
(TRAIN A)

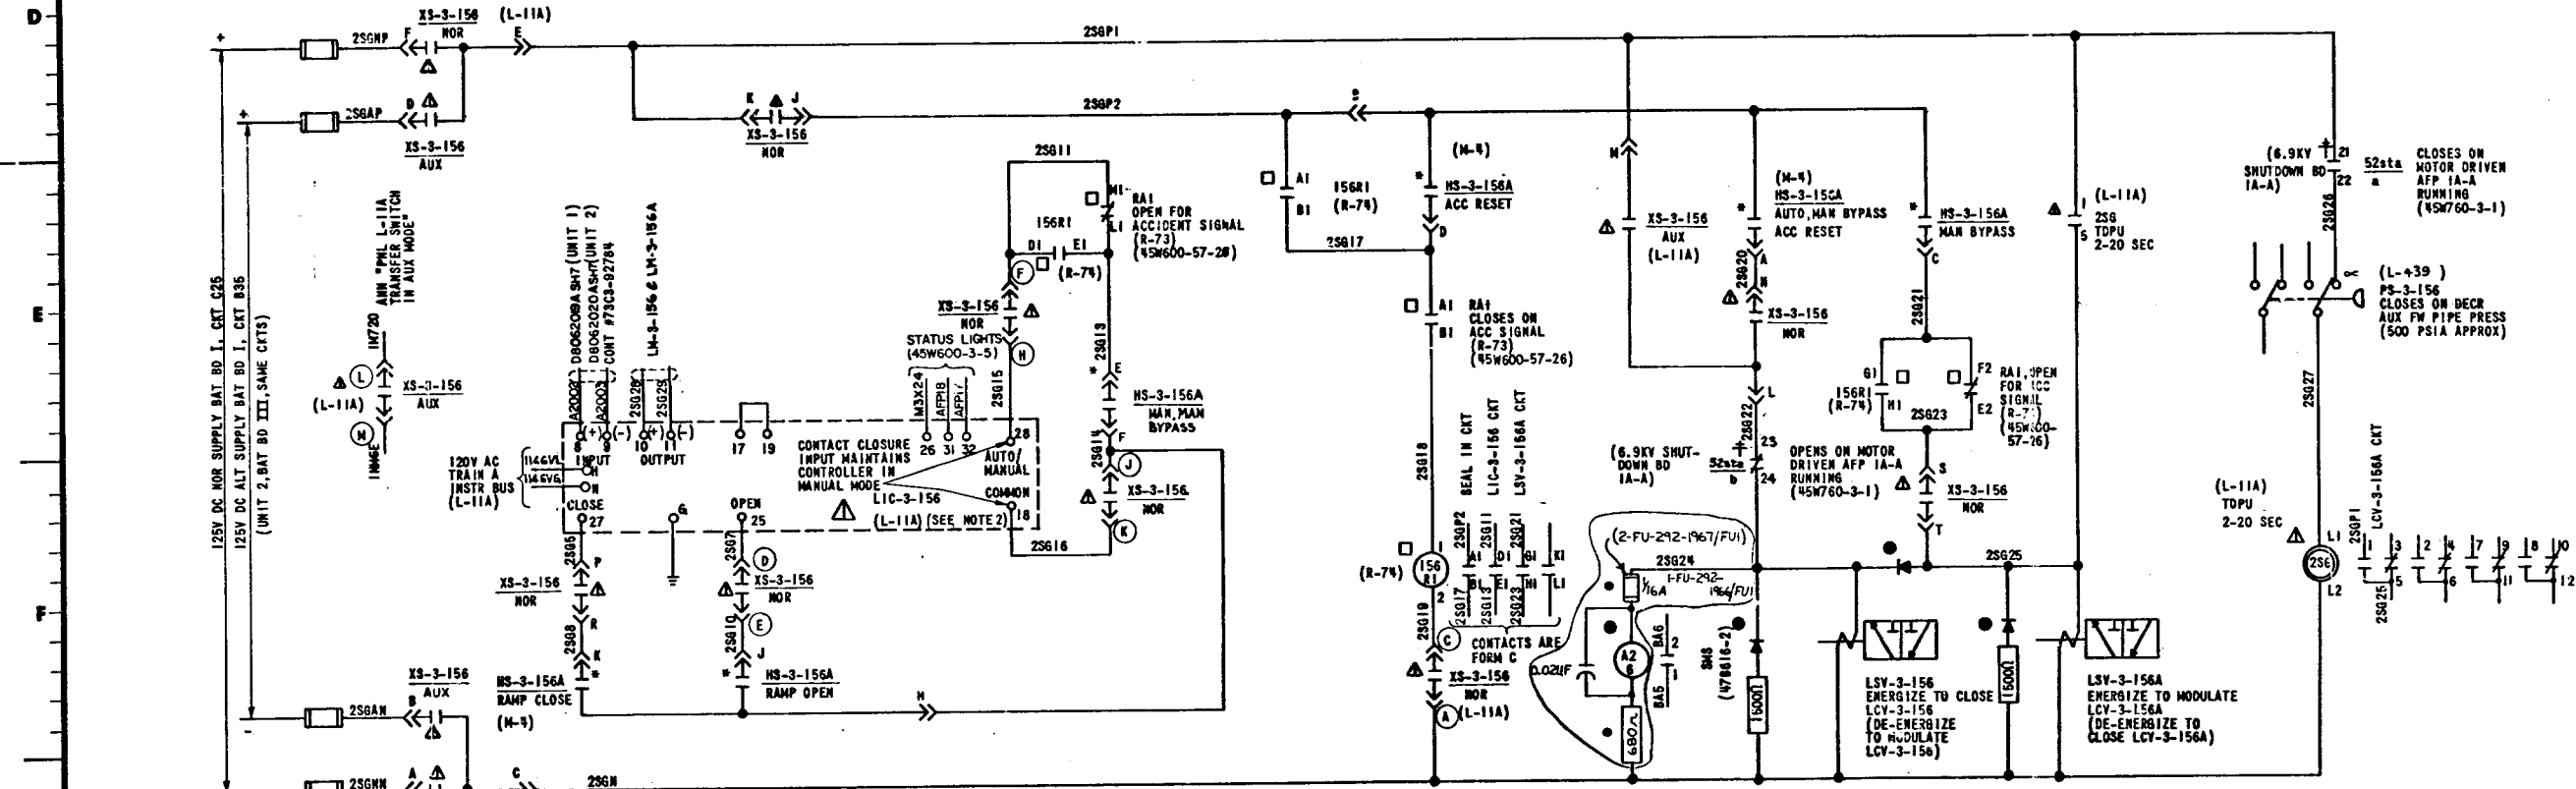

LCV-3-156 AND LCV-3-156A
MOTOR DRIVEN AUXILIARY FEEDWATER PUMP STEAM GENERATOR 2 LEVEL CONTROL AND BYPASS CONTROL VALVES
(TRAIN A)

PRC
APERTURE
CARD

THIS DRAWING IS A DUPLICATE OF
SERVOHYD DRAWING 454600-3-12
EXCEPT AS NOTED BY ENCLOSUREMENTS
ON RO OF THIS DRAWING

2 1041		12/22/77		TBS		FWS		J. R. Keller	
ADD EMB ARC SUPPRESSION NETWORKS									
1 1053									
REVISE LIC-3-156A-154									
REV	ECN NO.	DATE	CHG	OWN	CHK	APP	INSP	INSP	INSP
OWN	WRS	W. R. SCOGGIN							
CHKD	J. R. Keller								
SUPV	J. R. Keller								
SCALE: EXCEPT AS NOTED									
POWERHOUSE									
UNITS 1&2									
36.142-2									
WIRING DIAGRAMS									
MAIN & AUXILIARY FEEDWATER SYS.									
SCHEMATIC DIAGRAMS SHEET 3									
WATTS BAR NUCLEAR PLANT									
TENNESSEE VALLEY AUTHORITY									
DIVISION OF ENGINEERING DESIGN									
SUBMITTED									
RECOMMENDED									
APPROVED									
J. R. Keller									
KNOXVILLE 11-22-76									
85 E 45N600-3-3 R2									
RECORD DRAWING AS CONSTRUCTED									

8203170367