

**ATTACHMENT 5**

**Peach Bottom Atomic Power Station  
Units 2 and 3  
Docket Nos. 50-277 and 50-278**

**License Amendment Request  
Response to Request for Additional Information**

**Alternative Source Term (AST)**

**PBAPS Calculation 23-4/X-1, Revision 0, *"Reactor Building -  
H&V Ducts, Seismic Analysis"***



NUCLEAR  
GROUP  
M-20589 Rev. 3/83  
DOCTYPE 001

# CALCULATION COVER SHEET

1. Calculation No. 23-4/x-1

Page 1

2.  LGS  
 PBAPS

UNIT(S) 233

3. MOD/NCR/ECR No.:  
Other: CALC. TURN OVER TO DS

4. Responsible Branch: SECS

5. Total No. of Pages:  
33

6. Last Page No.:  
29

7.  Safety Related  
 Non-Safety Related

8. Description: REACTOR BUILD. - H<sub>2</sub>V DUCTS, SEISMIC ANALYSIS

9. System/Topic No.: 70, 901

Structure: —

Component: —

## RECORD OF REVISIONS

10. Rev. No.	11. Description of Revision	12. Vendor Calc.		13. Assumptions		14. Signatures		
		Number	Rev.	Yes	No	Preparer	Reviewer	Approver/Date
0	THIS CALCULATION HAS NOT BEEN VALIDATED FOR TECHNICAL CONTENT. IT HAS BEEN ADMINISTRATIVELY PROCESSED AND ACCEPTED FOR PIMS INDEXING. SINCE THE CALCULATION MAY OR MAY NOT REFLECT THE CURRENT AS-BUILT CONFIGURATION, THE USER MUST REVIEW THE CALCULATION FOR TECHNICAL ADEQUACY AND THE CURRENT CONFIGURATION NEEDED TO SUPPORT OTHER CALCULATIONS OR DESIGN ACTIVITIES IN PROGRESS.							"APPROVED FOR RECORD FM/MKS-UE 9/24/93

15. Related Calc. Number	Provides Info to:						
	Receives Info from:						
	Supersedes:						

16.  
 Manual  
 Computer  
Computer program and version

PEACH BOTTOM ATOMIC POWER STATION UNITS 2&3  
 QUALITY ASSURANCE PROGRAM  
 CALCULATION COVER SHEET  
 DISCIPLINE CIVIL

23-4/X-1

JOB NO. 6280-2

No of sheets

TITLE: PEACH BOTTOM A. P. S.

SUBJECT: REACTOR BUILDING MISC X-1

STATEMENT OF PROBLEM

STRUCTURAL ANALYSIS

SAR CHECKED

SAR CHANGE REQ'D

SAR CHANGE NOTICE INITIATED

SOURCES OF DATA

DWG:

DESIGN CRITERIA: PEACH BOTTOM UNITS 2 & 3, REVISION 5

SOURCES OF FORMULAE & REFERENCES

1. USC-1967
2. ACI 318-63
3. AISC-1967
4. M-425, M-426, M-427, M-428

\*PRELIMINARY CALC

FINAL CALC

SUPERSEDES CALC DATED

REV NO	DATE	CALCULATION BY	CHECKED BY	DATE	APPROVED BY	DATE
	10/70	E Solonjans	W. Bertwell	'70	Q. Ute	10/70



SIGNATURE H. SOLORZANO

DATE \_\_\_\_\_

TITLE P.B.JOB NO. 6280SUBJECT H&V Ducts - Dynamic Seismic AnalysisSHEET NO. 2METHOD OF ANALYSIS

Since we will use rigid system,

- a) Determine required duct span to provide us with a natural frequency in the rigid range ( $\geq 30$  cps)
- b) Obtain acceleration for rigid system from Spectrum Response Curves - Investigate range of accelerations involved for ducts of the whole job and if the difference is not great, we will use the worst.
- c) Determine equivalent static lateral load from above acceleration  $F = ma$
- d) Determine stresses on existing system for above loading - Modify as required to satisfy criteria - Evaluate a new and possibly more efficient hanger system for future hangers - Rigidity criteria of support is the same as for ducts -
- e) Check out details for integrity, including duct splice
- f) Layout and detail hanger system

CONCLUSIONS

- 1.) Weights involved are extremely light; therefore, the proposed system lends itself readily for a rigid support system
- 2.) As detailed here, square and rectangular ducts should give a good account of themselves under a seismic disturbance of the magnitude postulated for our site.



SIGNATURE ESR

DATE \_\_\_\_\_

TITLE TEACH BOTTOM ADS

JOB NO. 6280

SUBJECT H&V DUCTS - SEISMIC ANALYSIS

SHEET NO. 3

Group ducts to analyze as a whole:

Duct sizes: Repr. sizes (22 ga.) = .03"

CATEGORY

SIZES	Perimeter	WT/FT
4 x 12	32" = 2.67'	5.3 #/FT
6 x 20	56 = 4.67	9.3
8 x 18	52 = 4.3	8.6
9 x 18	54 = 4.5	9.0
10 x 20	50 = 4.2	8.4
12 x 36	96 = 8.	16.
14 x		
16 x 48	128 = 10.7	21.4
18 x 16	68 = 5.7	11.4
20 x 34	108 = 9.	18.
28 x 30	116 = 9.7	19.4
32 x 20	104 = 8.7	17.4
40 x 16	112 = 9.3	18.6
48 x 30	156 = 13.	26.
50 x 32	164 = 13.7	27.4

} I

} II

} III

Divide ducts arbitrarily into three categories per weight:

10% ; 30% and 30% based on the above tabulation.

(6x20)                      (28x30)                      (50x32)

I                                      II                                      III

00000079D484



SIGNATURE

ESR

DATE 11/4/70

TITLE

PEACH BOTTOM APS

JOB NO. 6280


SUBJECT

H & V DUCTS - SEISMIC ANALYSIS

SHEET NO. 4

Evaluation of stress and stiffness of ducts

Since ducts are oriented in different ways, worst condit. used here!

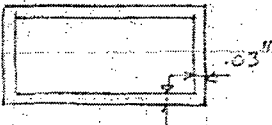

Gross I:

6x20 = (.03x20)(3)^2(2) + (1.03)(6)^3/12(2) = 11.9 in^4

28x30 = (.03x20)(14)^2(2) + .03(28)^3/12(2) = 345 in^4

50x32 = (.03x50)(16)^2(2) + .03(32)^3/12(2) = 17,265 in^4

(Conserv. to consider short dim. vertical)

M<sub>ss</sub> = 10 x (8)^2 / 8 = 80 in^4 = 960 in^4

f = 960 x 3 / 11.9 = 242 psi

= 20 x (8)^2 / 8 = 160 in^4 = 1920

f = 1920 x 14 / 345 = 780 psi

= 30 x (8)^2 / 8 = 240 in^4 = 2870

f = 2870 x 16 / 17,265 = 267 psi


From AISI Charts (3A & 3C):

Min. w/t ≈ 300

b/t ≈ 120 for 4000 psi (Strength) = 150 for Defl.

Max. " ≈ 800

Effective b = 120 x .03 = 3.6" for strength and 150 x .03 = 4.5" for Defl.

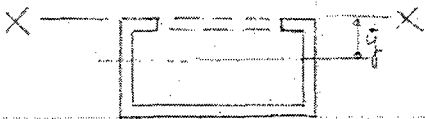

(6x20)

Area	$\bar{y}$	$A\bar{y}$	$A\bar{y}^2$	$I_{webs}$
$.03 \times 4.5 = 13.5$	.01	-	-	-
$2 \times .03 \times 60 = 3.6$	3	1.08	3.24	$.03 \times \frac{6^3}{12} = 0.54$
$.03 \times 20 = .6$	5.98	3.59	21.4	0.54
1.095		4.67	24.64	1.08

$\bar{y} = \frac{4.67}{1.1} = 4.25"$

$I = 25.7$   
 $(-) 1.1(4.25)^2 = 19.9$

Net I = 5.8 in^4



SIGNATURE ESR

DATE \_\_\_\_\_


TITLE PEACH BOTTOM AB

JOB NO. 6280

SUBJECT HEV DUCTS - SEISMIC ANALYSIS

SHEET NO. 4 A

Eff.  $4\frac{1}{2}$

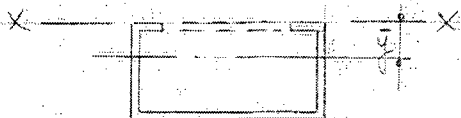

(30x28)

Area	y	Ay	Ay <sup>2</sup>	I <sub>inert</sub>
.03 x 45 = 1.35	.01	—	—	.03 x $\frac{28^3}{12}$ = 55.5
2 x .03 x 28 = 1.68	14.	23.5	329.	55.5
.03 x 30 = 0.9	27.98	25.2	705.	—
2.72		48.7	1034.	110.

$\bar{y} = \frac{48.7}{2.72} = 17.9"$

$S = 11.44$

$(-) 2.72 (17.9)^2 = 873$

Net I = 271 in<sup>4</sup>



(50x32)

Area	y	Ay	Ay <sup>2</sup>	I <sub>inert</sub>
.03 x 4.5 = 1.35	.01	—	—	.03 x $\frac{32^3}{12}$ = 82.5
2 x .03 x 32 = 1.92	16.	30.7	490.	82.5
.03 x 50 = 1.50	31.98	48.	1540.	—
3.55		78.7	2030.	165.

$\bar{y} = \frac{78.7}{3.55} = 22.2"$

$S = 21.95$

$(-) 3.55 (22.2)^2 = 1750$

Net I = 445 in<sup>4</sup>

0  
1  
2  
3  
4  
5  
6  
7  
8  
9  
0  
1  
2  
3  
4  
5  
6  
7  
8  
9  
0



SIGNATURE

ESR

DATE

TITLE

PEACH BOTTOM

JOB NO.

6280

SUBJECT

H &amp; V DUCTS - SEISMIC ANALYSIS

SHEET NO.

5

We will solve now for required  $I$  on a continuous beam over 4 spans, uniformly loaded, to produce deflection required for rigid body motion, using 8' c/c spans:

From AISC for 4 spans uniformly loaded

$$\Delta = \frac{.0065 w L^4}{EI} = \frac{.0065 \times (96)^4 (w)}{29,000,000 (I)} = (2.24 \times 10^{-10}) (96)^4 \left(\frac{w}{I}\right)$$

$$= 1.9 \times 10^{-2} \left(\frac{w}{I}\right)$$

Natural Frequency (cps) =  $\frac{\pi}{\sqrt{\Delta}} = 30$ . For rigid-body motion

$$\sqrt{\Delta} = 0.105 \text{ and } \underline{\underline{\Delta_{req'd} = 0.011''}}$$

(Req'd. Defl. for Rigid-body motion)

Solving for  $\left(\frac{w}{I}\right) = \frac{.011}{1.9 \times 10^{-2}} = .58$  and  $w = \frac{10^{\frac{4}{3}}}{30} = .83 \frac{4}{3}$

$$30 = 1.66$$

$$30 = 2.49$$

$$I_I = \frac{.83}{.58} = 1.43 \text{ in}^4$$

$$I_{II} = \frac{1.66}{.58} = 2.87$$

$$I_{III} = \frac{2.49}{.58} = 4.3$$

Therefore, 8' c/c spacing of supports is adequate



23-4/X-1

11/3/70

SIGNATURE

ESR

DATE

TITLE

FURNACE BOTTOM APS

JOB NO.

6280

SUBJECT

H&amp;V DUCTS - SEISMIC ANALYSIS

SHEET NO.

6

Check for allowable spans:

 $\Delta = .011''$  for rigid body motion

$$\Delta = \frac{.0065 w l^4}{EI} = 2.24 \times 10^{-10} \left( \frac{w l^4}{I} \right) \text{ for 4 spans unif. loaded}$$

$$\therefore \frac{w l^4}{I} = \frac{.011}{2.24 \times 10^{-10}} = 49.3 \times 10^6$$

$$\text{For } I = 6 \text{ in}^4; w l^4 = 296 \times 10^6; l^4 = \frac{296 \times 10^6}{0.83 \frac{\#}{\text{in}}} = 356 \times 10^6$$

$$\text{For } I = 271 \text{ in}^4; w l^4 = 13,350 \times 10^6; l^4 = \frac{13,350 \times 10^6}{1.67 \frac{\#}{\text{in}}} = 8,000 \times 10^6$$

$$l = 137'' = 11.4'$$

$$\text{For } I = 445 \text{ in}^4; w l^4 = 21,900 \times 10^6; l^4 = \frac{21,900 \times 10^6}{2.5 \frac{\#}{\text{in}}} = 8780 \times 10^6$$

$$l = 299'' = 24.9'$$

$$l = 306'' = 25.5'$$

See splice det. check for limiting spans on sheet 10

SIGNATURE ESR

DATE \_\_\_\_\_

TITLE PEACH BOTTOM APS

JOB NO. 6283

SUBJECT H & V DUCTS - SEISMIC ANALYSIS

SHEET NO. 7


INVESTIGATION OF EXIST. SUPPORTS

A survey of Spectrum Response Curves for the job indicates that for  $\frac{1}{2}\%$  Damping, the maximum acceleration is 0.2 G

Therefore, for  $30 \frac{\#}{ft} \times 8' \text{ Trib.} = 240 \frac{\#}{ft}$  <sup>vert. accel.</sup>  $\times 1.04 = 250 \frac{\#}{ft}$  Vert.  
 $0.2 (240 \frac{\#}{ft}) = 48 \frac{\#}{ft}$  Horiz. (Long. & Transv.)

Review of Pref. dwg's in Control Rm. Area where the highest ceiling spaces occur, we get the following hanger lengths:

- To M. Deck - 6.5'
- To WF beams - 3.0'

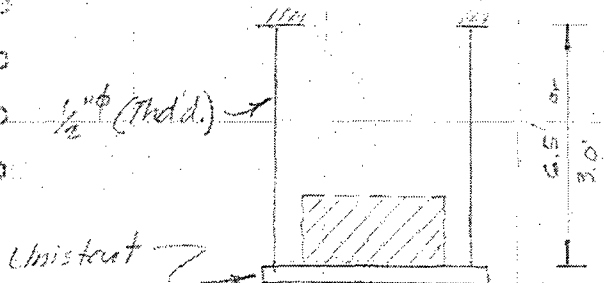

$$M_1 = 6.5 \times \frac{48}{3} = 156 \frac{\#}{ft} = 1890 \frac{\#}{ft}$$

$$M_2 = 3.0 \times \frac{48}{2} = 72 \frac{\#}{ft} = 865 \frac{\#}{ft}$$

$$S = .1 d^3 = .1 \left(\frac{1}{2}\right)^3 = .013 \text{ in}^3$$

$$f_1 = \frac{1890}{.013} = 145,000 \text{ psi N.G.}$$

$$f_2 = \frac{865}{.013} = 66,500 \text{ psi N.G.}$$

$$\frac{P}{A} = \frac{250 \frac{\#}{ft}}{2 \times 142} = 882 \text{ psi}$$

Therefore, we have to stiffen up exist. system for strength and flexibility



SIGNATURE ER

DATE \_\_\_\_\_


TITLE FEACH BOTTOM APS

JOB NO. 6290

SUBJECT H & V DUCTS - SEISMIC ANALYSIS

SHEET NO. 8

BRACING SYSTEM FOR EXIST. ROD HANGERS

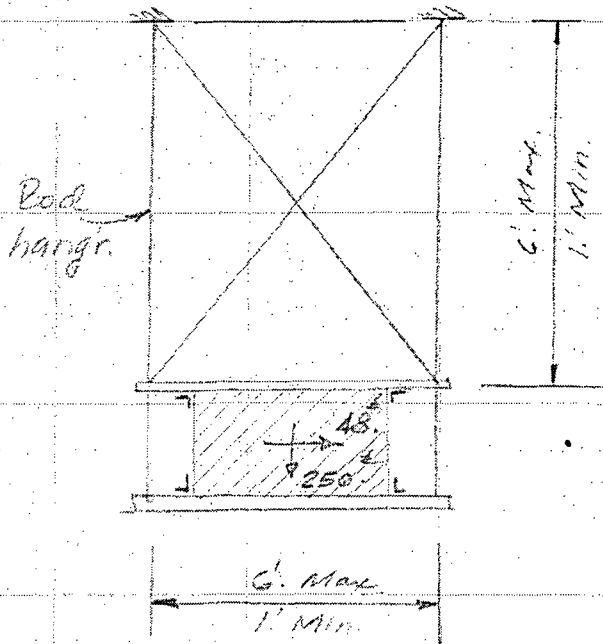

Max. for lens. bracing =  $6.1 (48) = 293$

$l \approx 75$  max

For  $2\frac{1}{2} \times 2\frac{1}{2} \times \frac{1}{4}$  &  $r = .49$

$\frac{l}{r} = \frac{75}{.49} = 153 < 200$  OK

Axial Id. Cap =  $7640 \frac{1}{10} \times 1.2 = 9150$  # OK

Max. axial Load:

$48 \times \frac{6}{1} = -288$  #

$250 \times \frac{1}{2} = \frac{+125}{1.63}$  # OK

This would occur only if we had the very flat angle assumed, which is unlikely - In the more common case there will not be compr. at all.

It is therefore required that for new hangers angles be employed rather than rods to avoid the above situation since in this case only one diag. is req'd.

Cap. of L- $2\frac{1}{2} \times 2\frac{1}{2} \times \frac{1}{4}$  is adequate and

$\frac{1}{2}$ "  $\phi$  in Shear & Porg. is OK

Likewise,  $\frac{3}{16}$ " F. Weld is OK

000000007914290



SIGNATURE ESR

DATE \_\_\_\_\_

TITLE TEACH BOTTOM APS


JOB NO. 6280

SUBJECT HEV DUCTS SEISMIC ANALYSIS

SHEET NO. 9

Deflection check to comply with rigid body criteria - Supports -

From Pp. 6 Axial Deformat. of bracing is:

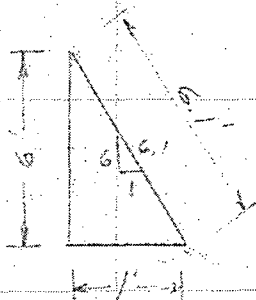


$A = 1.2''$     $L = 73''$     $P = 48(6.1) = 293.1$

$\delta = \frac{PL}{AE} = \frac{293 \times 73}{1.2 \times 29 \times 10^6} = .000615'' < .011''$  OK

(Worst Cond.)

Components of deform. small also.  
(Lat.  $\delta = \frac{6.1}{1} \times .000615 = .0038''$   $\neq$   
For both diag. work's.  $\Delta = \frac{1}{2} \times .0038$ )

If we were to have only a frame without bracing at short hangers, we get:

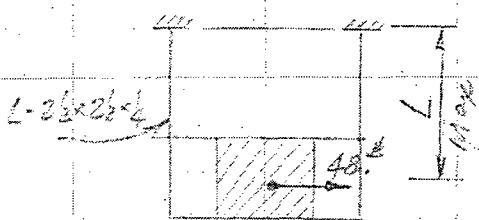

$\Delta = \frac{2d \times L^3}{3 \times 29 \times 10^6 \times 0.7} = 0.011''$

$\Delta^3 = \frac{0.011 \times 3 \times 29 \times 10^6 \times 0.7}{24} = 28,000$

$L_{max} = 30.3''$    Say 2'-6"



SIGNATURE ER

DATE \_\_\_\_\_

TITLE PEACH BOTTOM ADS

JOB NO. 6280


SUBJECT H & V DUCTS - SEISMIC ANALYSIS

SHEET NO. 9 A

Alternate scheme:

Provide rigid frame to resist loads instead of bracing


For rigid body motion  
allowable deflection = .011"

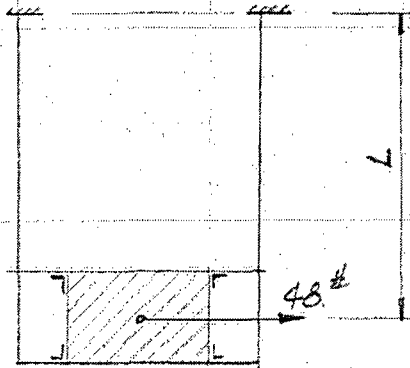

$$\Delta = \frac{PL^3}{3EI}$$

$$I_{reqd.} = \frac{PL^3}{3E\Delta} = \frac{24 \times L^3}{3 \times 29 \times 10^4 \times .011}$$

$$= 2.51 \times 10^{-5} (L^3)$$

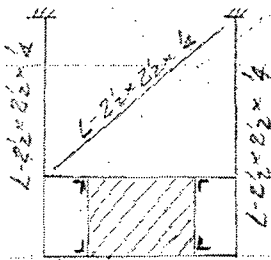

ALTERN. FRAME.

shape	L	L <sup>3</sup>	I
	10	10 <sup>3</sup>	2.51 x 10 <sup>-2</sup>
	15	3.4 x 10 <sup>3</sup>	8.54 x 10 <sup>-2</sup>
	20	8. x 10 <sup>3</sup>	20.1 x 10 <sup>-2</sup>
	25	15.6 x 10 <sup>3</sup>	39.2 x 10 <sup>-2</sup>
	30	27. x 10 <sup>3</sup>	67.8 x 10 <sup>-2</sup>
	35	43. x 10 <sup>3</sup>	108 x 10 <sup>-2</sup>
	40	64 x 10 <sup>3</sup>	161 x 10 <sup>-2</sup>
	45	91 x 10 <sup>3</sup>	228 x 10 <sup>-2</sup>
	50	125 x 10 <sup>3</sup>	314 x 10 <sup>-2</sup>
	60	216 x 10 <sup>3</sup>	542 x 10 <sup>-2</sup>

00000079114492

SIGNATURE ESR

DATE \_\_\_\_\_


TITLE PEACH BOTTOM APS

JOB NO. 6280

SUBJECT H<sub>2</sub>V DUCTS - SEISMIC ANALYSIS

SHEET NO. 9B

Check:

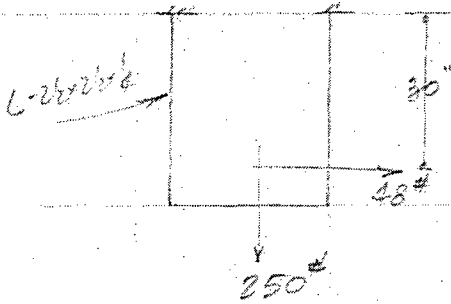

$$M = 24 \times 30 = 720 \text{ "}\cdot\text{"}$$


$$S_x = .39 \text{ in}^3 \text{ (L-2x2x1/8)}$$

$$f = \frac{720}{.39} = 1850 \text{ psi}$$

$$P/A = \frac{125}{1.19} = 105 \text{ psi}$$

$$\frac{L}{r} = \frac{30}{.49} = 61.2 \therefore F_a = 17.3 \text{ ksi}$$

OK

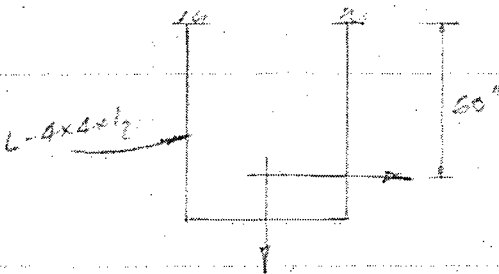

$$M = 24 \times 60 = 1440 \text{ "}\cdot\text{"}$$

$$f = \frac{1440}{2} = 720 \text{ psi}$$

$$P/A = \frac{125}{3.75} = 33.3 \text{ psi}$$

$$\frac{L}{r} = \frac{60}{.78} = 77 \therefore F_a = 15.69 \text{ ksi}$$


OK

Connection

Cap. of  $\frac{1}{2}$ " Thid. Stud in T =  $.142 \times 20 = 2.8 \text{ k}$

$$M_{max} = 1440 \text{ "}\cdot\text{"}$$

$$A_{req} = \frac{1.44}{2.8} = .5 \text{ " (won't OK)}$$

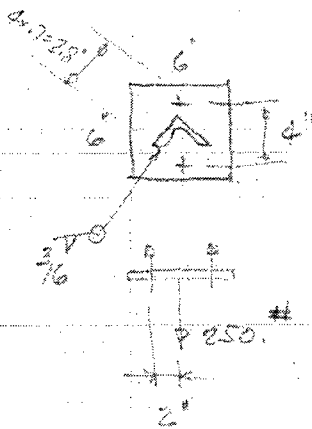

Re Bend's  $M_1 = 125 \times 1 = 125 \text{ "}\cdot\text{"}$

$$M_2 = \frac{1440}{2.8} \times 1 = \frac{510}{635} \text{ "}\cdot\text{"}$$

$$M/in = \frac{635}{(6-1)} = 127 \text{ "}\cdot\text{"}/\text{in}$$

$$f = \frac{127}{.0233} = 5450 \text{ psi}$$

Use  $\frac{3}{8}$ " Re

SIGNATURE ER

DATE \_\_\_\_\_

TITLE FEAR BOTTOM APS

JOB NO. 6280

SUBJECT H&V DUCTS - SEISMIC ANALYSIS

SHEET NO. 10

Evaluation of Duct splice  
Worst Cond. (Categ. III)

$w_s = 30\% /$

$L = 16' \text{ Max}$

$Arm = \frac{2}{3} (16) = 10.7''$

4 Span cont. bm. & Univ. Ld.

$M_{max} = -.107 (30) (16)^2 = 825. =$   
 $= 9900. \text{''-}\#$

$T = \frac{9900}{10.7} = 925. \#$

$T/in = \frac{925}{40''} = 23. \# / in$


Eccentr.  $\approx \frac{1}{2}''$  & arm (6.5)

$M/in = 23 \times \frac{1}{2} = 11.5 \text{''-}\# / in$

$S = \frac{(1)(.03)^2}{6} = .00015 \text{ in}^3 / in$

$S = \frac{(1)(.125)^2}{6} = .0026 \text{ in}^3 / in$

$f = \frac{11.5}{.0026} = 4400. \text{ psi}$

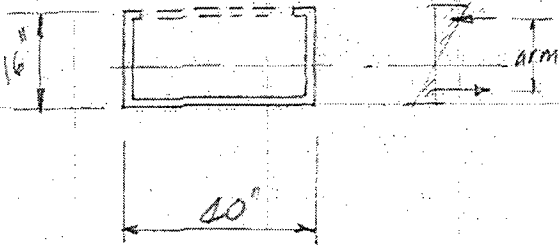

For large ducts, ZL- are used, which is more rigid yet:



For  $\frac{1}{8}''$  angle

Therefore, limit the spacg. of support; over 8' has to have  
L-1x1x $\frac{1}{8}$  at each flanged connection -

Shear

Assume bolts spaced 6'' e/c around connection flange (from picture)

$Shear/bolt = \frac{30\% \times 16}{2(40'' + 16'') \times \frac{1}{6}} = 256 \# / bolt$  and  $\frac{1}{4}''$  bolt OK  
(A-307 Mat'l.)

000000794





SIGNATURE ESL

DATE \_\_\_\_\_


TITLE TEACH BOTTOM

JOB NO. 6280

SUBJECT H<sub>2</sub>V DUCTS - SEISMIC ANALYSIS

SHEET NO. 10A

Ref. dwg. 5-108; 5-94; 5-86  
 Investigation of 18 WF beam for lateral load from frames.  
 Say 3/8" Flg. Thk. on 35' span (Min 9" width)

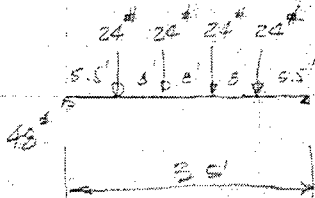

$$M_{25} = 48 \times 5.5 + 24 \times 8 = 456 \text{ ft-lb}$$

$$s = \frac{(6.815)(9)^2}{6} = 11.8 \text{ in}^3$$

$$v = \frac{48}{9 + \frac{2}{3}} = 61 \text{ psi}$$

$$f = \frac{12 \times 456}{11.8} = 4631 \text{ psi}$$

increase is very small -

Floor beams designed for 4<sup>th</sup> conc. hd during concrete which gives us enough to handle above loading -

Eliminate kickers

0000000791475



SIGNATURE ESR

DATE \_\_\_\_\_

TITLE FEACH BOTTOM APS JOB NO. 6280

SUBJECT H<sub>2</sub>V DUCTS - SEISMIC ANALYSIS SHEET NO. 11

SUMMARY:

A review of Spectrum Response Curves for the Reactor & Radwaste Bld'gs (Cmt. Room Area) for 1/2% Damp'g, shows that 20% G is max. value expected for rigid body motion.

The duct splice (flange connection) will have to be made with L-1x1x1/8 (which is standard) for spans of ducts larger than 8' c/c -

Details shown for support (brace) of vertical risers will have to be adjusted in the field for clearances.

This analysis is deemed applicable to all rectangular ducts

000000719496



~~5/2~~  
W. Betwell 10/12

SIGNATURE H. SOLORZANO

23-4/x-1

DATE 10/2/70

TITLE P.B.

JOB NO. 6280.2

SUBJECT H & V Ducts - Dyn. Seismic Anal. FRESH AIR SYST.

SHEET NO. 1 12

INTRODUCTION

From observation of in-place ducts around control room area, a flexible syst. of supports is not practical, since deflect. in range of several inches are not possible, physically, at the hangers, due in part to the longitudinal stiffness of the duct system itself.

In this case, we would have to analyze it similarly to a piping flexible system, which is lengthy & time-consuming a process.

Therefore, a rigid system would be a more logical way to go in view of the above observations.

We will try to determine what is required to do to the existing system as now placed to make it act rigid and also as an alternate for new systems not yet erected, what is the acceptable rigid syst. As a limit, a natural frequency of 30cps will be considered rigid body motion. - Damping used 1/2%

Supports are about 8' to 16' c/c presently  
Material is 20 ga.  $\approx 1.4\%/01$  (AISI at  $\approx 1.25\%/01$ )  
Insulat. wt  $\approx 0.5\%/01$  } From R. Armstrong

Say 2.0%/01 Total D.L. (no L.L. excap during const.)

Ref. dwg's. M-425 as marked by H & V group for system  
426  
407  
447

Must that be really in units?

000000007914887



5/27

23-4/X-1

SIGNATURE H. SOLORZANO

DATE \_\_\_\_\_

TITLE P.B.JOB NO. 6280SUBJECT H&V Ducts - Dynamic Seismic AnalysisSHEET NO. A 13METHOD OF ANALYSIS

Since we will use rigid system,

- a) Determine required duct span to provide us with a natural frequency in the rigid range ( $\geq 30$  cps)
- b) Obtain acceleration for rigid system from Spectrum Response Curves - Investigate range of accelerations involved for ducts of the whole job and if the difference is not great, we will use the worst.
- c) Determine equivalent static lateral load from above acceleration  $F = ma$
- d) Determine stresses on existing system for above loading. - Modify as required to satisfy criteria - Evaluate a new and possibly more efficient hanger system for future hangers - Rigidity criteria of support is the same as for ducts -
- e) Check out details for integrity, including duct splice
- f) Layout and detail hanger system

CONCLUSIONS

- 1.) Weights involved are extremely light, therefore, the proposed system lends itself readily for a rigid support system
- 2.) ~~Ducts under 14" will have to be handled separately~~
- 3.) As detailed here, square and rectangular ducts should give a good account of themselves under a seismic disturbance of the magnitude postulated for our site.
- 4.) Max. accel. = 0.2G



23-4/X-1

SIGNATURE H. SOLORZANO



DATE \_\_\_\_\_

TITLE P.B.


JOB NO. 6280

SUBJECT H & V Ducts - Dynamic Seismic Requirements

SHEET NO. 14

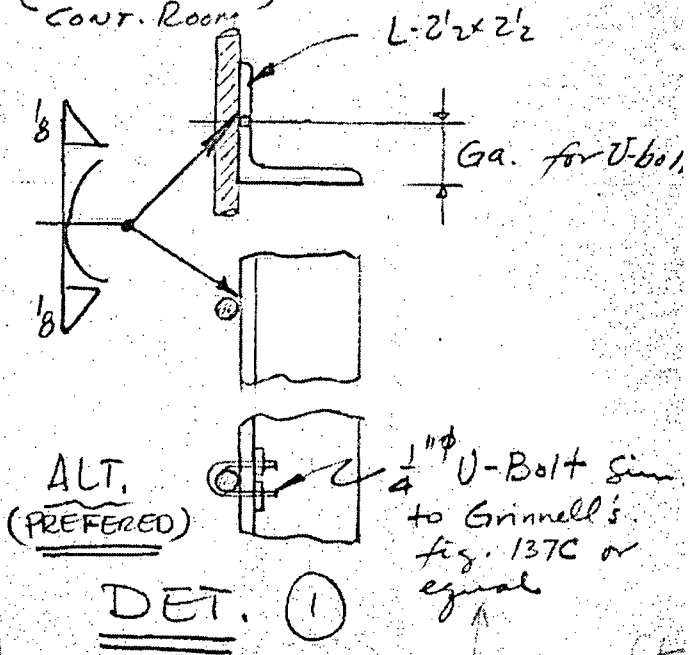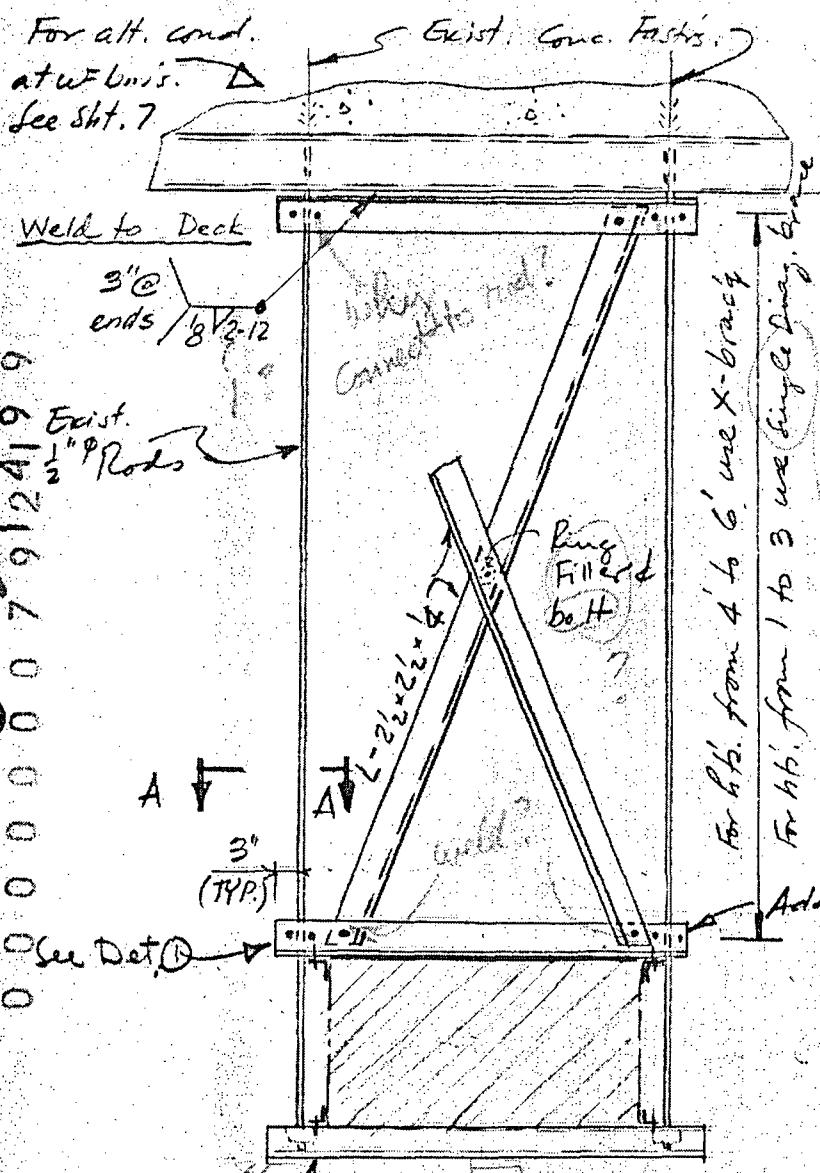


00000079124199

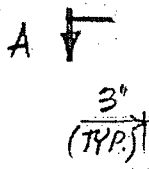

See Det. 1

TYPICAL EXIST. SUPPTS AT 8' 9/16 (±)

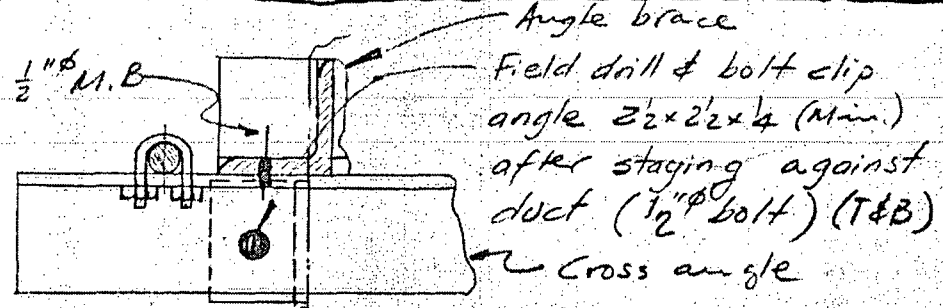

Do not attach to Duct


SEC. A-A

~~5/2-7~~

23-4/X-1

SIGNATURE H. SOLORZANO

DATE \_\_\_\_\_

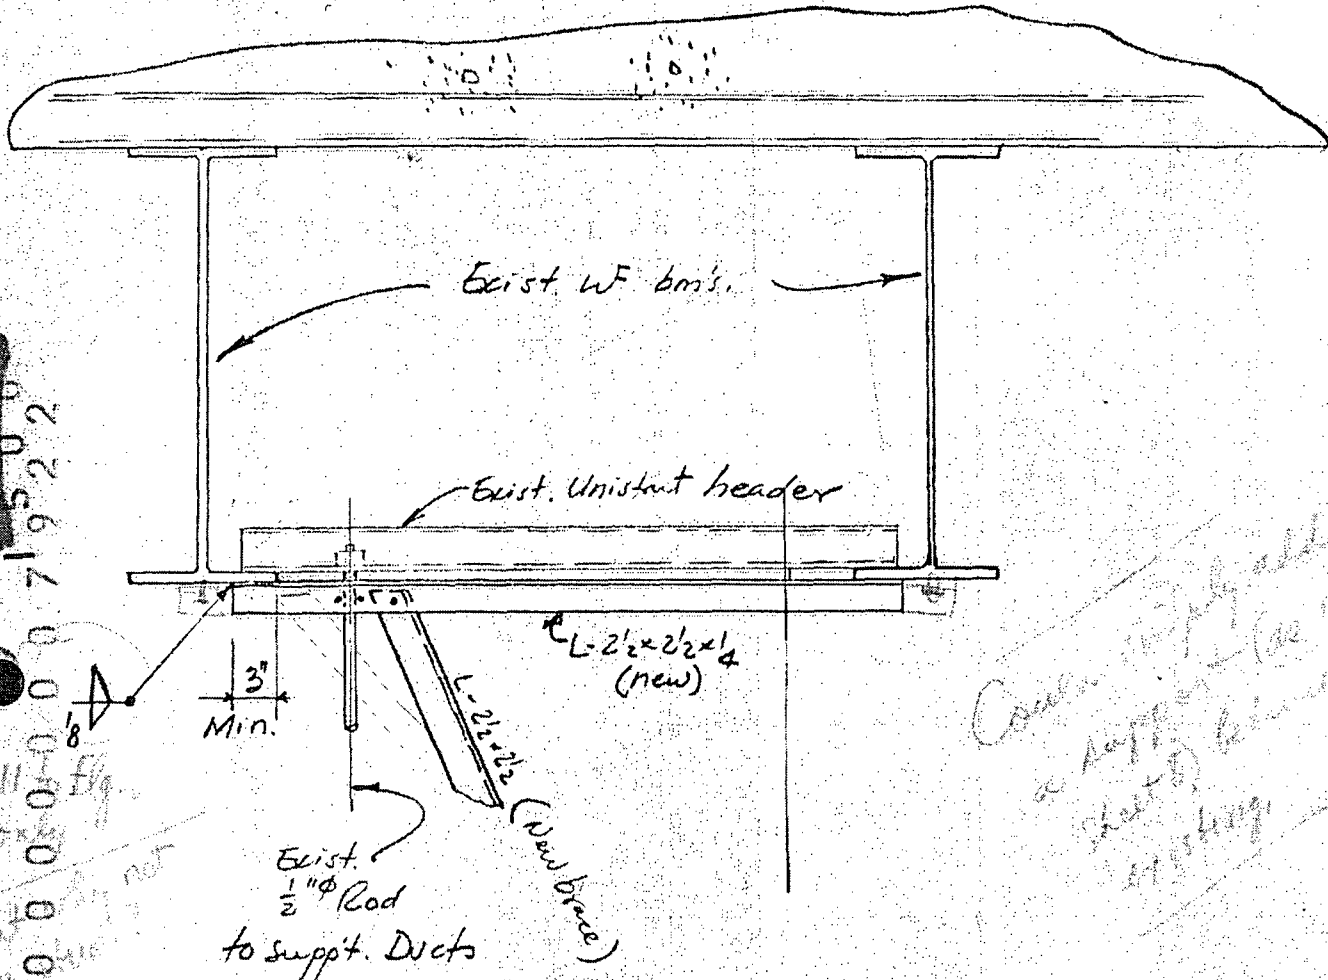TITLE P.B.JOB NO. 6280SUBJECT H & V Ducts - Dynamic Seismic Requirements (Exist'g.)  
CONT. ROOMSHEET NO. 7 15

*Check with all  
a support (see  
sheet 8) before  
installing*

### ALT. EXIST. CONDITION AT WF BM'S,

#### GENERAL NOTES:

1. Maximum Support Spacing shall be 4'-0" c/c and the stiffening shown shall apply to all ducts whose minimum dimension (smallest side) is 14" and larger.  
For ducts under 14" separate det. will be furnished
2. All stiffening members to be A-36 mat'l. and QA/QC documentation for Class I requirements applies -  
Bolts shall be ASTM A-307 (1/2"  $\phi$  U.N.)
3. New hangers to be added per attached detail
4. Straps will not be allowed for hangers



5/77

SIGNATURE H. SOLORZANO

23-4/X-1


DATE \_\_\_\_\_

TITLE P.B

JOB NO. 6280

SUBJECT H & V Ducts - Dynamic Seismic Requirements (New hangers) SHEET NO. 9 16

[CONT. ROOM]

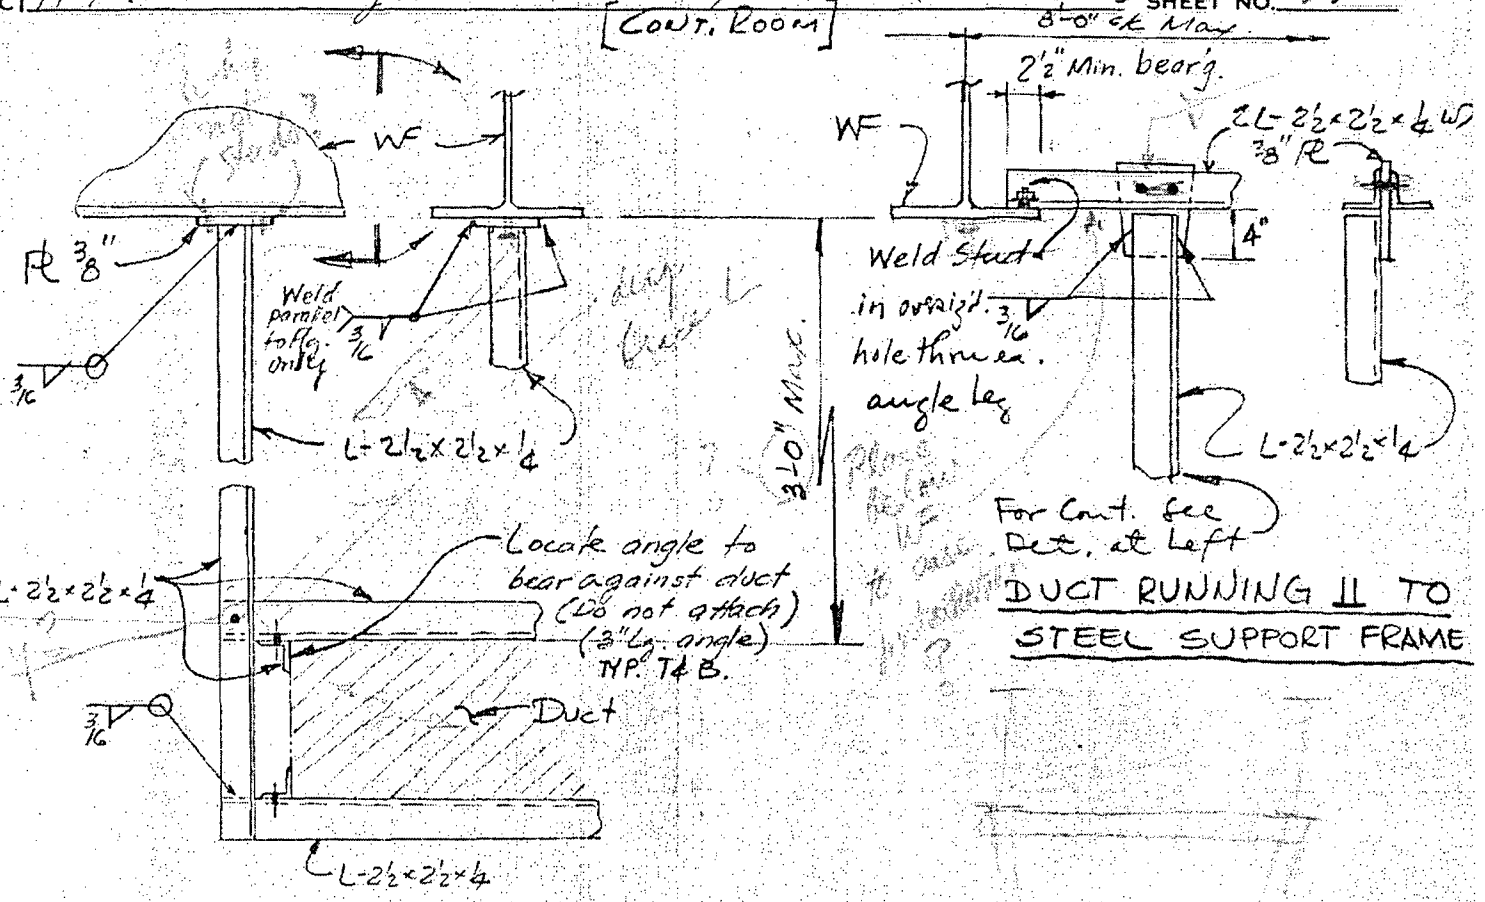

For Cont. see Det. at left  
DUCT RUNNING  $\perp$  TO  
STEEL SUPPORT FRAME

DUCT RUNNING  $\perp$  TO  
STEEL SUPPORT FRAME

TYPICAL NEW SUPPORT DETAIL

NOTES:

1. Supports shall be 4'-0" c/c max.
2. Fabricate frames in one piece and slip under duct - bolt up & fit in place
3. This detail requires hangers to frame at bottom of steel frame members - not to the slab underside
4. For hanger heights over 3'-0" use diagonal braces from L-2 1/2 x 2 1/2 x 1/4 - For details see sheets to existing hangers (cont.)
5. For additional notes & applicability of detail see sheets pertaining to existing hangers. (Sht. 7)
- 6.

00000007912530



CALCULATION SHEET

0510 (4-68)

SIGNATURE H. SOLORZANO

23-4/x-1


DATE 5/2

TITLE P.B.


JOB NO. 6280

SUBJECT H & V Ducts - Dynamic Seismic Requirements


SHEET NO. 12 of 17

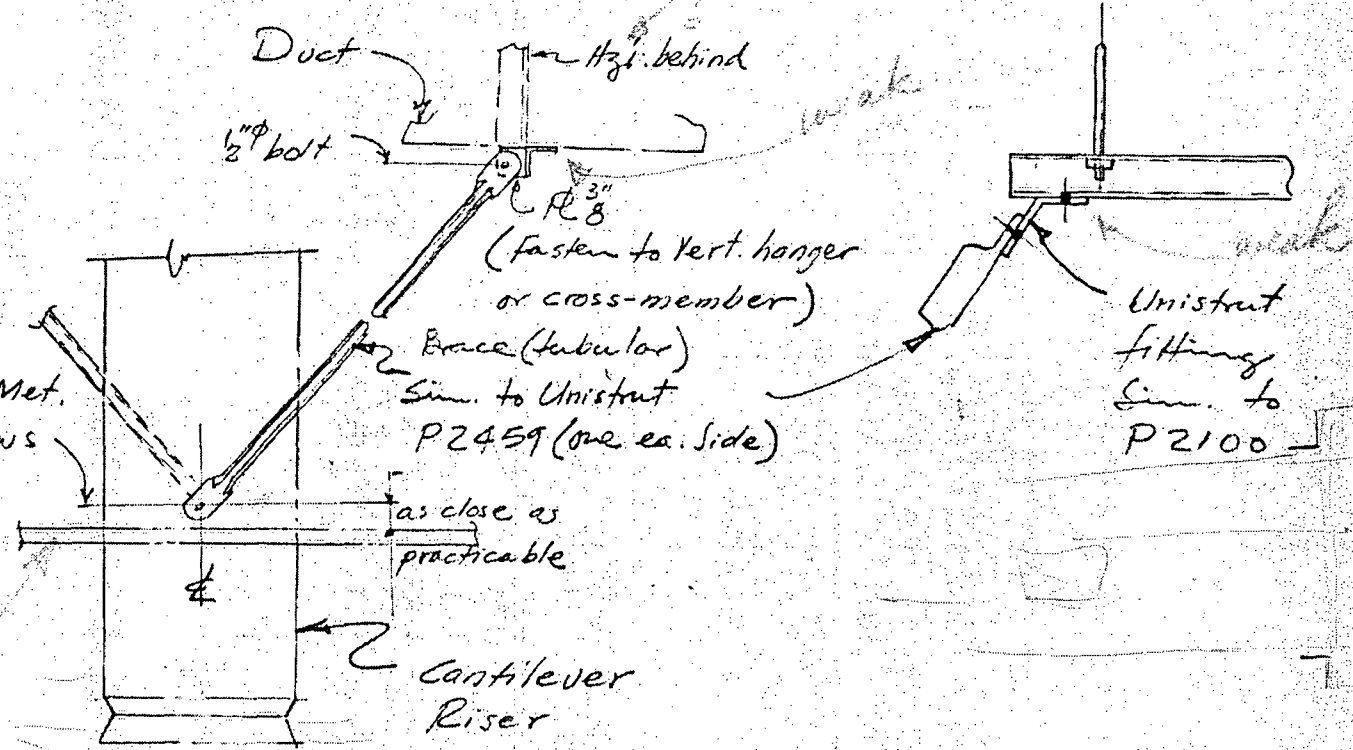

TYP. BRACE AT CANT. RISER

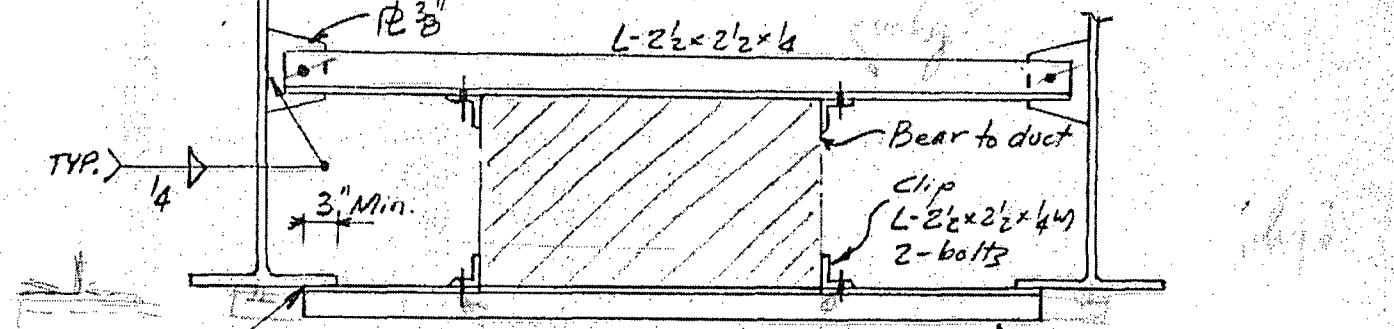

ST 3.5WF 7.65 or (2L-2 1/2 x 2 1/2 x 1/4) 4'-0" c/c spac's.

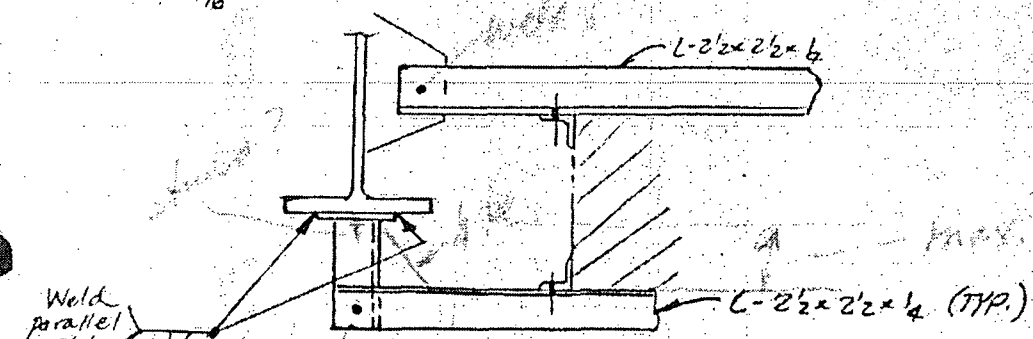

TYP. FRAMING BET. FL. MEMBERS

00000007925AD2



Peach Bottom  
Job No. 6280

23-4/x-1  
Sh. 17

MEMO  
FROM - BOB McCAFFERY

To: *Hirving*

*Letter found*

*let*

0000000000  
000000007925



1503



~~Bot 5/27~~

SIGNATURE H. SOLOGZANO

23-4/4-1

DATE 10/3/70

TITLE P.B.

JOB NO. 6280-2

SUBJECT H & V Ducts - Dyn. Seismic Anal. FRESH AIR SYST.

SHEET NO. 1 18

INTRODUCTION

From observation of in-place ducts around control room area, a flexible syst. of supports is not practical, since deflection in range of several inches are not possible, physically, at the hangers, due in part to the longitudinal stiffness of the duct system itself.

In this case, we would have to analyze it similarly to a piping flexible system, which is lengthy & time-consuming a process.

Therefore, a rigid system would be a more logical way to go in view of the above observations.

We will try to determine what is required to do to the existing system as now planned to make it act rigid and also as an alternate for new systems not yet erected, what is the acceptable rigid syst. As a limit, a natural frequency of 30 cps will be considered rigid body motion. - Damping used 1/2%

Supports are about 8' to 16' c/c presently  
Material is 22 ga.  $\approx 1.4\%/01$  } From R. Armstrong  
Insulat. wt  $\approx 0.5\%/01$  }  
Say 2.0%/01 Total D.L. (no L.L. except during const.)

Ref. durg's. M-425 as marked by H & V group for system  
426  
407  
447

000000007912360A  
Fabrication, 7' duct is independent  
Standard duct

~~5/27~~

23-4/x-1

SIGNATURE H. SOLORZANO

DATE \_\_\_\_\_

TITLE P.P.JOB NO. 6280SUBJECT H&V Ducts - Dynamic Seismic AnalysisSHEET NO. A 19METHOD OF ANALYSIS

Since we will use rigid system,

- Just, should the cable stay? → would otherwise change for file and reference.*
- Determine required duct span to provide us with a natural frequency in the rigid range ( $\geq 30$  cps)
  - Obtain acceleration for rigid system from Spectrum Response Curves - Investigate range of accelerations involved for ducts of the whole job and if the difference is not great, we will use the worst.
  - Determine equivalent static lateral load from above acceleration  $F = ma$
  - Determine stresses on existing system for above loading. - Modify as required to satisfy criteria - Evaluate a new and possibly more efficient hanger system for future hangers - Rigidity criteria of support is the same as for ducts -
  - Check out details for integrity, including duct splice
  - Layout and detail hanger system

CONCLUSIONS

- Weights involved are extremely light, therefore, the proposed system lends itself readily for a rigid support system
- Ducts under 14" will have to be handled separately
- As detailed here, square and rectangular ducts should give a good account of themselves under a seismic disturbance of the magnitude postulated for our site.

~~5/27~~

23-4/X-1

SIGNATURE H. SOLORZANO

DATE \_\_\_\_\_

TITLE P.B.


JOB NO. 6280

SUBJECT H & V Ducts - Dynamic Seismic Requirements

SHEET NO. 6 20


(EXISTING.)  
CONT. ROOM

For alt. cond. at u/b ris. See sht. 7

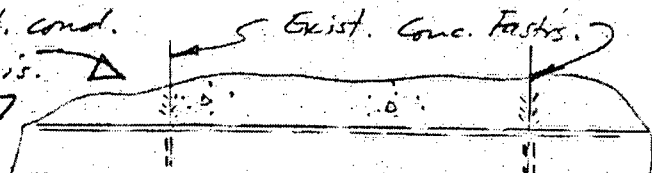

Weld to Deck  
3" @ ends / 3/8" V-12


Exist. 1/2" P Rods

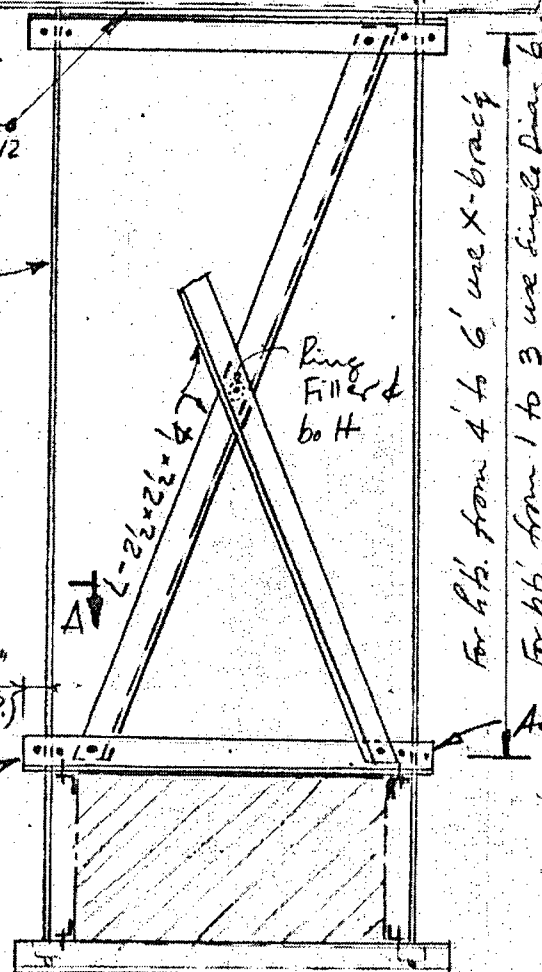

Ring Filler & bolt

For h/b. from 4' to 6' use X-bracing

For h/b. from 1 to 3 use single Diag. brace

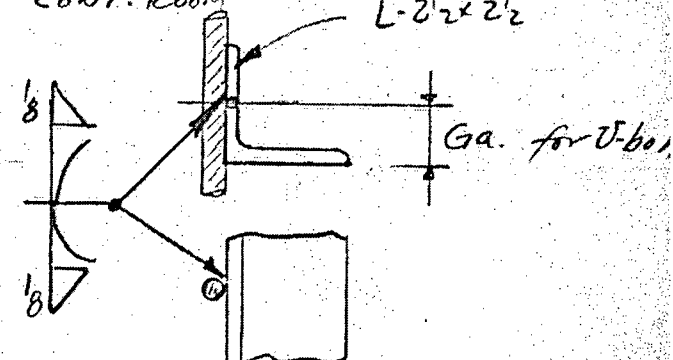

ALT. (PREFERRED)

DET. ①

1/4" phi U-Bolt Sim to Grinnell's fig. 137C or equal

00000079125806

A ↓


3" (TYP.)

See Det. ①

Add L-2 1/2 x 2 1/2 x 1/4 (3 x 3 x 8 kept.)

Exist. Unistrut

TYPICAL EXIST. SUPPTS AT 8' +/-

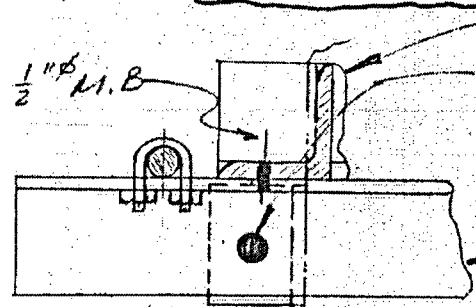

Angle brace  
Field drill & bolt clip angle 2 1/2 x 2 1/2 x 1/4 (Min.) after staying against duct (1/2" bolt) (T&B)  
Cross angle

Do not attach to Duct


Duct

SEC. A-A

125

SIGNATURE H. SOLORZANO5/77  
23-4/X-1

DATE \_\_\_\_\_

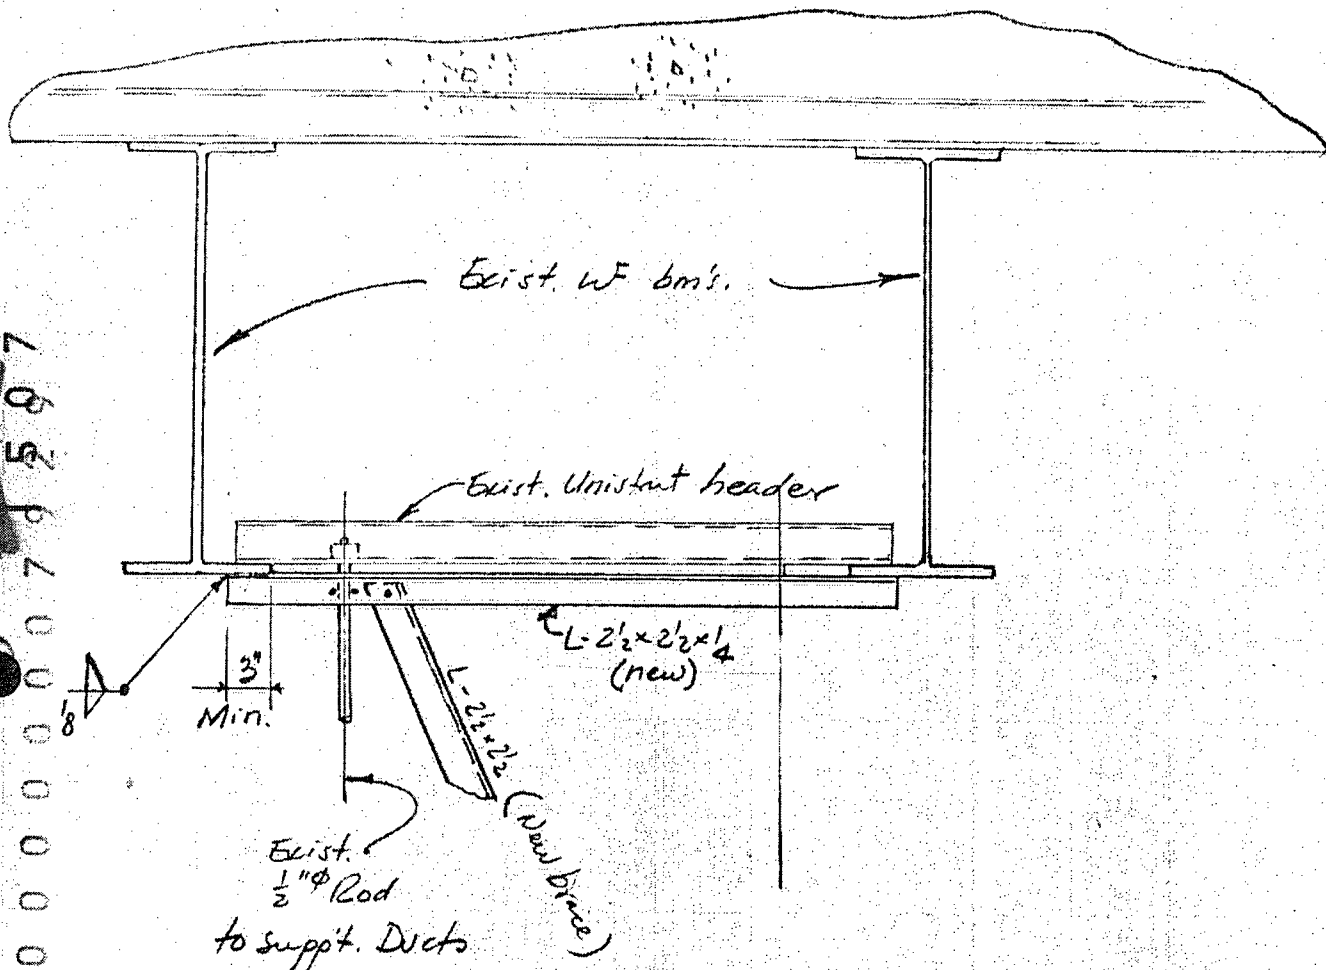TITLE P.B.JOB NO. 6280SUBJECT H & V Ducts - Dynamic Seismic Requirements (Exist'g.)  
CONT. ROOMSHEET NO. 7 21ALT. EXIST. CONDITION AT WF BM'S.GENERAL NOTES:

1. Maximum Support Spacing shall be 4'-0" c/c and the stiffening shown shall apply to all ducts whose minimum dimension (smallest side) is 14" and larger. For ducts under 14" separate det. will be furnished
2. All stiffening members to be A-36 mat'l. and QA/QC documentation for Class I requirements applies - Bolts shall be ASTM A-307 ( $\frac{1}{2}$ "  $\phi$  U.N.)
3. New hangers to be added per attached detail
4. Straps will not be allowed for hangers

CALCULATION SHEET



SIGNATURE H. SALORZANO

23-4/1-1  
5/2


DATE \_\_\_\_\_

TITLE P.E.

JOB NO. 6280

SUBJECT H & V Ducts - Dynamic Seismic Requirements (New hangers)  
[Cont. Room]

SHEET NO. 9/22

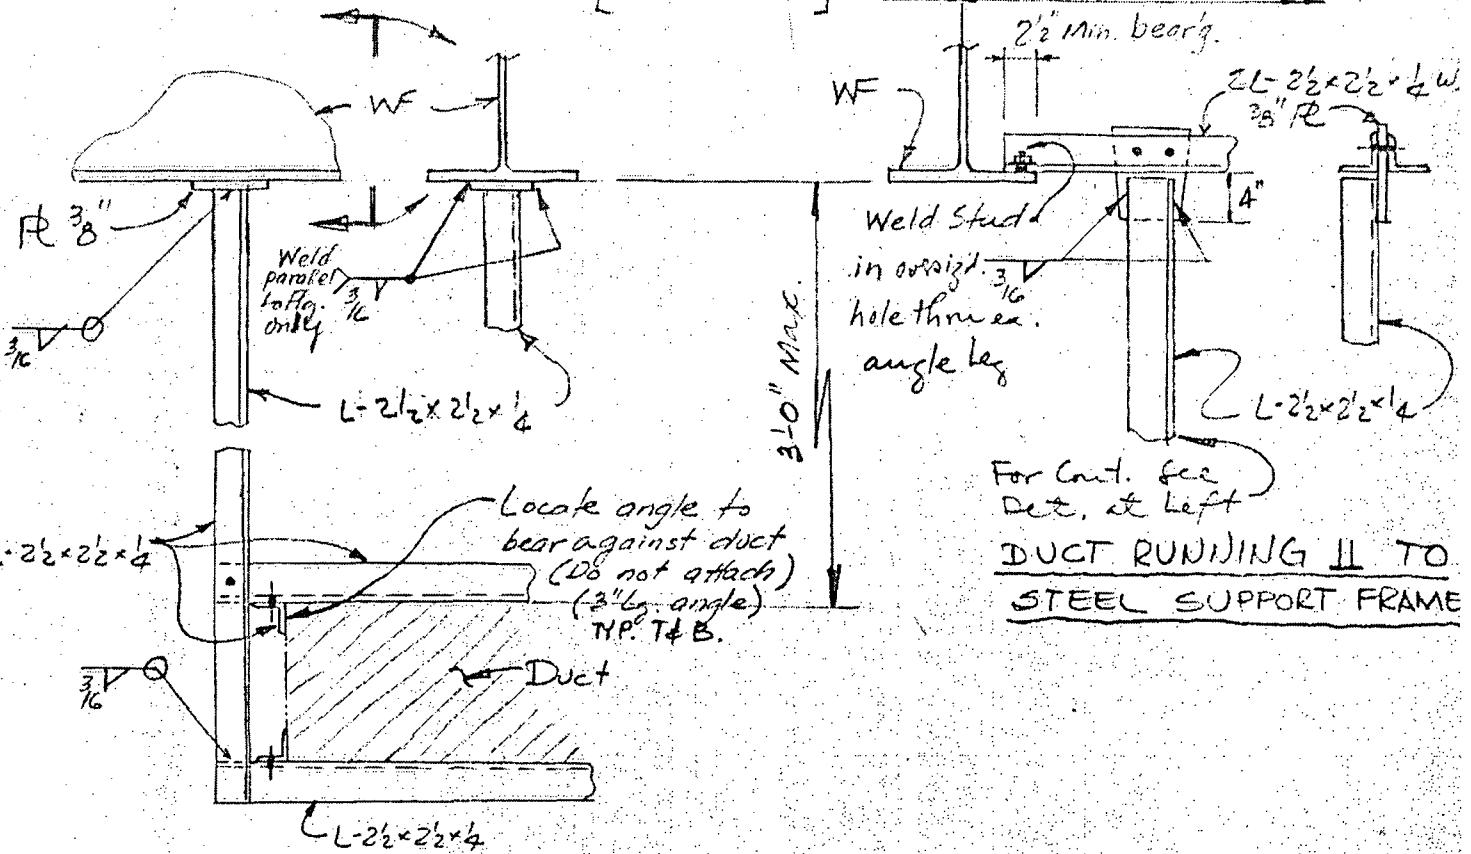

For Cont. see Det. at left

DUCT RUNNING || TO STEEL SUPPORT FRAME

DUCT RUNNING ⊥ TO STEEL SUPPORT FRAME

TYPICAL NEW SUPPORT DETAIL

NOTES:

1. Supports shall be 4'-0" c/c max.
2. Fabricate frames in one piece and slip under duct - bolt up & fit in place
3. This detail requires hangers to frame at bottoms of steel frame members - not to the slab underside
4. For hanger heights over 3'-0" use diagonal braces from L-2 1/2 x 2 1/2 x 1/4 - For details see sheets to existing hangers (SHT)
5. For additional notes & applicability of detail see sheets pertaining to existing hangers. (SHT.7)
- 6.

U U U U U U U U  
 0 0 0 0 0 0 0 0  
 7 1 9 5 0 0 8  
 127



CALCULATION SHEET

0510 (4-68)

SIGNATURE H. SOLORZANO

23-4/X-1

5/27


DATE \_\_\_\_\_

TITLE P.B.


JOB NO. 6280

SUBJECT H & V Ducts - Dynamic Seismic Requirements

SHEET NO. 12 23

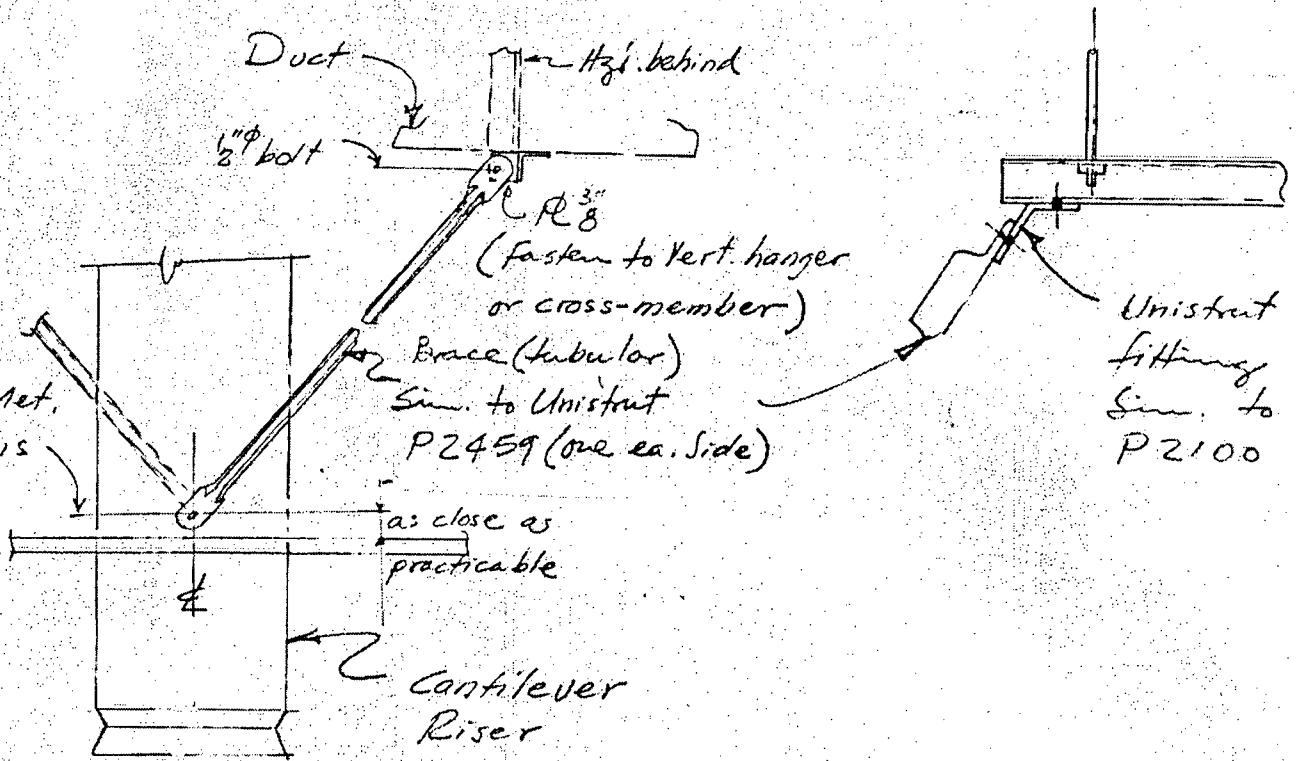


TYP. BRACE AT CANT. RISER

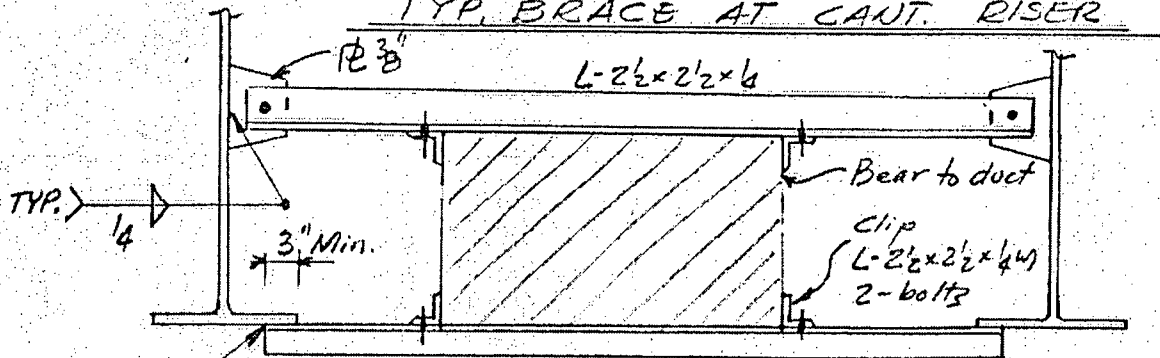

ST 3.5WF7.65 or (2L-2 1/2 x 2 1/2 x 1/4) 4'-0" c/c spac'g.

TYP. > 3/16

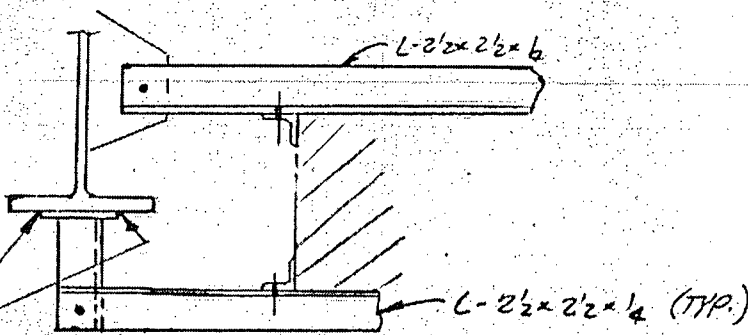

TYP. FRAMING BET. FL. MEMBERS

000000079135109

28



5/27

23-4/x-1

SIGNATURE ESR

DATE 1/6/70

TITLE P.B.

JOB NO. 6280-2


SUBJECT H & V Ducts & Valve at Radwaste Struct.

SHEET NO. X 2A

Ref. dwg. M-425 & M-447 - Plans & Sec. J/4-447

From R. Armstrong Valve wt = 1200#

Inb. length of ducts 25'

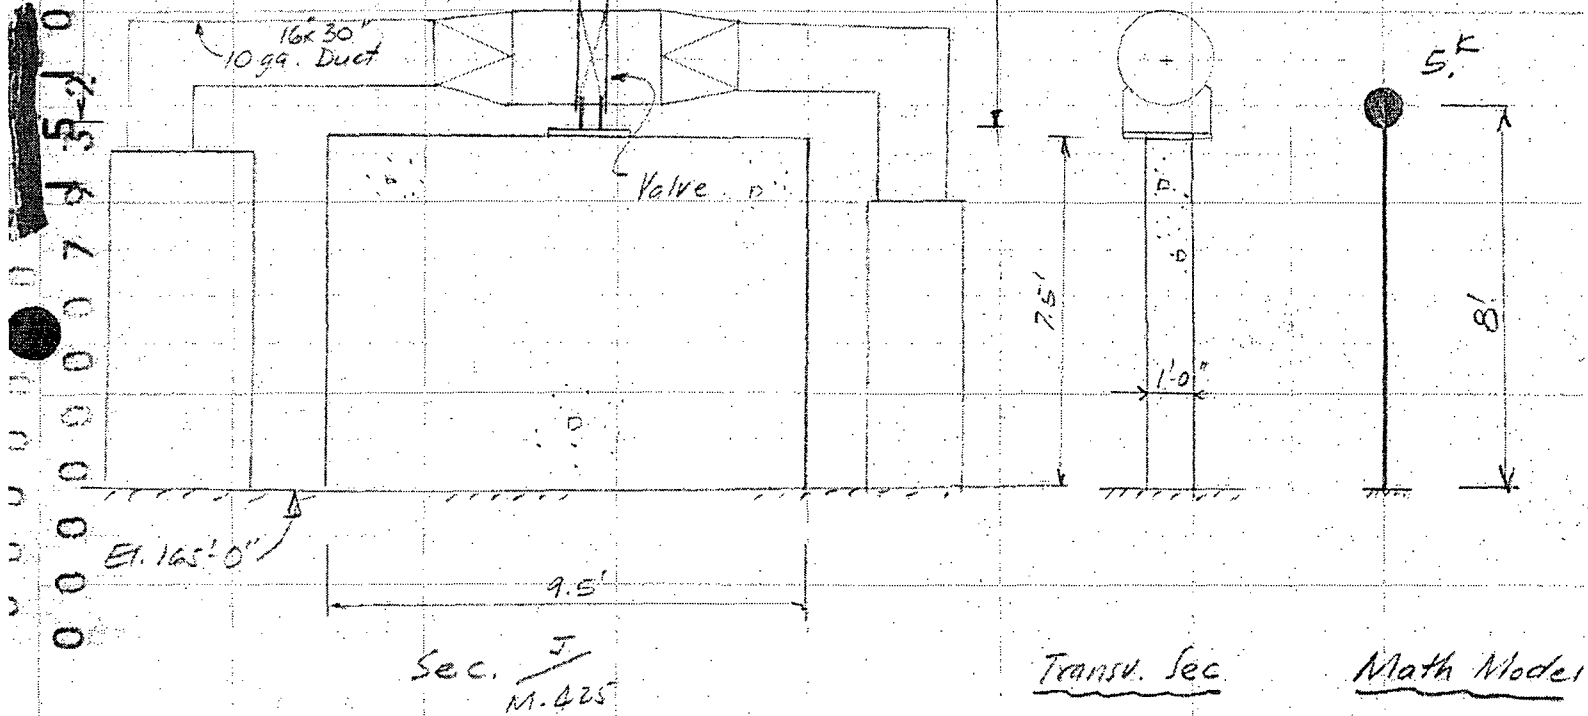

10 ga. duct  $\approx 90 \text{ lb/ft}^2 \approx 5.6 \text{ lb/ft}^2$     Perim  $\approx 7.5'$      $\therefore \text{wt/ft} = 5.6 \times 7.5 = 42 \text{ lb/ft}$

12" Conc. Wall =  $150 \text{ lb/ft}^2 \times 9.5' \times \left(\frac{33}{140} \times 7.5'\right) = 2520 \text{ lbs}$      $\frac{1060 \text{ lb}}{1060 \text{ lb}}$

*Tinoshenko*

Total Mass:

Duct	=	1060.
Valve	=	1200.
Wall	=	2520.
	=	<u>4780.</u>

Use 5,000. lbs

Wall I =  $\frac{(12 \times 9.5)(12)^3}{12} = 16,400 \text{ in}^4$

129



5/27  
23-4/X-1SIGNATURE ESR

DATE \_\_\_\_\_

TITLE PEACH BOTTOM APSJOB NO. 6280SUBJECT H & V DUCTSSHEET NO. 25

Static Defl. for 100%G :

$$\Delta = \frac{PL^3}{5T \cdot 3EI} = \frac{5^k \cdot (96)^3}{3 \times 3.2 \times 10^3 \times 16,400} = 0.0295''$$

$$\sqrt{\Delta_{st}} = 0.172$$

$$f_{nat} = \frac{188}{\sqrt{\Delta}} = \frac{188}{0.172} = 1090 \text{ RPM} = \underline{18.2 \text{ cps}}$$


From Floor Acc. Spectrum @  $6.165 \text{ L} \cdot 0''$  E-W direct. & 2% damp'g.  
(Radwaste PLD's Area)

$$a \approx 0.3 g$$

damp'g ER

$$\text{Max. Cred. ER } a = 0.72 g$$

$$F = 0.3 \times 5^k = \underline{1.5^k}$$

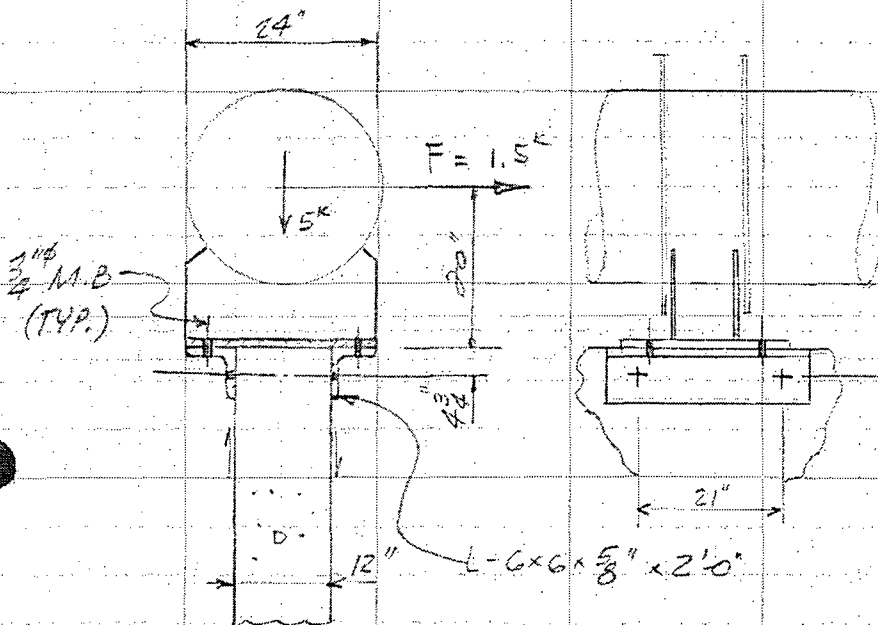check of Conn. Defl. at Valve

$$M_{ot} = 1.5^k \times 20'' = 30 \text{ in} \cdot \text{k}$$

$$\text{Shear} = \frac{30 \text{ in} \cdot \text{k}}{12''} = 2.5^k \quad \text{or}$$

$$= \frac{30 \text{ in} \cdot \text{k}}{21''} = 1.5^k$$

Use 2-  $\frac{3}{4}$  A.B. gird for  $3^k$  (tot.)

$$P/A = \frac{5^k}{24 \times 21} = 10 \text{ psi}$$

$$\text{Stress} = \frac{30}{27 \times 21} = .053 \text{ ksi}$$

$\frac{9''}{16} R$

