


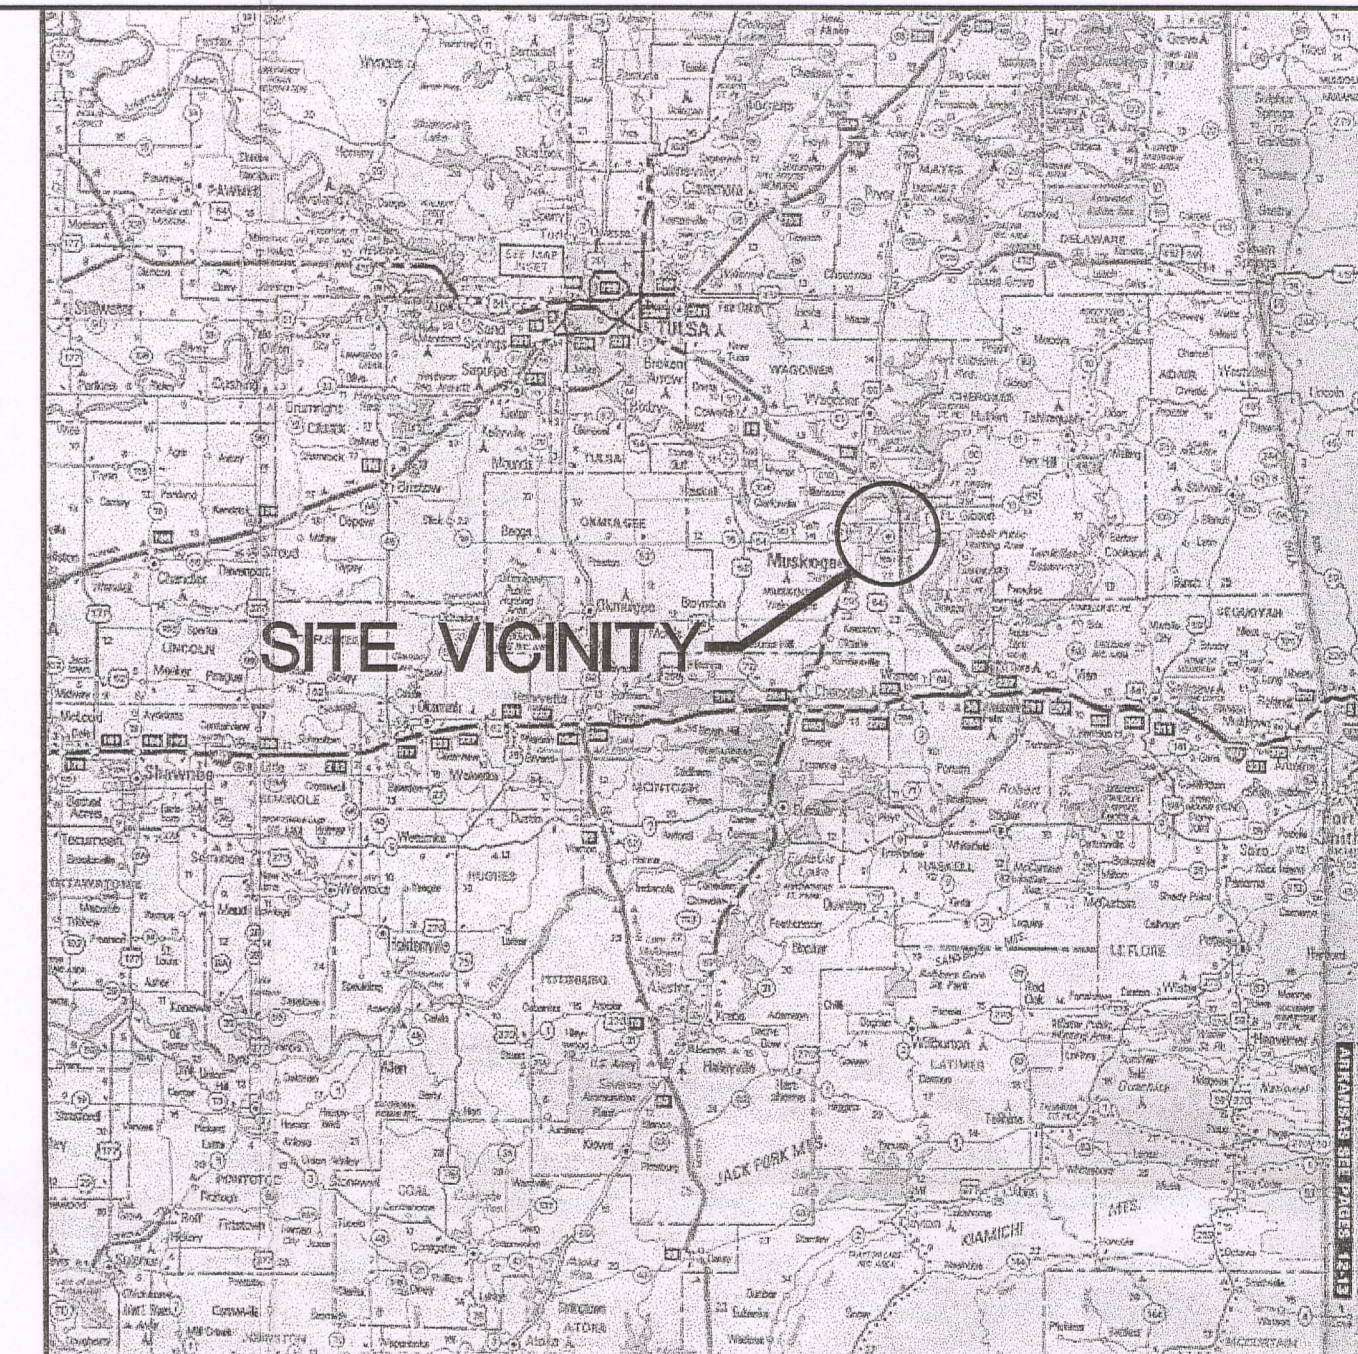


SITE LOCATION MAP


 SCALE - FEET
 0 1000
 OOKLAHOMA
 QUADRANGLE LOCATION
 REFERENCE
 USGS 7.5-MIN TOPOGRAPHIC QUADRANGLE
 STYLES NE, OKLAHOMA, DATED 1983, PHOTO REVISED 1979.
 NORTHEAST, OKLAHOMA, DATED 1974.
 SCALE 1:24000.

PREPARED FOR

Fansteel, Inc. Muskogee, Oklahoma



SITE VICINITY MAP

STATE OF OKLAHOMA
 SCALE 1" = 22.2 MILES

 REFERENCE
 AAA ROAD ATLAS
 DATED 1994


EXCAVATION AND ON-SITE MANAGEMENT OF RADIOLOGICALLY AFFECTED SOILS AND GROUNDWATER COLLECTION TRENCH AS-BUILT DRAWING PACKAGE

SHEET NUMBER DRAWING TITLE

| | |
|-------------------|--|
| CD-1 | TITLE SHEET |
| CD-2 | PRE-CONSTRUCTION CONDITIONS [△] |
| CD-3 | CONSTRUCTION PLAN |
| CD-4 | TRENCH PROFILE STA. 0+00 - 15+70.00 |
| CD-5 | TRENCH PROFILE STA. 15+70.00 - 30+98.71 |
| CD-6 | TRENCH DETAILS |
| CD-7 | MISCELLANEOUS DETAILS |
| CD-8 | MISCELLANEOUS DETAILS |
| CD-9 [△] | EXCAVATION DETAILS AND CONFIRMATION SAMPLING |

PREPARED BY

EARTH SCIENCES CONSULTANTS, INC.
EXPORT, PENNSYLVANIA

| | | |
|--|--------------------|---|
| REVISION | DATE | DESCRIPTION |
| △ | 11/18/99 | AS-BUILT |
| | | CD-1 |
| | | TITLE SHEET |
| EXCAVATION AND ON-SITE MANAGEMENT OF RADIOLOGICALLY AFFECTED SOILS AND GROUNDWATER COLLECTION TRENCH CONTRACT DRAWING PACKAGE MUSKOGEE, OKLAHOMA | | |
| PREPARED FOR FANSTEEL, INC. MUSKOGEE, OKLAHOMA <i>D-01</i> | | |
| APPROVED | <i>M. H. H. H.</i> | |
| CHECKED | 2/15/99 | |
| DRAWN | WJA/29JAN1998 | |
| DRAWING NUMBER | |  |
| 3789500 | | Earth Sciences Consultants, Inc. |