



STRAW BALE SILT FENCE

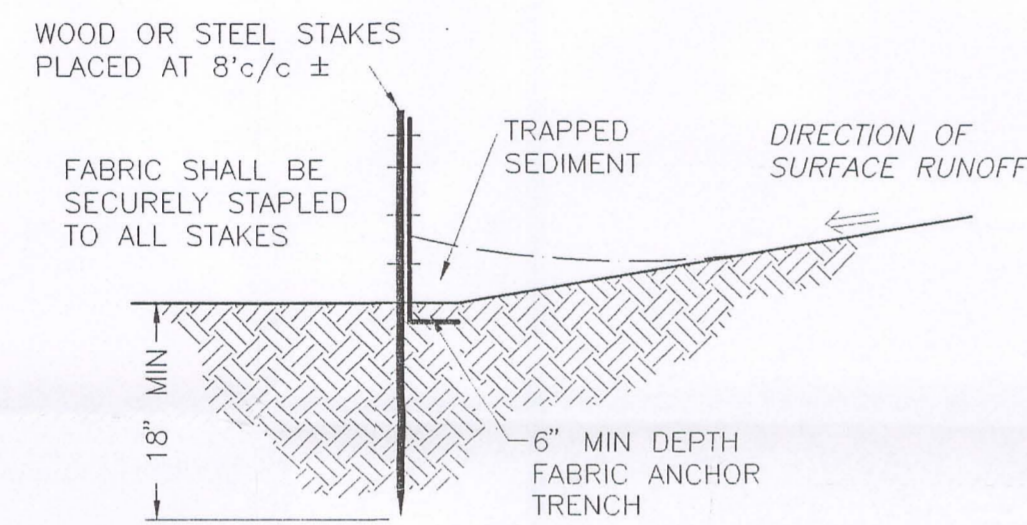


FABRIC SILT FENCE

DETAIL CD7-1
SEDIMENTATION BARRIER INSTALLATION DETAILS
NOT TO SCALE

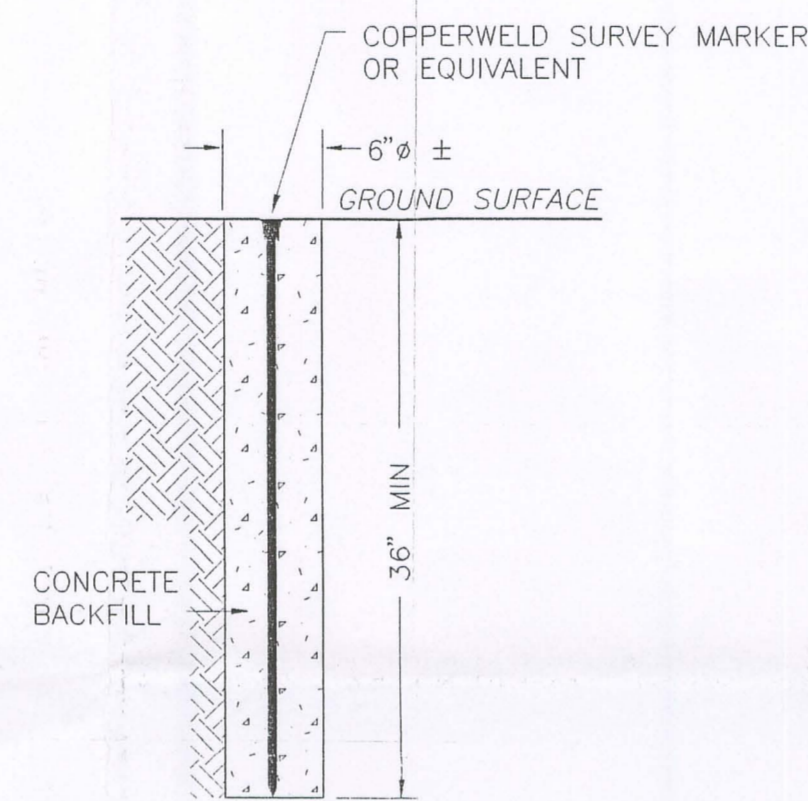


DETAIL CD7-3
TYPICAL MONUMENT INSTALLATION
SCALE 1" = 1'0"

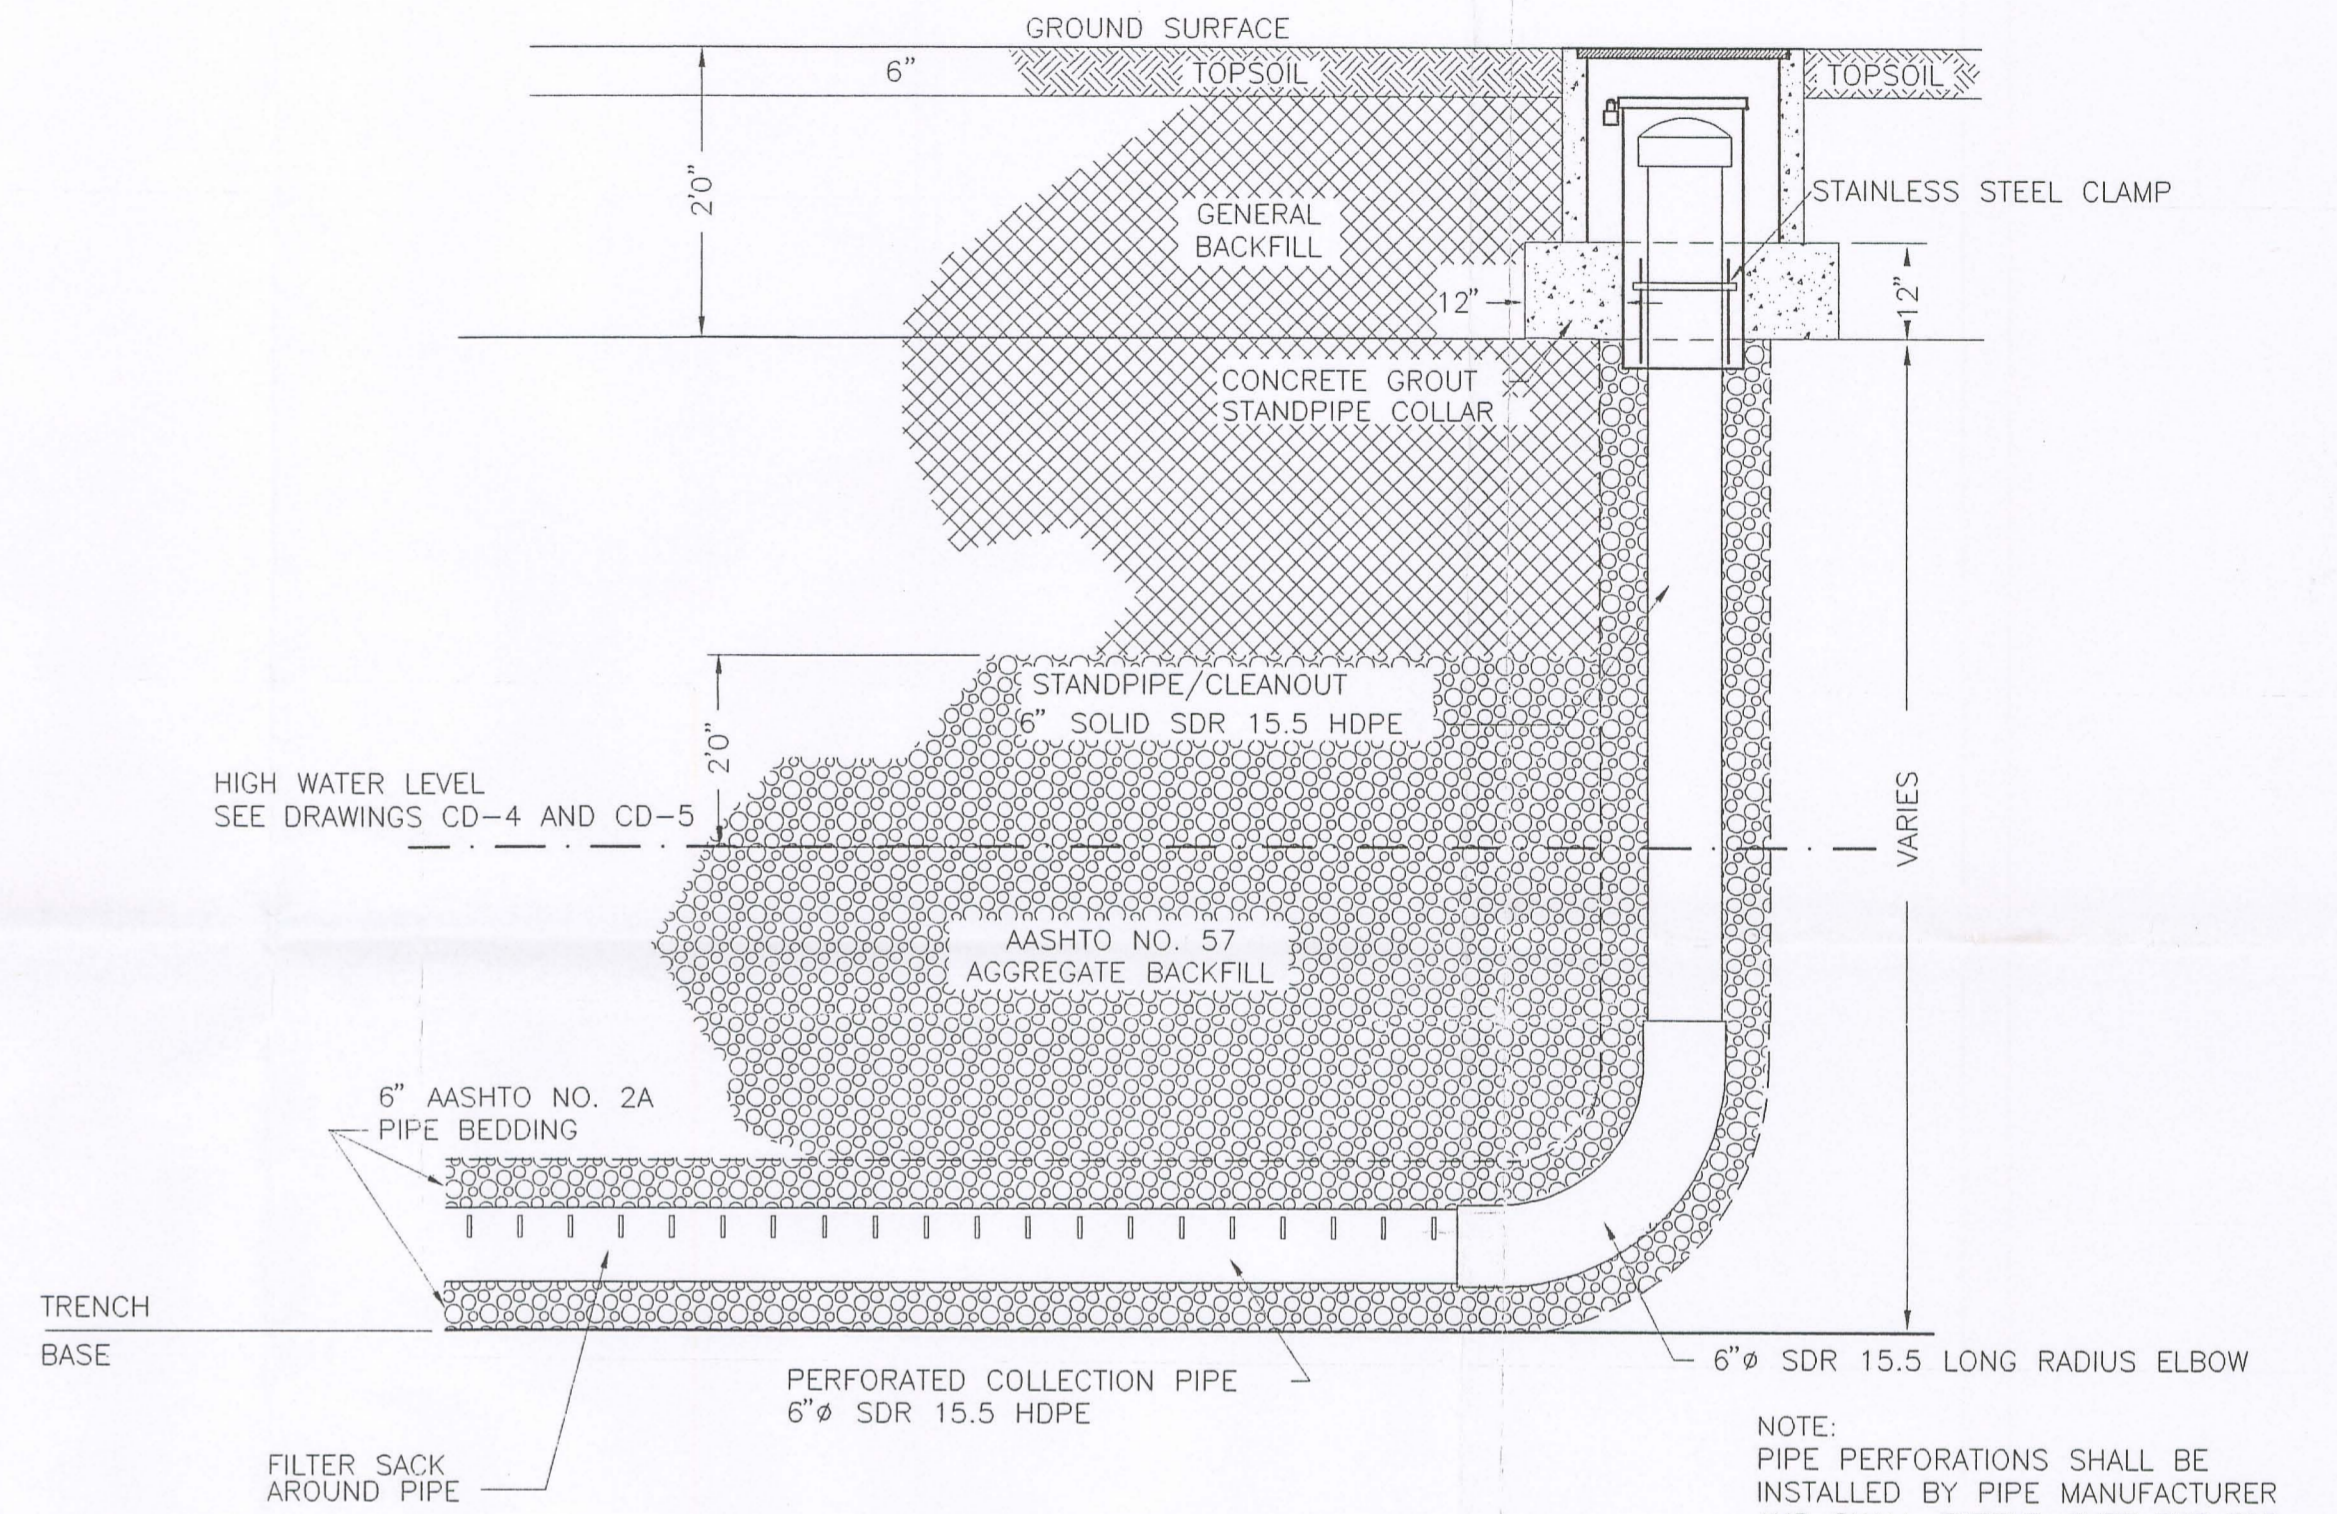


DETAIL CD7-6
COLLECTION STANDPIPE/CLEANOUT
NOT TO SCALE

NOTE:
PIPE PERFORATIONS SHALL BE
INSTALLED BY PIPE MANUFACTURER
AND SHALL EXTEND OVER THE TOP
HALF RADIUS OF THE PIPE.

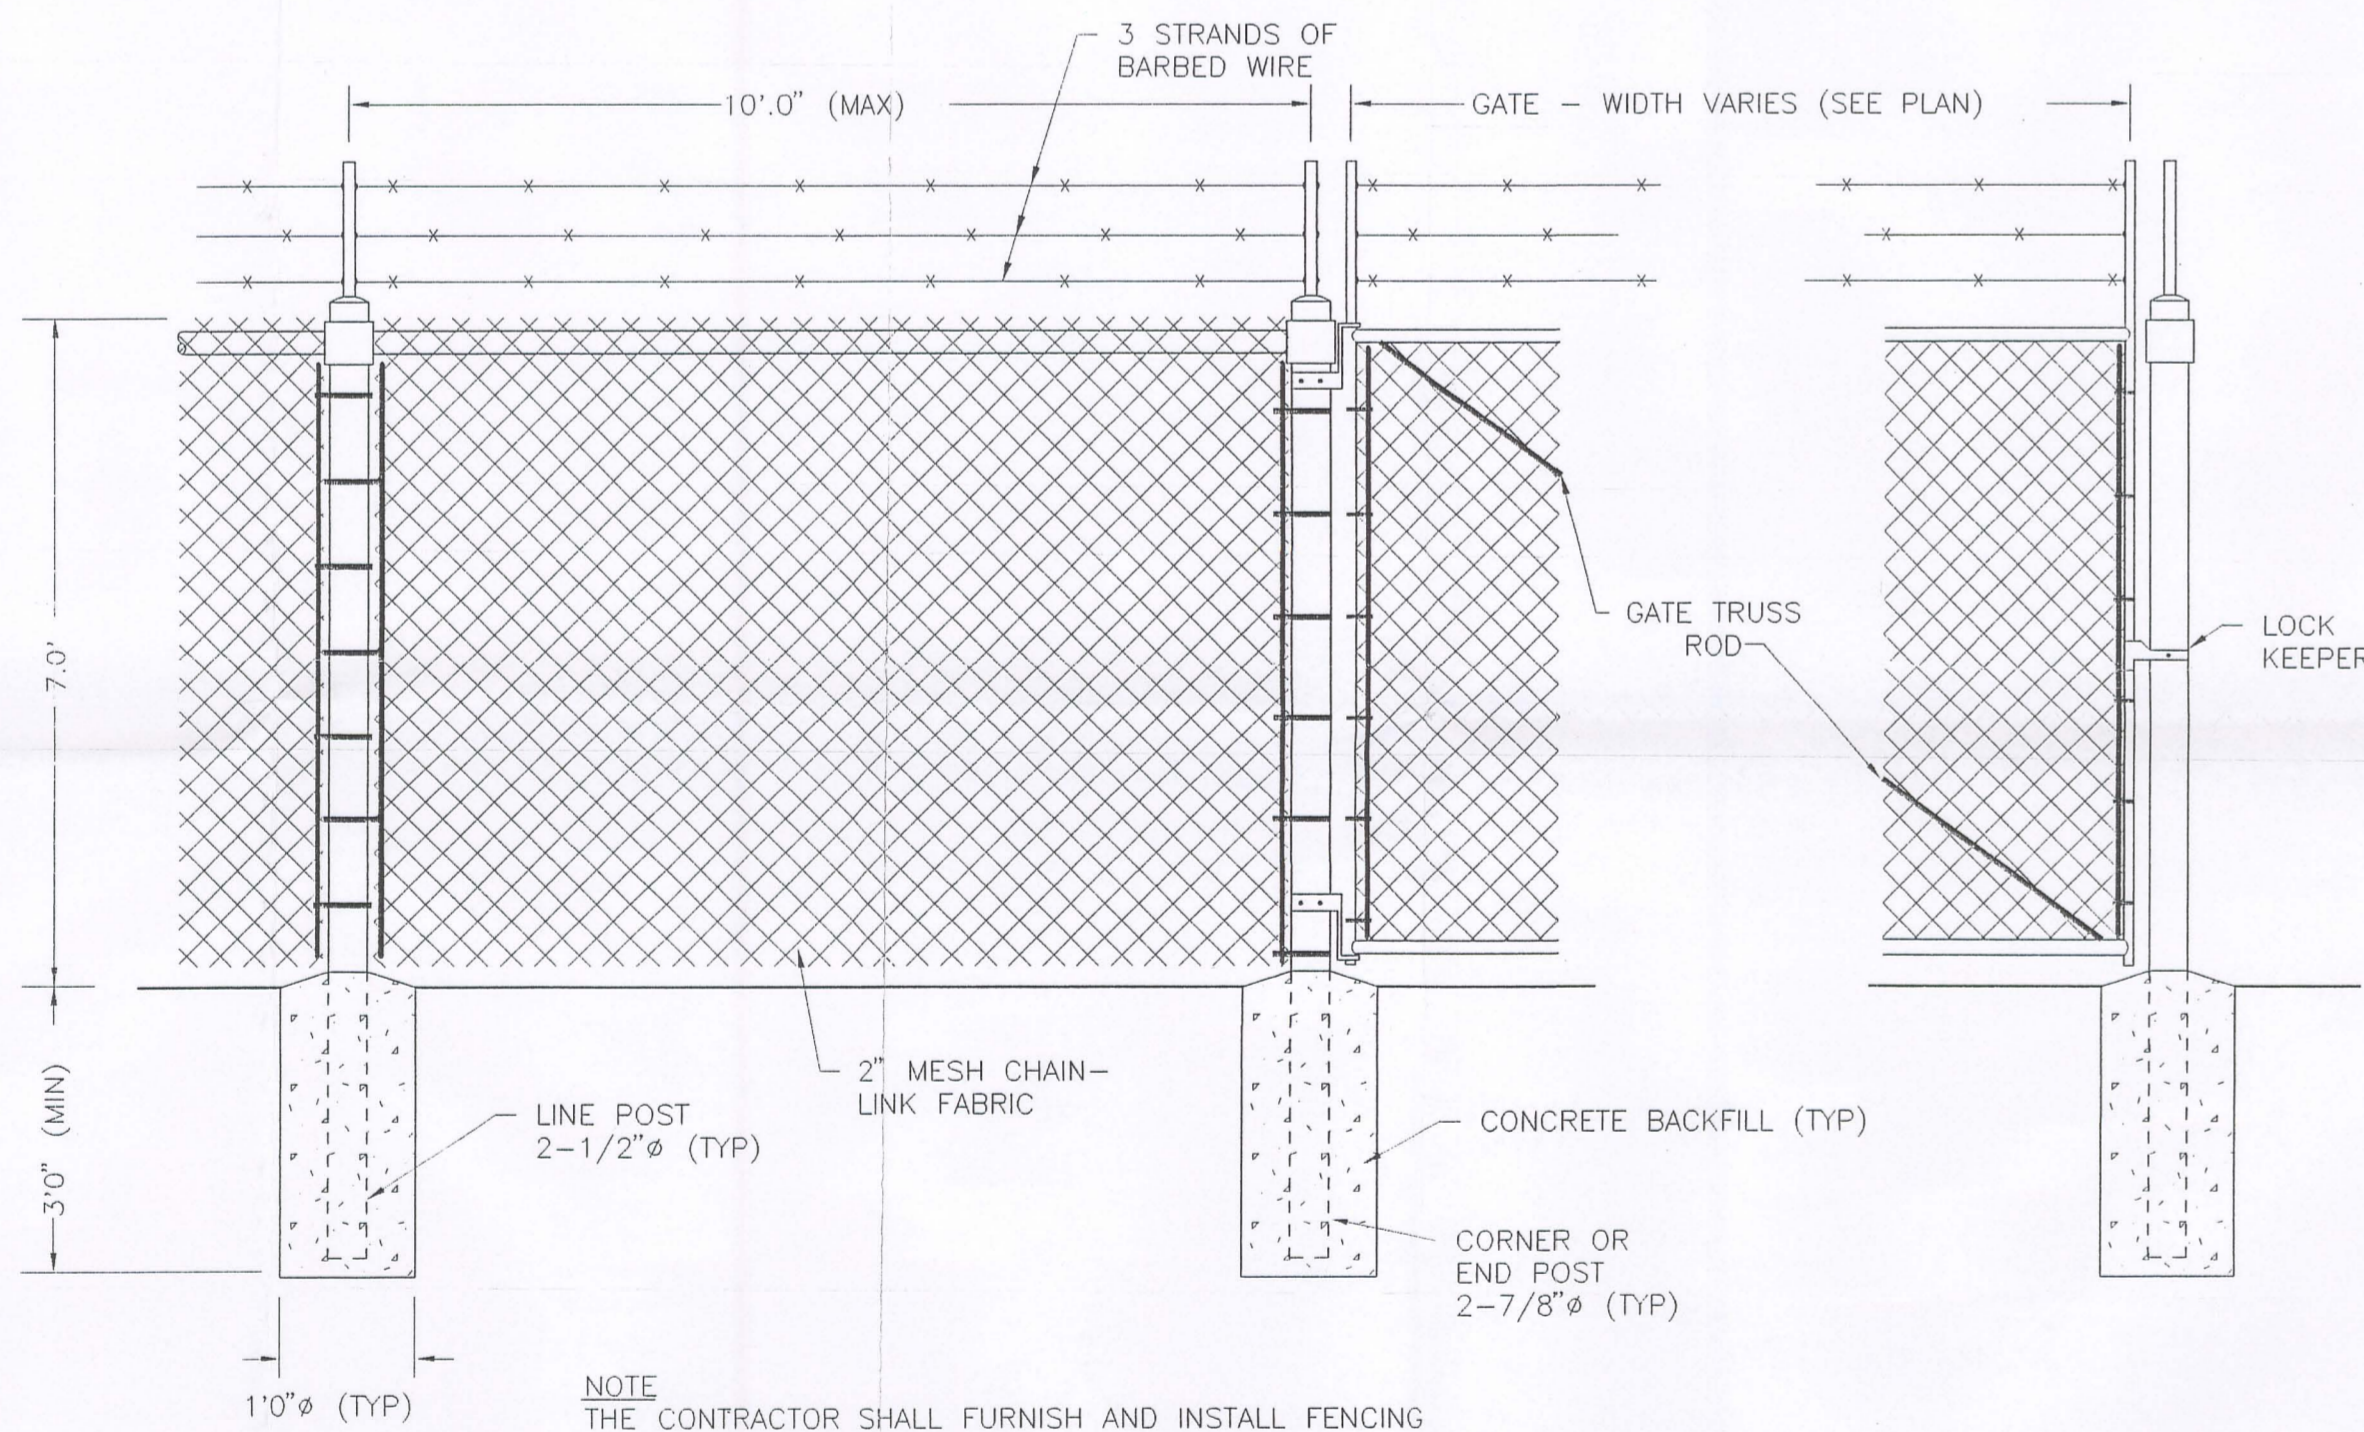


DETAIL CD7-2
TYPICAL SECURITY FENCE INSTALLATION
SCALE 1" = 2'

NOTE
THE CONTRACTOR SHALL FURNISH AND INSTALL FENCING
DEMOLISHED AS PART OF THE WORK.

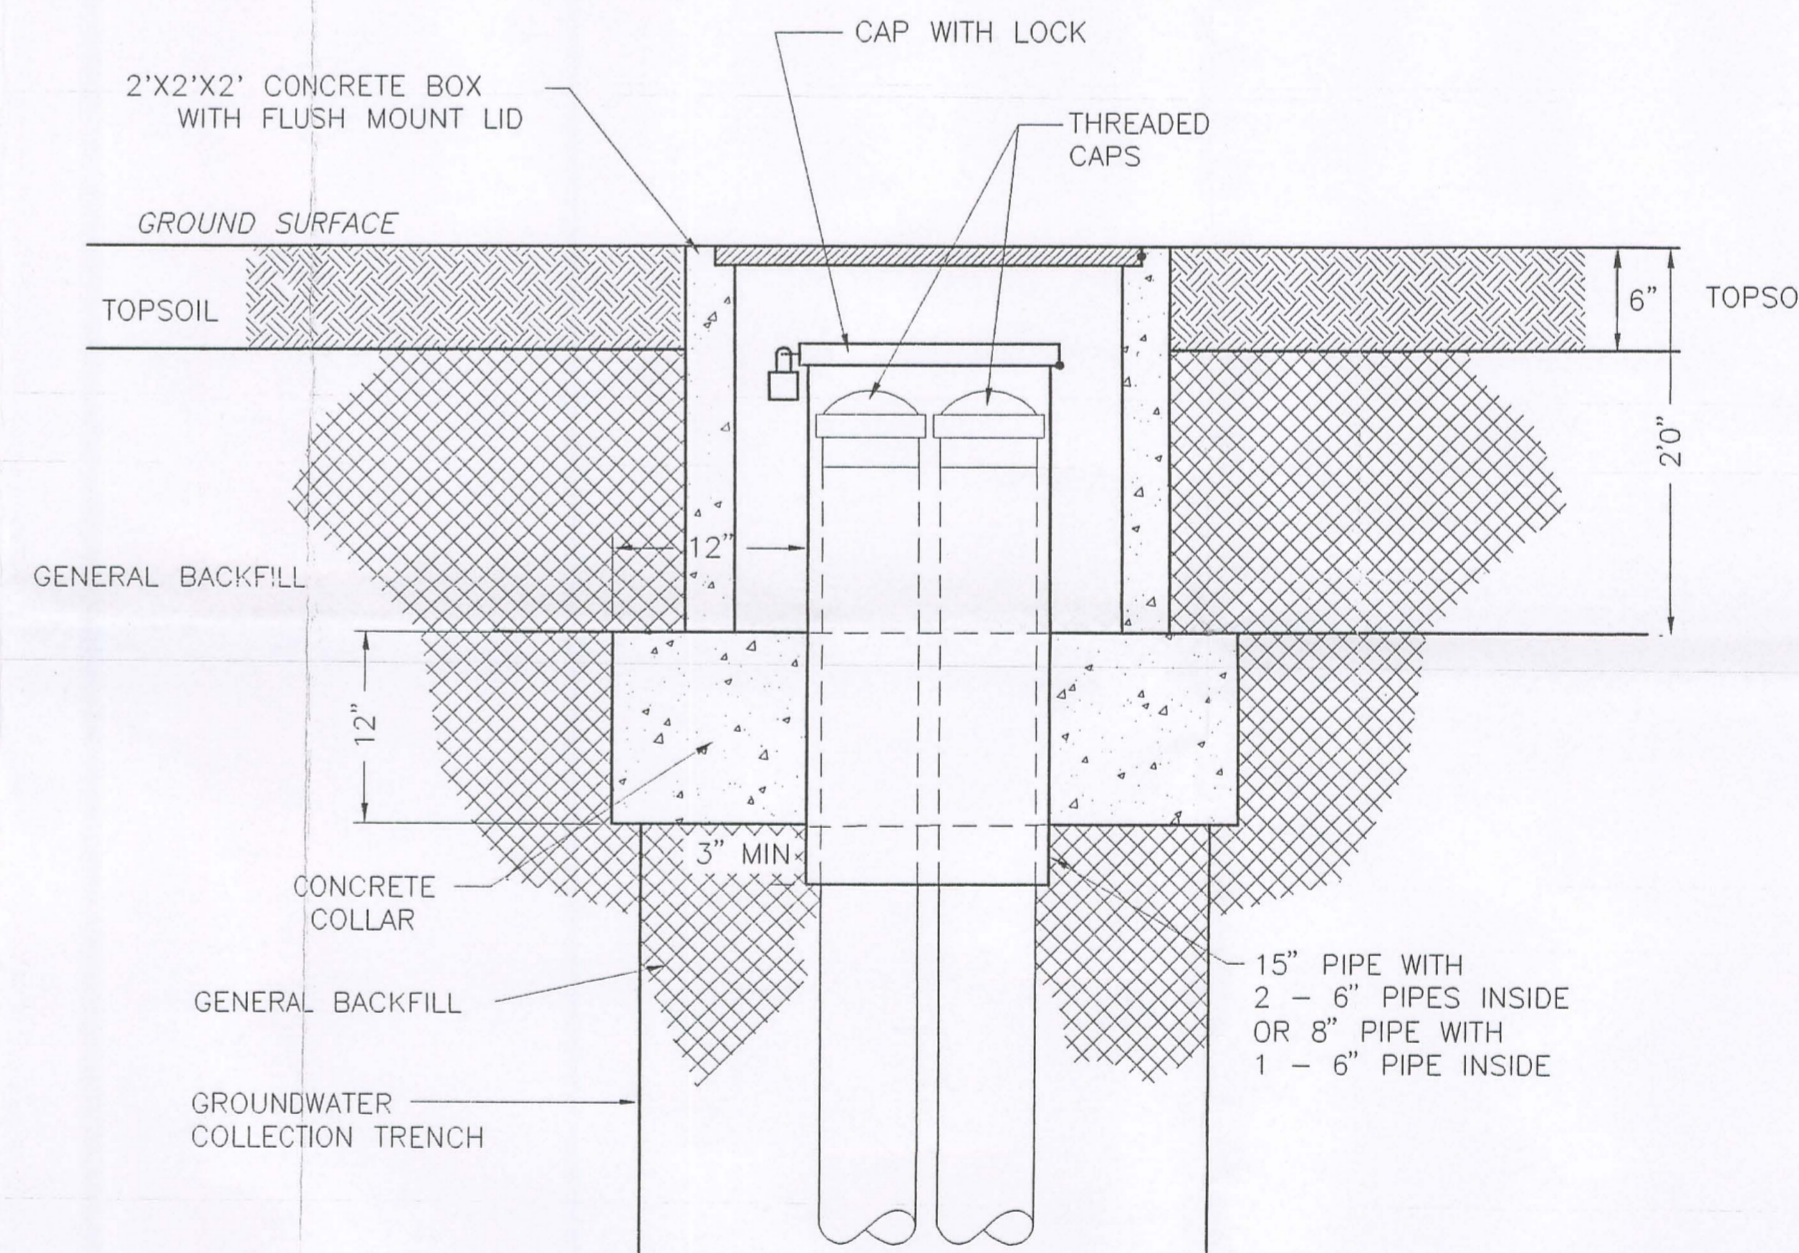

DETAIL CD7-5
COLLECTION CLEANOUT
NOT TO SCALE

NOTE
CENTER SINGLE OR DOUBLE PIPE
ARRANGEMENT AS APPROPRIATE

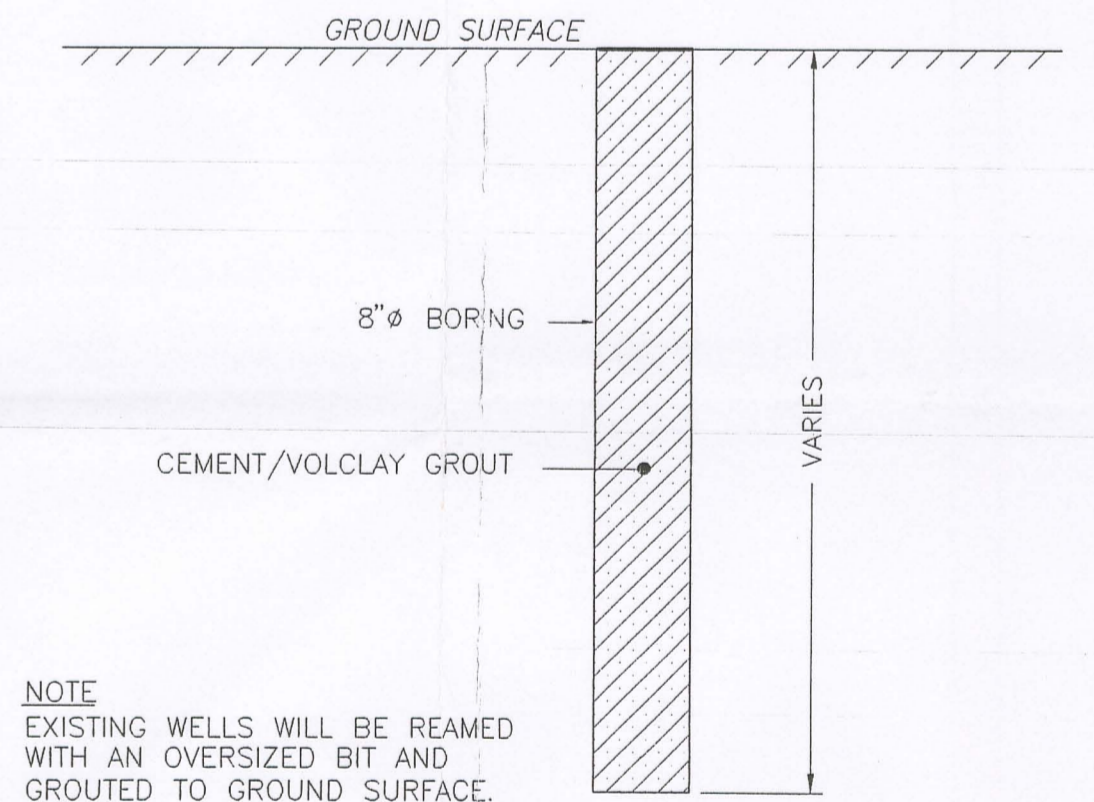

DETAIL CD7-4
TYPICAL DECOMMISSIONED WELL
NOT TO SCALE

NOTE
EXISTING WELLS WILL BE REAMED
WITH AN OVERSIZED BIT AND
GROUTED TO GROUND SURFACE.

REVISION	DATE	DESCRIPTION
11/18/99		AS-BUILT
CD-7		
MISCELLANEOUS DETAILS		
EXCAVATION AND ON-SITE MANAGEMENT OF RADIOLOGICALLY AFFECTED SOILS AND GROUNDWATER COLLECTION TRENCH CONTRACT DRAWING PACKAGE MUSKOGEE, OKLAHOMA		
PREPARED FOR FANSTEEL, INC. MUSKOGEE, OKLAHOMA D-07		
APPROVED	CHECKED	DRAWN
<i>[Signature]</i>	12/15/99	WJA/29/JAN1998
DRAWING NUMBER		
3789505		
Earth Sciences Consultants, Inc.		