



DETAIL CD6-1
PLAN VIEW
SUMP MANHOLE, VALVE AND METER BUILDING
SCALE 1/2" = 1'-0"


- NOTES:
1. ALL SHADED ITEMS ARE TO BE INSTALLED BY OTHERS.
 2. THE CONTRACTOR SHALL COORDINATE WORK WITH WASTEWATER TREATMENT FACILITY CONTRACTOR.

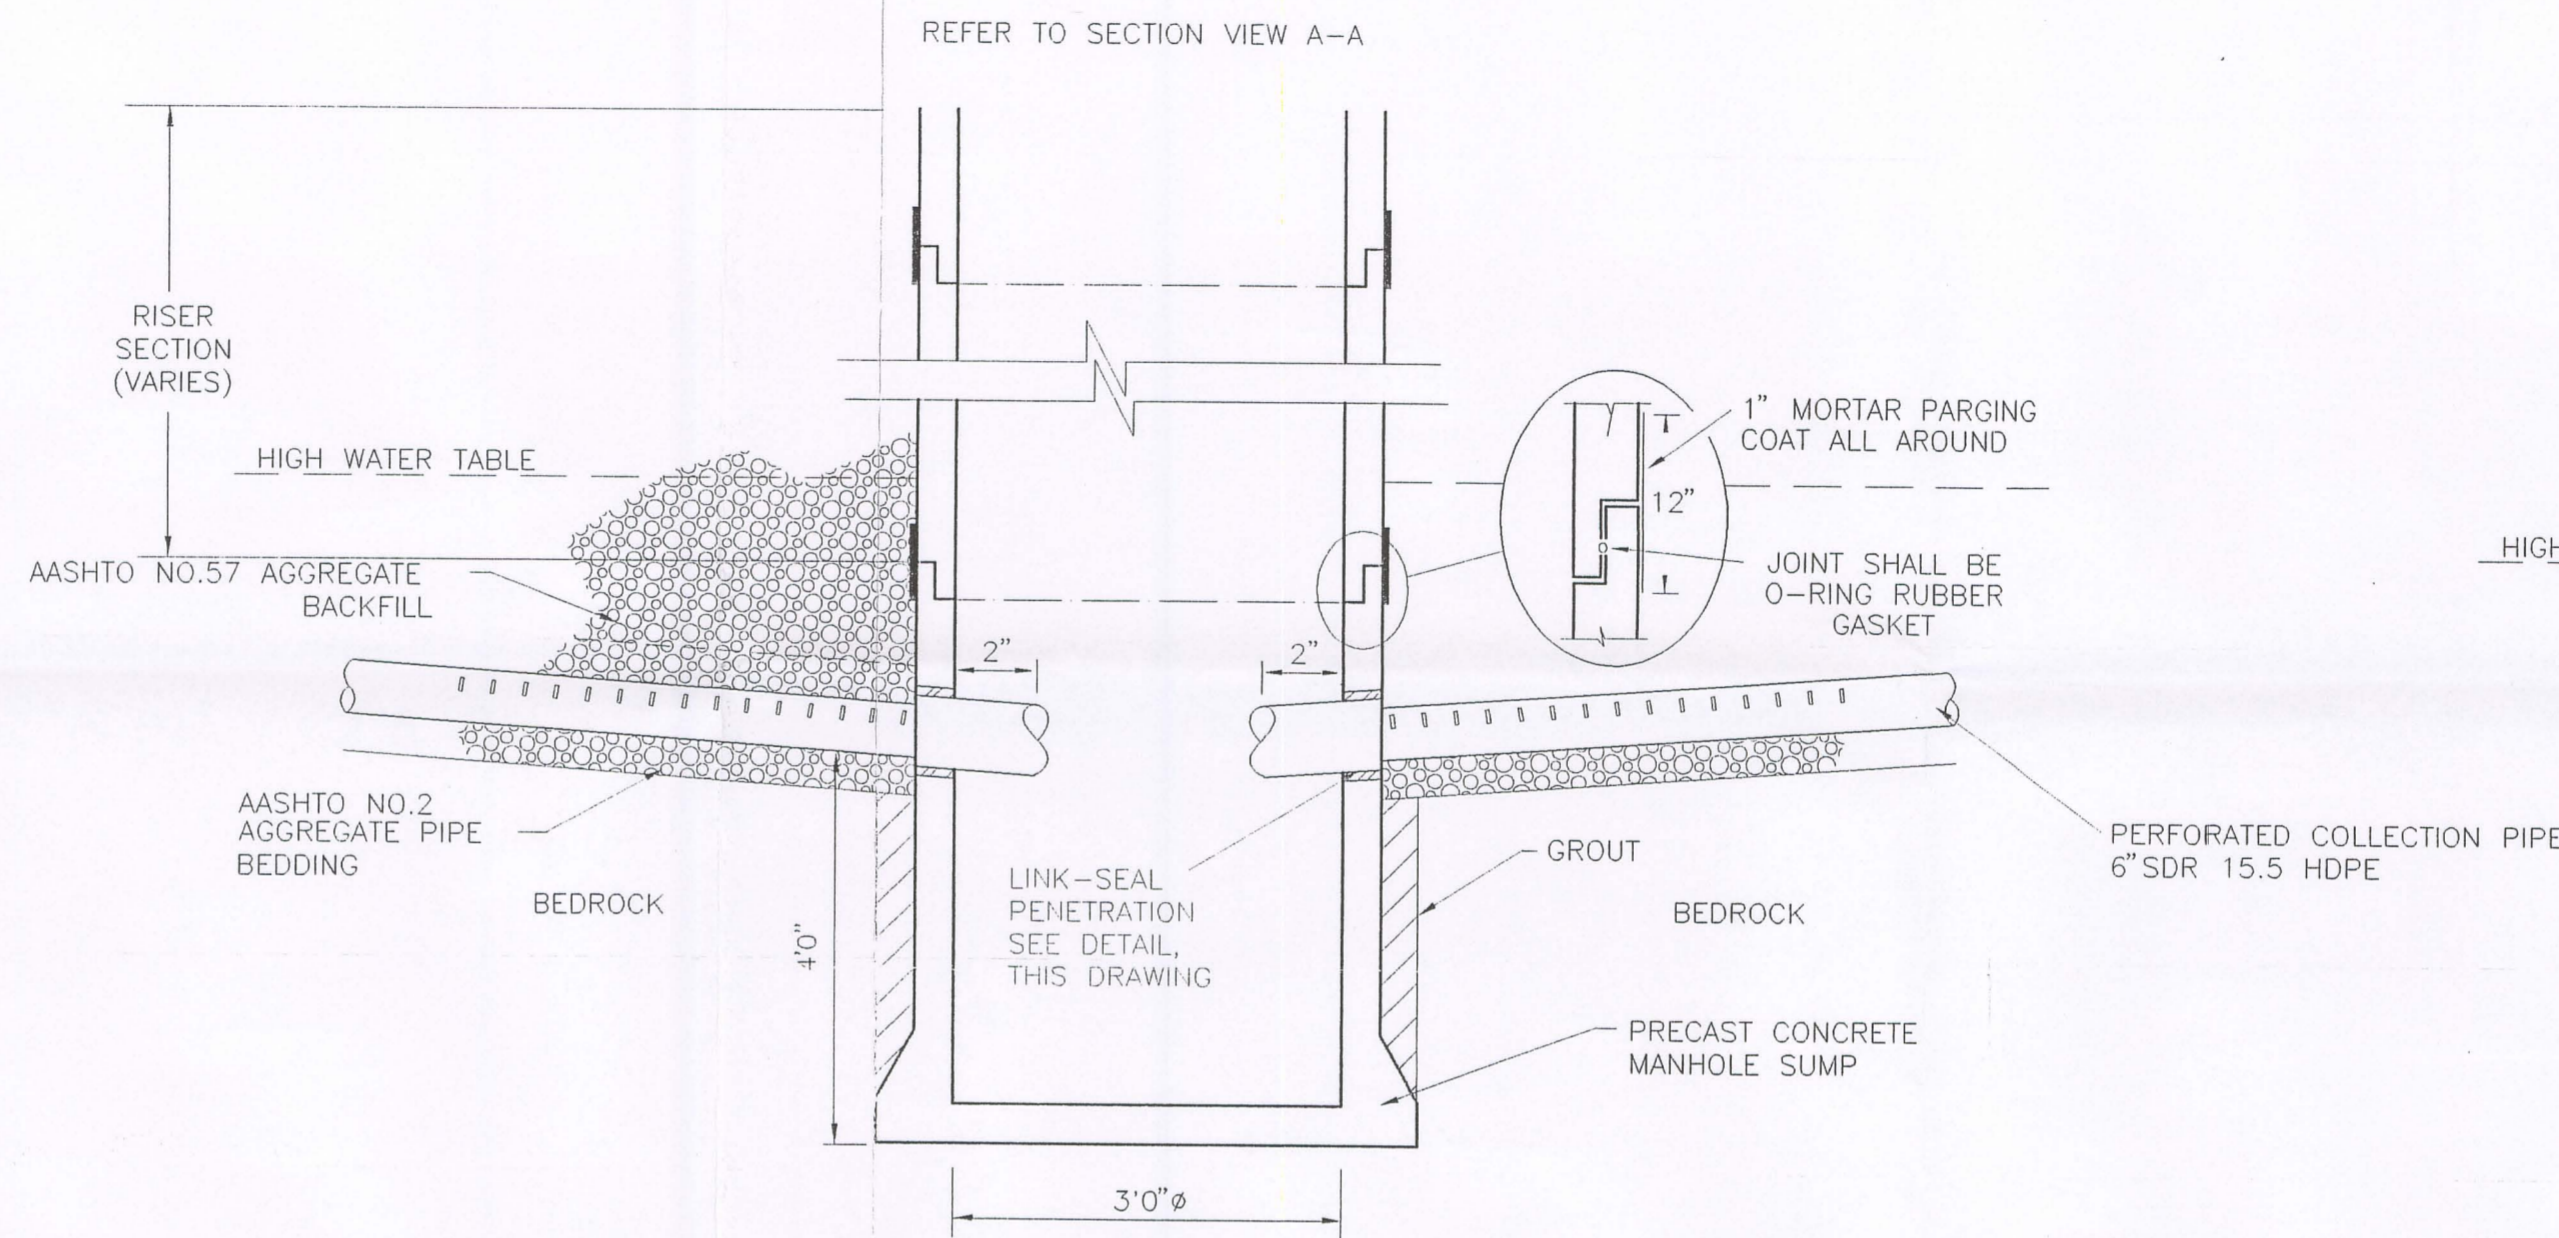


SECTION B
TYPICAL PRECAST CONCRETE MANHOLE SUMP
NOT TO SCALE

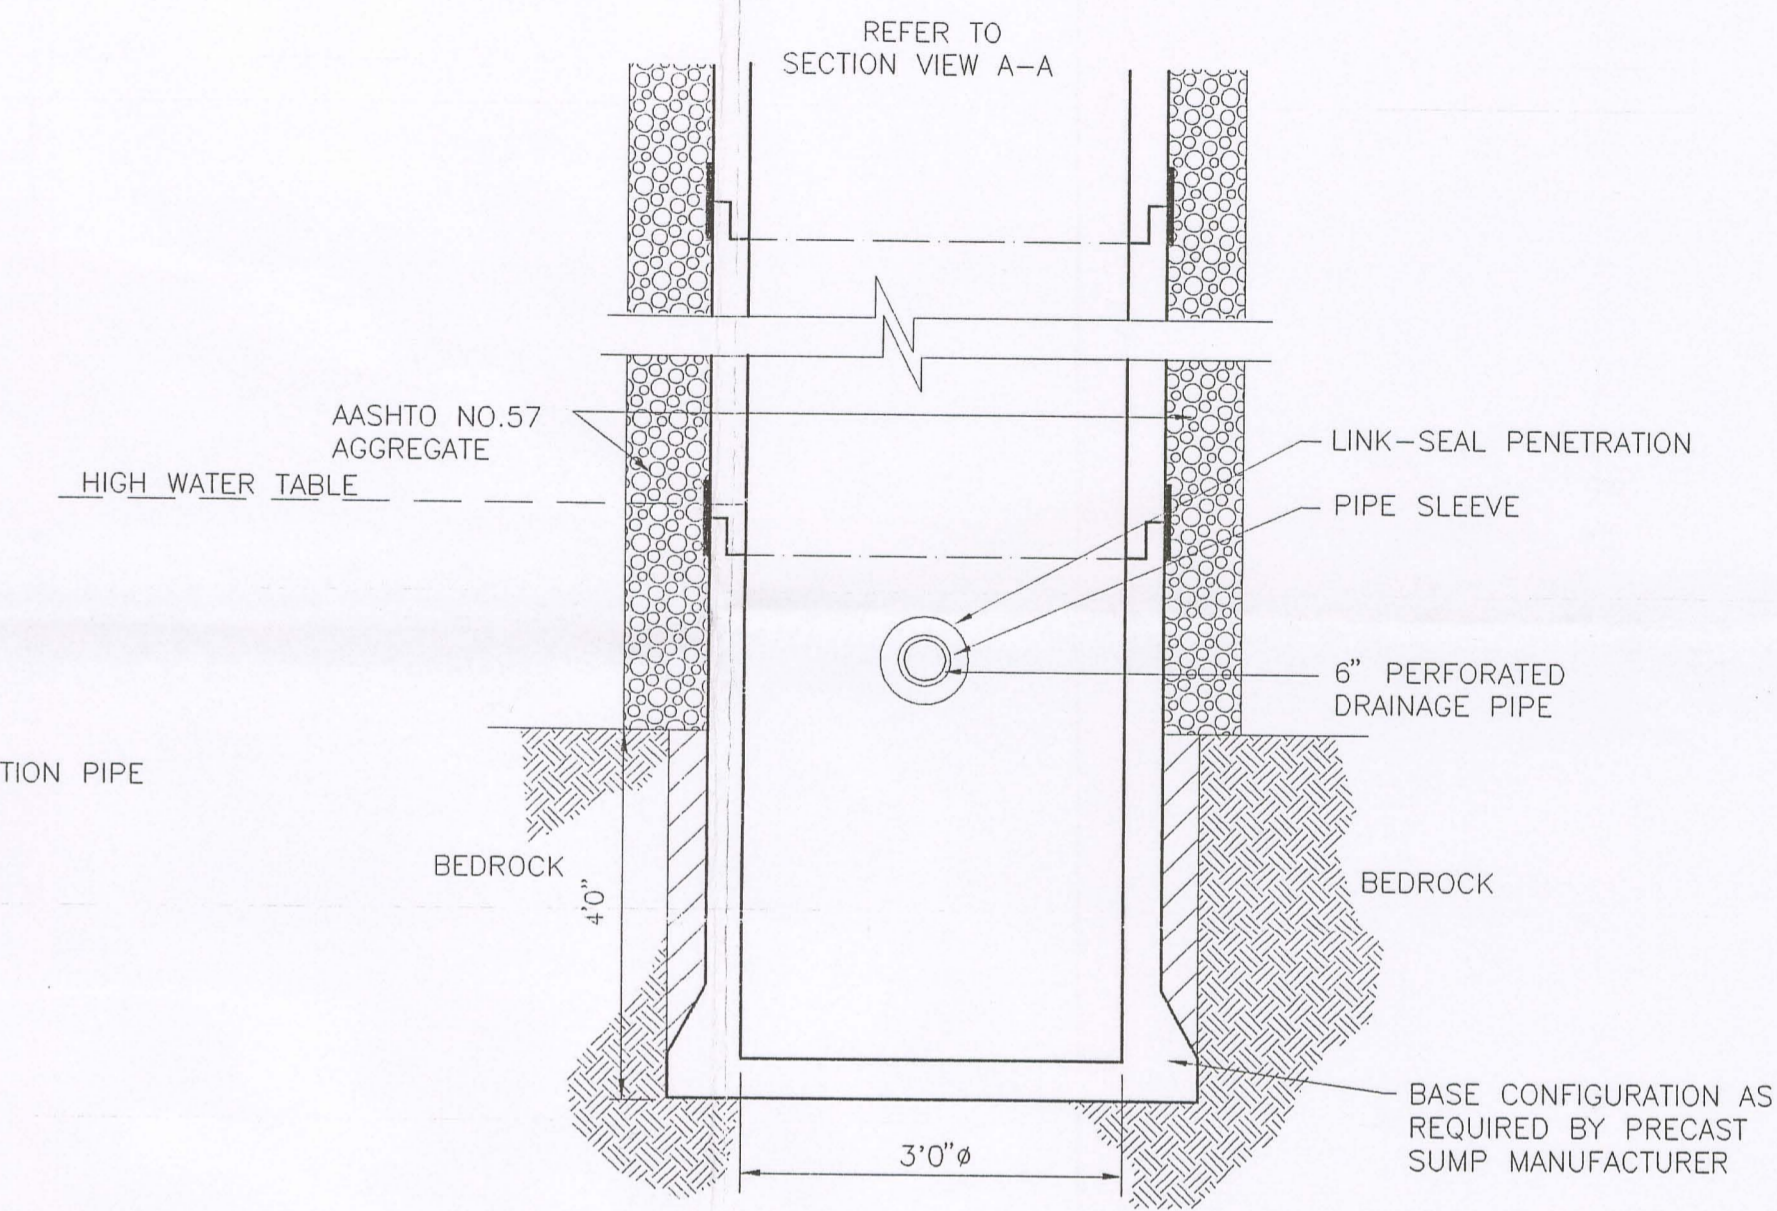


SECTION C
TYPICAL PRECAST CONCRETE MANHOLE SUMP
TRENCH LINE VIEW
NOT TO SCALE

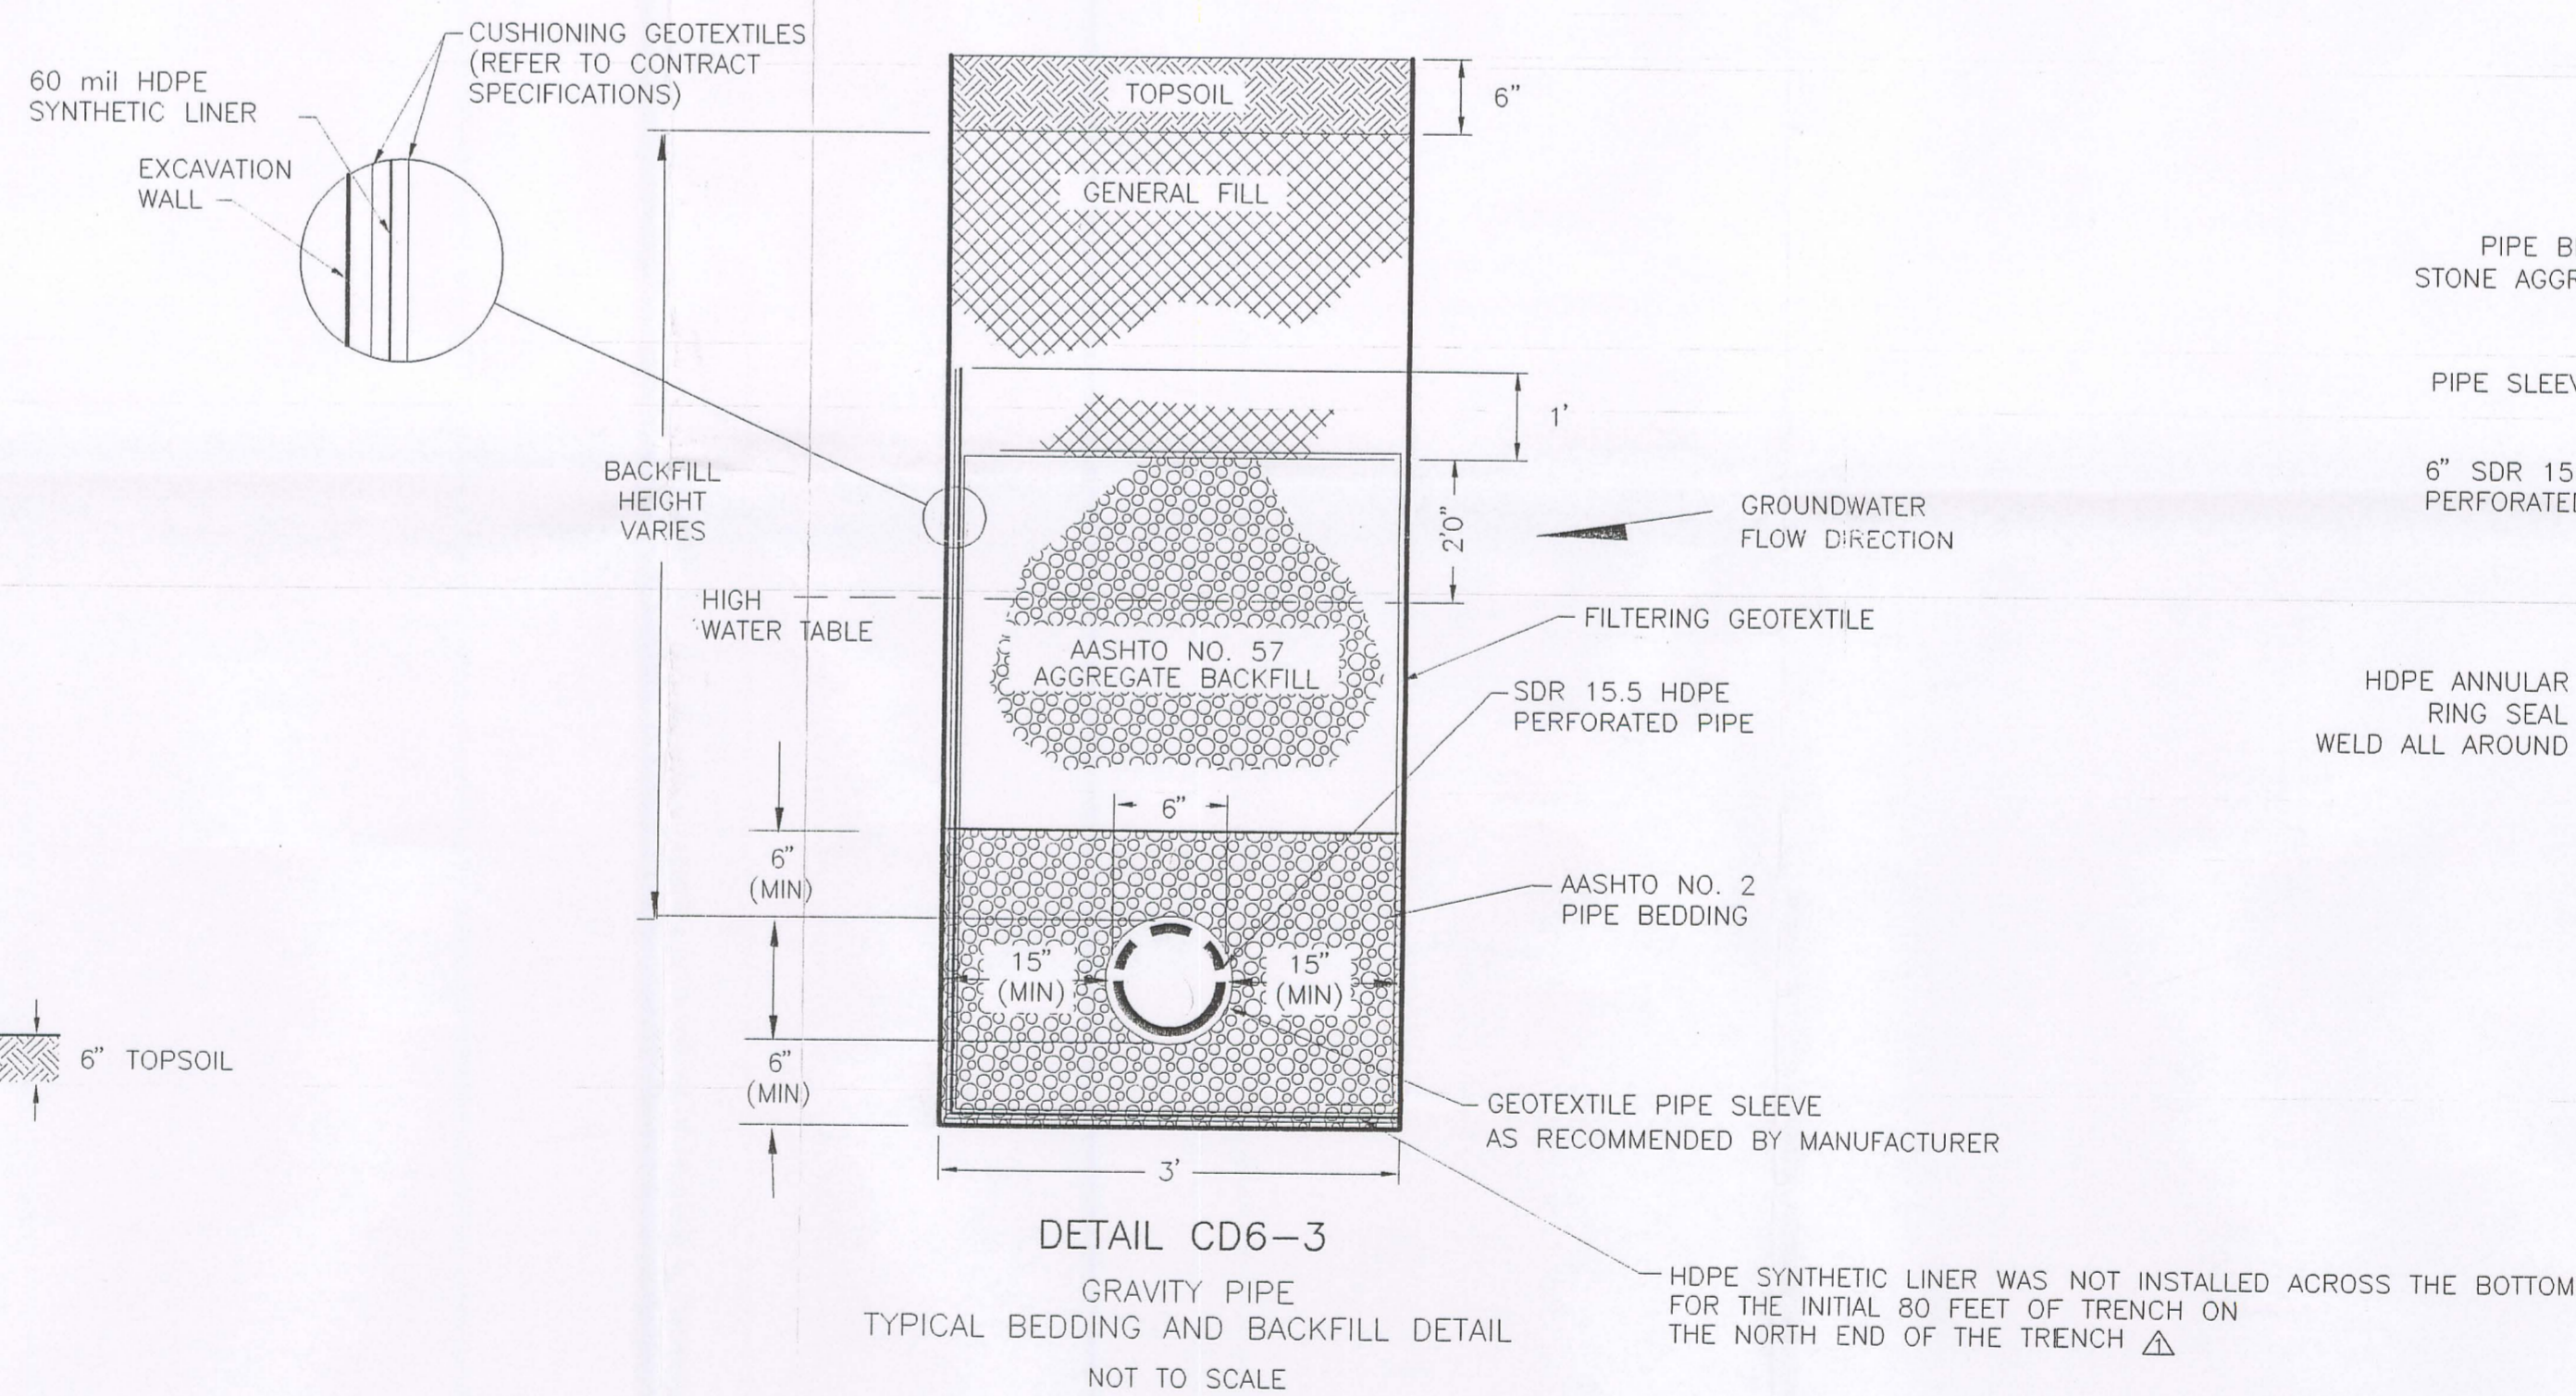

DETAIL CD6-3
GRAVITY PIPE
TYPICAL BEDDING AND BACKFILL DETAIL
NOT TO SCALE

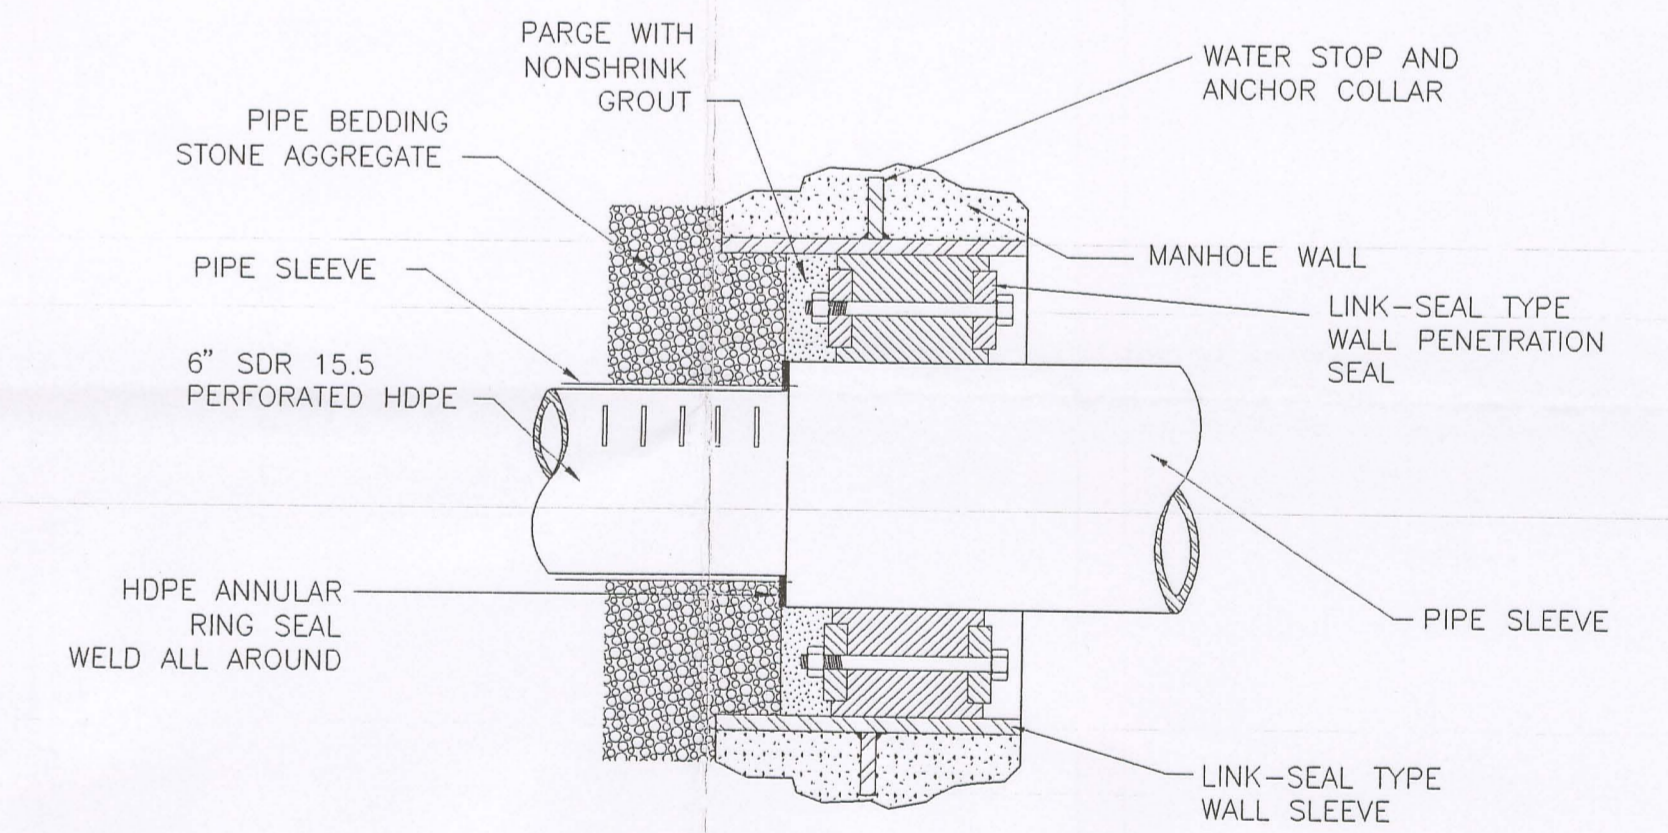

DETAIL CD6-4
TYPICAL LINK-SEAL DETAIL
NOT TO SCALE

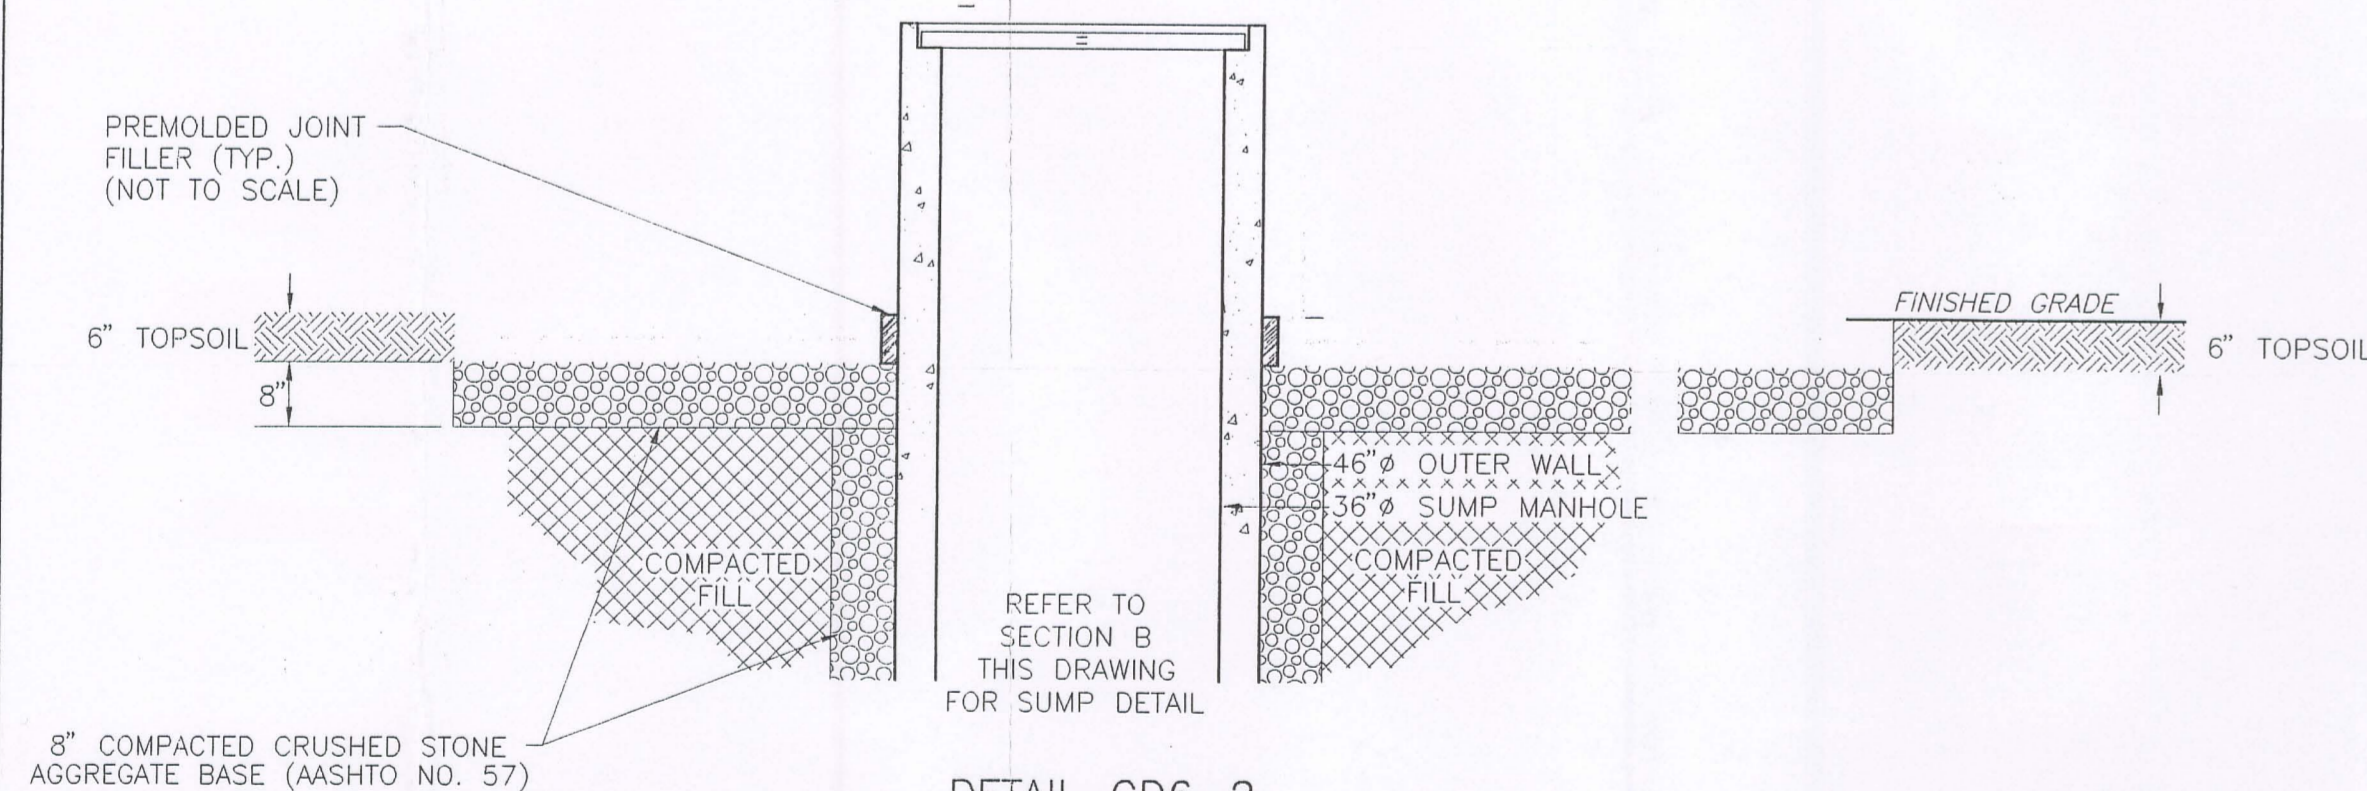

DETAIL CD6-2
SECTION VIEW A-A
MANHOLE, VALVE AND METER BUILDING
SCALE 1/2" = 1'-0"

REVISION	DATE	DESCRIPTION
11/18/99		AS-BUILT
CD-6		
TRENCH DETAILS		
EXCAVATION AND ON-SITE MANAGEMENT OF RADIOLOGICALLY AFFECTED SOILS AND GROUNDWATER COLLECTION TRENCH CONTRACT DRAWING PACKAGE MUSKOGEE, OKLAHOMA		
PREPARED FOR FANSTEEL, INC. MUSKOGEE, OKLAHOMA D-06		
APPROVED	W.A. 12/15/99	
CHECKED	W.A. 12/15/99	
DRAWN	W.A. 12/15/99	
DRAWING NUMBER		
3789506		Earth Sciences Consultants, Inc.