




DETAIL CD8-4
AAL STOCKPILE CAP AND ANCHOR SYSTEM
NOT TO SCALE

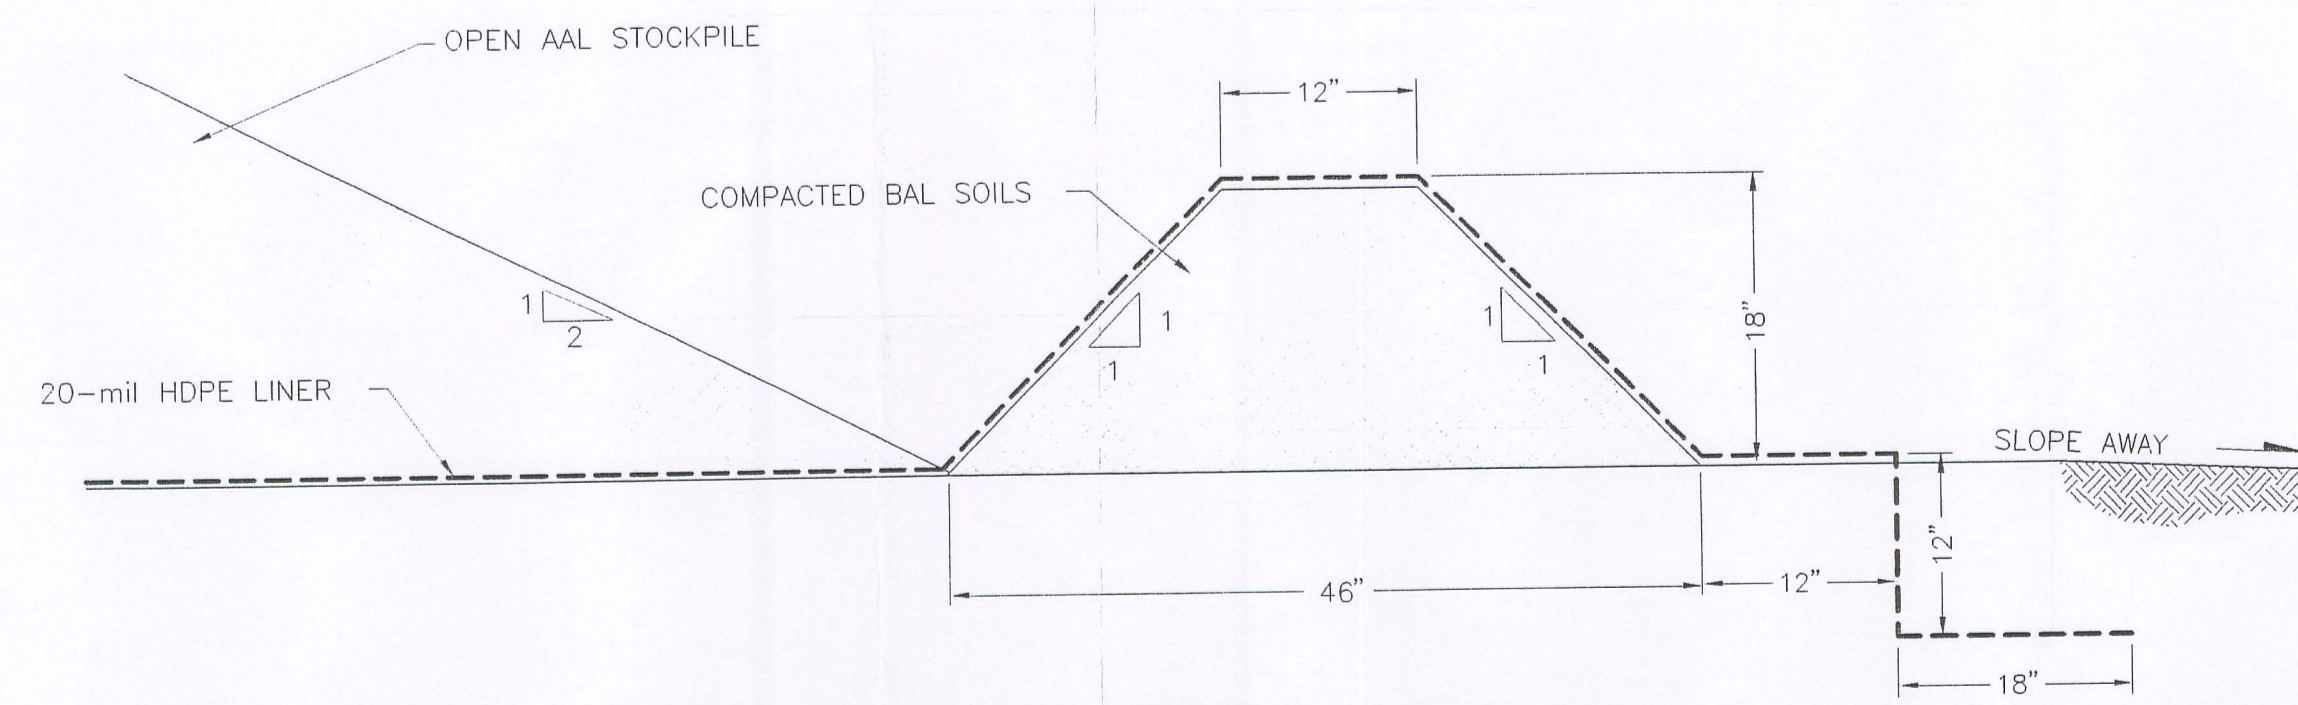

DETAIL CD8-2
AAL STOCKPILE BERM AND ANCHOR SYSTEM
NOT TO SCALE

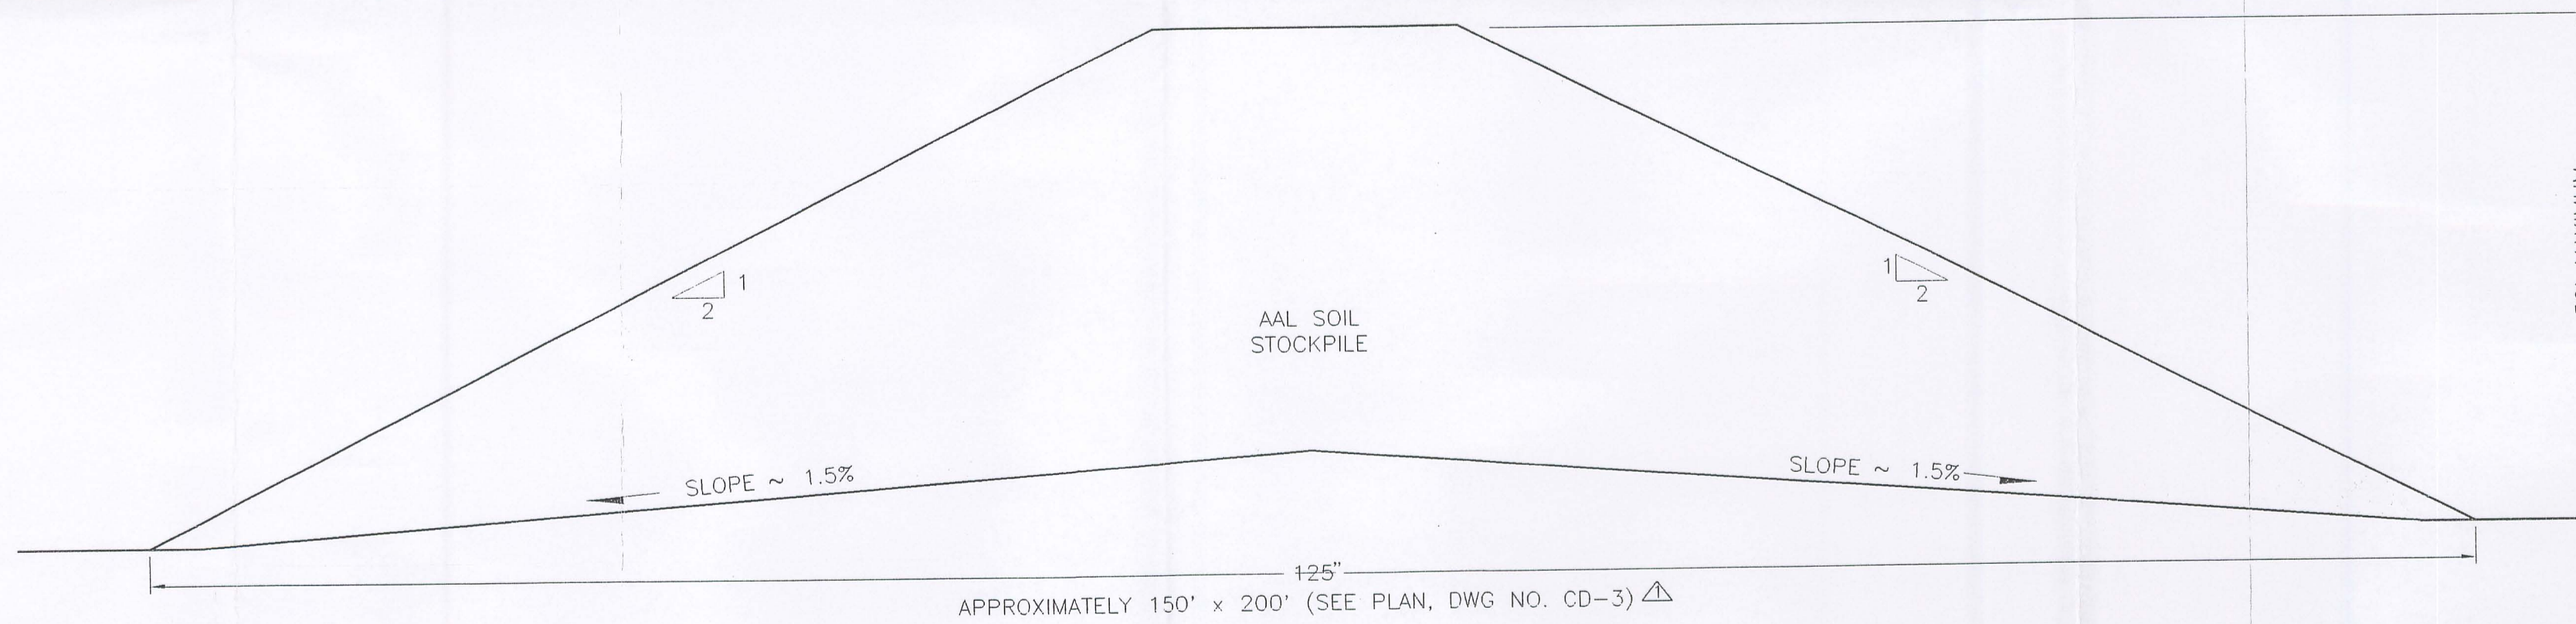

DETAIL CD8-3
AAL STOCKPILE CROSS-SECTION
NOT TO SCALE

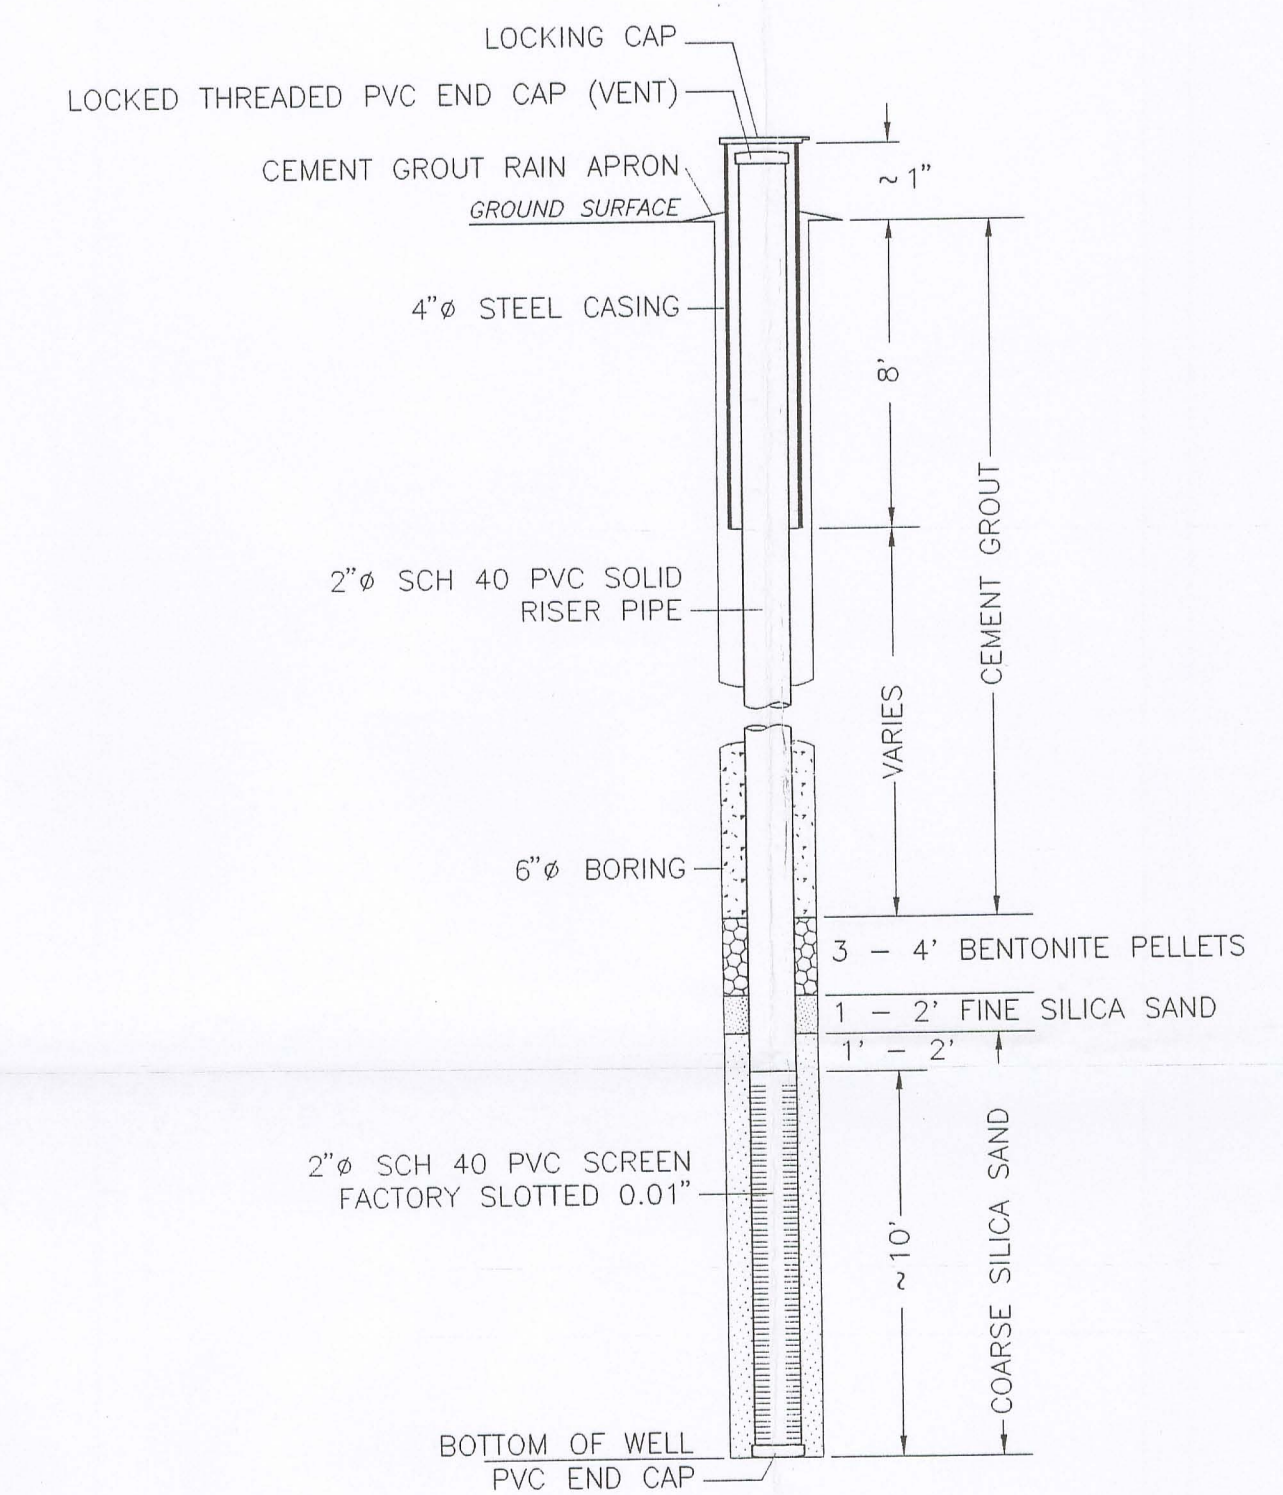

DETAIL CD8-1
TYPICAL PIEZOMETER INSTALLATION
NOT TO SCALE

REVISION	DATE	DESCRIPTION
△	11/18/99	AS-BUILT
CD-8		
MISCELLANEOUS DETAILS		
EXCAVATION AND ON-SITE MANAGEMENT OF RADIOLOGICALLY AFFECTED SOILS AND GROUNDWATER COLLECTION TRENCH CONTRACT DRAWING PACKAGE MUSKOGEE, OKLAHOMA		
PREPARED FOR FANSTEEL, INC. MUSKOGEE, OKLAHOMA D-08		
APPROVED	DATE	
CHECKED	DATE	
DRAWN	DATE	
DRAWING NUMBER		
3789513		
Earth Sciences Consultants, Inc.		