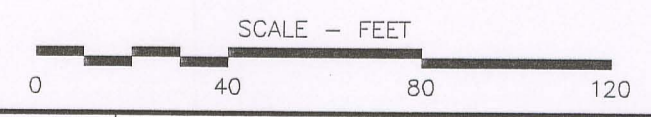


W.E.
512.3

W.E.
534.9



**TABLE 1
EXCAVATED SOIL QUANTITIES**

AREA	QUANTITIES
V-a	1185 TONS
V-b	1055 TONS
VIII-a	2551 TONS
VIII-b	1984 TONS
TOTAL	6775 TONS

NOTES:
 1. THIS DRAWING SHOWS APPROXIMATE LOCATIONS OF ABOVE ACTION LEVEL SOIL EXCAVATIONS.
 2. SOIL QUANTITIES REMOVED ARE PRESENTED IN TABLE 1.
 3. THIS DRAWING ALSO SHOWS THE APPROXIMATE LOCATION OF CONFIRMATION SAMPLING POINTS. TEST RESULTS ARE INCLUDED IN APPENDIX A OF THE CONSTRUCTION CERTIFICATION REPORT.

- LEGEND**
- VIIIa-01 ● CONFIRMATION SAMPLE LOCATION
 - ⊙ PIEZOMETER
 - ⊙ PIEZOMETER
 - ⊙ SUMP
 - GROUNDWATER COLLECTION TRENCH
 - - - PROPERTY LINE
 - ▨ APPROXIMATE LIMIT OF ABOVE ACTION LEVEL SOILS (REMOVED)

REFERENCES

1. SURFACE TOPOGRAPHY WAS DIGITIZED FROM A TOPOGRAPHIC MAP PREPARED BY GENE F. MOODY & ASSOCIATES, INC. TULSA, OKLAHOMA, DATED MAY 13, 1999.

REVISION	DATE	DESCRIPTION
		CD-9

**EXCAVATION DETAILS AND CONFIRMATION SAMPLING
EXCAVATION AND ON-SITE MANAGEMENT OF
RADIOLOGICALLY AFFECTED SOILS AND
GROUNDWATER COLLECTION TRENCH
AS-BUILT DRAWING PACKAGE
MUSKOGEE, OKLAHOMA**

PREPARED FOR
**FANSTEEL, INC.
MUSKOGEE, OKLAHOMA, D-09**

APPROVED <i>[Signature]</i>
CHECKED <i>[Signature]</i> 12/15/99
DRAWN <i>[Signature]</i> 12/15/99
DRAWING NUMBER

3789509A

Earth Sciences Consultants, Inc.