



CHANDRA K. SACHETI, M.D., LLC  
561 TALCOTTVILLE ROAD  
VERNON, CONNECTICUT 06066  
TELEPHONE: (860) 871-2018

CHANDRA K. SACHETI, M.D., F.A.C.C.  
DUSHYANT N. GANDHI, M.D., F.A.C.C.  
KARI J. DANIELS, PA-C

*Br L*

Chandra K. Sacheti, MD LLC  
561 Talcottville Rd.  
Vernon, CT., 06066

*06-30781-01*  
*03036145*

06 – Jan – 10

U.S. NRC Region I  
475 Allendale Rd.  
King of Prussia, PA 19406

To Whom It May Concern:

Please note, we are requesting a change in areas of use of radioactive material under our byproduct material license #06-30781-01. Attached is a copy of our new floor plan, which indicates a change of location of the nuclear lab and a change in location of the stress lab as well. Both labs will be within the existing building on the same floor.

All ALARA tools presently being used will be used in the same fashion in the new location, ie L – Block, lead shielding etc.

Additionally we have enclosed a copy of the new floor plan, which is up for your approval.


We will continue to survey and wipe each and all of these areas in accordance with our license, and provide a close – out survey and wipe of old locations.

Please do not hesitate to contact us with any questions or concerns.

Sincerely,

*Chandra K. Sacheti*  
Chandra K. Sacheti, MD

*144359*

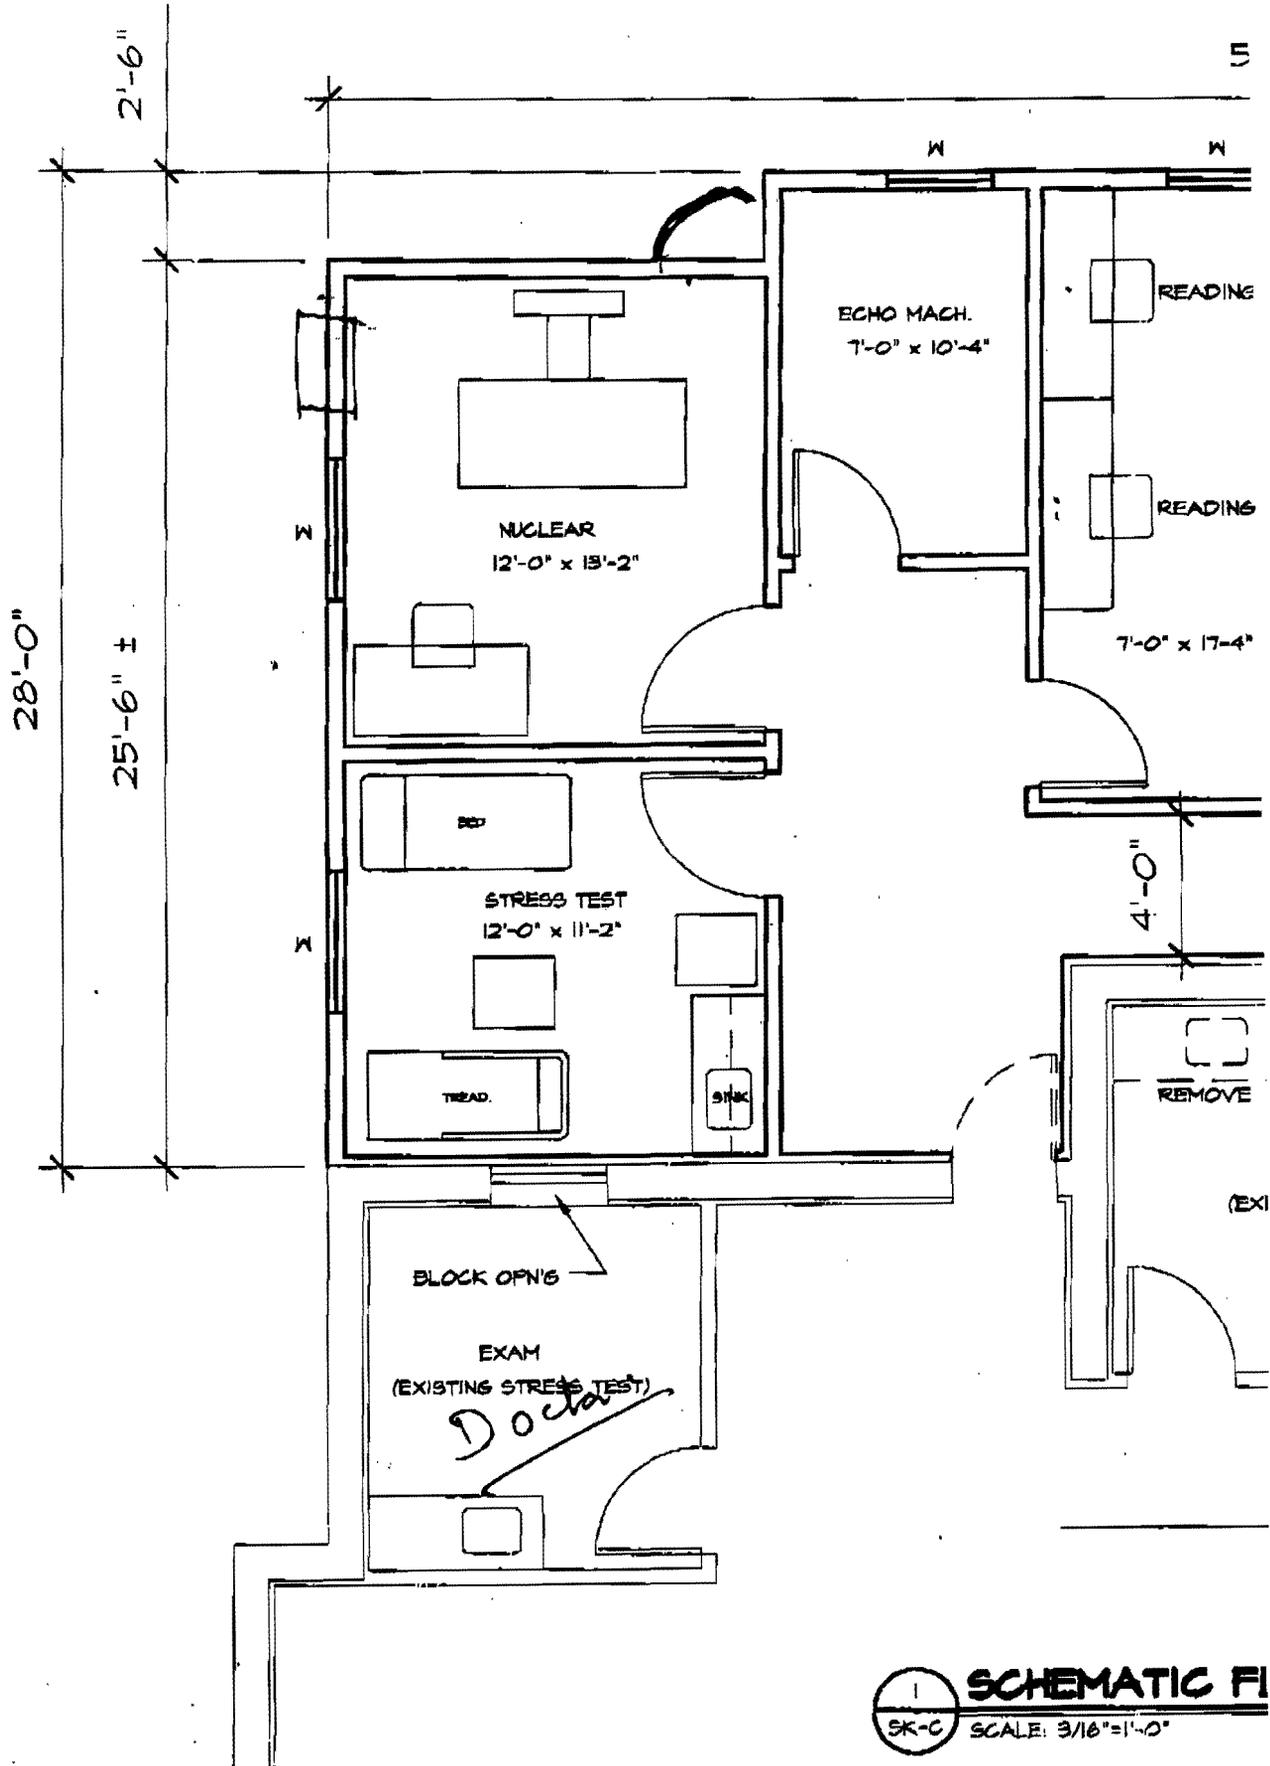

**1** **SCHEMATIC FI**  
 SK-C SCALE: 3/16"=1'-0"

This is to acknowledge the receipt of your letter/application dated

1/6/2010, and to inform you that the initial processing which includes an administrative review has been performed.

AMEND. 06-30781-01  
There were no administrative omissions. Your application was assigned to a technical reviewer. Please note that the technical review may identify additional omissions or require additional information.

Please provide to this office within 30 days of your receipt of this card

---

A copy of your action has been forwarded to our License Fee & Accounts Receivable Branch, who will contact you separately if there is a fee issue involved.

Your action has been assigned **Mail Control Number** 144359.  
When calling to inquire about this action, please refer to this control number.  
You may call us on (610) 337-5398, or 337-5260.