

PROP

Team
Environmental
Services, Inc.

Engineering Change Order

ENGINEERING
 P.O. BOX 123
 ALVIN, TEXAS 77511

Letter: C

ECO# <u>7228</u>	DWG.#/ITEM# <u>74298</u>
Requested by: <u>ERIC</u>	CSC#: <u>P37</u> JOB #: <u>079832N</u>
Department: <u>CSC 37</u> Date: <u>8/2/98</u>	Date Effective: <input checked="" type="checkbox"/> Immediate <input type="checkbox"/> Phase In <input type="checkbox"/> Record Only
Request Approved by: <u>CL</u>	Changed By: <u>CYL</u>
Date: <u>8/2/98</u>	Date: <u>8/2/98</u>

- Description:
1. CHANGE SIZE & NUMBER OF SET SCREWS ON DWG SHT 1 OF 3 (NO SET SCREWS)
 2. VOID DWG SHT 1a OF 3
 3. VOID DWG SHT 1b OF 3
 4. VOID MATERIAL FOR SET SCREWS
 5. NOTE TO MILL SPLIT LINE
 6. VOID MAX INJ. PRESSURE NOTE & ADD "DO NOT INJECT"
 7. CHANGE THRUST CALC. (CALL SHT 7 OF 9)
 8. ADD MTR TO ALL MATERIAL
 9. ADD CALC SHT 7a-7c OF 9
 10. ADD TORQUE VALVE

Reason For Change: EASE OF MFG
PLANT REQUEST

Effect On Structural

Integrity Of Clamp: SHOWN IN CALC
9811130204 981009
PDR ADOCK 05000247
P PDR

Checked By: CL

Date: 8/2/98

Approved By: CL

Date: 8/2/98

Items Affected

Raw Materials	Scrap <input type="checkbox"/>	Change <input type="checkbox"/>	Use <input type="checkbox"/>
Parts In Stock	Scrap <input type="checkbox"/>	Change <input type="checkbox"/>	Use <input type="checkbox"/>
Parts in Process	Scrap <input type="checkbox"/>	Change <input type="checkbox"/>	Use <input type="checkbox"/>
Vendor	Scrap <input type="checkbox"/>	Change <input type="checkbox"/>	Use <input type="checkbox"/>

Copies To:

Manufacturing Department

Q.A.

Purchasing

Environmental Services, Inc.

Engineering Change Order Request

ENGINEERING
BOX 123
ALVIN, TEXAS 77511

Requested By: ERIC	DWG.#/ITEM# 70298
Department: CSC 27	CSC#: P37 JOB #: 075324
Request Received By: CXL	Date Effective: <input checked="" type="checkbox"/> Immediate <input type="checkbox"/> Phase In <input type="checkbox"/> Record Only
Date: 8/2/98	

Description of Change: ~~CHANGE SIZE & # OF SET SCREWS~~
 DUE TO NOT INJECTING ENCLOSURE
 VOID SET SCREWS
 MOD CLAMP TO ACT AS CRUNCHRING.



Reason For Change: GAGE OF MFG, PLANT REQUEST

ALL DIMENSIONS TYPICAL UNLESS OTHERWISE NOTED

ECO# 7228
C 8/2/98

ECO# 7224
A 7/31/98

(A2) PMI required for all materials

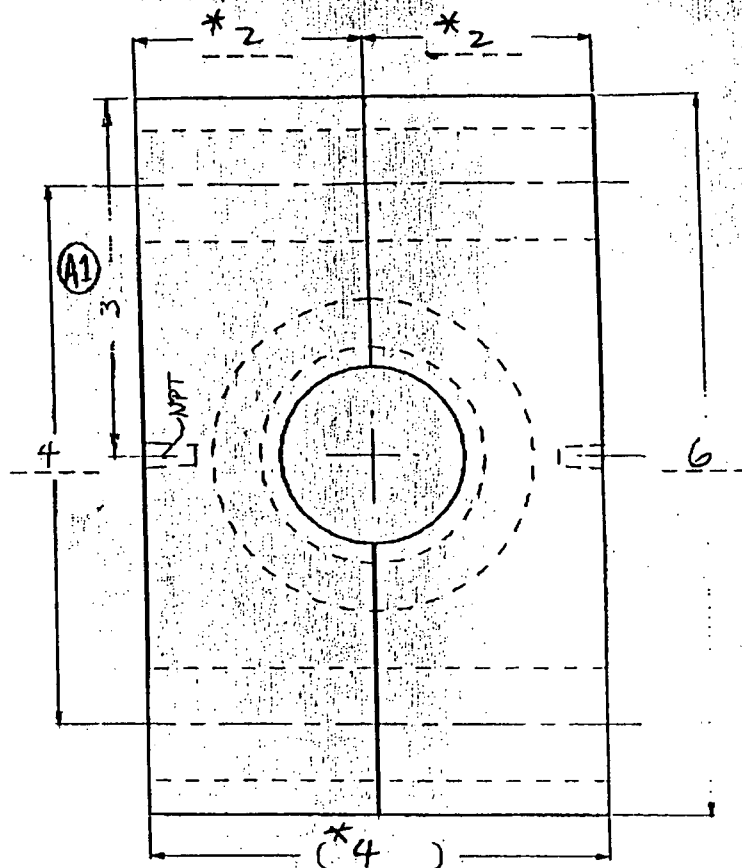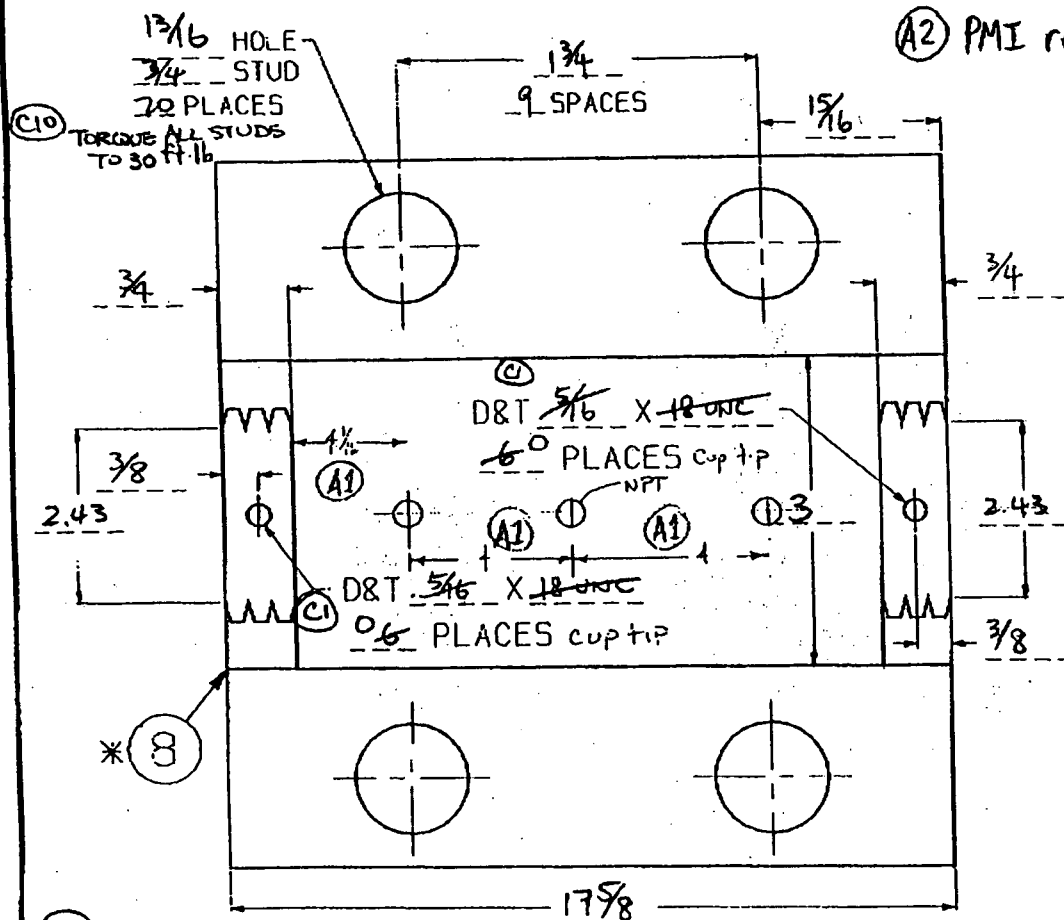

(C6) DO NOT INJECT
~~LIMIT MAX INJ. PRESSURE TO 1100 PSI STATIC~~

(C5) MIN 1/16" FROM
SPLIT LINE (EACH HALF)

"CONFIDENTIAL"

* DIMS BEFORE MILL PROPRIETARY INFORMATION

NUCLEAR
DO NOT PAINT

* WELDED ENOPLATES OPTIONAL

0.110 CRUNCH

D&T C - 1/8 NPT (CAVITY)

 ALVIN, TEXAS	JOB NO. P37-079832N	MATERIAL SEE MS SHEET	WEIGHT 112.4lb	VOID 68.5in ³ BC
	CLAMP NO. 74298	UNLESS NOTED OTHERWISE	CON-ED IPZ	
	EST. NO.	MACHINED SURFACES Break Sharp Corners		
	WELDING SPEC. NO. SEE WELD MAP	TOLEANCES: 3 Place Decimal : .005 2 Place Decimal : .01 1 Place Decimal : .1 ANGLES : 1/32 FRACTIONS : 1/32 ALL DIMENSIONS IN INCHES UNLESS NOTED OTHERWISE		
DRAWN BY CXL	7/30/98	DWG. NO. sb_cr_2w_ss2	SCALE NTS	REV 1 of 3
CHECKED JBA	7/31/98			
APPROVED				



MATERIAL SPECIFICATIONS

REVISED
C 8/2/98

NON-CRITICAL/NUCLEAR
 CRITICAL/NUCLEAR

SHT. 3 OF 3

DRAWN BY: CAL 7/30/98 CSC NO. P37 JOB NO. 079832W

CHECKED BY: CJM 7/31/98 ITEM NO. 74298

CUSTOMER: CON-ED IPZ EST. NO. _____

COMPONENT	MATERIAL SPECIFICATION	ALLOW STRESS	MTR	COC	NR
CLAMP					
RING					
EARS					
ENCLOSURES					
PIPE					
SOLID BLOCK	SA240 GR 304	11400	X		
END PLATES	SA240 GR 304	"	X		
SIDE BARS					
STRONGBACK BAR					
S.B. EARS/FINGERS					
FASTENERS					
STUDS CLAMP/ENCL.	SA193 GR B8/1	11400	(C3) X	X	
STUDS STRONGBACK			(C3)		
NUTS CLAMP/ENCL.	SA194 GR B8	-	X	X	
NUTS STRONGBACK	(C4)				
SET SCREWS	(B5) ANSI B18.5	X		X	
MISCELLANEOUS					

EC# 7228
C 8/2/98



ALVIN,
TEXAS

CLAMPS & ENCLOSURES

CALCULATIONS

Sht. 7 of 9

DESIGNED BY: eyl DATE: 7/30/98 CSC NO. P39 JOB NO. 579832N
 CHECKED BY: JRM DATE: 7/31/98 ITEM NO. 74298
 DGN. TEMP. _____ DGN. PSIG _____ EST. NO. _____
 SKIN TEMP. _____ OPER. PSIG _____ CALC NO. _____

THRUST FOR UNEQUAL BORES

T=HYDRAULIC THRUST
 D=LARGE CLOSING DIAMETER
 d=SMALL CLOSING DIAMETER
 P=PUMPING PRESSURE
 1000 psi (MIN), 2*DGN PRESS,
 OPER PRESS + 1000 psi (MAX),
 OR DGN PRESS (PERT. SEAL OR SEP.)
 N=# OF STRONGBACKS
 F=FORCE PER STRONGBACK

(C7)
$$T = (D^2 - d^2) * (\pi/4) * P$$

$$= (4.31^2 - 1.9^2) * \frac{\pi}{4} * (1100) + 1.9^2 * \frac{\pi}{4} * (600)$$
 INJECTION THRUST LINE SEPARATION

SAFETY FACTOR $T = \frac{3704.8}{6} = 1701.2$
 $T = 5 * T = 8506$
 $F = T/N = 617.5$

TYPES OF STRONGBACK

A. BOLTS

BS=BOLT STRENGTH
 A=TENSILE AREA OF STUD
 S=ALLOWABLE STRESS

BS=A*S

BS= ≥ F

B. SMOOTH TONGUE

WL=WORKING LOAD OF TONGUE
 DIA=DIAMETER OF FLANGE
 t=TONGUE THICKNESS
 S=ALLOWABLE STRESS

WL=π*DIA*t*S

WL= ≥ T

C. SET SCREWS

Hp=HOLDING POWER OF SET SCREWS

CUP TIP

CONE TIP

5/16 X +8 UNC

Hp= ≥ F

D. WELD

WS=WELD STRENGTH
 S=ALLOWABLE STRESS
 L=LENGTH OF WELD

WS=tL*√2/2*L*S*.45
 tL=THROAT LENGTH

WS= ≥ T

C 8/2/98

CA

ADD

Sheet 7a of 9

Crunch Ring Strongback Analysis

Designed By: CYL Date: 8/2/98CSC # P37 Job # 079832NChecked By: CL Date: 8-2-98

Calculation # _____

Customer: CON-ED IP2

Estimate # _____

Location: _____

Item # 74298

Purpose: This analysis will calculate the frictional force caused by the Crunch Ring Strongback and the internal stresses of the Crunch Ring Strongback due to the bolting.


References: ASME Boiler and Pressure Vessel Code, Section II, Part D, (Table for Maximum Allowable Stresses, 1995 Edition)

Mechanics of Materials by Beer and Johnston, 1981

Machinery's Handbook, 23rd Edition, pages 1278-1279 and 1498-1520

Data:

Design Pressure	$P := 600 \cdot \text{psi}$
Design Temperature	$T := 600 \cdot \text{deg}$
Inside Radius of Clamp	$R := 1.215 \cdot \text{in}$
Width of Crunch (CONTACT AREA)	$W := .6 \cdot \text{in}$
Friction Factor Dry/Dry Steel	$\mu := 0.3$
Minimum Wall Thickness	$t := .785 \cdot \text{in}$
Bolt CL To Inside Radius	$A := .785 \cdot \text{in}$
Number of Studs	$n := 5$
Tensile Area of Stud	$A_t := .3196 \cdot \text{in}^2$
Allowable Stress of Strongback	$S_a := 11400 \cdot \text{psi}$
Allowable Stress of Stud	$S_b := 11400 \cdot \text{psi}$
Torque Application Factor	$T_q := .65$
Hydraulic Thrust	$T_h := 8506 \cdot \text{lbf}$
Width of Clamp	$W_1 := 8.8125 \cdot \text{in}$

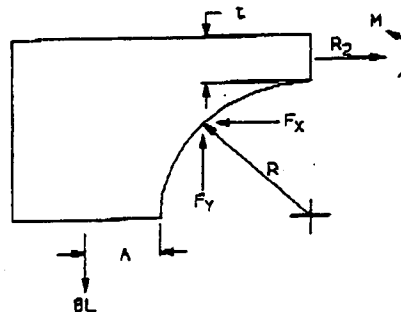

Analysis:

- Bolt Load

$$BL := S_b \cdot A_t \cdot n \cdot T_q \quad BL = 11841.18 \cdot \text{lbf}$$

- Summation of forces in Y-direction

$$F_y - BL = 0$$

$$BL = F_y = P_{cr} \cdot R \cdot W$$

- External pressure caused by crunch ring on pipe

$$P_{cr} := \frac{BL}{R \cdot W} \quad P_{cr} = 16243.045 \cdot \text{psi}$$

- Nominal force on circumference of pipe

$$N := P_{cr} \cdot 2 \cdot \pi \cdot R \cdot W \quad N = 74400.328 \cdot \text{lbf}$$

- Friction force of crunch ring strongback

$$F_f := \mu \cdot N \quad F_f = 22320.098 \cdot \text{lbf}$$

"CONFIDENTIAL"
PROPRIETARY INFORMATION

CT
Amp

8/2/98

- Summation of forces in X-direction

$$R_2 - F_x = 0$$

$$R_2 = F_x = F_y$$

$$R_2 = BL$$

$$R_2 = 11841.18 \cdot \text{lb}f$$

- Summation of moment about R2

$$M - F_x (L/2 + R - R \cdot \sin 45) - F_y (R \cdot \sin 45) + BL (R + A) = 0$$

$$M = BL \left(\frac{L}{2} - A \right)$$

$$M = -4647.663 \cdot \text{in} \cdot \text{lb}f$$

- Tensile Stress of Crunch Ring Strongback

$$\text{Area} = t \cdot W$$

$$\text{Area} = 6.918 \cdot \text{in}^2$$

$$\sigma_1 = \frac{R_2}{\text{Area}}$$

$$\sigma_1 = 1711.694 \cdot \text{psi}$$

- Bending Stress of Crunch Ring Strongback

$$c = \frac{t}{2}$$

$$c = 0.392 \cdot \text{in}$$

$$I = \frac{1}{12} \cdot W \cdot t^3$$

$$I = 0.355 \cdot \text{in}^4$$

$$\sigma_2 = \frac{M \cdot c}{I}$$

$$\sigma_2 = -5135.083 \cdot \text{psi}$$

- Combined Stresses of Crunch Ring Strongback

$$\sigma_{c1} = \sigma_1 + \sigma_2$$

$$\sigma_{c1} = -3423.389 \cdot \text{psi}$$

or

$$\sigma_{c2} = \sigma_1 - \sigma_2$$

$$\sigma_{c2} = 6846.777 \cdot \text{psi}$$

Summary

Friction Force of Crunch Ring Strongback

$$F_f = 22320.098 \cdot \text{lb}f$$

Greater Than

Allowable

$$T_h = 8506 \cdot \text{lb}f$$

Tensile Stress of Crunch Ring Strongback

$$\sigma_1 = 1711.694 \cdot \text{psi}$$

Less Than

$$S_u = 11400 \cdot \text{psi}$$

Bending Stress of Crunch Ring Strongback

$$\sigma_2 = -5135.083 \cdot \text{psi}$$

$$S_u = 11400 \cdot \text{psi}$$

Combined Stresses of Crunch Ring Strongback

$$\sigma_{c1} = -3423.389 \cdot \text{psi}$$

$$S_a \cdot 1.5 = 17100 \cdot \text{psi}$$

$$\sigma_{c2} = 6846.777 \cdot \text{psi}$$



MATERIAL SPECIFICATIONS

NON-CRITICAL/NUCLEAR
 CRITICAL/NUCLEAR

SHT. 3 OF 3

DRAWN BY: CLC 7/31/98 CSC NO. 737 JOB NO. 079832N

CHECKED BY: CBM 7/31/98 ITEM NO. 74298

CUSTOMER: CON-ED IP2 EST. NO. _____

COMPONENT	MATERIAL SPECIFICATION	ALLOW STRESS	MTR	COC	NR
CLAMP					
RING					
EARS					
ENCLOSURES					
PIPE					
SOLID BLOCK	SA240 GR 304	11400	X		
END PLATES	SA240 GR 304	"	X		
SIDE BARS					
STRONGBACK BAR					
S.B. EARS/FINGERS					
FASTENERS					
STUDS CLAMP/ENCL.	SA193 GR B8/1	11400		X	
STUDS STRONGBACK					
NUTS CLAMP/ENCL.	SA194 GR B8	-		X	
NUTS STRONGBACK					
SET SCREWS (SS)	ANSI B18.3	-		X	
MISCELLANEOUS					



CONFIDENTIAL
 PROPRIETARY INFORMATION

ALL DIMENSIONS TYPICAL UNLESS OTHERWISE NOTED

ECO# 7228
C 8/2/98

ECO# 7224
A 7/31/98

(A2) PMI required for all materials

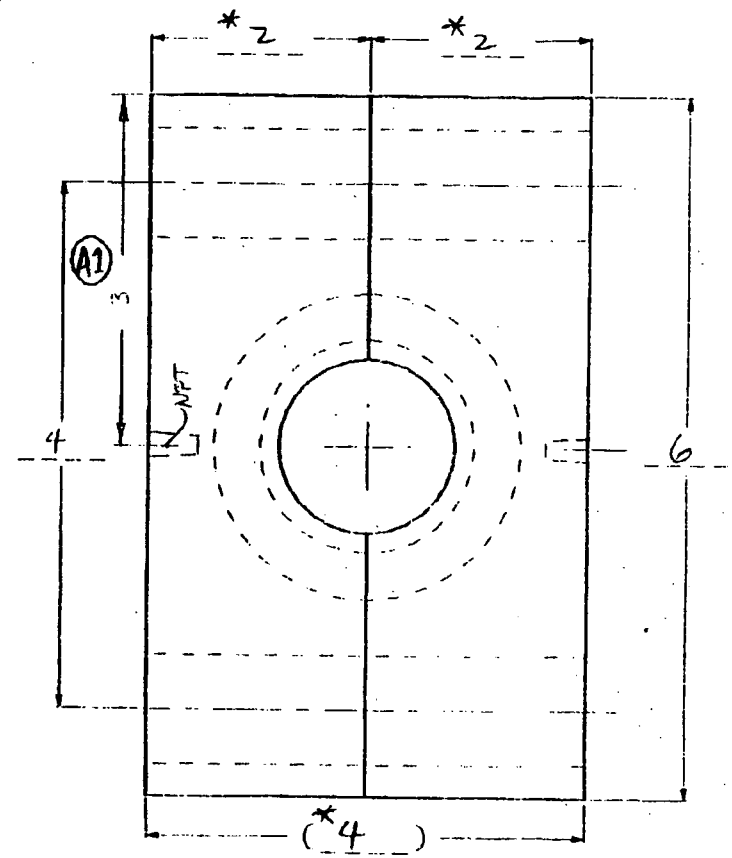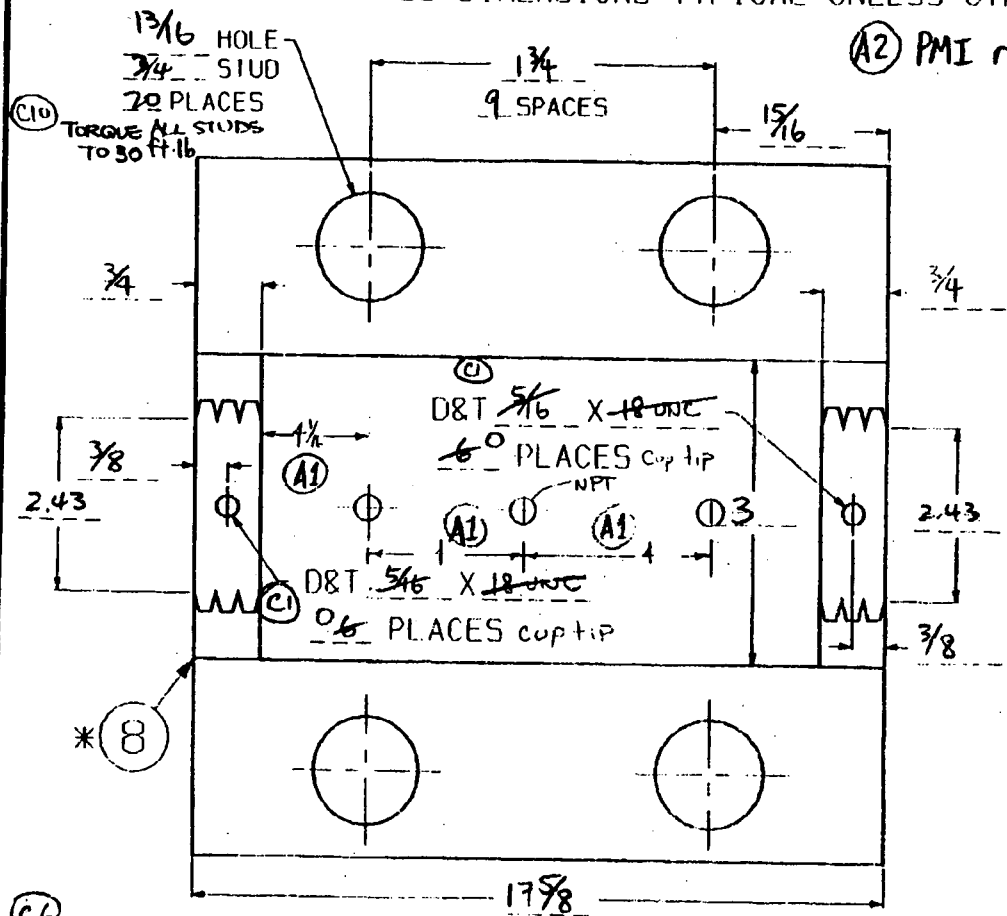

(C6) DO NOT INJECT
~~LIMIT MAX INJ. PRESSURE TO 1100 PSI + STATIC~~

(C5) MIN 1/16" FROM
SPLIT LINE (EACH HALF)
* DIMS BEFORE MILL
"CONFIDENTIAL"
PROPRIETARY INFORMATION

NUCLEAR
DO NOT PAINT

* WELDED ENDPLATES OPTIONAL
O.110 CRUNCH
D&T 6 - 1/8 NPT (CAVITY)

 ALVIN, TEXAS	JOB NO. P37-079832N	MATERIAL SEE MS SHEET	WEIGHT 112.4lb	VOID 68.5in ³ BC
	CLAMP NO. 74298	UNLESS NOTED OTHERWISE	CON-ED IP2	
EST. NO.	MACHINED SURFACES Break Sharp Corners	250 ✓ .005		
WELDING SPEC. NO. SEE WELD MAP	TOLERANCES:	3 Place Decimat .005 2 Place Decimat .01 1 Place Decimat .1 ANGLES 1/2" FRACTIONS 1/32	DWG. NO. sb_cr_2w_ss2	REV
DRAWN BY: CXL 7/30/98	APPROVED:	ALL DIMENSIONS IN INCHES	SCALE: NTS	Sheet 1 of 3

** TOTAL PAGE.03 **

P.03/03
 72283333--
 291 559 5932 12 E
 AN ENGINEERING



CLAMPS & ENCLOSURES

CALCULATIONS

Sheet 9 of 9

DESIGNED BY: exl DATE: 7/30/98 CSC NO. P39 JOB NO. 579832N
 CHECKED BY: JKM DATE: 7/31/98 ITEM NO. 74298
 DGN. TEMP. _____ DGN. PSIG _____ EST. NO. _____
 SKIN TEMP. _____ OPER. PSIG _____ CALC NO. _____

THRUST FOR UNEQUAL BORES

T=HYDRAULIC THRUST
 D=LARGE CLOSING DIAMETER
 d=SMALL CLOSING DIAMETER
 P=PUMPING PRESSURE
 1000 psi (MIN), 2*DGN PRESS,
 OPER PRESS + 1000 psi (MAX),
 OR DGN PRESS (PERI. SEAL OR SEP.)
 N=# OF STRONGBACKS
 F=FORCE PER STRONGBACK

$$T = (D^2 - d^2) * (\pi/4) * P$$

$$= (3.433^2 - 1.9^2) * \frac{\pi}{4} * (1100) + 1.9^2 * \frac{\pi}{4} * (600)$$

INJECTION THRUST LINE SEPARATION

T = 3704.8

$$F = T/N$$

F = 617.5

TYPES OF STRONGBACK

A. BOLTS

BS=BOLT STRENGTH
 A=TENSILE AREA OF STUD
 S=ALLOWABLE STRESS

$$BS = A * S$$

BS = ≥ F

B. SMOOTH TONGUE

WL=WORKING LOAD OF TONGUE
 DIA=DIAMETER OF FLANGE
 t=TONGUE THICKNESS
 S=ALLOWABLE STRESS

$$WL = \pi * DIA * t * S$$

WL = ≥ T

C. SET SCREWS

Hp=HOLDING POWER OF SET SCREWS

CUP TIP

CONE TIP

5/16 x 18 UNC

Hp = 625 ≥ F

D. WELD

WS=WELD STRENGTH
 S=ALLOWABLE STRESS
 L=LENGTH OF WELD

$$WS = tL * \sqrt{2}/2 * S * .45$$

tL=THROAT LENGTH



WS = ≥ T

"CONFIDENTIAL"
 PROPRIETARY INFORMATION

Weight Calculations for a Bar Clamp:

Designed by: CYL Date: 7/30/98
 Checked by: JR Date: 7/31/98
 Customer: CON-ED IP2

Job No. P37-070332N
 Clamp No. 74298
 Estimate No. _____
 Calculation No. _____

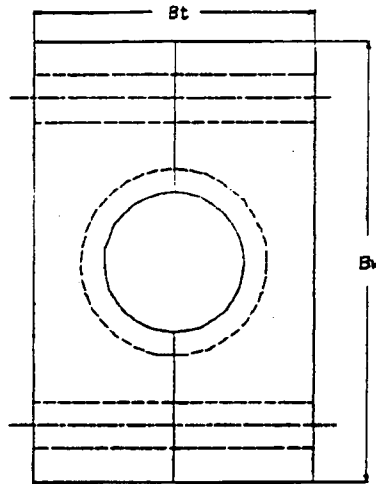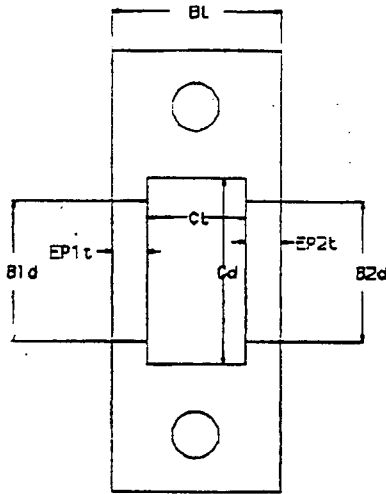

Data:

Block Length $BL := 17.625 \text{ in}$
 Block Width $Bw := 6 \text{ in}$
 Block Thickness $Bt := 4 \text{ in}$

Cavity Diameter $Cd := 3 \text{ in}$
 Cavity Length $Cl := 16.125 \text{ in}$

Stud Size $SS := .75 \text{ in}$
 Number of Studs $N := 20$
 Stud Length $SL := 8 \text{ in}$
 Stud Bore Oversize $SBO := 0.0625 \text{ in}$

Stud Weight (per unit length) $SW := 0.13 \frac{\text{lb}}{\text{in}}$
 Nut Weight (per nut) $NW := 0.19 \text{ lb}$

Block $:= \rho \cdot (BL \cdot Bw \cdot Bt)$

Cavity $:= \rho \cdot Cd^2 \cdot \frac{\pi}{4} \cdot Cl$

EndPlate1 $:= \rho \cdot (B1d^2) \cdot \frac{\pi}{4} \cdot EP1t$

EndPlate2 $:= \rho \cdot (B2d^2) \cdot \frac{\pi}{4} \cdot EP2t$

StudHoles $:= \rho \cdot (SS + SBO)^2 \cdot N \cdot \frac{\pi}{4} \cdot Bt$

Studs $:= N \cdot SL \cdot SW$

Nuts $:= (2 \cdot N) \cdot NW$

Sealant $:= \text{Void} \cdot \rho_s \cdot CR$

InjValves $:= NIV \cdot 0.50 \text{ lb}$

Bore 1 Diameter $B1d := 2.43 \text{ in}$
 Endplate 1 Thickness $EP1t := .75 \text{ in}$

Bore 2 Diameter $B2d := 2.43 \text{ in}$
 Endplate 2 Thickness $EP2t := .75 \text{ in}$

Sealant Void (Before Compression) $\text{Void} := 68.49 \text{ in}^3$
 Sealant Density $\rho_s := 0.07 \frac{\text{lb}}{\text{in}^3}$
 Compression Ratio $CR := 1.50$

Enclosure Density $\rho := 0.2833 \frac{\text{lb}}{\text{in}^3}$

Number of Injection Valves $NIV := 6$

Block $= 119.84 \text{ lb}$

Cavity $= 32.29 \text{ lb}$

EndPlate1 $= 0.99 \text{ lb}$

EndPlate2 $= 0.99 \text{ lb}$

StudHoles $= 11.75 \text{ lb}$

Studs $= 20.8 \text{ lb}$

Nuts $= 7.6 \text{ lb}$

Sealant $= 7.19 \text{ lb}$

InjValves $= 3 \text{ lb}$

Weight $:= \text{Block} - \text{Cavity} - \text{EndPlate1} - \text{EndPlate2} - \text{StudHoles} + \text{Studs} + \text{Nuts} + \text{Sealant} + \text{InjValves}$

Weight $= 112.41 \text{ lb}$


Void Calculations:

$$V := (Cd)^2 \cdot \left(\frac{\pi}{4}\right) \cdot Cl - \left[(1.9 \cdot in)^2 \cdot \left(\frac{\pi}{4}\right) \cdot (16.425 \cdot in) \right] - \left[(0 \cdot in)^2 \cdot \left(\frac{\pi}{4}\right) \cdot (0 \cdot in) \right] - \left[(0 \cdot in)^2 \cdot \left(\frac{\pi}{4}\right) \cdot (0 \cdot in) \right]$$

$$V := V + (NIV \cdot 0.18 \cdot in^3)$$

$$V = 68.49 \cdot in^3$$

'CONFIDENTIAL'
PROPRIETARY INFORMATION

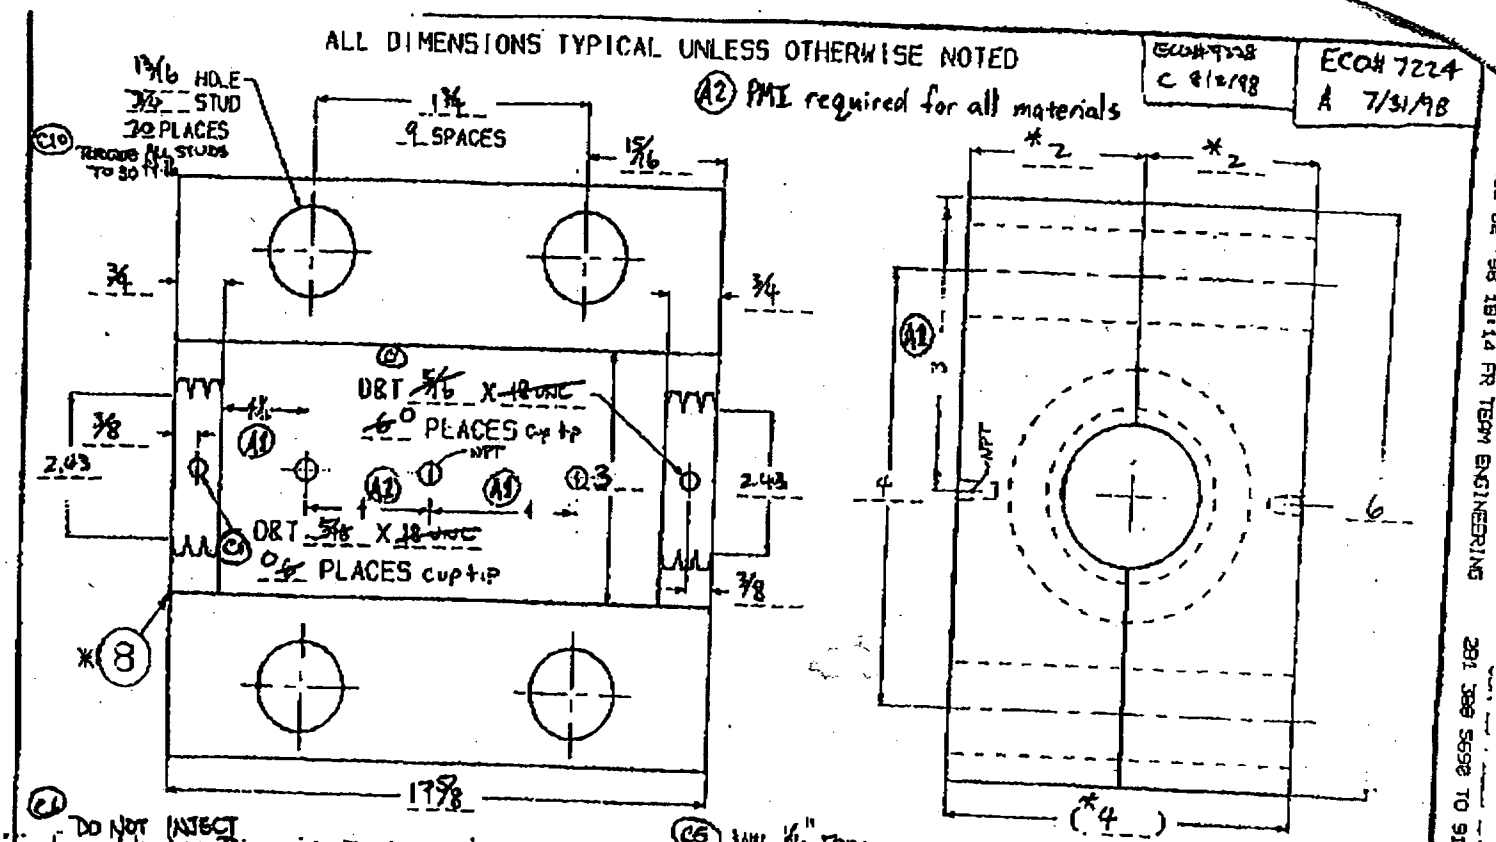

(A1) DO NOT INTERFERE WITH MAX. PRESSURE TO HOOPER STATE

(A2) WILL 1/16" FROM SPLIT LINES (EACH HALF) * DIA. BEGINS WILL

NUCLEAR
DO NOT PAINT

* WELDED ENOPLATES OPTIONAL
O.H.C. CRUNCH
DBT C - 1/8 NPT (CAVITY)

"CONFIDENTIAL"
* DIA. BEGINS WILL PROPRIETARY INFORMATION

	JOB NO. P27-079832A	MATERIAL SEE HS SHEET	WEIGHT 112.4lb	NO. OF 68.5in ³ @
	DRAWING NO. 74298	DATE 7/15/98	DESIGNED BY ALVIN, TEXAS	CON-ED IPZ
EST. NO.	ISSUE SPEC. NO. SEE WELD MAP	DESIGNED BY ALVIN, TEXAS	CHECKED BY YSA	DATE 7/15/98
DRAWN BY DR	DATE 7/15/98	APPROVED BY	DATE 7/15/98	SCALE NYS (Scale: 1)

Proposed Clamp Design
Figure 3

0