
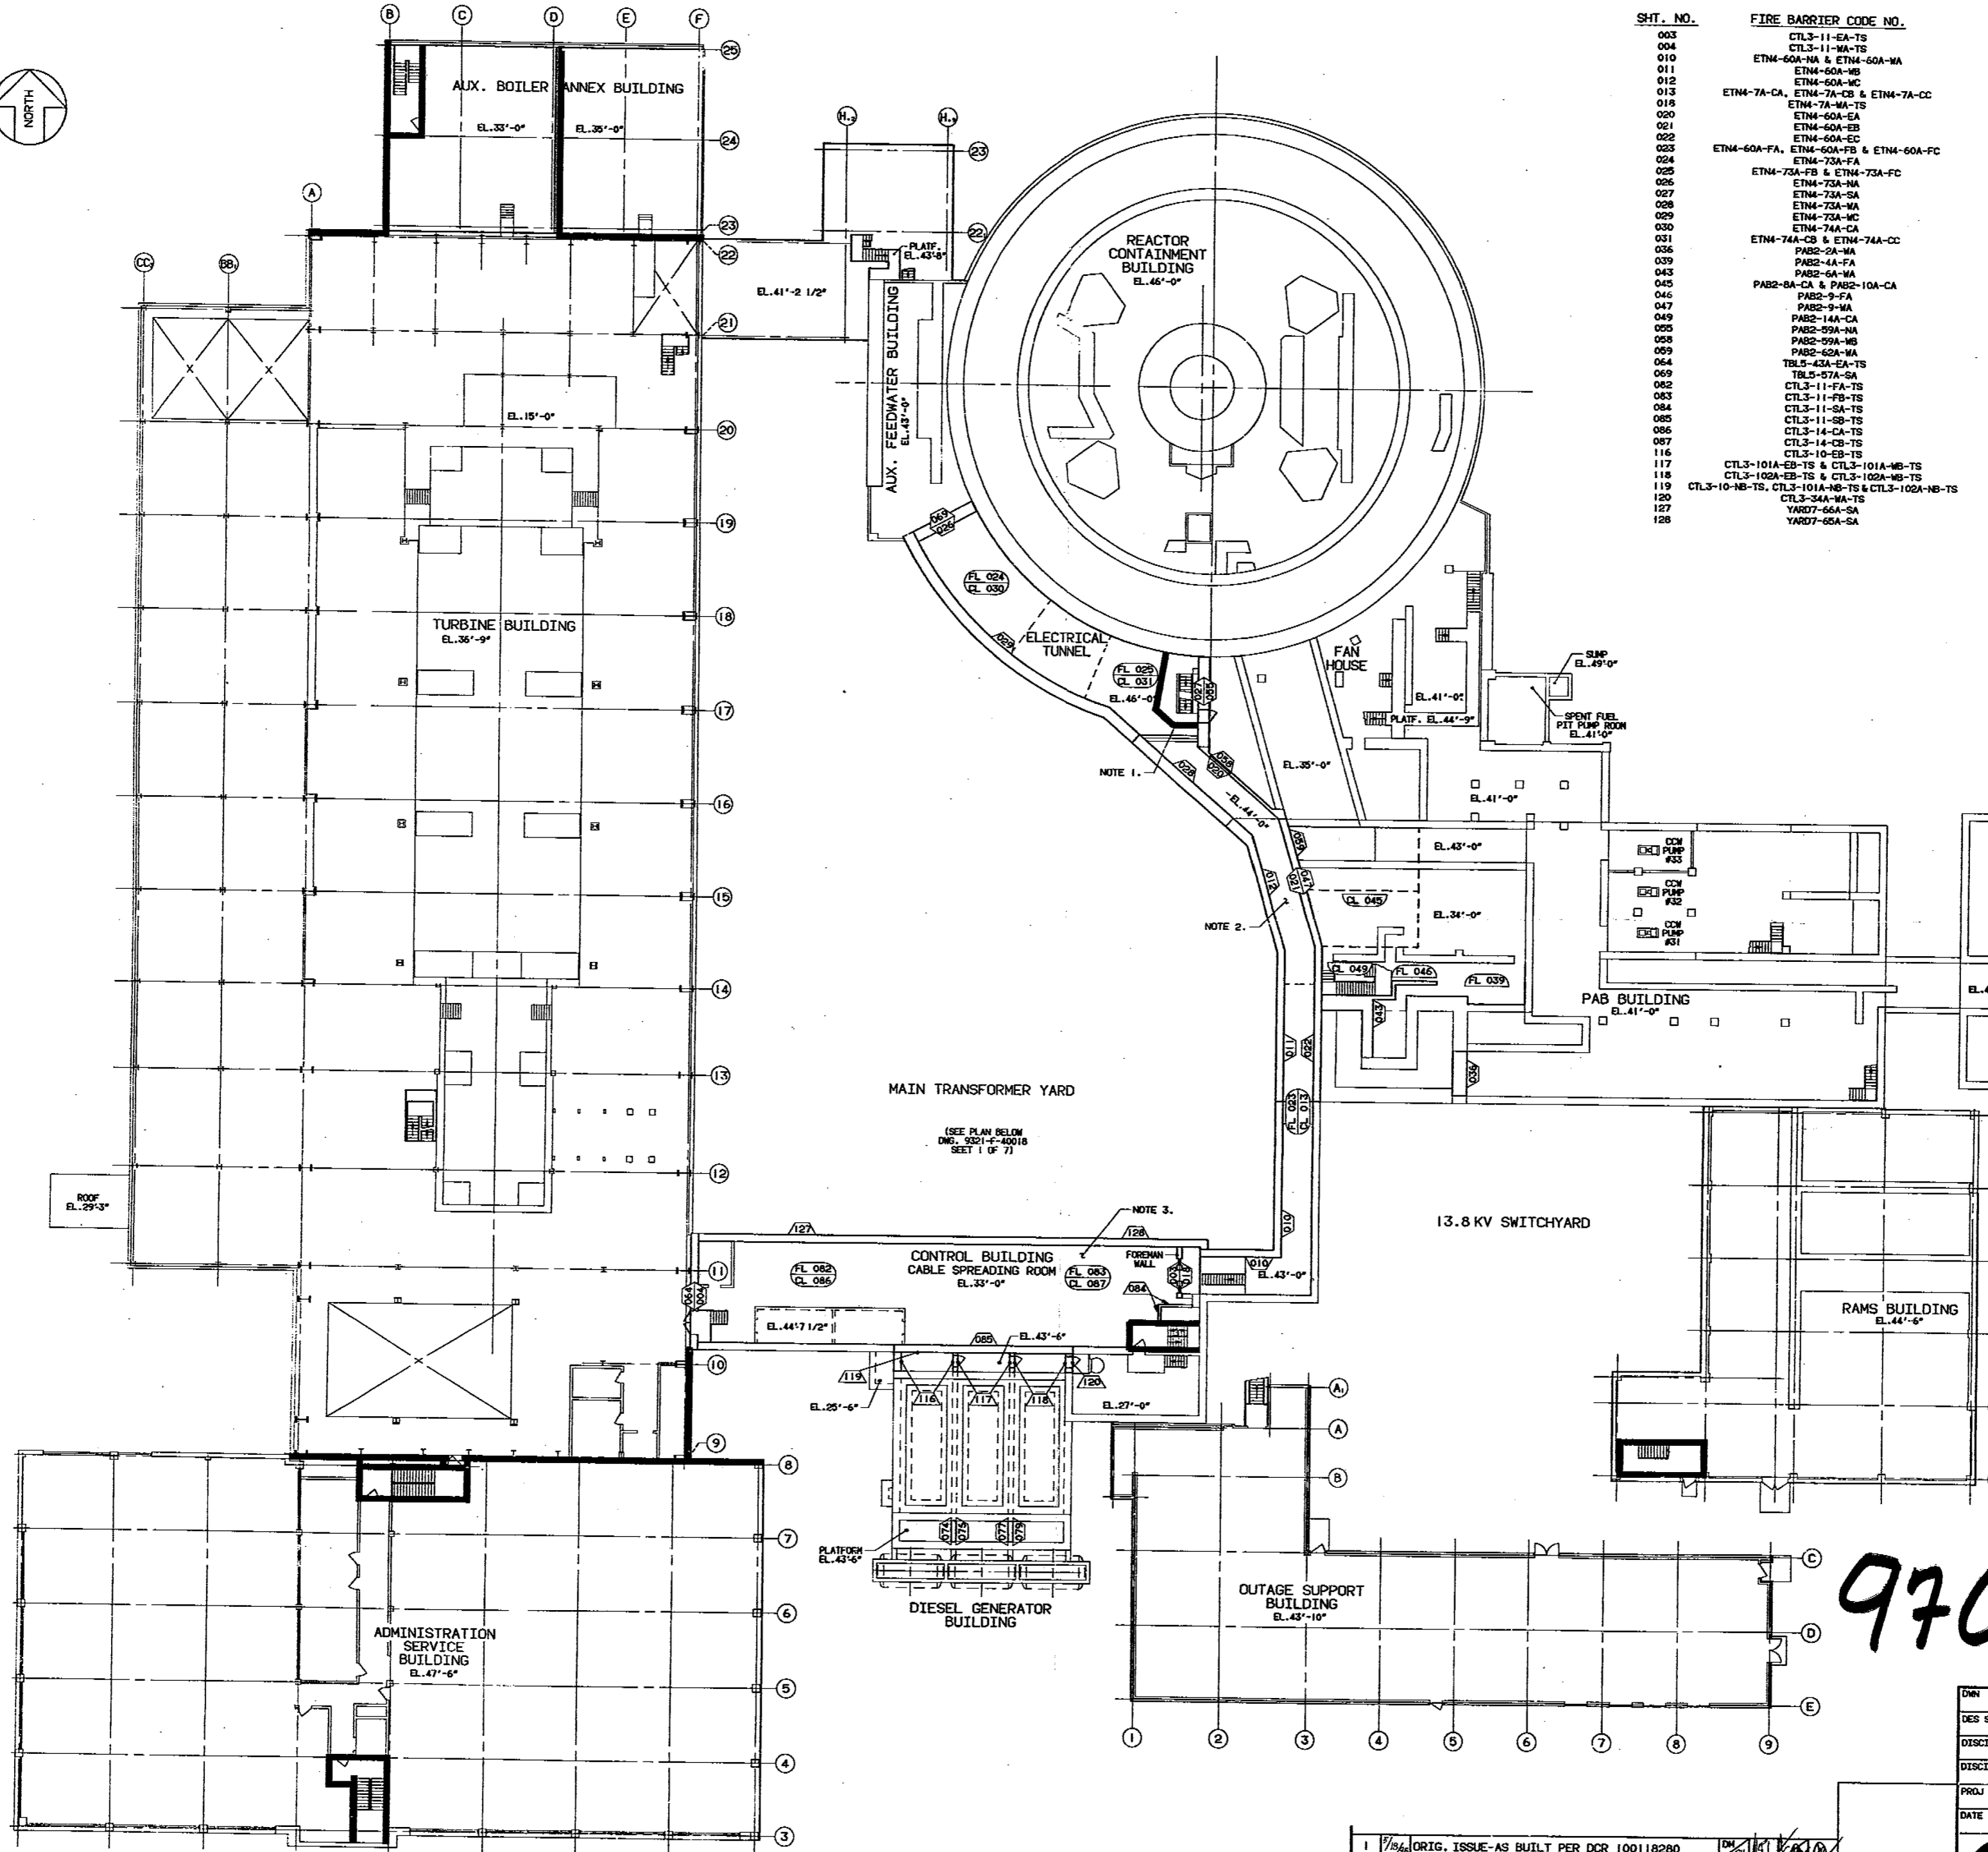


8 7 6 5 4 3 2 1

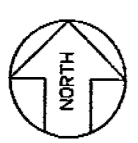

SHT. NO.	FIRE BARRIER CODE NO.
003	CTL3-11-EA-TS
004	CTL3-11-MA-TS
010	ETM-60A-NA & ETM-60A-MA
011	ETM-60A-NB
012	ETM-60A-MC
013	ETM-7A-CA, ETM-7A-CB & ETM-7A-CC
018	ETM-7A-MA-TS
020	ETM-60A-EA
021	ETM-60A-EB
022	ETM-60A-EC
023	ETM-60A-FA, ETM-60A-FB & ETM-60A-FC
024	ETM-73A-FA
025	ETM-73A-FB & ETM-73A-FC
026	ETM-73A-MA
027	ETM-73A-SA
028	ETM-73A-WA
029	ETM-73A-MC
030	ETM-74A-CA
031	ETM-74A-CB & ETM-74A-CC
032	PAB2-2A-MA
039	PAB2-4A-FA
043	PAB2-6A-WA
045	PAB2-8A-CA & PAB2-10A-CA
046	PAB2-9-FA
047	PAB2-9-MA
049	PAB2-1A-CA
055	PAB2-5A-NA
058	PAB2-5A-NB
059	PAB2-6A-MA
064	TBL5-43A-EA-TS
069	TBL5-57A-SA
082	CTL3-11-FA-TS
083	CTL3-11-FB-TS
084	CTL3-11-SA-TS
085	CTL3-11-SB-TS
086	CTL3-14-CA-TS
087	CTL3-14-CB-TS
116	CTL3-10-EB-TS
117	CTL3-101A-EB-TS & CTL3-101A-NB-TS
118	CTL3-102A-EB-TS & CTL3-102A-NB-TS
119	CTL3-10-NB-TS, CTL3-101A-NB-TS & CTL3-102A-NB-TS
120	CTL3-34A-WA-TS
127	YARD7-66A-SA
128	YARD7-66A-SA

- NOTES:**
- 1/4" THICK STEEL PLATE EXPOSURE BARRIER AT THE STAIRWAY OPENING, ELEVATION 46'-0".
  - THE FLOOR/CEILING ASSEMBLY BETWEEN THE UPPER ELECTRICAL TUNNEL AND PENETRATION AREA (FIRE ZONES 60A AND 73A) AND THE LOWER ELECTRICAL TUNNEL AND PENETRATION AREA (FIRE ZONES 7A AND 74A) IS A CONTROLLED BARRIER. SEE DEFINITION SHT. 1.
  - THE BARRIER SEPARATING THE 480V SWITCHGEAR ROOM (FIRE ZONE 14) AND THE CABLE SPREADING ROOM (FIRE ZONE 11) AND THE BARRIER SEPARATING THE CABLE SPREADING ROOM FROM THE CONTROL ROOM (FIRE ZONE 15) ARE BARRIERS REQUIRED BY OPERATIONAL SPECIFICATIONS 3.5.3.

ANSTEC  
APERTURE  
CARD

**UNCONTROLLED  
DRAWING**

Copy Date \_\_\_\_\_  
CAUTION - Extended use of this drawing copy may result in inaccuracy due to subsequent changes and drawing updates.

**9701070150**  
NOT NUCLEAR SAFETY RELATED

1	1/8/99	ORIG. ISSUE-AS BUILT PER DCR 100118280	DES	CHK	APP
REV	DATE	DESCRIPTION	DES	CHK	APP
REVISIONS					

DN	CHK'D	INDIAN POINT NO.3 NUCLEAR POWER PLANT
DES	SUPV	
DISCIPLINE	ENG	FIRE BARRIER PENETRATION WALLS LOCATION SITEMAP PLANS EL. 41'-0", 43'-0", 43'-10", 44'-0", 46'-0" & 47'-6"
DISCIPLINE	MGR.	
PRJ	APPROVAL	New York Power Authority
DATE		
SCALE: 1/16"=1'-0"		REV 1
DNG NO 9321-F-40018		
SHEET 3 OF 7		

8 7 6 5 4 3 2 1

9701070150