

Attachment 02.04.03-08K
TVA letter dated February 2, 2010
RAI Response

ASSOCIATED ATTACHMENTS/ENCLOSURES:

Attachment 02.04.03-8K: Dam Rating Curve, Fort Patrick Henry

(82 Pages including Cover Sheet)



NPG CALCULATION COVERSHEET/CCRIS UPDATE

Page 1

REV 0 EDMS/RIMS NO. L58 090120 003				EDMS TYPE: Calculations (nuclear)		EDMS ACCESSION NO (N/A for REV. 0) L58 091230 023	
Calc Title: Dam Rating Curve, Fort Patrick Henry							
CALC ID	TYPE	ORG	PLANT	BRANCH	NUMBER	CUR REV	NEW REV
CURRENT	CN	NUC	GEN	CEB	CDQ000020080010	0	1
NEW							
ACTION		NEW REVISION <input checked="" type="checkbox"/>	DELETE RENAME <input type="checkbox"/>	SUPERSEDE DUPLICATE <input type="checkbox"/>	CCRIS UPDATE ONLY <input type="checkbox"/> (Verifier Approval Signatures Not Required)		No CCRIS Changes <input type="checkbox"/> (For calc revision, CCRIS been reviewed and no CCRIS changes required)
UNITS N/A		SYSTEMS N/A			UNIDS N/A		
DCN.EDC.N/A *See Below		APPLICABLE DESIGN DOCUMENT(S) N/A				CLASSIFICATION E	
QUALITY RELATED? Yes <input checked="" type="checkbox"/> No <input type="checkbox"/>		SAFETY RELATED? (If yes, QR = yes) Yes <input checked="" type="checkbox"/> No <input type="checkbox"/>		UNVERIFIED ASSUMPTION Yes <input type="checkbox"/> No <input checked="" type="checkbox"/>		SPECIAL REQUIREMENTS AND/OR LIMITING CONDITIONS? Yes <input checked="" type="checkbox"/> No <input type="checkbox"/>	
						DESIGN OUTPUT ATTACHMENT? Yes <input type="checkbox"/> No <input checked="" type="checkbox"/>	
						SAR/TS and/or ISFSI SAR/CoC AFFECTED Yes <input type="checkbox"/> No <input checked="" type="checkbox"/>	
PREPARER ID C. J. Grace	PREPARER PHONE NO 205.298.6074		PREPARING ORG (BRANCH) CEB		VERIFICATION METHOD Design Review - See Pg 5.1	NEW METHOD OF ANALYSIS <input type="checkbox"/> Yes <input checked="" type="checkbox"/> No	
PREPARER SIGNATURE Chris Grace		DATE 12/21/2009		CHECKER SIGNATURE Andrew Murr		DATE 12/21/2009	
VERIFIER SIGNATURE Andrew Murr		DATE 12/21/2009		APPROVAL SIGNATURE K.R. Spates		DATE 12/23/09	
STATEMENT OF PROBLEM/ABSTRACT							
<p>Headwater rating curves for 20 dams are required as inputs to TVA's SOCH and TRBROUTE models, which perform flood-routing calculations for the Tennessee River and tributaries. The headwater rating curves for each dam provide total dam discharge as a function of headwater elevation. This calculation presents the headwater rating curve for Fort Patrick Henry Dam.</p> <p>This calculation contains electronic attachments and must be stored in EDMS as an Adobe .pdf file to maintain the ability to retrieve the electronic attachments.</p> <p>*EDCN 22404A (SQN), EDCN 54018A (WBN), EDCN Later (BFN)</p> <p>Limiting Condition Note: The headwater rating curve provided in this calculation is limited in application to maximum PMF headwater elevation of 1288 feet (See Section 5.0 in the calculation for the basis of this limiting condition).</p>							
MICROFICHE/EFICHE Yes <input type="checkbox"/> No <input checked="" type="checkbox"/> FICHE NUMBER(S)							
<input type="checkbox"/> LOAD INTO EDMS AND DESTROY <input checked="" type="checkbox"/> LOAD INTO EDMS AND RETURN CALCULATION TO CALCULATION LIBRARY. ADDRESS: LP4D-C <input type="checkbox"/> LOAD INTO EDMS AND RETURN CALCULATION TO:							

TVAN CALCULATION COVERSHEET/CCRIS UPDATE

Page 1a

REV 0 EDMS/RIMS NO. 158 090120 003				EDMS TYPE: Calculations (nuclear)		EDMS ACCESSION NO (N/A for REV. 0) N/A	
Calc Title: Dam Rating Curve, Fort Patrick Henry							
CALC ID	TYPE	ORG	PLANT	BRANCH	NUMBER	CUR REV	NEW REV
CURRENT	CN	NUC			0		
NEW	CN	NUC	GEN	CEB	CDQ000020080010	N/A	0
ACTION		NEW REVISION <input checked="" type="checkbox"/>	DELETE RENAME <input type="checkbox"/>	SUPERSEDE DUPLICATE <input type="checkbox"/>	CCRIS UPDATE ONLY <input type="checkbox"/> (Verifier Approval Signatures Not Required)		No CCRIS Changes <input type="checkbox"/> (For calc revision, CCRIS been reviewed and no CCRIS changes required)
UNITS N/A		SYSTEMS N/A			UNIDS N/A		
DCN/EDC/N/A N/A		APPLICABLE DESIGN DOCUMENT(S) N/A				CLASSIFICATION E	
QUALITY RELATED? Yes <input checked="" type="checkbox"/> No <input type="checkbox"/>	SAFETY RELATED? (If yes, OR = yes) Yes <input checked="" type="checkbox"/> No <input type="checkbox"/>	UNVERIFIED ASSUMPTION Yes <input checked="" type="checkbox"/> No <input type="checkbox"/>	SPECIAL REQUIREMENTS AND/OR LIMITING CONDITIONS? Yes <input type="checkbox"/> No <input checked="" type="checkbox"/>		DESIGN OUTPUT ATTACHMENT? Yes <input type="checkbox"/> No <input checked="" type="checkbox"/>	SAR/TS and/or ISFSI SAR/CoC AFFECTED Yes <input type="checkbox"/> No <input checked="" type="checkbox"/>	
PREPARER ID jvpeyton	PREPARER PHONE NO 865-632-3280	PREPARING ORG (BRANCH) CEB		VERIFICATION METHOD Design Review	NEW METHOD OF ANALYSIS <input type="checkbox"/> Yes <input checked="" type="checkbox"/> No		
PREPARI J.V. Peyton	G.A. Schohl	DATE 12/3/2008	CHECKER SIGNATURE JANIE B. MAUTER		DATE 12/16/08		
VERIFIER SIGNATURE ANDREW C. MURK	R.B. Williams	DATE 12/16/08	APPROVAL SIGNATURE E.R. SPATES		DATE 1/20/09		
STATEMENT OF PROBLEM/ABSTRACT							
<p>Headwater rating curves for 20 dams are required as inputs to TVA's SOCH and TRBROUTE models, which perform flood-routing calculations for the Tennessee River and tributaries. The headwater rating curves for each dam provide total dam discharge as a function of headwater elevation. This calculation presents the headwater rating curve for Fort Patrick Henry Dam.</p> <p>This calculation contains electronic attachments and must be stored in EDMS as an Adobe .pdf file to maintain the ability to retrieve the electronic attachments.</p>							
MICROFICHE/EFICHE Yes <input type="checkbox"/> No <input checked="" type="checkbox"/> FICHE NUMBER(S)							
<input type="checkbox"/> LOAD INTO EDMS AND DESTROY <input checked="" type="checkbox"/> LOAD INTO EDMS AND RETURN CALCULATION TO CALCULATION LIBRARY. ADDRESS: LP4D-C <input type="checkbox"/> LOAD INTO EDMS AND RETURN CALCULATION TO:							

Page 2

<u>CALC ID</u>	<u>TYPE</u>	<u>ORG</u>	<u>PLANT</u>	<u>BRANCH</u>	<u>NUMBER</u>	<u>REV</u>
	CN	NUC	GEN	CEB	CDQ000020080010	1

<u>ALTERNATE CALCULATION IDENTIFICATION</u>					
<u>BLDG</u>	<u>ROOM</u>	<u>ELEV</u>	<u>COORD/AZIM</u>	<u>FIRM</u> BWSC	<u>Print Report</u> Yes <input type="checkbox"/>
CATEGORIES SR/LC					

[illegible][illegible]

Following are required only when making keyword/cross reference CCRIS updates and page 1 of form NEDP-2-1 is not included:

PREPARER SIGNATURE	DATE	CHECKER SIGNATURE	DATE
PREPARER PHONE NO.	EDMS ACCESSION NO.		

NPG CALCULATION RECORD OF REVISION	
CALCULATION IDENTIFIER CDQ000020080010	
Title Dam Rating Curve, Fort Patrick Henry	
Revision No.	DESCRIPTION OF REVISION
0	Initial issue Total pages: 67 Attachment 1: 2 pages; Attachment 2: 1 page Appendix A: 5 pages; Attachments A1 thru A3: 1 page each; Attachment A4: 7 pages; Attachment A5: 1 page; Attachment A6: 5 pages; Attachments A7 thru A14: 1 page each.
1	<p>Revised to eliminate Unverified Assumption in Section 3.2; added Reference 2.20 (Page 8); revise CCRIS input information on Page 2 and Revised coversheet.</p> <p>This calculation was also revised to address the following :</p> <ul style="list-style-type: none"> • PER 203951- The verification of the original calculation was completed by personnel who had not completed the required NEDP-7 Job Performance Record (JPR). A verification JPR is now in place for all personnel engaged in verification tasks. Checking includes only changes made in this revision as the checking of the calculation was not impacted by PER 203951. The verification is inclusive of work completed prior to this revision. • PER 203872- replace NEDP-2 forms on Pages 1 through 6 (excluding Page 1a) with the forms from the NEDP-2 Revision in effect at the time of calculation issuance. • Removed UVA 3.2.1. Replaced with: <ul style="list-style-type: none"> ○ Assumption 3.1.2 based on Reference 2.20 and, ○ Assumption 3.1.3 based on Appendix B. • Added Limiting Condition to calculation in Section 5.0. <p>Significant changes in Revision 1 are noted with a right margin revision bar. Administrative changes and typos are excluded.</p> <p>Pages deleted: none Pages revised: 1, 2, 3, 4, 5, 8, 9 New pages added: 1a (Rev 0 coversheet), 5.1 (NEDP 2-4), B1-B4 Calculation header was revised (Title and Revision) on pages 8-9</p> <p>Total pages for Revision 1: 73 Attachment 1: 2 pages; Attachment 2: 1 page Appendix A: 5 pages; Attachments A1 thru A3: 1 page each; Attachment A4: 7 pages; Attachment A5: 1 page; Attachment A6: 5 pages; Attachments A7 thru A14: 1 page each. Appendix B: 4 pages</p>

NPG CALCULATION TABLE OF CONTENTS		
Calculation Identifier: CDQ000020080010		Revision: 1
TABLE OF CONTENTS		
SECTION	TITLE	PAGE
	Coversheet	1
	Revision 0 Coversheet	1a
	CCRIS Update Sheet	2
	Revision Log	3
	Table of Contents	4
	Calculation Verification Form	5.1
	Computer Input Sheet	6
1.0	Purpose	7
2.0	References	8
3.0	Assumptions & Methodology	9
	3.1 Assumptions	9
	3.2 Unverified Assumptions	9
	3.3 Methodology – Discharge Equations	10
	3.4 Methodology – Spillway Discharge Calculations	11
	3.5 Methodology – Discharge Coefficients and Submergence Factors for Overflow Sections	11
4.0	Design Input	12
	4.1 Acceleration of Gravity	12
	4.2 Spillway Crest Parameter	12
	4.3 Spillway Gate Parameters	12
	4.4 Spillway Gate Overflow	12
	4.5 Powerhouse Overflow	12
	4.6 Spillway Piers Overflow	12
	4.7 Nonoverflow Dam (B=12')	12
	4.8 Nonoverflow Dam (B=26.25')	13
	4.9 Tailwater Rating Curve	13
5.0	Special Requirements/Limiting Conditions	14
6.0	Calculations	15
	6.1 Overflow Lengths	16
	6.2 Overflow Parameters	17
	6.3 Configuration of Spillway Gates – Maximum Open	20
	6.4 Overflow Parameter for Tainter Spillway Gate	22
	6.5 Tailwater Submergence Effect on Discharge	25
	6.6 Turbine Discharge	25.1
7.0	Results/Conclusions	26


NPG CALCULATION TABLE OF CONTENTS (CONTINUED)

Calculation Identifier: CDQ000020080010

Revision: 1

TABLE OF CONTENTS(Continued)

SECTION	TITLE	PAGE
Attachments		
1	Fort Patrick Henry Tailwater Rating Curve	2 Pages
2	Submergence Factors for Radial Gates on Spillway Crests	1 Page
3	Excel file: Ft. Patrick Henry Dam Rating Curve Turbine Discharge.xls (Electronic attachment)	N/A
4	TVA Drawing No. 10W200 R8 (Electronic attachment)	1 Page
5	TVA Drawing No. 10W201 R8 (Electronic attachment)	1 Page
6	TVA Drawing No. 10N203 R5 (Electronic attachment)	1 Page
7	TVA Drawing No. 46N401 R0 (Electronic attachment)	1 Page
8	TVA Drawing No. 54N201 R1 (Electronic attachment)	1 Page
9	TVA Drawing No. 54N202 R1 (Electronic attachment)	1 Page
Appendix A	Spillway Discharge Coefficients and Submergence Factors for Fort Patrick Henry From 1:15 and 1:112.5 Scale Model Test Data	
Appendix A Attachments		
A1	Location of Spillway Gates	1 Page
A2	Spillway Gate Arrangements	1 Page
A3	Memorandum: "Rating Curves & Gate Operating Instructions – Boone & Fort Patrick Spillways (ASF 1282 and 1303)"	1 Page
A4	Chapter 8, "Hydraulic Model Studies, Fort Patrick Henry Project," Technical Monograph No. 87	7 Pages
A5	Definition Sketch for Spillway Discharge	1 Page
A6	Spillway Gate Geometry	5 Pages
A7	TVA Drawing 54N200 R1– Radial Gates Arrangement	1 Page
A8	TVA Drawing 51N202 R3 – Concrete Blocks 12, 13 & 14 Outline	1 Page
A9	H(Lmin) Determination	1 Page
A10	Free Discharge Coefficient	1 Page
A11	Orifice Discharge Coefficient - Tainter Gates Partially Opened	1 Page
A12	Cg vs Hc – Fort Patrick Henry 1:15 Scale Model Results	1 Page
A13	Discharge Coefficients – Tainter Gates on Spillway Crests	1 Page
A14	Tainter Gate Ratings – Basic Model and Prototype Data	1 Page
A15	Excel file: Ft Pat Henry Model Data for Headwater Ratings.xls (Electronic attachment)	N/A
A16	TVA Drawing No. 54N200 R1 (Electronic attachment)	1 Page
A17	TVA Drawing No. 51N202 R3 (Electronic attachment)	1 Page
	Note: N/A indicates an electronic file that is not paginated.	
Appendix B	Hydrostatic Loads on the Spillway Tainter Gates	4 Pages

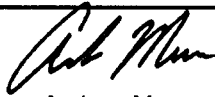NPG CALCULATION VERIFICATION FORM	
Calculation Identifier: CDQ000020080010	Revision: 1
Method of verification used: 1. Design Review <input checked="" type="checkbox"/> 2. Alternate Calculation <input type="checkbox"/> 3. Qualification Test <input type="checkbox"/>	<div style="text-align: center;">  Verifier: <u>Andrew Murr</u> Date <u>12/21/2009</u> </div>
Comments: <p>This calculation entitled, "Dam Rating Curve, Fort Patrick Henry," was verified by independent design review. The process involved a critical review of the calculation to ensure that it is correct and complete, uses appropriate methodologies, and achieves its intended purpose. The inputs were reviewed and determined to be appropriate inputs for this calculation. The results of the calculation were reviewed and were found to be reasonable and consistent with the inputs provided. Backup files and documents were consulted as necessary to verify data and analysis details found in the calculation.</p> <p>Detailed comments and editorial suggestions for the changes made in this revision were transmitted to the author and reviewer by email along with a marked up copy of the calculation.</p> <p>The methodology used to justify the operability of the gates is based solely on the conclusions of the "Watts Bar Dam – Flood and Earthquake Analysis on Radial Spillway Gates." Appendix B uses the same assumptions, methodology, and approach developed in the Watts Bar radial gate analysis to determine the forces on the radial gates in a closed position with the forces on the gates in the maximum open position. This appendix does not assert that a structural analysis has been performed beyond that found in the Watts Bar radial gate calculation.</p> <p>(Note: The design verification of this calculation revision is for the total calculation, not just the changes made in the revision. This complete re-verification is performed to disposition PER 203951 as described in the Calculation Revision Log on Page 3).</p>	

**NPG COMPUTER INPUT FILE
STORAGE INFORMATION SHEET**

Document CDQ000020080010

Rev. 0

Plant: GEN

Subject:

Dam Rating Curve, Fort Patrick Henry

☐ Electronic storage of the input files for this calculation is not required. Comments:

There are no electronic input or output files associated with this calculation.

☒ Input files for this calculation have been stored electronically and sufficient identifying information is provided below for each input file. (Any retrieved file requires re-verification of its contents before use.)

These files are electronically attached to the parent ADOBE.pdf calculation file. All files are therefore stored in an unalterable medium and are retrievable through the EDMS number for this calculation.

Attachment 3: Excel file: "Ft.Patrick Henry Dam Rating Curve Turbine Discharge.xls"

Attachment 4: TVA Drawing No. 10W200 R8

Attachment 5: TVA Drawing No. 10W201 R8

Attachment 6: TVA Drawing No. 10N203 R5

Attachment 7: TVA Drawing No. 46N401 R0

Attachment 8: TVA Drawing No. 54N201 R1

Attachment 9: TVA Drawing No. 54N202 R1

Appendix A Attachments:

Attachment A15: Excel file: "Ft Pat Henry Model Data for Headwater Ratings.xls"

Attachment A16: TVA Drawing No. 54N200 R1

Attachment A17: TVA Drawing No. 51N202 R3

☐ Microfiche/eFiche

TVA

Calculation No. CDQ000020080010	Rev: 0	Plant: GEN	Page: 7
Subject: Dam Rating Curve, Fort Patrick Henry	Prepared G. A. Schohl		
	Checked J. B. Mauter		

1.0 Purpose

Headwater rating curves for twenty dams geographically located on the Tennessee River and its tributaries above the existing Bellefonte Nuclear facility are required as inputs to TVA's SOCH and TRBROUTE models, which perform flood-routing calculations. The headwater rating curves for each dam provide total dam discharge as a function of headwater elevation. This calculation determines the headwater rating curve for Fort Patrick Henry Dam with all spillway gates fully open.

TVA developed methods of analysis, procedures, and computer programs for determining design basis flood levels for nuclear plant sites in the 1970's. Determination of maximum flood levels included consideration of the most severe flood conditions that may be reasonably predicted to occur at a site as a result of both severe hydrometeorological conditions and seismic activity. This process was followed to meet Nuclear Regulatory Guide 1.59. At that time, there were no computer programs available that would handle unsteady flow and dam failure analysis. As a result of this early work and method development TVA developed a runoff and stream course modeling process for the TVA reservoir system. This process provided a basis for currently licensed plants (Sequoyah Nuclear Plant, Watts Bar Nuclear Plant, and Browns Ferry Nuclear Plant). The Bellefonte Nuclear Plant (BLN) Units 1 & 2 Final Safety Analysis Report (FSAR) was also based on this process.

BLN Unit 3 & 4 Combined Operating License Application (COLA) was submitted using data and analysis that was determined for the original BLN FSAR (Unit 1 and Unit 2) and was documented in a 1998 reassessment. In 1998, the analysis process and documentation was brought under the nuclear quality assurance process for the first time. A quality assurance audit conducted by NRC staff in early 2007 raised several questions related to past work regarding design basis flood level determinations. This calculation supports a portion of the effort to improve the design basis documentation.

Drawing 10W200 (Reference 2.1) provides plan and elevation views of Fort Patrick Henry Dam. For headwaters in the normal operating range, discharge is passed through the turbines or the spillway. The spillway consists of five spillway bays, each with a radial, or tainter, gate to control discharge. If, as during a probable maximum flood (PMF) event, headwater rises above the normal operating range, discharge may pass also over the dam nonoverflow section, the tops of the open spillway gates and the tops of the spillway piers.

TVA

Calculation No. CDQ000020080010	Rev: 1	Plant: GEN	Page: 8
Subject: Dam Rating Curve, Fort Patrick Henry	Prepared C.Grace		
	Checked A. Murr		

2.0 References

- 2.1 TVA drawing 10W200 R8, "General Plan, Elevation & Sections."
- 2.2 TVA drawing 10W201 R8, "General Plan, Elevation & Sections."
- 2.3 TVA drawing 54N200 R1, "Radial Gates Arrangement."
- 2.4 TVA drawing 54N201 R1, "Radial Gates Structural Details – Sheet 1."
- 2.5 TVA drawing 54N202 R1, "Radial Gates Structural Details – Sheet 2."
- 2.6 "Fort Patrick Henry Dam Spillway Discharge Tables," River Operations, Tennessee Valley Authority, March 1999, TVA EDMS accession no. L58081211803.
- 2.7 "Hydraulic Design Criteria," USACE (U. S. Army Engineer Waterways Experiment Station), Eighteenth Issue, Vicksburg, MS, 1988.
- 2.8 Handbook of Hydraulics, E. F. Brater and H. W. King, Sixth Ed., McGraw Hill, 1976.
- 2.9 "Hydraulic Design Criteria," USACE (U.S. Army Engineer Waterways Experiment Station), Eighteenth Issue, Vicksburg, MS, 1988, Hydraulic Design Chart 711 (HDC 711).
- 2.10 "Hydraulic Model Studies, Fort Patrick Henry Project," TVA Division of Water Control Planning Technical Monograph No. 87, TVA Research Library call no. 999.6278 T2985fo.
- 2.11 "Rating Curves for Flow over Drum Gates," Joseph N. Bradley, Paper No. 2677, Transactions of the American Society of Civil Engineers, vol. 119, pp. 403-433, 1954.
- 2.12 Open Channel Flow, Sec. 2.7, F. M. Henderson, Macmillan, New York, 1966.
- 2.13 Bellefonte Nuclear Plant FSAR, Units 1 and 2, Section 2.4.3.3, page 2.4-16.
- 2.14 TVA drawing 51N202 R3, "Concrete Blocks 12, 13 & 14 Outline."
- 2.15 TVA drawing 10N203 R5, "Principal Features of Design."
- 2.16 TVA drawing 46N401 R0, "Architectural Elevations Sheet 1."
- 2.17 TVA Fort Patrick Henry Project drawing 47K909 R0, "Powerhouse Generating Unit 1, Operating Characteristics of 33,000 KVA Generating Unit Based on Acceptance Test," Fort Patrick Henry Blue Book, page 23.
- 2.18 TVA Fort Patrick Henry Project drawing 47K910 R0, "Powerhouse Generating Unit 2, Operating Characteristics of 33,000 KVA Generating Unit Based on Acceptance Test," Fort Patrick Henry Blue Book, page 24.
- 2.19 Design of Small Dams, US Department of the Interior, Bureau of Reclamation, 2nd Edition 1973, Revised reprint 1977.
- 2.20 "Basis for Dam Spillway Gate/Outlet Open Configuration for Flood Analyses," Tennessee Valley Authority, May 29, 2009 (EDMS No. L58 090529 800)

TVA

Calculation No. CDQ000020080010	Rev: 1	Plant: GEN	Page: 9
Subject: Dam Rating Curve, Fort Patrick Henry	Prepared C.Grace		
	Checked A. Murr		

3.0 Assumptions & Methodology

The headwater rating curves developed in these calculations will be used in simulations of probable maximum flood events. Consequently, the rating curves have been calculated well above the normal operating range and several feet above the top of the dam.

3.1 Assumptions

- 3.1.1 Assumption: The tailwater rating curve provided as Attachment 1 accurately predicts the tailwater elevation for the range of discharge required for the headwater rating curve.

Technical Justification: The tailwater rating curve was generated by the TVA Flood Risk group. This tailwater rating curve is used by TVA during actual flood events as input for river management decisions and is the best available source of tailwater elevation data. In addition, the evaluation in Section 6.5 of this calculation demonstrates that the discharge for Fort Patrick Henry dam is not sensitive to the accuracy of the tailwater curve.

- 3.1.2 Assumption: All spillway gates will be set to the maximum openings specified in the spillway discharge tables.

Technical Justification: For technical justification, see Reference 2.20, "Basis for Dam Spillway Gate/Outlet Open Configuration for Flood Analyses."

- 3.1.3 Assumption: All spillway gates will remain operable in the closed position and in the maximum opened position as specified in the spillway discharge tables.

Technical Justification: The radial gates will remain operable in the maximum opened position based on the findings of the "Watts Bar Dam – Flood and Earthquake Analysis on Radial Spillway Gates" (Reference B1). Appendix B uses the same assumptions, methodology, and approach as the Watts Bar radial gate analysis to compare forces on the gates in a closed position with forces on the gates in the maximum open position to provide technical justification for the gates to remain operable in the maximum open position during a PMF.

3.2 Unverified Assumptions

None.

TVA

Calculation No. CDQ000020080010	Rev: 0	Plant: GEN	Page: 10
Subject: Dam Rating Curve, Fort Patrick Henry	Prepared G.A. Schohl		
	Checked J.B.Mauter		

3.3 Methodology -- Discharge Equations

Discharges past the dam are computed as either “free” discharge or “orifice” discharge. Free discharge refers to free surface overflow and is computed using a weir-type equation as follows (Reference 2.7 provides weir flow equations for overflow discharges):

$$Q_f = C_f L H_c^{1.5} \quad (1)$$

in which Q_f = free discharge (cfs), C_f = free discharge coefficient ($\text{ft}^{0.5}/\text{sec}$ -- may vary with HW), L = length of overflowing section (ft), H_c = head on crest (ft) = HW - Z_c , HW = headwater elevation (ft), and Z_c = top, or crest, elevation of overflowing section (ft). This equation need not be modified to account for tailwater submergence because the tailwater does not rise high enough to affect the free discharges computed for this headwater rating curve.

Flow over the nonoverflow section, the tops of the open spillway gates, and the tops of the spillway piers is treated as free discharge. Flow over the spillway crest is treated as free discharge for headwater elevations below $H_c = H_{L\min}$, the head at which the overflowing nappe first touches the bottoms of the open gates (see Attachment A5). $H_{L\min}$ varies with gate opening, V , defined as the vertical distance between the spillway crest and the bottom of the gate.

For headwater elevations above $H_c = H_{L\min}$ flow through the spillway gates is treated as orifice discharge. Orifice discharge refers to flow passing through a contracted opening and is computed using an orifice-type equation as follows (Reference 2.7, Hydraulic Design Chart 311-1):

$$Q_g = C_g G_n L \sqrt{2g(H_c - H_{mp})} \quad (2)$$

in which Q_g = orifice discharge (cfs), C_g = orifice discharge coefficient (dimensionless -- varies with gate opening and H_c), G_n = effective gate opening = minimum distance between the gate lip and the crest (ft), g = acceleration of gravity, and H_{mp} = vertical distance between the mid-point of G_n and the crest. This equation is modified, if required, to account for tailwater submergence as follows:

$$Q_{gs} = S_g Q_g \quad (3)$$

in which Q_{gs} = “corrected” orifice discharge (cfs) and S_g = tailwater submergence factor (dimensionless -- varies with d/H_c and gate opening, G_n).

Calculation No. CDQ000020080010	Rev: 0	Plant: GEN	Page: 11
Subject: Dam Rating Curve, Fort Patrick Henry	Prepared G.A. Schohl		
	Checked J.B.Mauter		

3.4 Methodology -- Spillway Discharge Calculations

The discharge coefficient, C_d , for free discharge over a spillway crest varies with head, H_c (References 2.7 and 2.8 both provide this kind of data). For the Fort Patrick Henry spillway crest, the relationships $H_{Lmin}(V)$ and $C_d(H_c)$ are available from model test data (Appendix A). The relationship between orifice discharge coefficient, C_g , and head, H_c , for various gate openings, V (up to $V = 25$ feet), is also available from the model test data. The crest length, L , and crest elevation, Z_c , are shown on TVA drawings (e.g., References 2.1 and 2.2). The parameters G_n and H_{mp} are determined from geometry (Appendix A).

The physical model used to measure spillway discharge included several bays and the piers between them. Consequently, pier contraction effects are implicitly included in the discharge coefficients derived from the model test data.

Under the assumption that all spillway gates are fully open, the two end bays (first and last) are the only spillway bays subject to end contraction effects. These effects, which may reduce discharge through these two bays by a few percent, are neglected in this calculation. Neglecting this minor effect has negligible impact on the dam rating curve.

3.5 Methodology -- Discharge Coefficients

Values of the discharge coefficient, C_d , for flows over the nonoverflow section, the tops of the open spillway gates, and the tops of the spillway piers, are estimated using Hydraulic Design Chart 711 (Reference 2.9). Length, L , and crest elevation, Z_c , in each case are determined from TVA drawings (all relevant drawings are defined as References).

The upper plot of HDC 711 (Reference 2.9) shows that C_d is about 2.65 for very broad crests ($H_1/B < 0.4$ where $H_1 = H_c$ and B = streamwise length of the crest) and gradually increases to 3.1, the maximum value for a "broad-crested" weir, as H_1/B increases to about 1.2. As H_1/B increases above 1.2, C_d continues to increase as the weir transitions from broad-crested to sharp-crested at about $H_1/B = 2.0$. Since the estimation of discharge over the top of various sections of a dam and its embankments is an approximation, small variations in C_d with H_c are not modeled and the effects of end contractions are neglected. A single representative value for C_d within the range of its variation is used for all headwater elevations included in the rating. Neglecting minor variations in C_d values and end contractions has negligible impact on the dam rating curve.

TVA

Calculation No. CDQ000020080010	Rev: 0	Plant: GEN	Page: 12
Subject: Dam Rating Curve, Fort Patrick Henry	Prepared J.V. Peyton		
	Checked J.B. Mauter		

4.0 Design Input

Sec	Input Parameter	Source	Symbol	Value
4.1	Acceleration of gravity			
		Common knowledge	g	32.2 ft/sec ²
4.2	Spillway crest parameters			
4.2.1	Crest length	Five 35-foot wide bays; Ref. 2.1	L	175 feet
4.2.2	Crest elevation	Attachment A7, page A24	Z_c	1228.0 feet
4.2.3	Free discharge coefficient	Polynomial fit to model data given in Attachment A10 and discussed in Appendix A	$C_f(H_c)$	Equation A3
4.3	Spillway gate parameters			
4.3.1	Vertical opening	Discussed in Appendix A	V	31.0 feet
4.3.2	Effective gate opening	Computed in Appendix A	G_n	31.54 feet
4.3.3	Mid-point elevation of opening relative to crest	Computed in Appendix A	H_{mp}	15.375 feet
4.3.4	Headwater elevation at which nappe touches gates	H_{Lmin} estimated in Appendix A and Attachment A9	$H_{Lmin} + Z_c$	1265.49 feet
4.3.5	Orifice discharge coefficient	Extrapolated curve given in Attachment A12 and Table A2 and discussed in Appendix A	$C_g(H_c)$	Interpolate between points in Table A2
4.4	Spillway gate overflow			
4.4.1	Overflow discharge coeff.	Calculations in Section 6.0, pages 22 -24	C_o	3.2
4.4.2	Overflow elevation	Computed in Appendix A	Z_o	1277 feet
4.4.3	Overflow length	Same as spillway crest, Ref. 2.1	L_o	175 feet
4.5	Powerhouse overflow			
4.5.1	Discharge coefficient	Calculation page 18	C_f	2.65
4.5.2	Overflow elevation	TVA drawing 46N401, Downstream Elevation	Z_c	1285 feet
4.5.3	Overflow length	TVA drawing 46N401, Downstream Elevation	L	151.5 feet
4.6	Spillway piers overflow			
4.6.1	Discharge coefficient	Calculation page 18	C_f	2.68
4.6.2	Overflow elevation	TVA drawing 10N203, G-G	Z_c	1272.42 feet
4.6.3	Overflow length	TVA drawing 10N203, Plan	L	39.0 feet
4.7	Nonoverflow Dam (B=12')			
4.7.1	Discharge coefficient	Calculation page 17	C_f	3.0
4.7.2	Overflow elevation	TVA drawing 10W201	Z_c	1270.0 feet
4.7.3	Overflow length	Calculation page 16	L	241.5 feet

TVA

Calculation No. CDQ000020080010	Rev: 0	Plant: GEN	Page: 13
Subject: Dam Rating Curve, Fort Patrick Henry	Prepared J.V. Peyton		
	Checked J.B. Mauter		

4.0 Design Input (Continued)

[illegible]

TVA

Calculation No. CDQ000020080010	Rev: 1	Plant: GEN	Page: 14
Subject: Dam Rating Curve, Fort Patrick Henry	Prepared C. Grace		
	Checked A. Murr		

5.0 Special Requirements/Limiting Conditions

Calculations performed in Appendix B demonstrate that the spillway gate PMF hydrostatic loads in the expected fully open position are comparable to the normal spillway gate design loads in the fully closed position. Although a detailed gate analysis could potentially demonstrate the capability of the gate to withstand higher headwater elevations, the applicability of this calculation is limited to headwater elevations no greater than 1288.0 feet, near the maximum expected headwater elevation for the PMF at the Fort Patrick Henry Dam. If PMF headwater elevations at the Fort Patrick Henry Dam exceed 1288.0 feet, a revision of this calculation will be required.

TVA

Calculation No. CDQ000020080010	Rev: 0	Plant: GEN	Page: 15
Subject: Dam Rating Curve, Fort Patrick Henry	Prepared J.V. Peyton		
	Checked J.B. Mauter		

6.0 Calculations

The calculations included in this section are overflow lengths, overflow parameters, configuration of spillway gates for the maximum open position, overflow parameter for the tainter spillway gates and tailwater submergence effect on discharge.


Dam Rating Curve

Fort Patrick Henry Page 16
CDQ000020080010

Computed By: JVPeyton 10-24-08 Checked By: JB Mauter

6.1 Overflow Lengths

Ref: TVA drawing 10W200

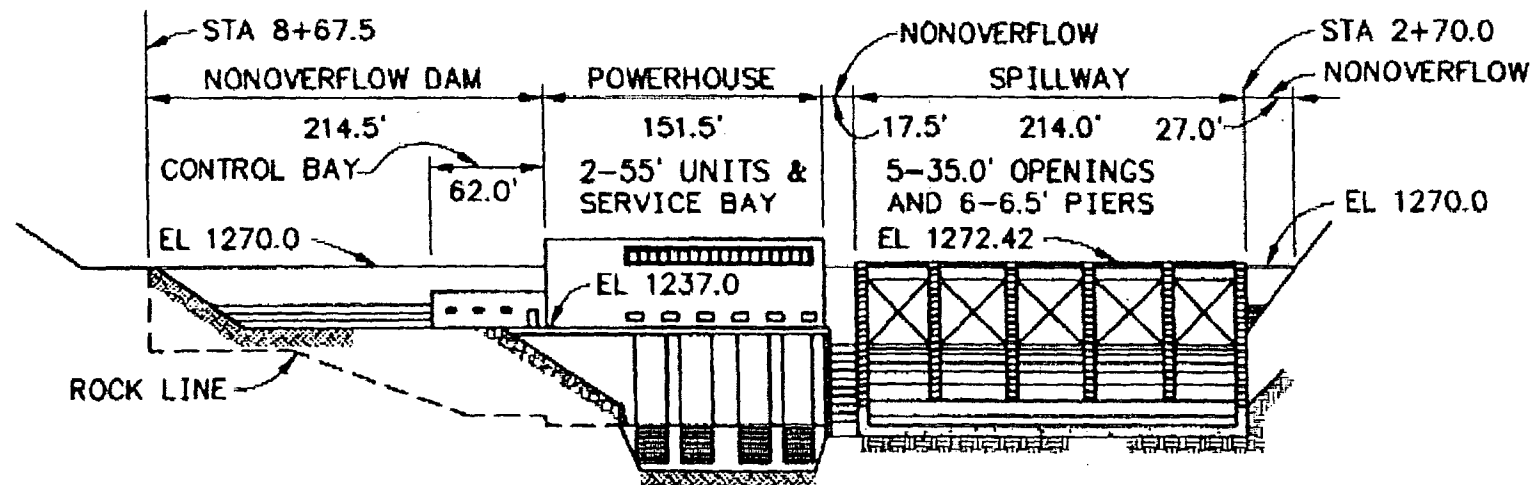

DOWNSTREAM ELEVATION

Lengths @ EL 1270

$$L_{\text{over}} (\text{Non overflow lengths shown above}) = 214.5' + 17.5' + 27.0' = 259'$$

$$L_{\text{over}} (B, \text{Width} = 12') = 214.5 + 27.0 = 241.5'$$

$$L_{\text{over}} (B, \text{Width} = 26.5') = 17.5'$$

Length @ Power House, EL 1285 (Top of Coping, Dwg 46N401)

$$L (\text{Powerhouse, shown above}) = 151.5'$$

SUBJECT Dam Rating CurvePROJECT Fort Patrick Henry

CDQ000020080010

COMPUTED BY JV PeytonDATE 10-24-08CHECKED BY JB Mauter

DATE

6.2 Overflow ParametersTop of Dam, E1270.0

Ref: Army Corp of Engineers, "Hydraulic Design Criteria,"
Eighteenth Issue, Hydraulic Design Chart 711.

$B = 12'$
See A-A & B-B.
TVA dwg 10W201
and the chart
on page 19.

$$\frac{H_1}{B} = \frac{0}{12'} = 0 \Rightarrow C_f \approx 2.65$$

$$\frac{H_1}{B} = \frac{(E1290^* - E1270)}{12'} = 1.67 \Rightarrow C_f \approx 3.35$$

$$\text{Use } C_f (\text{Average}) = \frac{2.65 + 3.35}{2} = 3.0$$

$B = 26.25'$
See E-E
TVA dwg 10W201
and the chart
on page 19.

$$\frac{H_1}{B} = \frac{0}{26.25'} = 0 \Rightarrow C_f \approx 2.65$$

$$\frac{H_1}{B} = \frac{(E1290^* - E1270)}{26.25'} = 0.76 \Rightarrow C_f \approx 2.82$$

$$\text{Use } C_f (\text{Average}) = \frac{2.65 + 2.82}{2} = 2.74$$

B - streamwise length of weir crest. See Section 3.4, page 11.

* Assumed. Maximum headwater elevation considered in this calculation.

SUBJECT Dam Rating CurvePROJECT Fort Patrick HenryCOMPUTED BY JN PeytonDATE 10-24-08CHECKED BY JB Mauter

CDQ000020080010

DATE

6.2 Overflow Parameters (Continued)Tops of Spillway Piers, El 1272.42

$$L = 6 \text{ piers @ } 6.5' \text{ wide} = 39'$$

$$\frac{H_1}{B} = \frac{0}{35'} = 0 \Rightarrow C_f \approx 2.65$$

$$\frac{H_1}{B} = \frac{El 1290^* - El 1272.42'}{35'} = \frac{17.58}{35'} = 0.50 \Rightarrow C_f \approx 2.70$$

$$\text{Use } C_f (\text{Average}) = \frac{2.65 + 2.70}{2} = 2.68$$

B - streamwise length of weir crest. See Section 3.4, page 11; F-F
TVA drawing 10W201 and page 19.

Powerhouse, El 1285.0

$$L = 151.5'$$

$$\frac{H_1}{B} = \frac{0}{59.5'} = 0 \Rightarrow C_f \approx 2.65$$

$$\frac{H_1}{B} = \frac{El 1290^* - El 1285}{59.5'} = 0.08 \approx 0 \Rightarrow C_f = 2.65$$

$$\text{Use } C_f = 2.65$$

B - streamwise length of weir crest. See Section 3.4, page 11;
C-C, TVA drawing 10W201 and page 19.

* Assumed. Maximum headwater elevation considered in this calculation.

Dam Rating Curve

Computed By: JV Peyton 10-24-08


CDQ000020080010

Fort Patrick Henry

Page 19

Checked By: JB Mauter

6.2 Over flow Parameters (Continued)

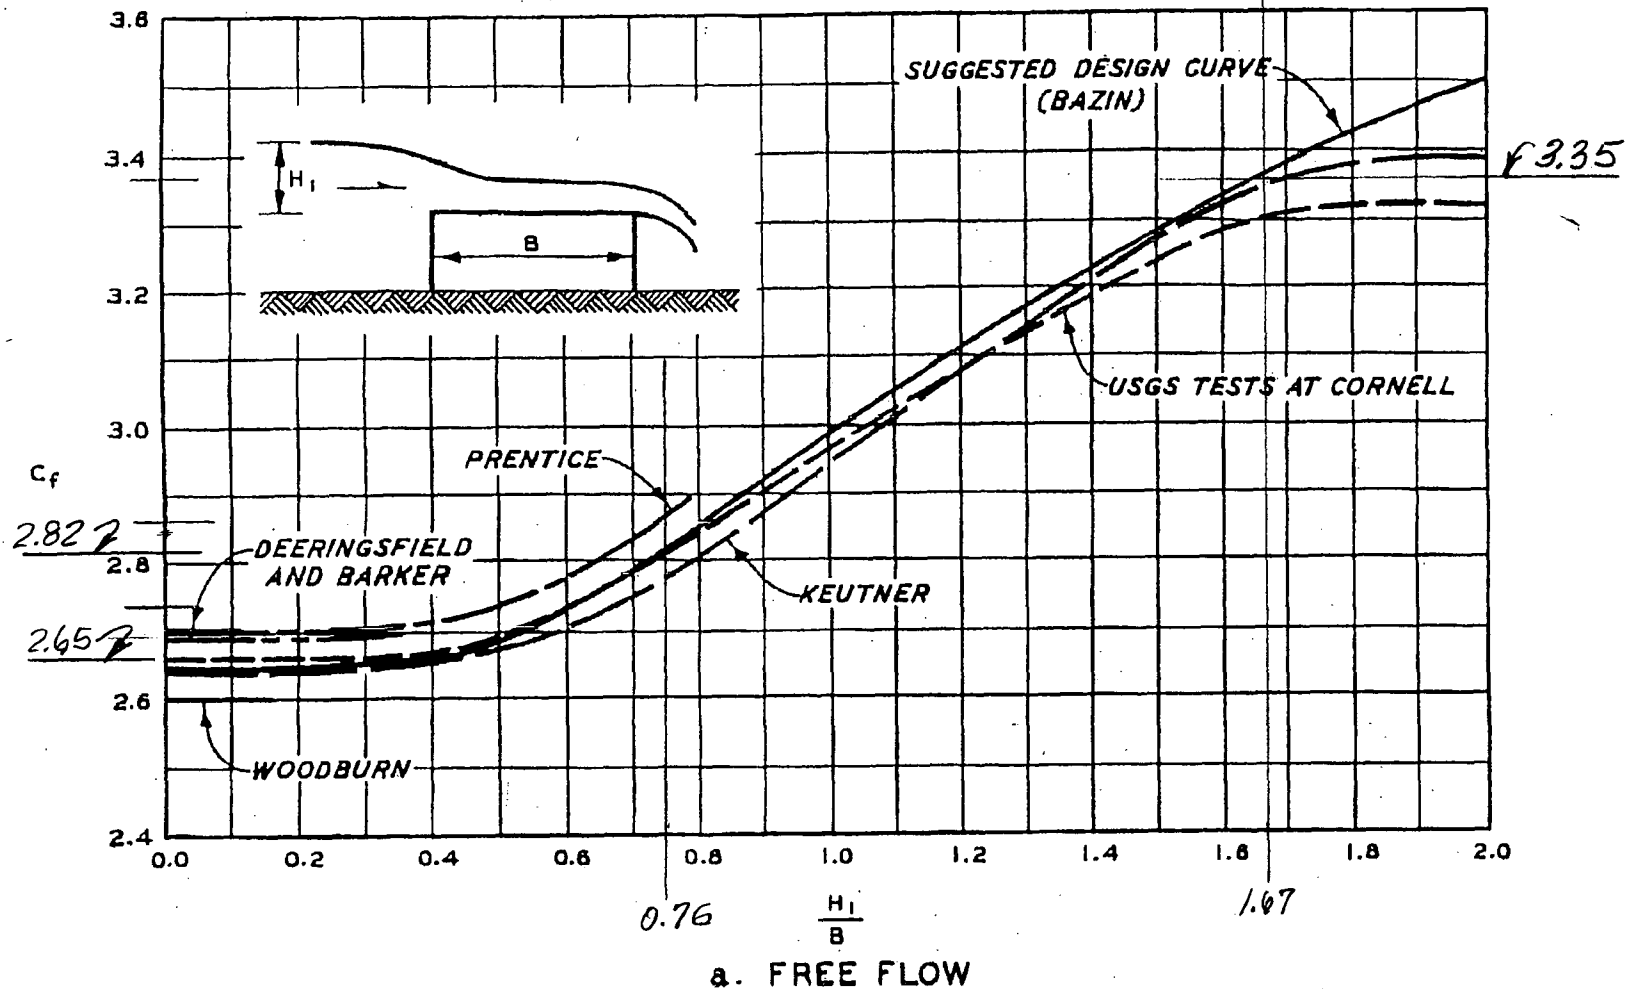

Ref: Army Corp of Engineers, "Hydraulic Design Criteria",
18th Issue, Design Chart 711.

SUBJECT Dam Rating CurvePROJECT Fort Patrick Henry

CDQ000020080010

COMPUTED BY JV PeytonDATE 10-24-08CHECKED BY JB Mauter

DATE

6.3 Configuration of Spillway Gates - Maximum Open

Ref: TVA drawings 54N200 R1 & 54N201 R1

The elevation of the top edge of the gate is determined using AUTOCAD.

The angles calculated below are used to plot the gate in the closed position. The gate is rotated so that the vertical distance from the spillway crest to the bottom edge of the gate is 31'; the maximum the gate is opened.

$$Q_1 \text{ (Angle from bottom edge to } \angle \text{ lower arms)} = \frac{180L}{\pi r} = \frac{180(3'-0\frac{1}{8}")}{\pi(36')} = 4.7912^\circ$$

$$Q_2 \text{ (Angle between } \angle \text{ lower \& upper arms)} = \frac{180L}{\pi r} = \frac{180[(9'-9\frac{5}{16}") + (1'-2") + (8'-7")]}{\pi(36')} \\ = \frac{180(19.5260')}{\pi(36')} = 31.0766^\circ$$

$$Q_3 \text{ (Angle from } \angle \text{ upper arm to top edge)} = \frac{180L}{\pi r} = \frac{180[(10'-0\frac{7}{8}") + (5'-0\frac{1}{8}")]}{\pi(36')} \\ = \frac{180(15.0833')}{\pi(36')} = 24.0058^\circ$$


Total arc length of gate skin;

$$L = (3'-0\frac{1}{8}") + (9'-9\frac{5}{16}") + (1'-2") + (8'-7") + (10'-0\frac{7}{8}") + (5'-0\frac{1}{8}") = 37'-7\frac{7}{16}"$$


$$Q = \frac{180L}{\pi r} = \frac{180(37'-7\frac{7}{16}")}{\pi(36')} = \frac{180(37.6198')}{\pi(36')} = 59.8738^\circ$$

$$Q = 4.7912^\circ + 31.0766^\circ + 24.0058^\circ = 59.8736^\circ$$

6.3 Configuration of Spillway Gates - Maximum Open (Continued)

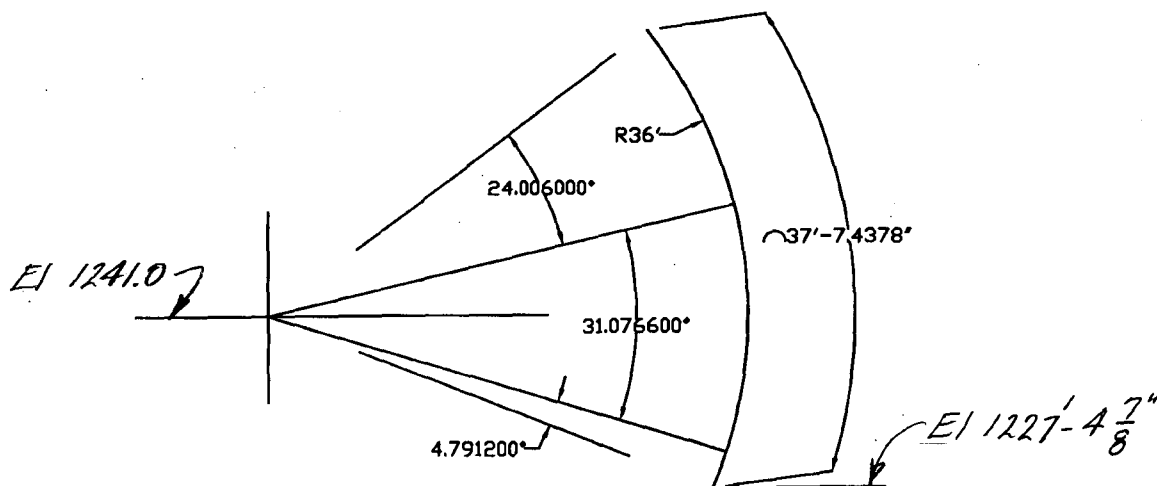

Gate Closed

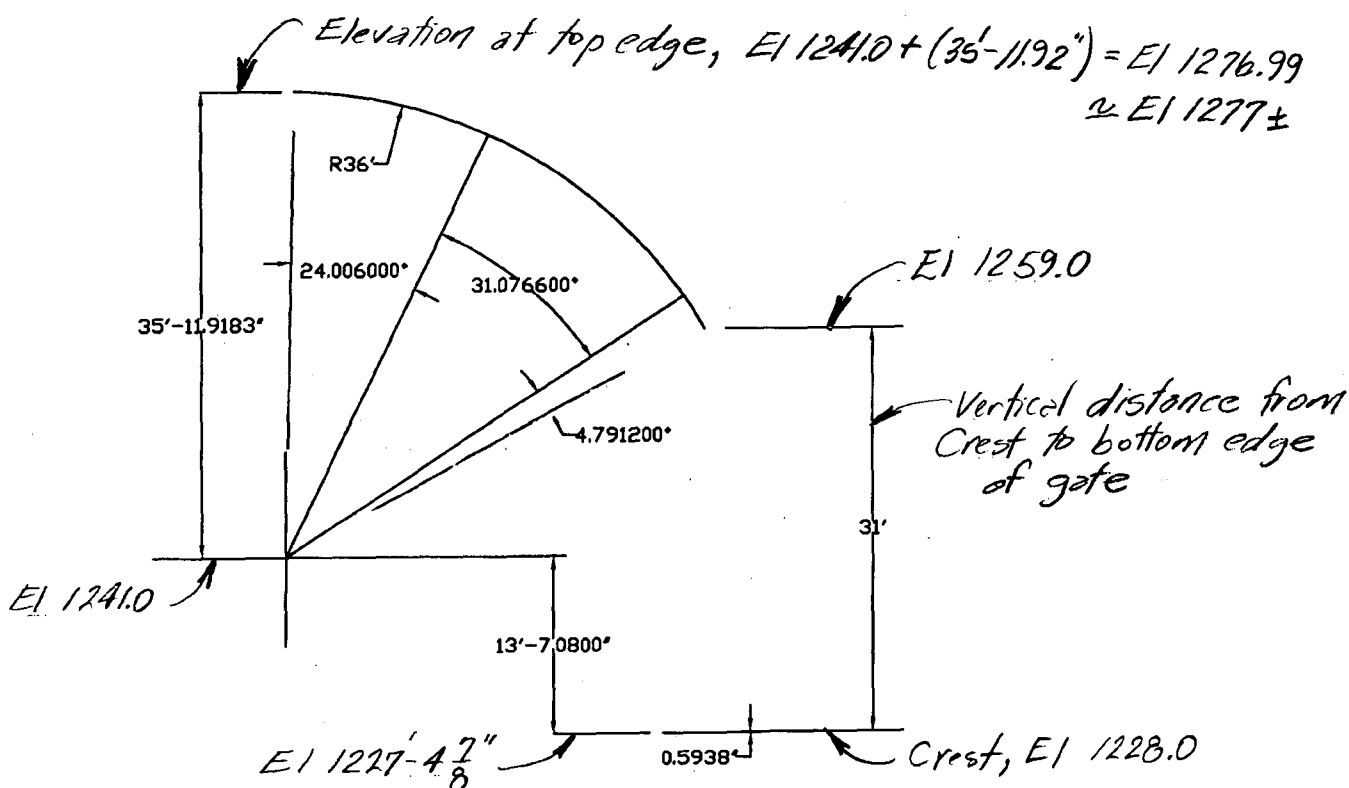

Max Gate Open

SUBJECT Dam Rating Curve PROJECT Fort Patrick HenryCOMPUTED BY JV PeytonDATE 10-30-08CHECKED BY JB Mauter

DATE

CDQ 000020080010

6.4 Overflow Parameter For Tainter Spillway Gate

Ref: 1. "Rating Curves for Flow Over Drum Gates," Joseph N. Bradley, Paper No. 2677, Transactions of the American Society of Civil Engineers, Vol. 119, pp. 403-433, 1954.

2. Attachment A6

3. TVA drawing 54N201 R1

* Determining Z_1 from 54N200 R1 A-A yields a slightly different result (Appendix A, page A3):
 $Z_1 = E11241.0 - (E11227 - 4\frac{5}{8})$
 $= 13' - 7\frac{1}{8}"$
 $Z_1 = 13.5937'$

Angle Subtended By Edges of Gate

$$\theta = \sin^{-1}\left(\frac{Z_2}{R}\right) + \sin^{-1}\left(\frac{Z_1}{R}\right)$$

$$Z_1 = (2'-10") + (9'-7\frac{5}{16}") + (1'-2") = 13' - 7\frac{5}{16}" = 13.6094' *$$

$$Z_2 = (8'-6") + (9'-4") + (4'-2") = 22'-0" = 22.0000'$$

$$\theta = \sin^{-1}\left(\frac{22.0'}{36.0'}\right) + \sin^{-1}\left(\frac{13.6094'}{36.0'}\right) = 37.6699^\circ + 22.2123^\circ = 59.8821^\circ$$

Angle From Horizontal Line Through Trunnion To Bottom Edge

$$\alpha = \sin^{-1}\left(\frac{Z}{R}\right) = \sin^{-1}\left(\frac{E11259.0 - E11241.0}{36'}\right) = \sin^{-1}\left(\frac{18'}{36'}\right)$$

$$\alpha = 30.0^\circ$$

Angle ϕ

$$y_0 = E11276.99' - E11241.0 = 35.99'$$

$$x_0 = R \cos(\theta - \alpha) = 36' \cos[59.8821^\circ - (-30.0^\circ)] = 0.0741'$$

$$\phi = \tan^{-1}\left(\frac{x_0}{y_0}\right) = \tan^{-1}\left(\frac{0.0741'}{35.99'}\right) = 0.12^\circ \approx 0.0$$

SUBJECT Dam Rating CurvePROJECT Fort Patrick Henry

CDQ000020080010

COMPUTED BY JV PeytonDATE 10-31-08CHECKED BY JB Mauter

DATE


6.4 Overflow Parameter For Tainter Spillway Gate (Continued)

The overflow parameters for flow depth over the gate, $0 \leq H \leq 13'$ (EI 1290 - EI 1277) are taken from Figure 6 of "Rating Curves for Flow Over Drum Gates." See the following page.

Minimum flow; $\frac{H}{r} = 0 \Rightarrow C_g = 3.0 \pm$

Maximum flow; $\frac{H}{r} = \frac{13'}{36'} = 0.36 \Rightarrow 3.59 \pm$

Use $C_g = C_0 = 3.2$

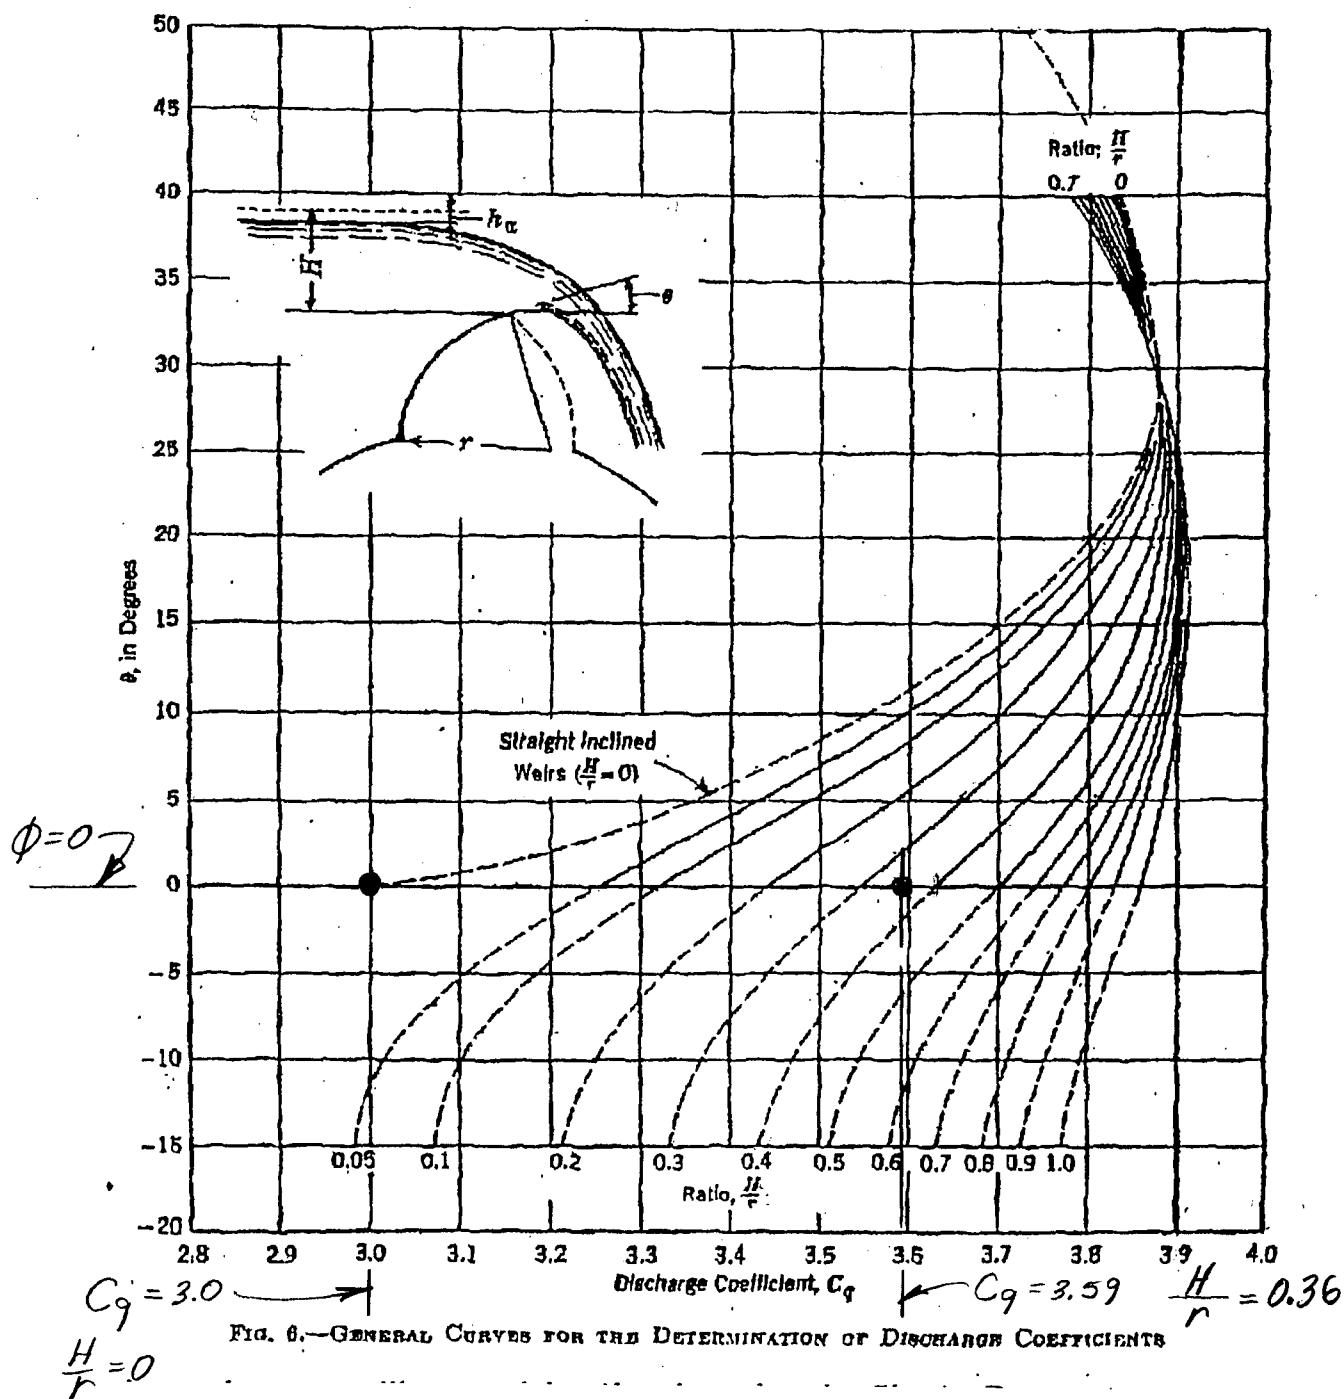

TVA

Calculation No. CDQ000020080010	Rev: 1	Plant: GEN	Page: 25
Subject: Dam Rating Curve, Fort Patrick Henry	Prepared C. Grace		
	Checked A. Murr		

6.5 Tailwater Submergence Effect on Discharge

The effect of the tailwater submergence on the discharge is evaluated using Attachments 1, "Fort Patrick Henry Tailwater Rating," and Attachment 2, "Figure 252, Effects of downstream influences on flow over weir crests." Attachment 2 is from "Design of Small Dams," US Department of the Interior, Bureau of Reclamation, 2nd edition 1973, revised reprint 1977, page 380 (Reference 2.19). "Design of Small Dams" was published to provide safe practices for the design of small dams and is an industry accepted reference.

The maximum headwater elevation considered in this calculation is El 1290. The discharge calculated for headwater El 1290 is 325,290 cfs, Table 7.1 and Figure 7.1. Although the headwater rating curve provided in this calculation extends to the elevations noted, Section 5.0 of this calculation limits the applicability of this curve to the headwater elevation defined in Section 5.0.

From Attachment 1, Fort Patrick Henry Tailwater Rating, the tailwater elevation for the maximum discharge (325,290 cfs) is El 1258. This elevation is lower than the elevation of the top of the nonoverflow sections of the dam (El 1270), the elevation of the tops of the spillway piers (El 1272.42), the elevation of the top of the spillway gates when fully open (El 1277) and the elevation of the top of the powerhouse (El 1285). Therefore discharge over these features is not affected by the tailwater at El 1258.

The vertical distance from the crest to the downstream apron and the depth of flow in the downstream channel, as it relates to the headwater level, are the submergence factors identified in "Design of Small Dams," page 376, which alter the coefficient of discharge. The percent decrease in coefficient of discharge is estimated using Attachment 2 (Figure 252) as follows:

$$H_e = \text{Headwater elevation minus crest elevation} = 1290 - 1228 = 62'$$

$$h_d = \text{Headwater elevation minus tailwater elevation} = 1290 - 1258 = 32'$$

$$d = \text{Depth of tailwater above apron} = 1258 - 1182.5 = 75.5'$$

The elevation of the apron, 1182.5, is shown by drawing 51N202 R3, Sections A-A & A1-A1 (Attachment A17).

The degree of submergence is:

$$(h_d / H_e) = (32' / 62') = 0.52.$$

The position of downstream apron is:

$$[(h_d + d) / H_e] = [(32' + 75.5') / 62'] = 1.73.$$

These ratios, degree of submergence and position of downstream apron, are plotted on Attachment 2. The decrease in coefficient of discharge shown is approximately 0.5 %. This is not a significant reduction and is neglected.

TVA

Calculation No. CDQ000020080010	Rev: 0	Plant: GEN	Page: 25.1
Subject: Dam Rating Curve, Fort Patrick Henry	Prepared J.V. Peyton		
	Checked J.B. Mauter		

6.6 Turbine Discharge

The turbine generators are assumed to operate until the tailwater reaches Elevation 1237, the elevation of the switchyard and the elevation of the doorways to the powerhouse. References 2.17 and 2.18 provide the turbine discharge based on the gross head for the dam. The gross head is the difference between the headwater elevation and the tailwater elevation. The lowest gross head shown on References 2.17 and 2.18 is 55 feet. The turbine discharge for lower values of gross head is determined by extrapolation. The following table summarizes the iterative steps to determine the turbine discharge for a range of headwater values.

HW	Spillway Discharge cfs	Estimated Turbine Discharge cfs	Estimated Total Discharge cfs	TW	Gross Head	Turbine Discharge For 33' Gross Head	Total Discharge cfs
1240	24837	9000	34000	1208	32	8000	32837
1250	65686	9000	75000	1217	33	8000	73686
1260	121847	9000	131000	1227	33	8000	129847
1270	164558	9000	174000	1237	33	8000	172558

The iteration to determine the turbine discharge is as follows:

1. The spillway discharge for the headwater elevations 1240, 1250, 1260 and 1270 are taken from Table 7.1, page 27.
2. The tailwater elevations for headwater elevations 1240, 1250, 1260 and 1270 are determined from Attachment 1-1, the tailwater rating curve, for the Estimated Total Discharge.
3. The gross head (HW-TW) for the headwater elevations 1240, 1250, 1260 and 1270 are calculated. A gross head of 33' is used to estimate the turbine discharge for all the elevations.
4. The turbine discharge for 33' gross head is taken from drawings 47K909 R0 and 47K910 R0, references 2.17 and 2.18.
5. Finally, the total discharge is the sum of the spillway discharge and the turbine discharge for 33' gross head.

The gross head of 33' for all headwater elevations and the rounding of the turbine discharge don't significantly affect the result since the turbine discharge is a small percentage of the total discharge expected.


The turbine discharge continues until the tailwater reaches elevation 1237, the elevation at which the switchyard and powerhouse are flooded. Once stopped, the turbines are not expected to be restarted immediately when the tailwater drops below elevation 1237. Due to flooding of the powerhouse and switchyard the turbines may not operate for several days. To consider both rising and falling headwater, Table 7.1 lists the total discharge for the dam including turbine discharge and the total discharge for the dam without turbine discharge. Figure 7.1 is the rating curve including turbine discharge and Figure 7.2 is the rating curve without turbine discharge included.

Calculation No. CDQ0000200810

Prepared: JVPeyton 12-2-08

Checked: JBMauter


606XLT M ZE

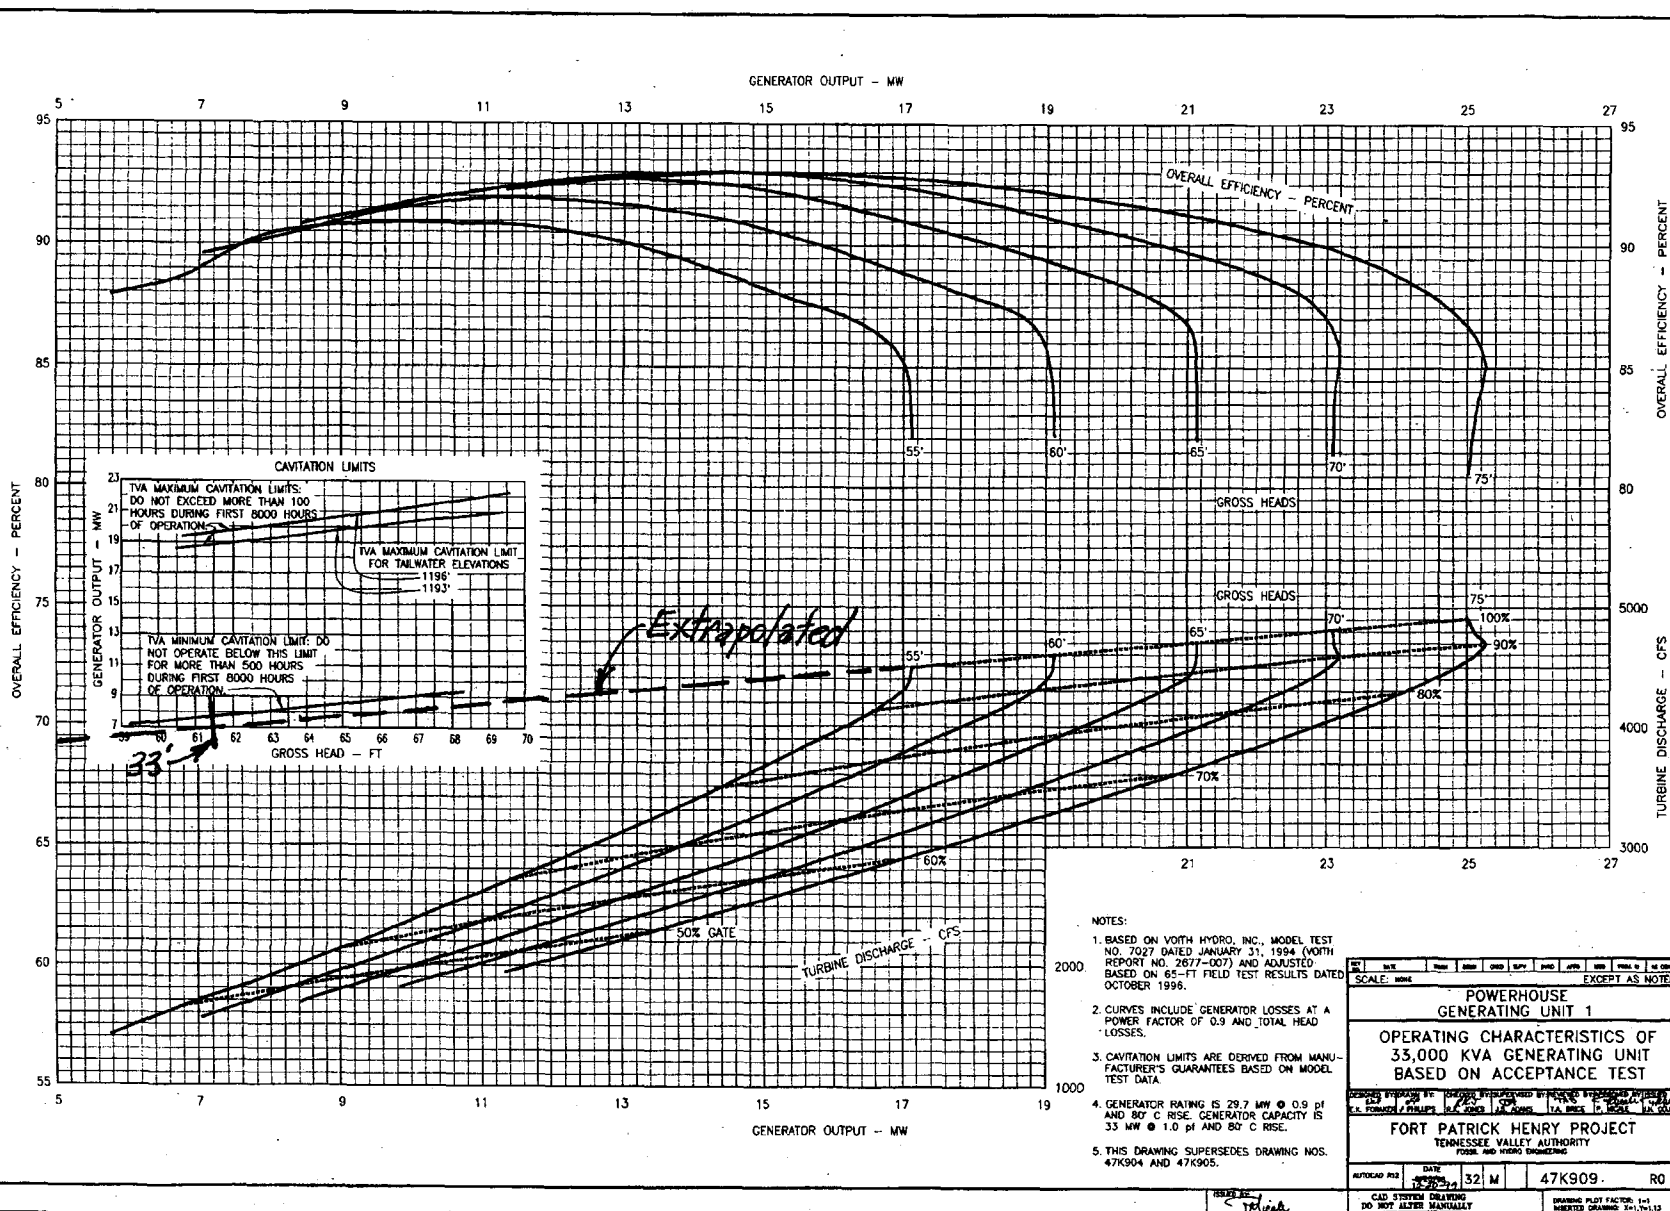

Calculation No. CDQ000020080010

Prepared: JV Peyton 12-2-08

Checked: JB Mauter

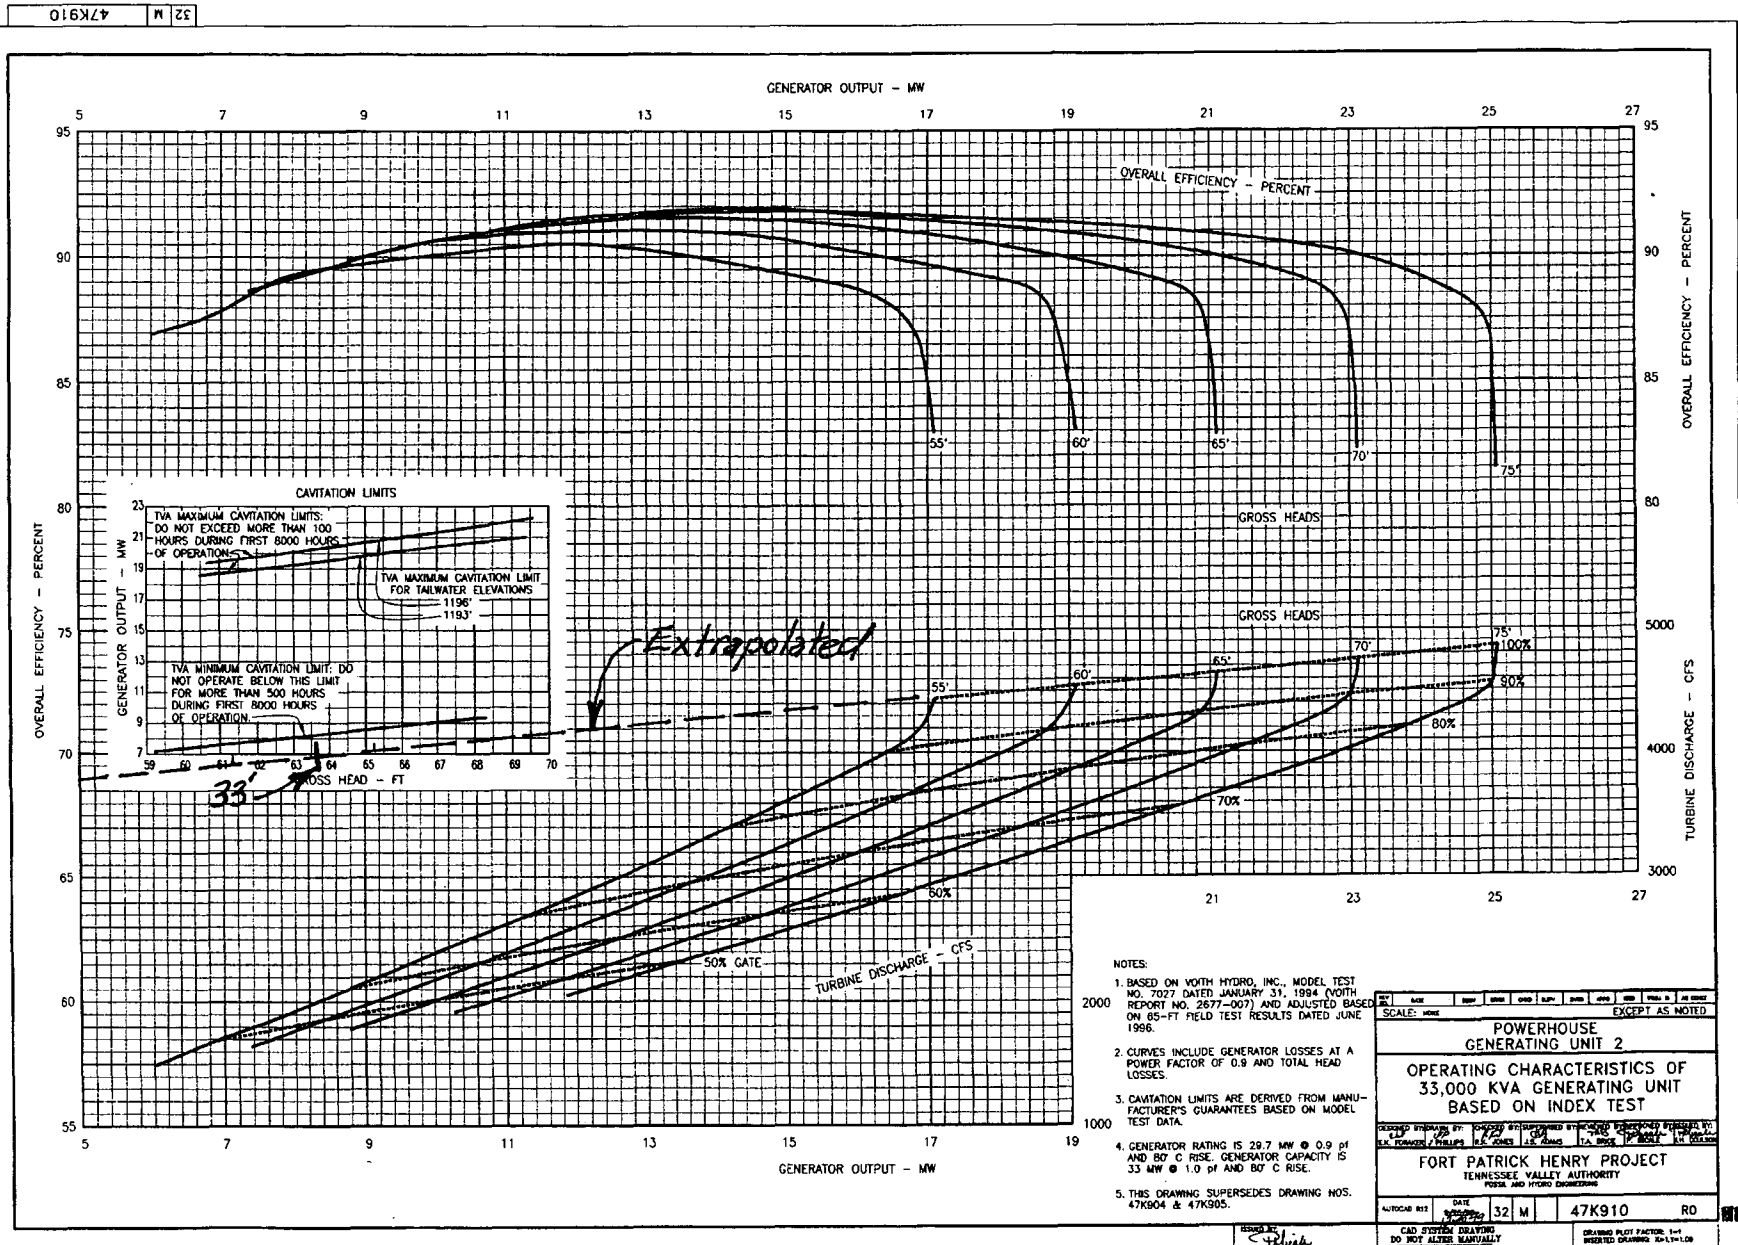

TVA

Calculation No. CDQ000020080010	Rev: 1	Plant: GEN	Page: 26
Subject: Dam Rating Curve, Fort Patrick Henry	Prepared C. Grace		
	Checked A. Murr		

7.0 Results/Conclusions

The headwater rating results are tabulated as total discharge in cubic feet per second (cfs) vs. headwater elevation in feet in Table 7.1. The headwater rating curve is plotted in Figure 7.1 and Figure 7.2.

As discussed in Section 5.0, the dam (headwater) rating curves provided in Figures 7.1 and 7.2 and tabulated in Table 7.1 are limited in applicability to headwater elevations no greater than 1288.0 feet.

TVA

Calculation No. CDQ000020080010	Rev: 0	Plant: GEN	Page 27
Subject: Dam Rating Curve, Fort Patrick Henry	Prepared: J.V. Peyton		
	Checked: J.B. Mauter		

Table 7.1

For $0 \leq H_c \leq 37.49$: $C_t = 2.8 + 0.08548H_c - 0.003963H_c^2 + 0.0001039H_c^3 - 0.0000009857H_c^4$


Dam Rating Curve

For $38 \leq H_c \leq 62$: C_g is given by Attachments A11 and A12.

g = 32.2		ft/s ²		Spillway Parameters			Overtopping Flows						Turbine Discharge
				L = 175 feet			Spillway		Nonover		Nonover		
				Z _c = 1228 feet			Gate		P-house		B=12		
				G _n = 31.540 feet							B=26.25		
				H _{mp} = 15.375 feet							Pier		


Calculation No. CDQ000020080010	Rev: 0	Plant: GEN	Page: 28
Subject: Dam Rating Curve, Fort Patrick Henry	Prepared J.V. Peyton		
	Checked J.B. Mauter		

Figure 7.1
Fort Patrick Henry Rating Curve
Including Turbine Discharge

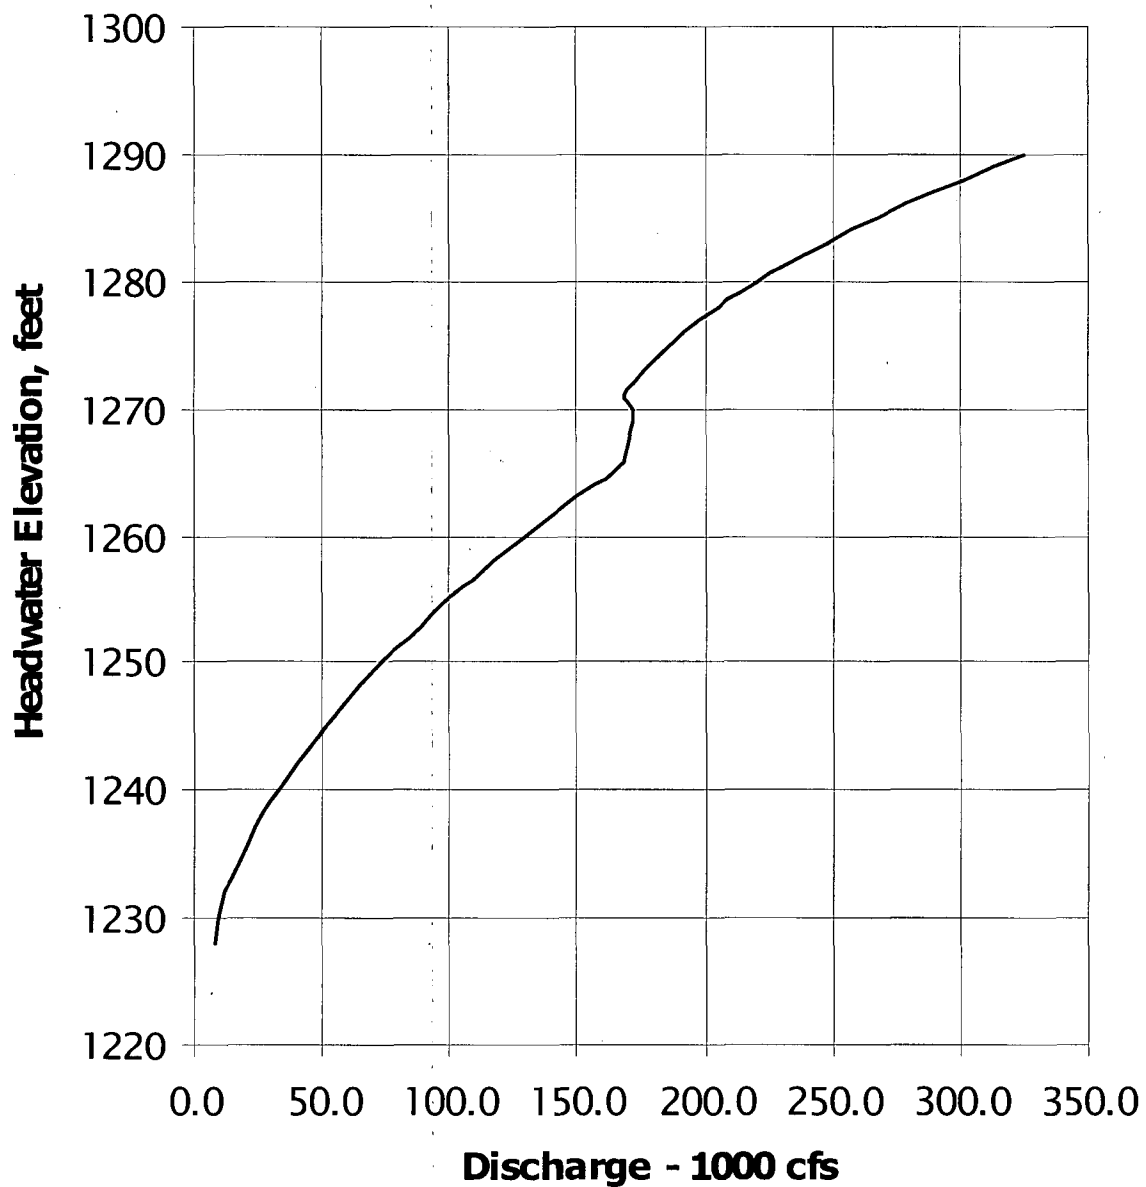

Calculation No. CDQ000020080010	Rev: 0	Plant: GEN	Page: 28.1
Subject: Dam Rating Curve, Fort Patrick Henry	Prepared J.V. Peyton		
	Checked J.B. Mauter		

Figure 7.2
Fort Patrick Henry Rating Curve
Without Turbine Discharge

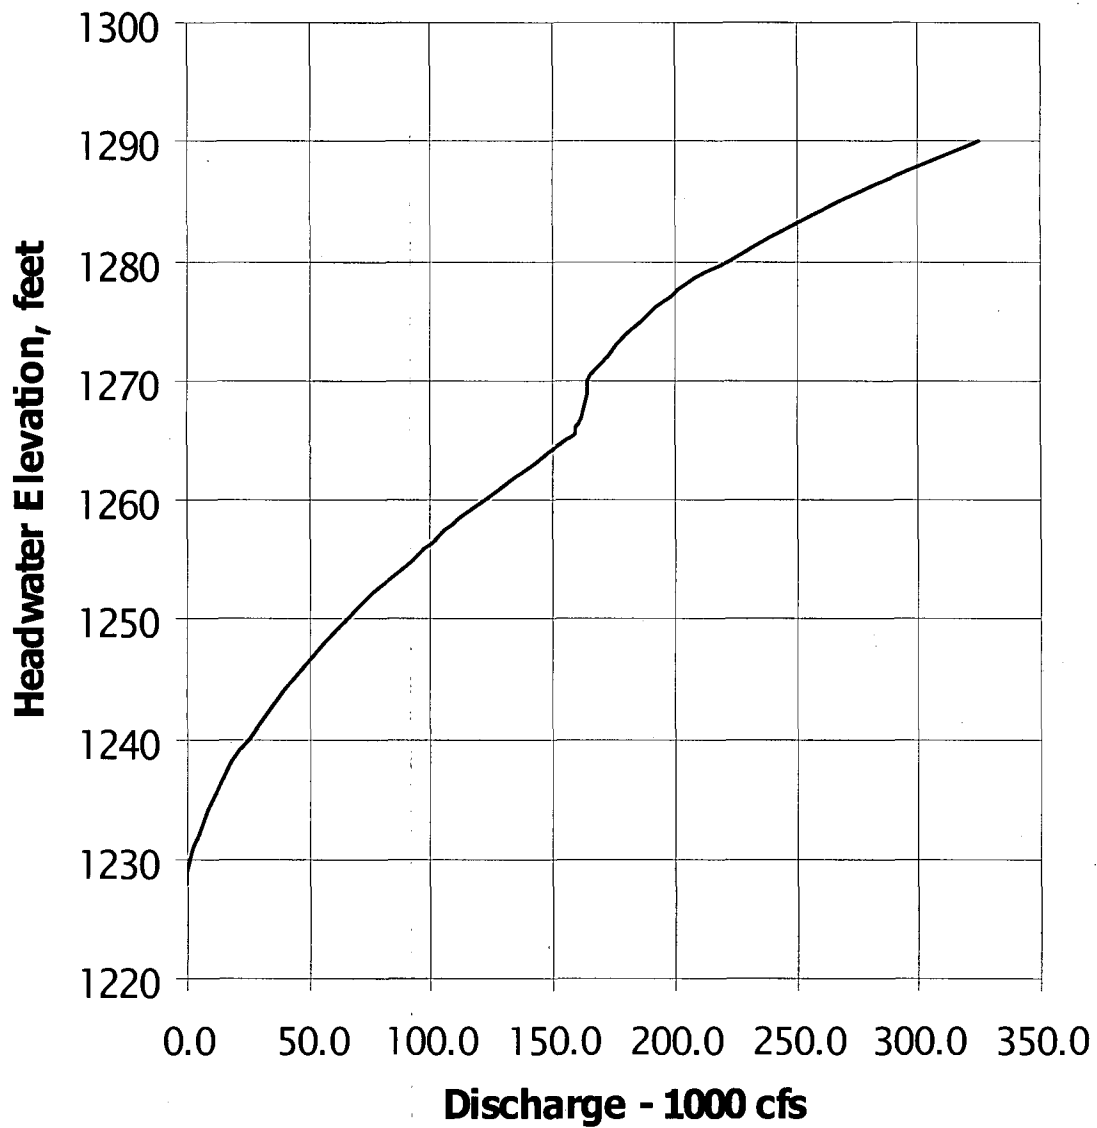


TVA

Calculation No. CDQ000020080010	Rev: 0	Plant: GEN	Page: 29
Subject: Dam Rating Curve, Fort Patrick Henry	Prepared J.V. Peyton		
	Checked J.B. Mauter		

Attachments

Fort Patrick Henry Tailwater Rating

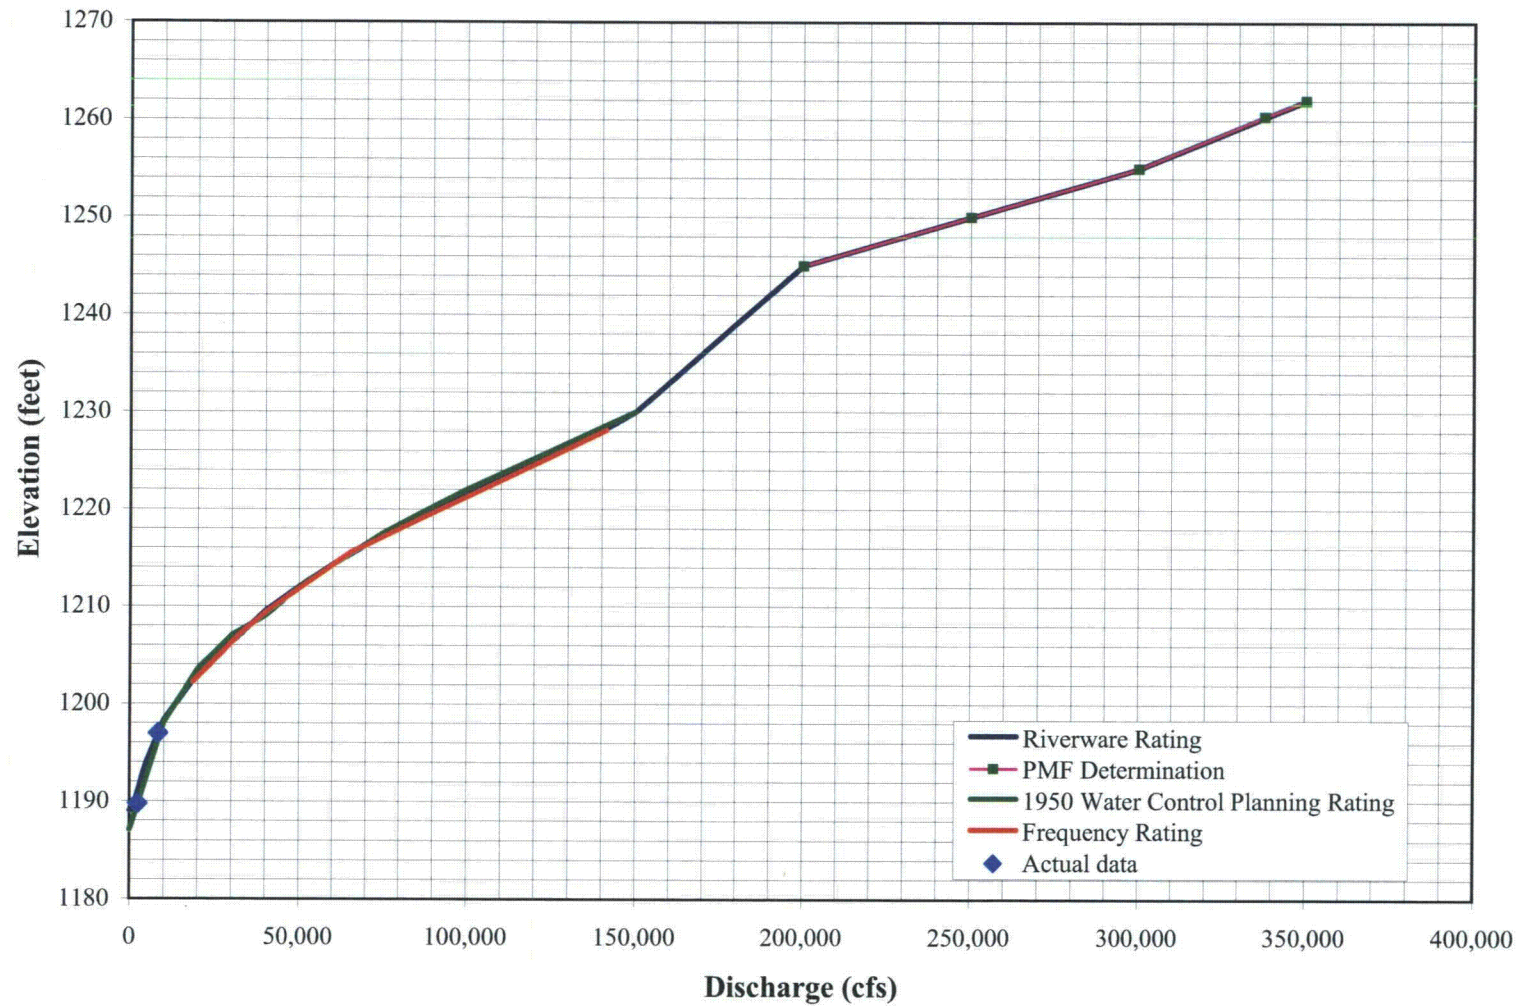

Fort Patrick Henry Tailwater Rating

<u>Q*1000</u>	<u>Q</u>	<u>Elevation</u>
0	0	1189
0.8	800	1189
4	4,000	1193
5	5,000	1194
10	10,000	1198.25
20	20,000	1203
30	30,000	1206.25
40	40,000	1209.5
50	50,000	1212
60	60,000	1214.25
70	70,000	1216.25
80	80,000	1218.2
90	90,000	1220
100	100,000	1221.8
110	110,000	1223.4
120	120,000	1225
130	130,000	1226.5
140	140,000	1228
150	150,000	1230
200	200,000	1245
250	250,000	1250
300	300,000	1255
350	350,000	1262

Water Control Planning 1950

<u>Dicharge</u>	<u>Elevation</u>
0	1187
10,000	1198
20,000	1203.5
30,000	1207
40,000	1209
50,000	1212
75,000	1217.5
100,000	1222
125,000	1226
150,000	1230


Frequency Floods

<u>Dicharge</u>	<u>Elevation</u>	<u>Freq</u>
18,600	1202.20	10
33,000	1207.30	50
41,000	1209.60	100
65,500	1215.50	500
141,400	1228.1	MPF
200,000	1245	
250,000	1250	
300,000	1255	
337,800	1260.36	PMF
350,000	1262	

Actual data

2400 1189.7

8400 1196.9

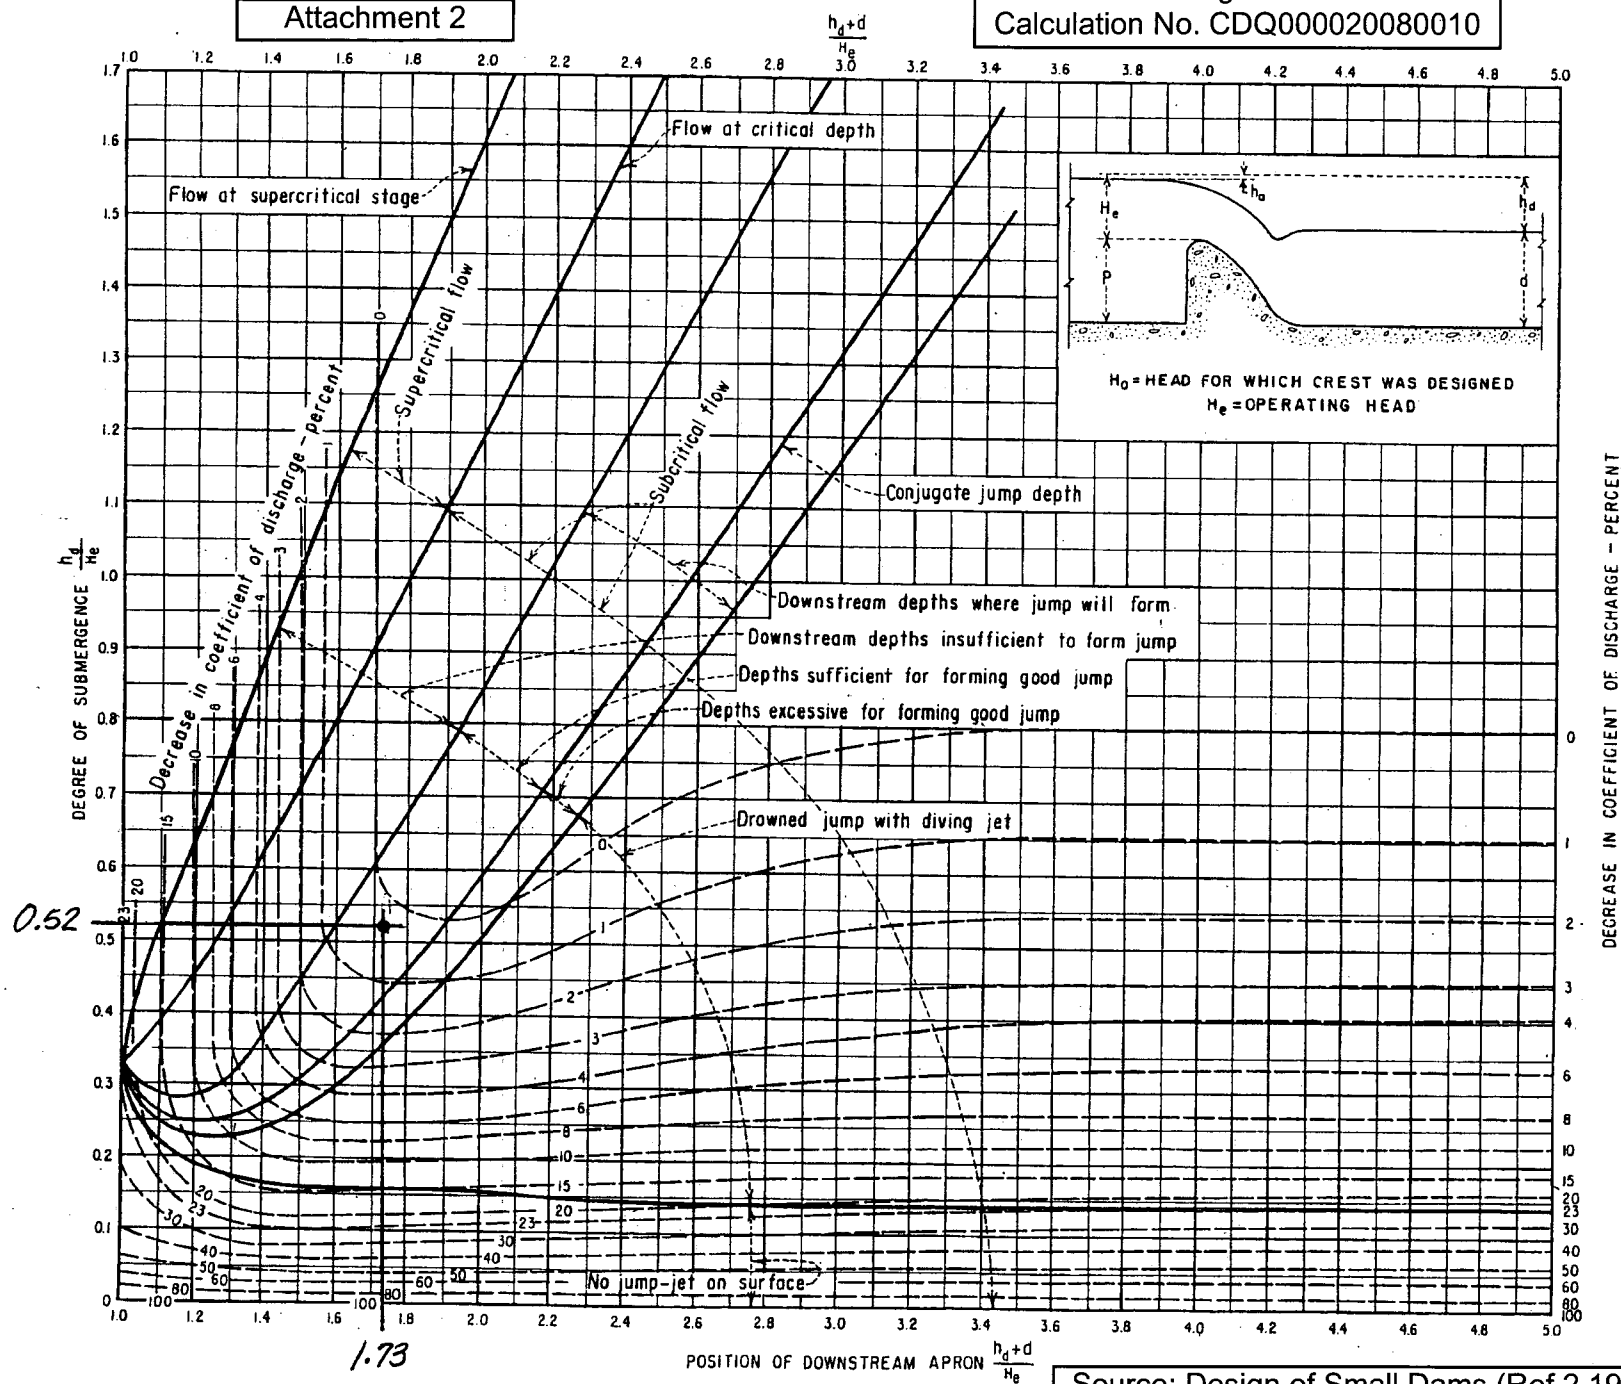

Source: Design of Small Dams (Ref 2.19), page 380

Figure 252. Effects of downstream influences on flow over weir crests. 288-D-2412.

TVA

Calculation No. CDQ000020080010	Rev: 0	Plant: GEN	Page: A1
Subject: Dam Rating Curve, Fort Patrick Henry	Prepared J.V. Peyton		
	Checked J.B. Mauter		

Appendix A

TVA

Calculation No. CDQ000020080010 Appendix A	Rev: 0	Plant: GEN	Page: A2
Subject: Dam Rating Curves, Fort Patrick Henry	Prepared G.A. Schohl		
	Checked J.B. Mauter		

Appendix A: Spillway Discharge Coefficients and Submergence Factors for Fort Patrick Henry Dam from 1:15 and 1:112.5 Scale Model Test Data

TVA has model test data describing the relationships between discharge, headwater, tailwater, and gate opening for most of its spillways. These data, which are the basis for the spillway discharge tables developed for each dam, are used in the headwater rating curve calculations. Use of reference book discharge coefficients for standard crests would result in inferior results because TVA's spillway crests are not standard.

Fort Patrick Henry Dam has five spillway bays, each controlled by a radial (tainter) gate as illustrated in Attachment A1. For headwater rating curve calculations the gates are assumed to be open to their maximum open position as specified in the Spillway Gate Arrangements table in Reference A1 and included as Attachment A2. As shown in this table, the maximum opening corresponds to reading "31" on the gate position indicators for the spillway. As referred to in Attachment A3 (from Reference A2), the indicating dials for the spillway gates at Fort Patrick Henry were specially fabricated to indicate actual vertical opening in feet. Thus, the vertical distance, V, between the bottom lip of a raised spillway gate and the spillway crest is 31 feet for gate position indicator reading "31."

Reference A3 is a comprehensive report on the hydraulic model studies conducted for Fort Patrick Henry Dam. Attachment A4 is a copy of Chapter 8, "Spillway Operations" from that report. Test data from a 1:112.5 scale model were taken to establish the free discharge rating for the spillway crest. Test data from a 1:15 scale model were taken to establish the orifice discharge rating parameters for different gate openings. Data were collected for twelve different gate openings varying from V = 0.5 feet to V = 25 feet. Data were not collected for gate openings as large as V = 31 feet, however, because under normal operating conditions the overflowing nappe will never touch the bottom of a gate open this far. But under the PMF conditions considered for the headwater rating curves the nappe will touch the gate in this position. Consequently, the data for gate openings V = 25, 21, 17, 13, and 10 feet are used here to estimate orifice flow discharge characteristics for V = 31 feet.

A.1 References

- A1. "Fort Patrick Henry Dam Spillway Discharge Tables," River Operations, Tennessee Valley Authority, March, 1999, EDMS Accession No. L58081211803.
- A2. TVA Files, binder "Fort Patrick Henry, Spillway Rating, Model Scales - 1:112.5 & 1:50.
- A3. "Fort Patrick Henry Project Hydraulic Model Studies, Tennessee Valley Authority, Technical Monograph No. 87, Knoxville, Tennessee, 1960, TVA Research Library call no. 999.6278 T2985fo.
- A4. "Hydraulic Design Criteria," USACE (U. S. Army Engineer Waterways Experiment Station), Eighteenth issue, Vicksburg, MS, 1988
- A5. TVA drawing no: 54N200, R1 (Attachment A7 and Electronic Attachment A16)
- A6. TVA drawing no: 51N202, R3 (Attachments A8 and Electronic Attachment A17)

A.2 Discharge Equations

Attachment A5 is a definition sketch for flow over the Fort Patrick Henry Dam spillway. Free discharge occurs for headwater elevations below the elevation at which the overflowing nappe first touches the bottom lip of the gate, or $H_c \leq H_{Lmin}$, and is computed using a weir equation (e.g., Reference A4, Sheet 711):

$$Q_f = C_f L H_c^{1.5} \quad (A1)$$

in which Q_f = free discharge (cfs), C_f = free discharge coefficient ($\text{ft}^{0.5}/\text{s}$ -- varies with H_c), L = length of overflowing section (ft), H_c = head on crest (ft) = $HW - Z_c$, HW = headwater elevation (ft), and Z_c = top, or crest, elevation of overflowing section (ft).

TVA

Calculation No. CDQ000020080010 Appendix A	Rev: 0	Plant: GEN	Page: A3
Subject: Dam Rating Curves, Fort Patrick Henry		Prepared G.A. Schohl	
		Checked J.B. Mauter	

For headwater elevations above the elevation at which the nappe touches the gate lip, or $H_c > H_{Lmin}$, orifice flow occurs and is computed from (e.g., Reference A4)

$$Q_g = C_g G_n L \sqrt{2g(H_c - H_{mp})} \quad (A2)$$

in which Q_g = orifice discharge (cfs), C_g = orifice discharge coefficient (dimensionless -- varies with gate opening and H_c), G_n = effective gate opening = minimum distance between the gate lip and the crest (ft), g = acceleration of gravity (32.2 ft/s² -- common knowledge, Reference A4, sheet. 000-1 for example), and H_{mp} = vertical distance between the mid-point of G_n and the crest.

A.3 Model Test Data

The 1:112.5 scale and 1:15 scale Fort Patrick Henry model test data (Reference A3) are used to determine

- $C_f(H_c)$
- H_{Lmin} and $C_g(H_c)$ for $V = 31$ ft.

The model test data, scaled to prototype values, for both orifice and free discharge are plotted in Attachment A4-4 and tabulated in Attachment A4-5. These data are used below to estimate H_{Lmin} and $C_g(H_c)$ for $V = 31$ feet and to establish a curve fit for $C_f(H_c)$.

A.4 Geometry

Parameters G_n , H_{mp} , Z_o (gate overflow elevation), and β (angle plotted against discharge coefficient in Reference A4) are computed from crest and gate geometry as described in Attachment A6. Table A1 gives the values of these parameters for $V = 10, 13, 17, 21, 25$, and 31 feet.

Table A1: Geometrical Parameters for Relevant Gate Openings

V, feet	G_n , feet	H_{mp} , feet	Z_o , feet	β , deg.
10	10.139	4.951	1270.53	80.1
13	13.118	6.462	1272.14	85.4
17	17.123	8.464	1273.95	91.9
21	21.165	10.456	1275.38	97.9
25	25.255	12.436	1276.38	103.7
31	31.540	15.375	1277.00	112.2

As an example, the procedure for computing the geometrical parameters for $V = 31$ feet is given here. From Attachment A7 (Reference A5),

- $R = 36$ feet
- $Z_c = 1228$ feet
- $Z_{tr} = 1241$ feet
- $z_1 = 1241 - 1227.406 = 13.594$ feet
- $z_2 = 1263 - 1241 = 22.0$ feet

where the parameters are defined in Attachment A6-2. Referring to Attachment A6:

TVA

Calculation No. CDQ000020080010 Appendix A	Rev: 0	Plant: GEN	Page: A4
Subject: Dam Rating Curves, Fort Patrick Henry		Prepared G.A. Schohl	
		Checked J.B. Mauter	

Angle θ : $\theta = \sin^{-1}\left(\frac{22}{36}\right) + \sin^{-1}\left(\frac{13.594}{36}\right) = 59.856^\circ$

Angle α : $\alpha = \tan^{-1}\left(\frac{1241 - 1228 - 31}{\sqrt{36^2 - (1241 - 1228 - 31)^2}}\right) = -30.0^\circ$

Overflow elevation Z_o : $Z_o = 1241 + 36 \sin[59.856 - (-30)] = 1277.00$ feet

Gate lip y-coordinate: $y_f = 1241 - 1228 - 31 = -18.0$ feet

Gate lip x-coordinate: $x_f = \sqrt{36^2 - (-18)^2} = 31.177$ feet

From Attachment A8 (Reference A6), the equation for the spillway crest segment downstream from the valve seat is:

$$y_s^* = f(x_s^*) = 0.592 + \frac{x_s^* - 5.333}{5} + \frac{(x_s^* - 5.333)^2}{133} \quad \text{for } x_s^* \geq 5.333$$

in which $y_s^* = y_s - 13$ and $x_s^* = 38.75 - x_s$. In terms of y_s and x_s :

$$y_s = f(x_s) = 13.592 - \frac{x_s - 33.417}{5} + \frac{(x_s - 33.417)^2}{133} \quad \text{for } x_s \leq 33.417 \text{ feet}$$

and

$$\frac{dy_s}{dx_s} = -0.70251 + \frac{x_s}{66.5}$$

To get effective gate opening, G_n , solve the following equation for x_{sn} :

$$x_{sn} - 31.177 + \left[13.592 - \frac{x_{sn} - 33.417}{5} + \frac{(x_{sn} - 33.417)^2}{133} - (-18) \right] \left[-0.70251 + \frac{x_{sn}}{66.5} \right] = 0$$

Solution:

- $x_{sn} = 36.129$ feet (by iteration), but crest equation was valid only for $x_s \leq 33.417$ feet.

From Attachment A8 (Reference A6), the equation for the spillway crest segment between the crest and the valve seat is:

$$y_s^* = f(x_s^*) = \frac{(x_s^*)^{1.8}}{34.378} \quad \text{for } 0 \leq x_s^* \leq 5.333$$

In terms of y_s and x_s :

TVA

Calculation No. CDQ000020080010 Appendix A	Rev: 0	Plant: GEN	Page: A5
Subject: Dam Rating Curves, Fort Patrick Henry		Prepared G.A. Schohl	
		Checked J.B. Mauter	

$$y_s = f(x_s) = 13 + \frac{(38.75 - x_s)^{1.8}}{34.378} \quad \text{for } 33.417 \leq x_s \leq 38.75$$

and

$$\frac{dy_s}{dx_s} = -\frac{1.8(38.75 - x_s)^{0.8}}{34.378}$$

The equation for x_{sn} is now:

$$x_{sn} - 31.177 + \left[13 + \frac{(38.75 - x_{sn})^{1.8}}{34.378} - (-18) \right] \left[-\frac{1.8(38.75 - x_{sn})^{0.8}}{34.378} \right] = 0$$

Solution:

- $x_{sn} = 35.440$ feet (by iteration), which is in the valid range for the crest equation used.
- $y_{sn} = 13 + (38.75 - 35.44)^{1.8}/34.378 = 13.251$
- $G_n = \sqrt{(35.440 - 31.177)^2 + (13.251 - (-18))^2} = 31.540$ feet

and

- $H_{mp} = 31 - [13.251 - (-18)]/2 = 15.375$ feet
- $\beta = \frac{\pi}{2} - \tan^{-1}\left(\frac{-18}{31.177}\right) - \tan^{-1}\left(\frac{35.44 - 31.177}{13.251 - (-18)}\right) = 90 - (-30.0) - 7.77 = 112.2^\circ$

A.5 Determination of $H_{Lmin}(V)$

Values for H_{Lmin} are not listed in Attachment A4-5 but are indicated graphically in Attachment A4-4, as the points at which the curves for different gate openings meet the free discharge curve (gates raised above water surface). Values scaled from this plot for gate openings 25, 21, 17, 13, 10, 8, and 6.5 feet are indicated on the plot. Attachment A9 lists these values and fits a straight line to the data (spreadsheet included as Electronic Attachment A15). A value of H_{Lmin} for $V = 31$ feet is established by using the straight-line fit to extrapolate the data. The following is used for the headwater rating curve calculations:

$$H_{Lmin} = 37.49 \text{ feet for } V = 31 \text{ feet.}$$

A.6 Determination of $C_f(H_c)$

Attachment A10 shows the 1:112.5 scale model test data for free discharge from Attachment A4-5 and a polynomial curve fit to the data:

$$C_f = 2.8 + 0.08548H_c - 0.003963H_c^2 + 1.039 \times 10^{-4}H_c^3 - 9.875 \times 10^{-7}H_c^4 \quad (A3)$$

Equation A3 is used to compute $C_f(H_c)$ for the headwater rating curve calculations. Values of C_f are needed up to $H_c = H_{Lmin}$, or 37.5 feet, which is a few feet higher than the data range. The plot in Attachment A10 shows that Equation A3 can be used to estimate C_f for H_c values slightly above the data range.

TVA

Calculation No. CDQ000020080010 Appendix A	Rev: 0	Plant: GEN	Page: A6
Subject: Dam Rating Curves, Fort Patrick Henry		Prepared G.A. Schohl	
		Checked J.B. Mauter	

A.7 Determination of $C_g(H_c)$ for $V = 31$ feet

Attachment A11 shows the calculations and results for extrapolating $C_g(H_c)$ for $V = 31$ feet from the model data for other gate openings. The first column in Attachment A11 indicates the data for which $H_c = H_{Lmin}$, at which H_c is just high enough to touch the bottom of the gate. The discharge indicated for $V = 31$ feet at $H_c = H_{Lmin}$ is the free discharge computed using $C_d(H_c)$ from equation A3. The first three numerical columns list the model data (scaled to prototype dimensions) for $V = 10, 13, 17, 21$, and 25 feet as listed in Attachment A4-5. The rows that do not include values of discharge, Q , were added to extrapolate the data. The next two columns after the model data list prototype geometrical parameters. The last numerical column lists the C_g values computed from the data. Values that were "estimated" for extrapolation purposes are labeled as such to the right of the C_g column.

Attachment A12 shows C_g plotted against H_c for all gate openings. All curves include extrapolated segments to $H_c = 60$ feet. The extrapolations were guided by plotting the C_g values estimated for $H_c=60$ feet against angle β on Hydraulic Design Chart 311-1 from Reference A4. This chart, which shows U.S. Army Corps of Engineers data for tainter gates on standard crests, is included as Attachment A13 with the Fort Patrick Henry data added. The value of X/H_d for Fort Patrick Henry is 0.15 ($X = 5.333$ feet, Attachment A7, and $H_d = 35$, Attachment A14). Presumably because TVA's spillway crests are not standard, TVA data always lie to the left of the suggested design curves on this chart.

The estimated curve for $V = 31$ feet starts with the value for $H_c = H_{Lmin}$ and runs approximately parallel to the curve for $V = 25$ feet. Given the absence of data, this extrapolated line segment fit for $C_g(H_c)$ at $V = 31$ feet is used for the headwater rating calculations. Table A2 lists the points describing the extrapolated relationship.

Table A2: Points Defining Extrapolated Curve for $C_g(H_c)$ at $V = 31$ feet.

H_c , feet	C_g
37.5	0.764
42	0.720
48	0.712
58	0.720
60	0.720


TVA

Calculation No. CDQ000020080010	Rev: 0	Plant: GEN	Page: A7
Subject: Dam Rating Curve, Fort Patrick Henry	Prepared J.V. Peyton		
	Checked J.B. Mauter		

**Appendix A
Attachments**

FORT PATRICK HENRY DAM

LOCATION OF SPILLWAY GATES

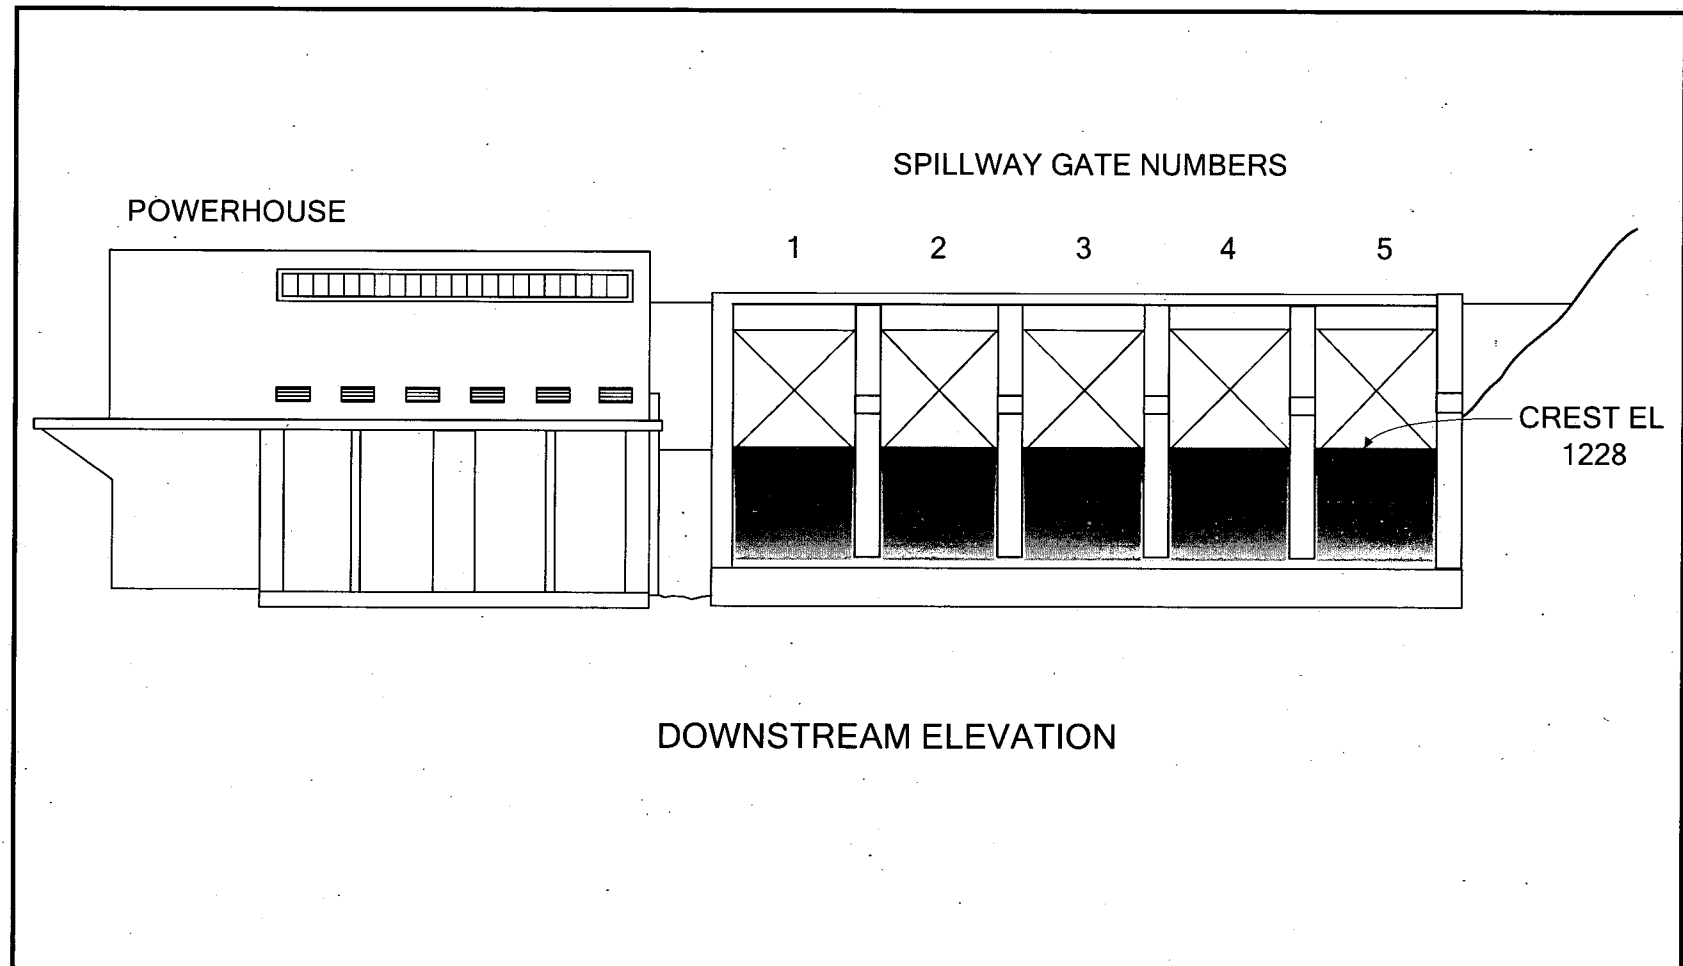

SPILLWAY GATE ARRANGEMENTS

Arrangement Number	Gate Number				
	1	2	3	4	5
1	-	-	-	C	-
2	-	C	-	C	-
3	-	C	-	C	C
4	C	C	-	C	C
5	C	C	C	C	C
6	C	C	C	0.5	C
7	C	0.5	C	0.5	C
8	C	0.5	C	0.5	0.5
9	0.5	0.5	C	0.5	0.5
10	0.5	0.5	0.5	0.5	0.5
11	0.5	0.5	0.5	1	0.5
12	0.5	1	0.5	1	0.5
13	0.5	1	0.5	1	1
14	1	1	0.5	1	1
15	1	1	1	1	1
16	1	1	1	1.5	1
17	1	1.5	1	1.5	1
18	1	1.5	1	1.5	1.5
19	1.5	1.5	1	1.5	1.5
20	1.5	1.5	1.5	1.5	1.5
21	1.5	1.5	1.5	2	1.5
22	1.5	2	1.5	2	1.5
23	1.5	2	1.5	2	2
24	2	2	1.5	2	2
25	2	2	2	2	2
26	2	2	2	3	2
27	2	3	2	3	2
28	2	3	2	3	3
29	3	3	2	3	3
30	3	3	3	3	3

Arrangement Number	Gate Number				
	1	2	3	4	5
31	3	3	3	4	3
32	3	4	3	4	3
33	3	4	3	4	4
34	4	4	3	4	4
35	4	4	4	4	4
36	4	4	4	5	4
37	4	5	4	5	4
38	4	5	4	5	5
39	5	5	4	5	5
40	5	5	5	5	5
41	5	5	5	6.5	5
42	5	6.5	5	6.5	5
43	5	6.5	5	6.5	6.5
44	6.5	6.5	5	6.5	6.5
45	6.5	6.5	6.5	6.5	6.5
46	6.5	6.5	6.5	8	6.5
47	6.5	8	6.5	8	6.5
48	6.5	8	6.5	8	8
49	8	8	6.5	8	8
50	8	8	8	8	8
51	8	8	8	10	8
52	8	10	8	10	8
53	8	10	8	10	10
54	10	10	8	10	10
55	10	10	10	10	10
56	10	10	10	13	10
57	10	13	10	13	10
58	10	13	10	13	13
59	13	13	10	13	13
60	13	13	13	13	13

Arrangement Number	Gate Number				
	1	2	3	4	5
61	13	13	13	17	13
62	13	17	13	17	13
63	13	17	13	17	17
64	17	17	13	17	17
65	17	17	17	17	17
66	17	17	17	21	17
67	17	21	17	21	17
68	17	21	17	21	21
69	21	21	17	21	21
70	21	21	21	21	21
71	21	21	21	25	21
72	21	25	21	25	21
73	21	25	21	25	25
74	25	25	21	25	25
75	25	25	25	25	25
76	25	25	25	31	25
77	25	31	25	31	25
78	25	31	25	31	31
79	31	31	25	31	31
80	31	31	31	31	31

GATE OPENINGS

Figures in columns under each gate number refer to gate opening indicator reading
dash (-) indicates closed gate
C indicates gate raised to crest elevation

February 10, 1954

Albert S. Fry

Rex A. Elder

**RATING CURVES AND GATE OPERATING INSTRUCTIONS - BOONE AND FORT PATRICK
HENRY DAM SPILLWAYS (ASF 1282 AND 1303)**

To provide a means of operating the Boone and Fort Patrick Henry spillway gates in the interim period before spillway discharge tables are prepared and issued, we recommend the following.

1. The rating curves and spillway operating schedule prepared for the Boone model studies report should be issued to the operating personnel at that dam. The spillway operating schedule is detailed enough that the operating personnel can determine the proper gate settings when used in conjunction with the rating table. The gates at this dam have individual gate hoists and each hoist is equipped with an indicating dial which we have arranged to have marked with every foot and one-half foot of gate opening.
2. The gate operation sequence schedule table—Fort Patrick Henry Dam—which accompanies this memorandum should be issued. This schedule will, when issued in conjunction with the spillway rating curves that have already been issued, allow the setting of discharges up to a total spillway flow of 65,000 cfs. These gates are equipped with gate operating equipment and indicators similar to those at Boone. They also have been calibrated to indicate every foot and one-half foot of gate opening.

The tests on the Henry model, while they are still not complete, indicate that the estimated curves for various small discharges as shown on the rating curves that have been issued for Fort Henry are reasonably accurate. Small flow releases, if necessary, can therefore be made with reasonable assurance.

Rex A. Elder

RAE:ab

CHAPTER 8**SPILLWAY OPERATION****LIMITATIONS UPON GATE OPERATION**

The model studies to develop the design of the spillway apron, described in Chapter 3, were generally made with all the gates opened the same amount. Since it would not be practical to arrange the prototype gate controls to make the openings always equal, it was advisable to determine a gate-opening sequence which would combine good hydraulic performance with a practicable operation schedule. In order to achieve these results, it was found imperative that a limit for gate-opening inequality be established which would prevent improper or detrimental spillway operation.

1:50 Scale Model

Model studies in the flume showed that the gate operation restrictions enumerated in the Summary in Chapter 3 under "General Operating Tests of Selected Design" would result in satisfactory spillway operation without significant erosion. The amounts of erosion for different gate openings are shown in Table 15.

1:112.5 Scale Model

A comprehensive study of gate operation was made on the 1:112.5 scale model to determine the best gate-operating sequence. Photographs of confetti flow patterns were made to aid in this determination and for use as a reference when there might be future need to prepare gate-operating sequences to meet special needs. Appendix C contains a table showing the gate arrangements for which pictures were taken.

Gate Operating Schedule

The gate operating schedule was developed upon the basis of the erosion observed in the 1:50 scale model and the flow patterns observed in the 1:112.5 scale model. The order for opening the gates is 4, 2, 5, 1, 3.

The maximum opening for each gate is 1 foot until all gates have reached this opening, after which the gates shall be opened in the same order to a maximum opening of 3 feet. From a uniform 3-foot opening the gates shall then be opened successively to 5 feet, and thereafter in 5-foot increments in accordance with the same operating pattern to maintain balanced operation with a maximum difference of 5 feet in the settings of any two gates. Smaller increments in gate opening may be used, provided that the same opening sequence is maintained.

Trash Removal

No trash gate was provided. It was determined by visual inspection of the model approach flows that Gate 3 should be used for trash removal. When it is desirable to remove trash, Gate 3 should be raised above the surface and kept open only long enough to rid the surface of the trash.

SPILLWAY DISCHARGE RATING

The spillway discharge rating was determined from tests conducted on the 1:15 and 1:112.5 scale models with check tests on the 1:50 scale model. The 1:112.5 and 1:50 scale models were designed and used primarily for development of the apron design and were not specifically designed as rating models. They were therefore used only to establish the free-discharge curve for the condition of all gates raised above the water surface. The 1:15 scale model, consisting of a single spillway bay, was used to determine accurate ratings for partial gate openings. A detailed description of all three models is given in Chapter 2.

Methods of Measurement

Enough tests were made to define accurately the free-discharge curve and the curve for each gate-opening position tested. Each test was made under conditions of constant and stabilized discharge. The discharge in the 1:112.5 and 1:50 scale models was measured by reading the differential pressure across a previously calibrated diaphragm orifice in the supply line. The 1:15 scale

Source: Reference A3

model discharge was measured by means of the diaphragm orifices or a calibrated sharp-crested weir located near the upstream end of the test flume. Headwater elevations on all models were measured with hook gages, reading to 0.001 foot, at the locations shown on Plates 3, 4, and 6.

1:15 Scale Model Tests


d. Discharges under partially opened gates were determined from the 1:15 scale model tests in which equal opening of adjacent gates was simulated in the model. This was accomplished by installing vertical walls, upstream from the piers, with their inner faces on the centerlines of the piers confining the single bay of the model. The walls had the same effect upon the flow as mirrors in the same positions would have upon the visual concept of the model, and the resulting contraction effect was equal to that produced by opening the adjacent gates. The spillway end contraction effect, produced by having the adjacent gates closed, was neglected because it has been found to be practically negligible at partial gate openings.

1:112.5 Scale Model Tests

Discharges unregulated by any gates were determined from tests on the 1:112.5 scale model, which simulated the entire spillway, the powerhouse, and a reach of the channel both upstream and downstream from the dam. These tests included the end contraction effects, which may appreciably affect the discharge when the gates are raised above the water surface. It was evident from the tests that the bend in the river immediately upstream from the spillway caused the flow to pile up on the left side of Bays 1, 2, 3, and 4 and on the right side of Bay 5 as shown in Figure 14 with a subsequent effect upon the discharge rating.

Rating Curves

Plate 36 shows the rating curves developed from all the model test data. These curves cover the complete operating range of the spillway. The gate discharge data were obtained at gate openings of 0.5, 1, 2, 3, 5, 6.5, 8, 10, 13, 17, 21, and 25 feet. The curves for other openings were obtained by

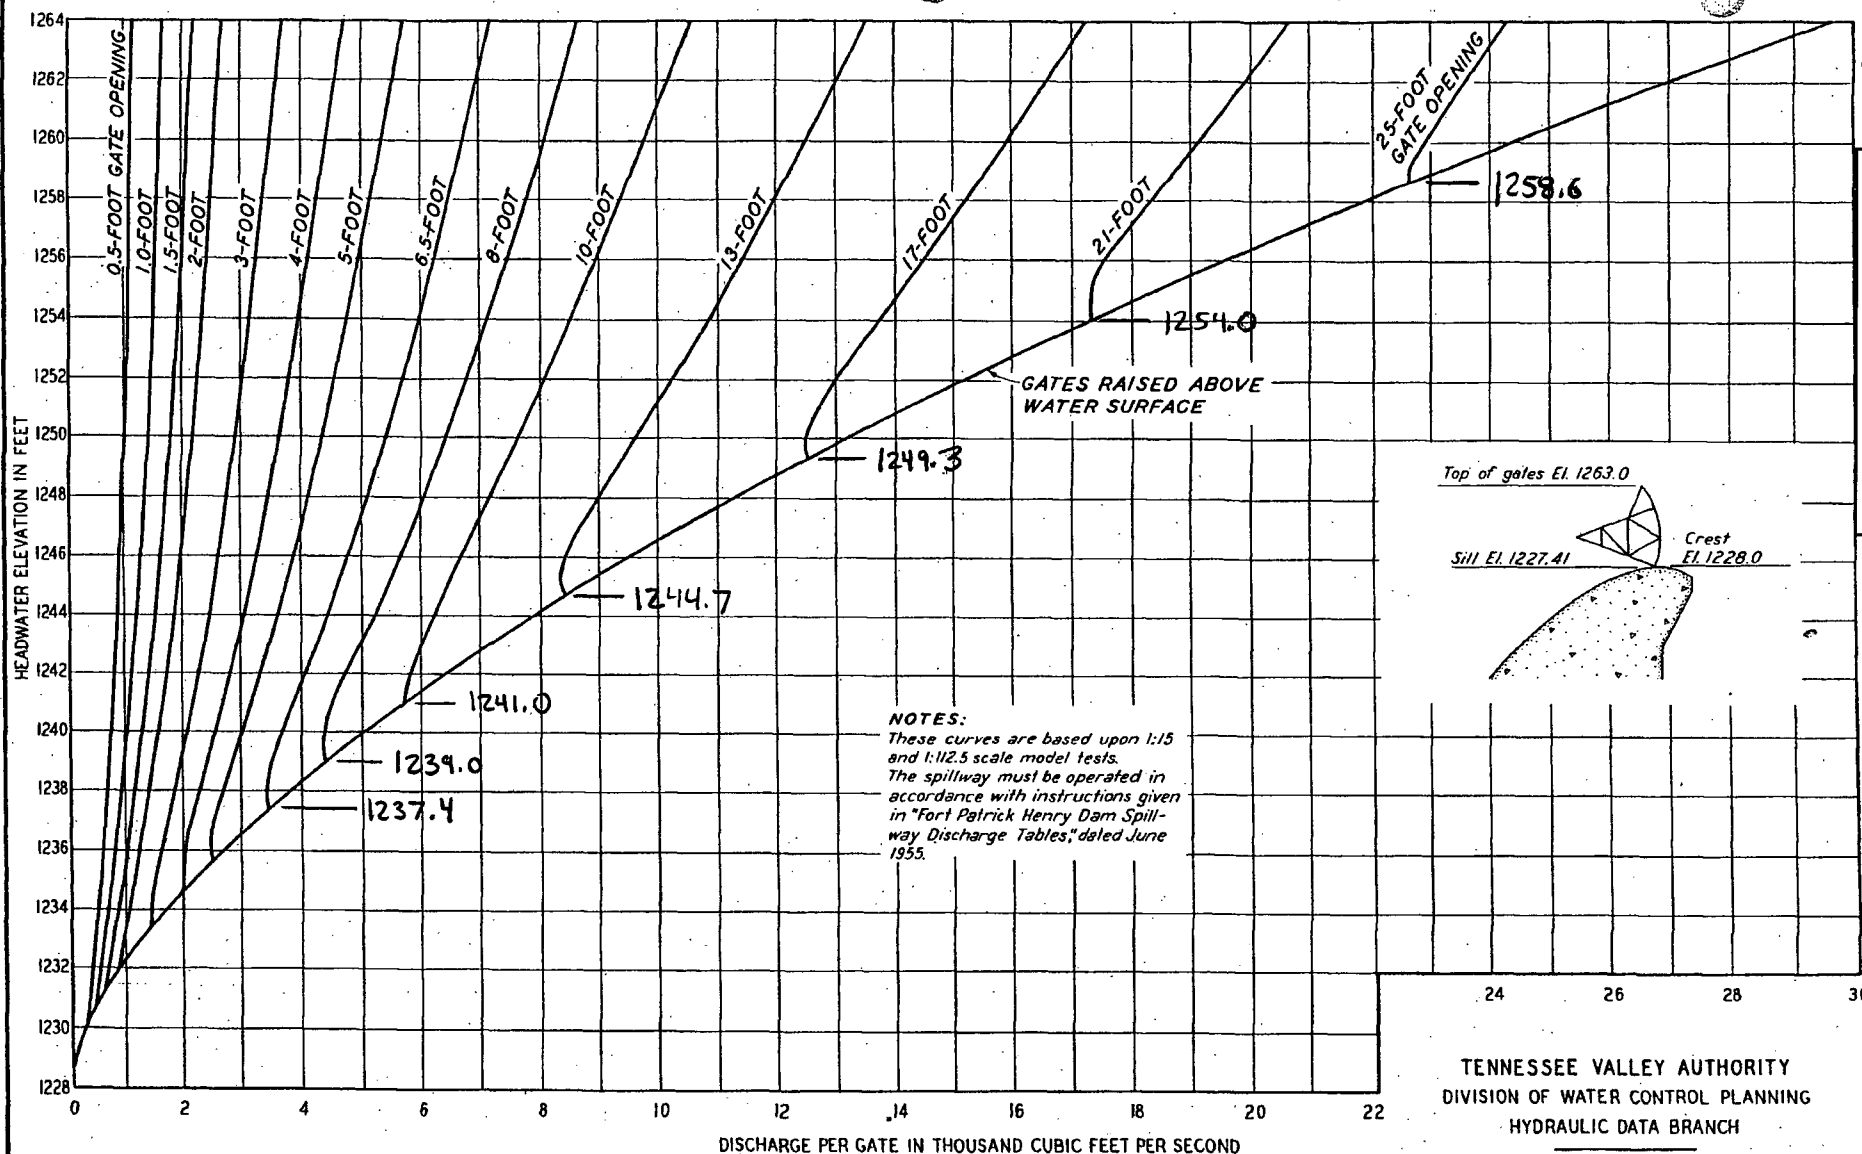

TENNESSEE VALLEY AUTHORITY
 DIVISION OF WATER CONTROL PLANNING
 HYDRAULIC DATA BRANCH

FORT PATRICK HENRY PROJECT
 HYDRAULIC MODEL STUDIES

SPILLWAY RATING CURVE

SUMMARY OF SPILLWAY RATING TEST DATA

Test No.	Model Scale	Gate Opening (feet)*	Headwater Elevation (feet)	Discharge per Bay (cfs)	Test No.	Model Scale	Gate Opening (feet)*	Headwater Elevation (feet)	Discharge per Bay (cfs)
1	1:15	0.5	1234.57	501	61	1:15	10.0	1256.92	9229
2			1237.38	602	62			1259.82	9763
3			1240.87	706	63			1260.99	9986
4			1245.58	829	64	1:15	13.0	1245.28	8320
5			1258.78	1095	65			1245.48	8349
6			1261.78	1150	66			1246.26	8476
7	1:15	1.0	1230.64	447	67			1247.46	8844
8			1231.02	456	68	1:15	13.0	1249.39	9454
9			1231.64	500	69			1254.64	11030
10			1233.16	601	70			1258.86	12190
11			1235.16	725	71			1264.27	13550
12			1238.76	898	72	1:15	17.0	1250.14	12470
13	1:15	1.0	1242.46	1049	73			1251.49	12820
14			1246.72	1201	74			1252.05	12990
15			1250.44	1322	75			1252.83	13270
16			1253.23	1398	76	1:15	17.0	1257.72	15060
17			1258.78	1547	77			1260.39	15970
18			1262.90	1644	78			1263.96	17160
19	1:15	2.0	1232.17	863	79	1:15	21.0	1255.22	17360
20			1232.06	885	80			1255.51	17380
21			1234.06	1001	81			1255.82	17450
22			1237.52	1307	82			1256.14	17520
23			1241.66	1602	83			1257.61	18050
24	1:15	2.0	1247.21	1932	84	1:15	21.0	1257.61	18150
25			1250.60	2100	85			1258.22	18340
26			1253.92	2255	86			1260.34	19240
27			1258.04	2439	87			1264.16	20630
28			1263.44	2656	88	1:15	25.0	1261.26	23300
29	1:15	3.0	1234.36	1352	89			1261.78	23490
30			1233.40	1375	90			1262.59	23750
31			1235.50	1491	91	1:15	25.0	1262.89	23880
32			1236.34	1596	92			1263.49	24090
33			1238.24	1809	93			1263.99	24260
34	1:15	3.0	1244.65	2401	94	1:15	Gates	1230.64	447
35			1249.18	2750	95		raised	1232.06	885
36			1253.71	3060	96		above	1233.25	1320
37			1261.21	3520	97		above	1233.40	1375
38			1265.95	3775	98	1:15	water	1235.88	2562
39	1:15	5.0	1236.55	2414	99		surface	1237.71	3590
40			1237.44	2523	100			1236.57	2940
41			1237.58	2546	101			1235.32	2290
42			1238.90	2769	1A	1:112.5	Gates	1233.10	1330
43			1239.16	2803	2A		raised	1234.61	1974
44	1:15	5.0	1241.80	3217	3A		above	1235.61	2384
45			1245.04	3675	4A		above	1236.01	2574
46			1250.00	4265	5A		water	1236.61	2904
47			1253.44	4645	6A	1:112.5	surface	1236.81	3004
48			1256.76	4981	7A			1239.83	4840
49	1:15	6.5	1239.54	3517	8A			1244.17	7994
50			1246.64	4831	9A			1241.14	5716
51			1252.02	5661	10A	1:112.5	Gates	1248.82	11990
52			1257.96	6450	11A		raised	1252.98	16140
53	1:15	8.0	1245.22	5437	12A		above	1255.62	19100
54			1250.11	6438	13A			1258.98	22950
55			1255.08	7311	14A	1:112.5	water	1247.05	10310
56			1263.80	8613	15A		surface	1260.41	24890
57	1:15	10.0	1242.07	5774	16A			1262.34	27330
58			1243.06	5950	17A			1264.07	29570
59			1246.54	6816					
60			1251.52	7989					

Not used

Free Discharge Data

*Gate opening is measured above the spillway crest elevation.

Source: Reference A3

interpolation. The model data from which the curves were prepared are given in Table 29. The data for the 1:15 and 1:50 scale model tests have been corrected for velocity of approach.

The discharge curves for partial gate openings in the immediate vicinity of the intersection with the free-discharge curve are based upon the 1:15 scale model tests under a condition of rising headwater. The intersection point must be considered as an approximation since it varies both with a rising or falling headwater condition and with approach flow conditions.

Published Spillway Discharge Tables

Spillway discharge tables for use in the actual operation of the dam have been prepared by the Hydraulic Data Branch of the TVA from the rating curves on Plate 36, and were issued in June 1955. They incorporate a series of gate arrangements which comply with the requirements for order and magnitude of successive gate openings as described earlier in this chapter under "Gate Operating Schedule." The allowable 1-foot, 2-foot, and 5-foot increments successively specified therein were determined to be too great for proper flexibility of operation, and the tables were computed for smaller gate opening increments.

The published Spillway Discharge Tables provide discharge values at 0.1-foot intervals of headwater elevation for each of 80 gate arrangements. The arrangements consist of opening each gate successively in the order 4, 2, 5, 1, 3 to each of the 16 positions listed in Table 30. Table 30 is an abridgment of the published tables and shows the discharges at 1-foot intervals of headwater elevation for the 16 arrangements at which all gates are opened uniformly.

TABLE 30

SPILLWAY DISCHARGE IN CUBIC FEET PER SECONDWITH ALL GATES EQUALLY OPEN

Gate Opening	Headwater Elevation in Feet								
	1256	1257	1258	1259	1260	1261	1262	1263	1264
Crest	2940	3000	3040	3090	3140	3180	3220	3260	*
0.5	5160	5240	5330	5420	5500	5580	5660	5740	*
1	7360	7480	7620	7740	7860	7980	8100	8210	8320
1.5	9580	9760	9920	10100	10260	10420	10580	10730	10880
2	11790	12000	12220	12420	12640	12840	13030	13220	13420
3	16040	16360	16660	16960	17260	17540	17820	18100	18360
4	20360	20750	21160	21560	21940	22300	22680	23040	23400
5	24660	25160	25650	26120	26600	27050	27500	27960	28390
6.5	31060	31720	32320	32930	33520	34180	34720	35320	35920
8	37300	38100	38880	39640	40390	41110	41820	42520	43220
10	44850	45880	46900	47940	48920	49960	50880	51920	52850
13	57100	58460	59780	61120	62400	63730	64940	66220	67440
17	72280	74060	75810	77570	79260	80980	82600	84300	85910
21	87480	89380	91380	93360	95340	97320	99240	101100	102900
25	97560	103400	109300	113200	114500	116100	117800	119600	121300
31	#	#	#	115500	121700	128200	134700	141500	148400

*Gates must be raised to prevent overtopping.


#Gates are above water surface at previous setting.

Definition Sketch for Spillway Discharge


COMPUTED GAS DATE 8/12/2008

CHECKED DATE


Free Discharge - No Tailwater effect

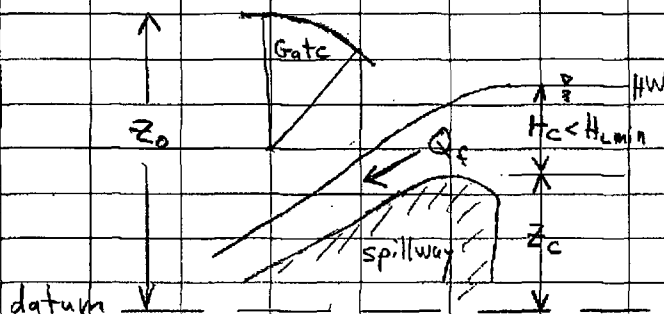


Free Discharge affected by Tailwater

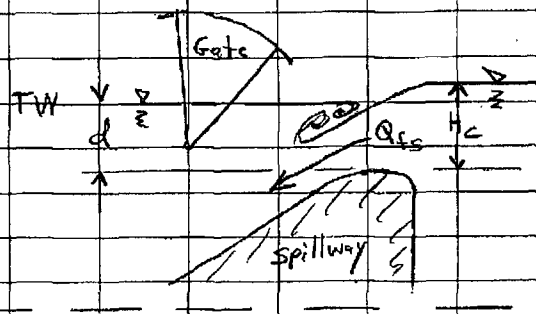


Nappe Touches Gate

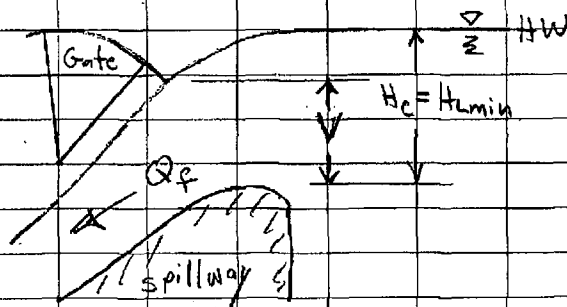

Orifice Discharge - No Tailwater Effect

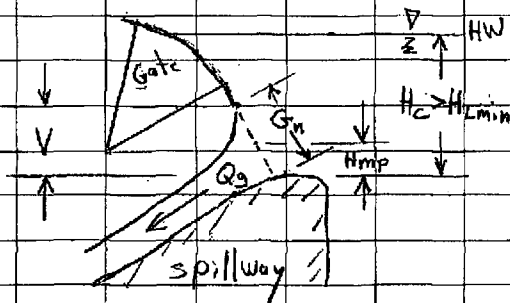

Orifice Discharge affected by Tailwater

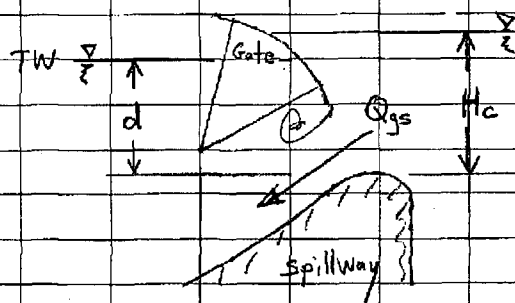


Spillway Discharge Calculations Geometry for Flow Under an Open Tainter Gate

COMPUTED CAS DATE 8/11/2008

CHECKED _____ DATE _____

Definition Sketch

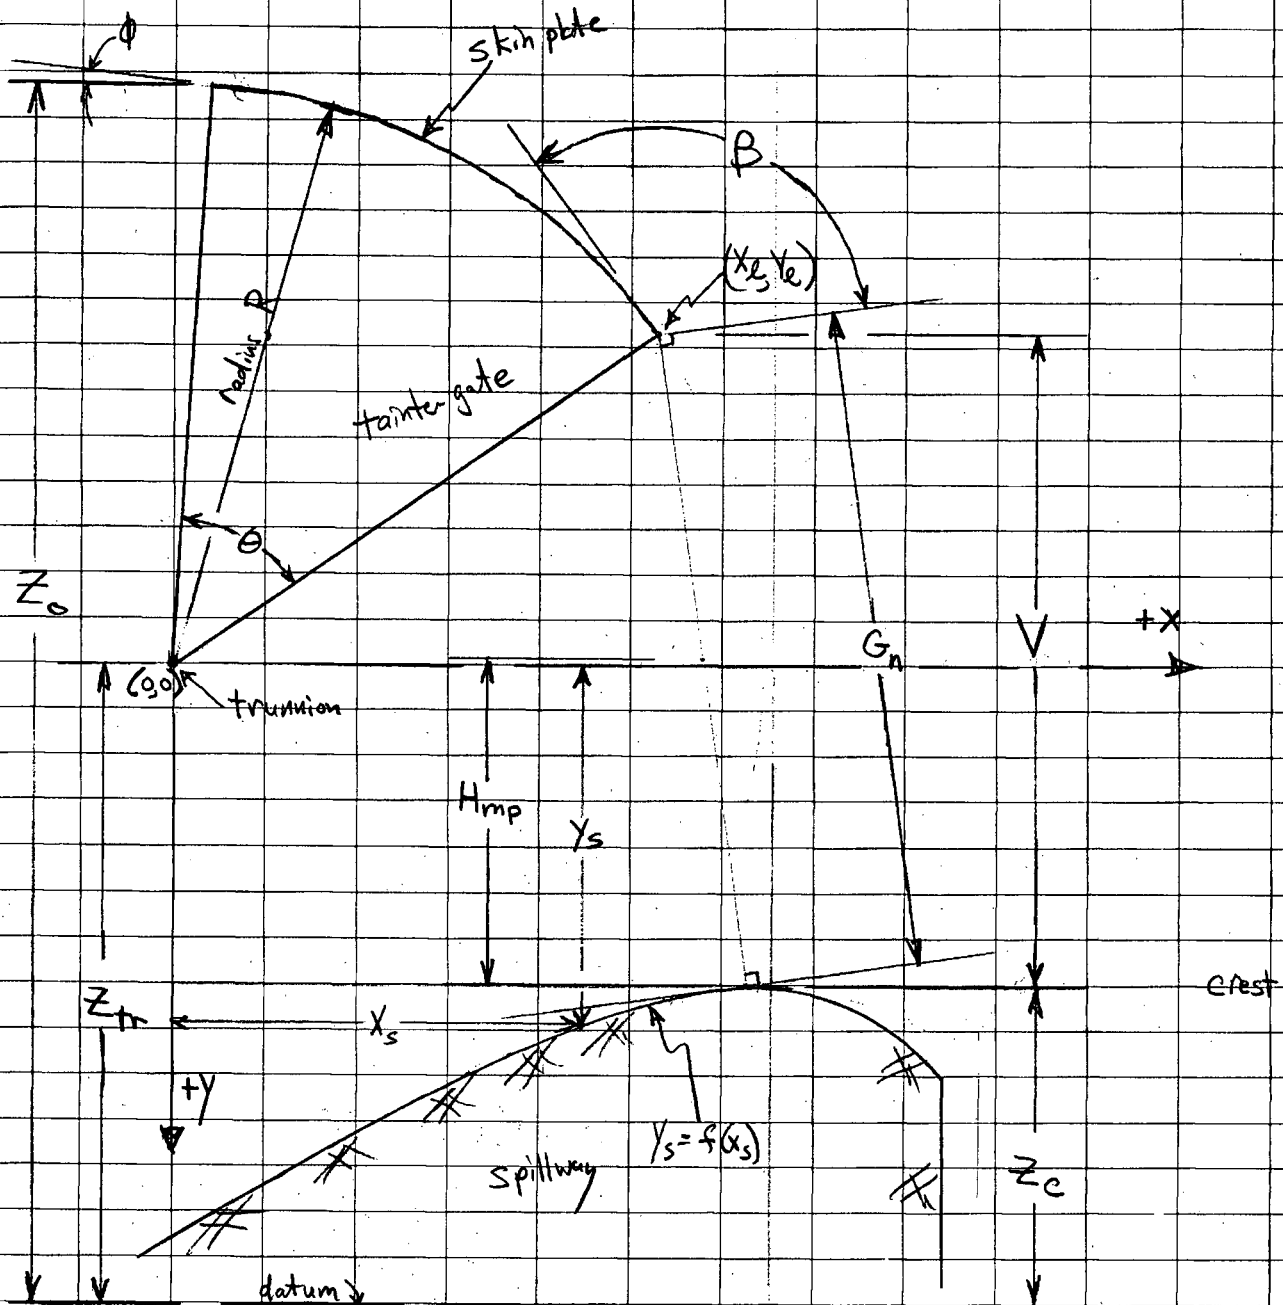

Spillway Gate Geometry

COMPUTED GAS DATE 8/11/2008

CHECKED _____ DATE _____

Variables

V = vertical distance between the bottom of the open gate and the crest

Z_c = crest elevation

Z_{tr} = trunnion elevation

Z_o = over flow elevation

R = radius of the tangent gate

G_n = minimum distance between the gate lip and the crest

H_{mp} = vertical distance between the mid-point of G_n and the crest

β = angle formed by the tangent to the gate lip and the tangent to the crest curve at the nearest point of the crest curve

θ = angle of the sector of a circle formed by two lines connecting the trunnion axis to the bottom and top of the radial gate.

X, y = coordinates relative to trunnion axis (y positive downward)

X_s, y_s = coordinates of spillway surface defined by $y_s = f(x_s)$

X_e, y_e = coordinates of the gate lip relative to trunnion axis

notes: y positive downward for all coordinates


{ all coordinates relative to trunnion axis

ϕ = angle formed by the tangent to the gate top and horizontal

Angle, θ

$$\theta = \sin^{-1}\left(\frac{Z_2}{R}\right) + \sin^{-1}\left(\frac{Z_1}{R}\right)$$

Z_1 & Z_2 are determined from drawings

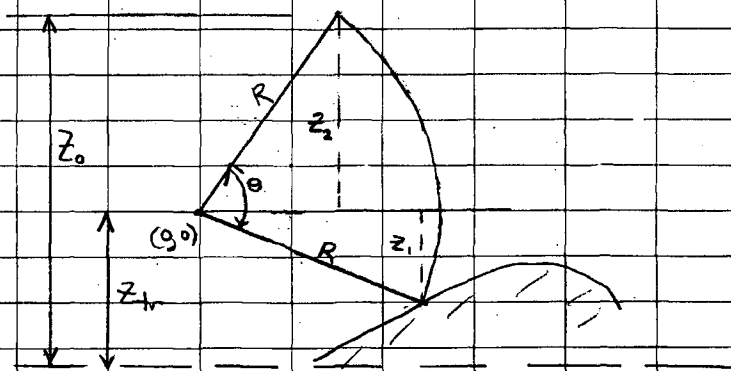

Closed Gate

Spillway Gate Geometry


COMPUTED GAS DATE 8/11/2008

CHECKED _____ DATE _____


Overflow Elevation, Z_o and Angle, Φ

For a gate opened so far that its upper edge is downstream of the trunnion:

$$Z_o = Z_{tr} + R$$

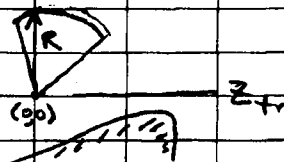

For a gate opened less:

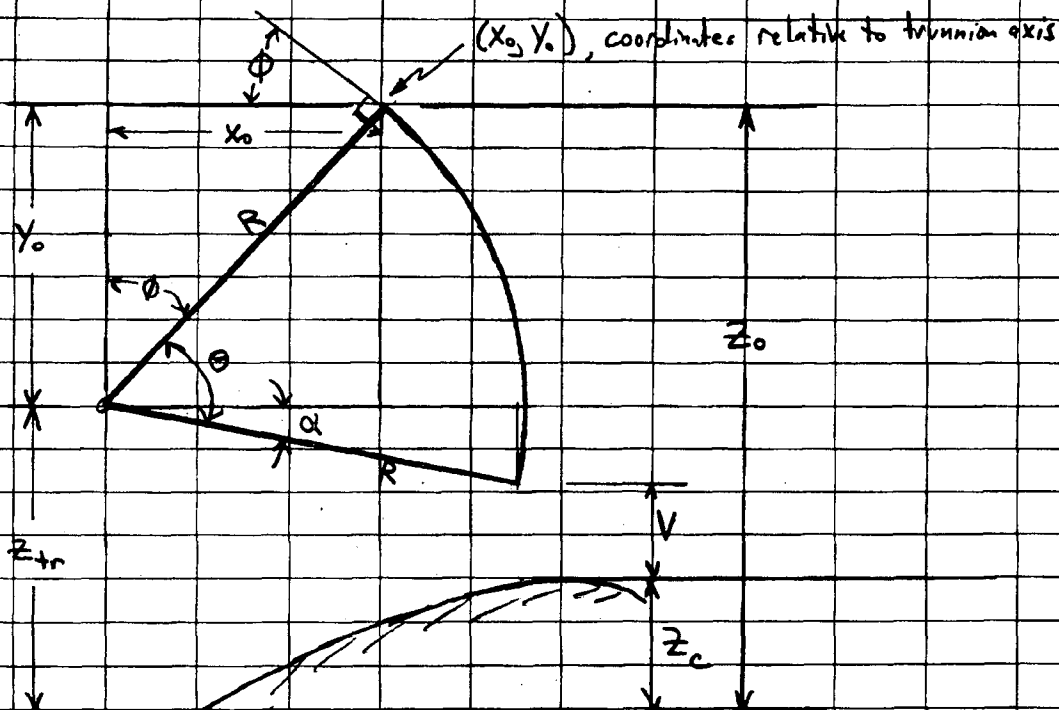

$$\alpha = \tan^{-1} \left(\frac{Z_{tr} - (Z_c + V)}{\sqrt{R^2 - (Z_{tr} - Z_c - V)^2}} \right)$$

 V given

$$Z_o = Z_{tr} + R \sin(\theta - \alpha)$$

$$\text{and } \Phi = \tan^{-1} \left(\frac{x_o}{y_o} \right) \quad \text{with } \begin{cases} y_o = Z_o - Z_{tr} \\ x_o = R \cos(\theta - \alpha) \end{cases}$$

Spillway Gate Geometry

COMPUTED GAS DATE 8/11/2008

CHECKED DATE

Gate Opening, G_n

Gate lip coordinates $\begin{cases} Y_e = Z_{tr} - Z_c - V \\ X_e = \sqrt{R^2 - Y_e^2} \end{cases}$

Distance between gate lip and any point on spillway surface is

$$l = \sqrt{(X_s - X_e)^2 + (Y_s - Y_e)^2} \equiv \sqrt{(X_s - X_e)^2 + [f(X_s) - Y_e]^2}$$

G_n is the minimum distance. l is minimum when $\frac{dl}{dX_s} = 0$

$$\frac{dl}{dX_s} = \frac{1}{2} \left\{ (X_{sn} - X_e)^2 + [f(X_{sn}) - Y_e]^2 \right\}^{-1/2} \cdot \left\{ 2(X_{sn} - X_e) + 2[f(X_{sn}) - Y_e] \frac{df(X_{sn})}{dX_s} \right\} = 0$$

$$\Rightarrow 0 = \frac{(X_{sn} - X_e) + [f(X_{sn}) - Y_e] \frac{df(X_{sn})}{dX_s}}{l_{\text{minimum}}}$$

where $X_{sn} = X_s$ for minimum l , $l_{\text{minimum}} \equiv G_n$.

Solve: $X_{sn} - X_e + [f(X_{sn}) - Y_e] \frac{df(X_{sn})}{dX_s} = 0$ for X_{sn}


Then:

$Y_{sn} = f(X_{sn})$ and $G_n = \sqrt{(X_{sn} - X_e)^2 + (Y_{sn} - Y_e)^2}$

Mid-Point Head, H_{mp}

$$H_{mp} = Z_{tr} - Z_c - Y_e - \frac{1}{2}(Y_{sn} - Y_e)$$


$$\Rightarrow H_{mp} = V - \frac{1}{2}(Y_{sn} - Y_e)$$

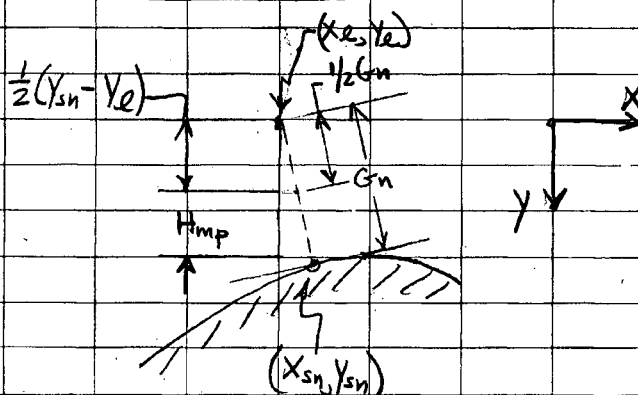

Spillway Gate Geometry

COMPUTED GAS DATE _____

CHECKED _____ DATE _____

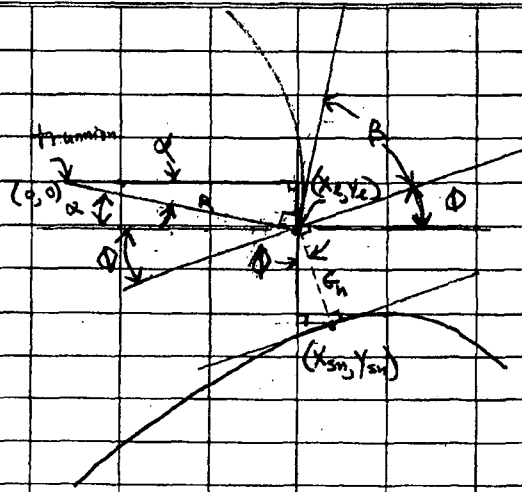Angle B

$$\beta + \frac{\pi}{2} + \alpha + \phi = \pi$$


$$\beta + \phi = \frac{\pi}{2} - \alpha$$


$$\beta = \frac{\pi}{2} - \alpha - \phi$$

$$\alpha = \tan^{-1} \left(\frac{Y_e}{X_e} \right)$$

$$\phi = \tan^{-1} \left(\frac{X_{sn} - X_e}{Y_{sn} - Y_e} \right)$$

$$\beta = \frac{\pi}{2} - \tan^{-1} \left(\frac{Y_e}{X_e} \right) - \tan^{-1} \left(\frac{X_{sn} - X_e}{Y_{sn} - Y_e} \right)$$

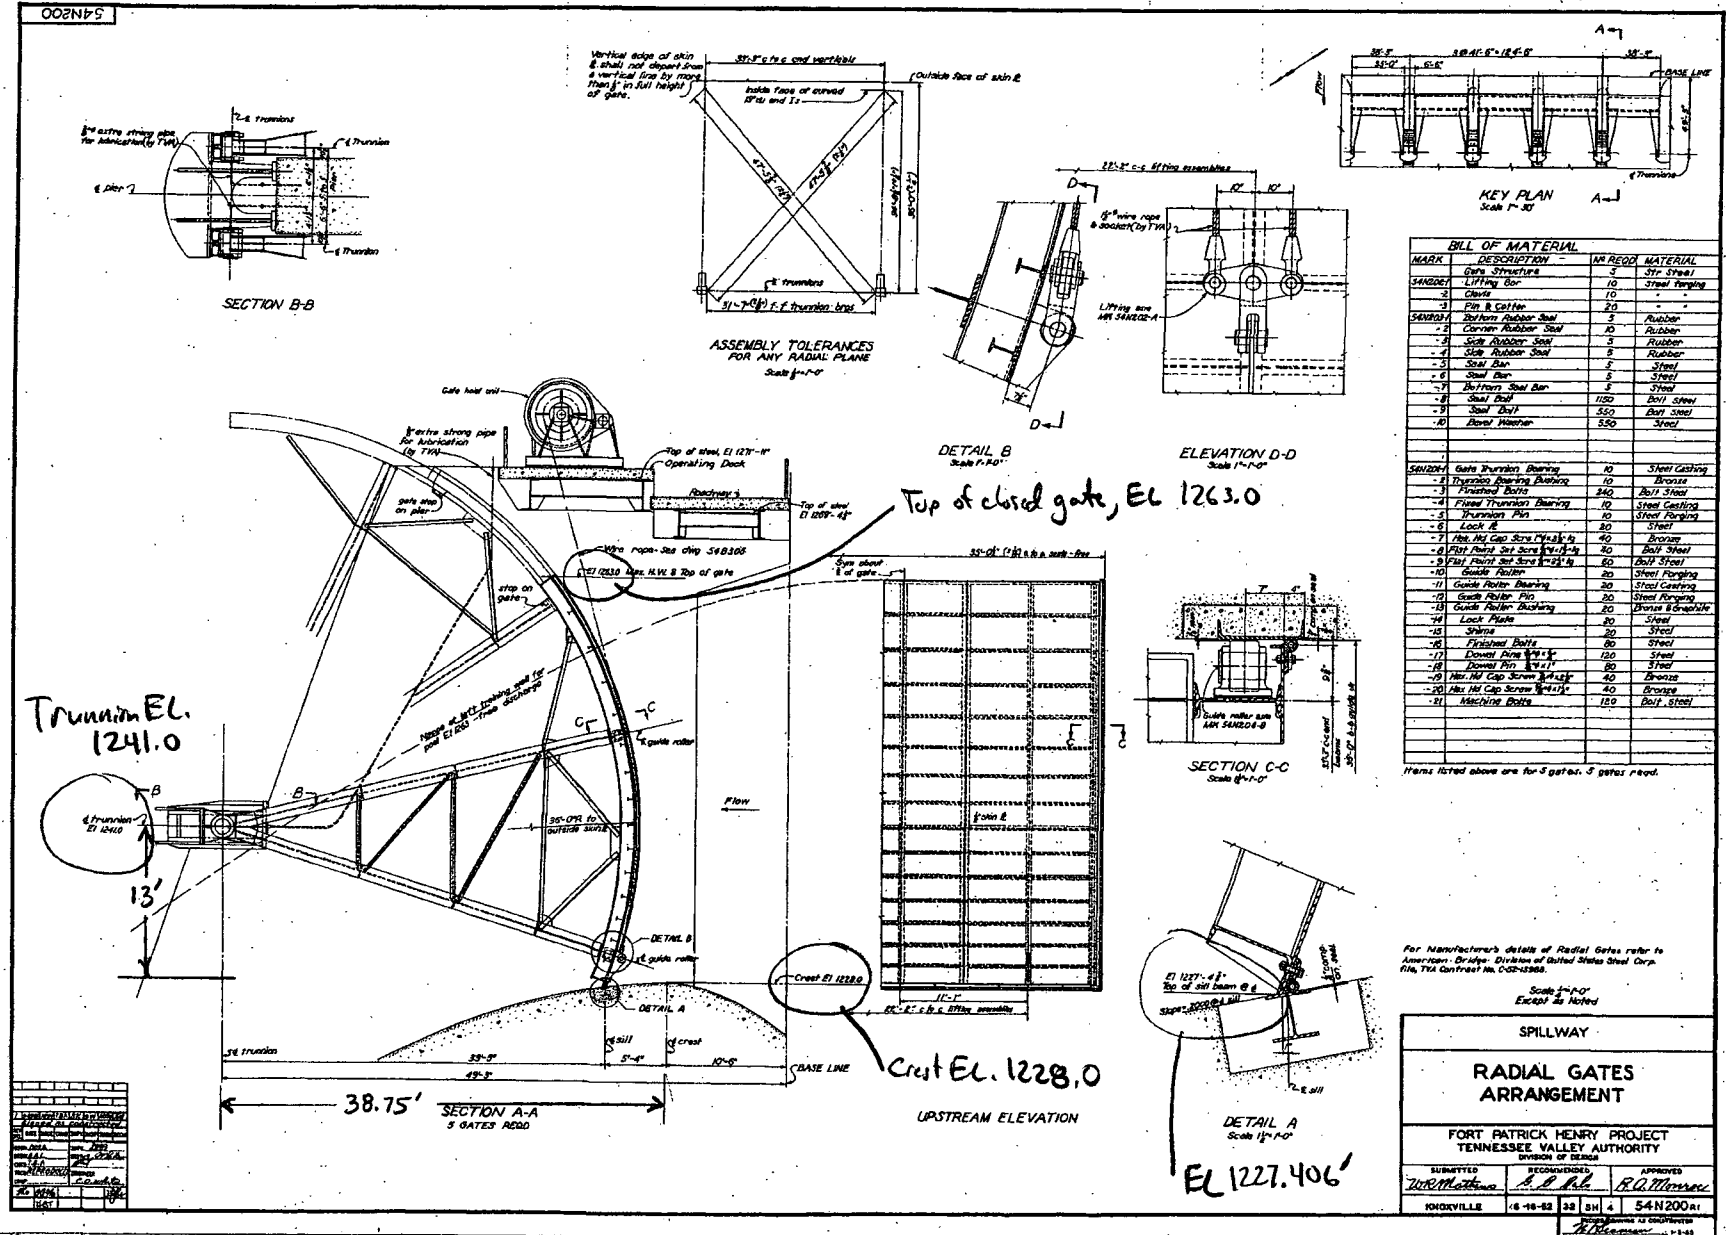

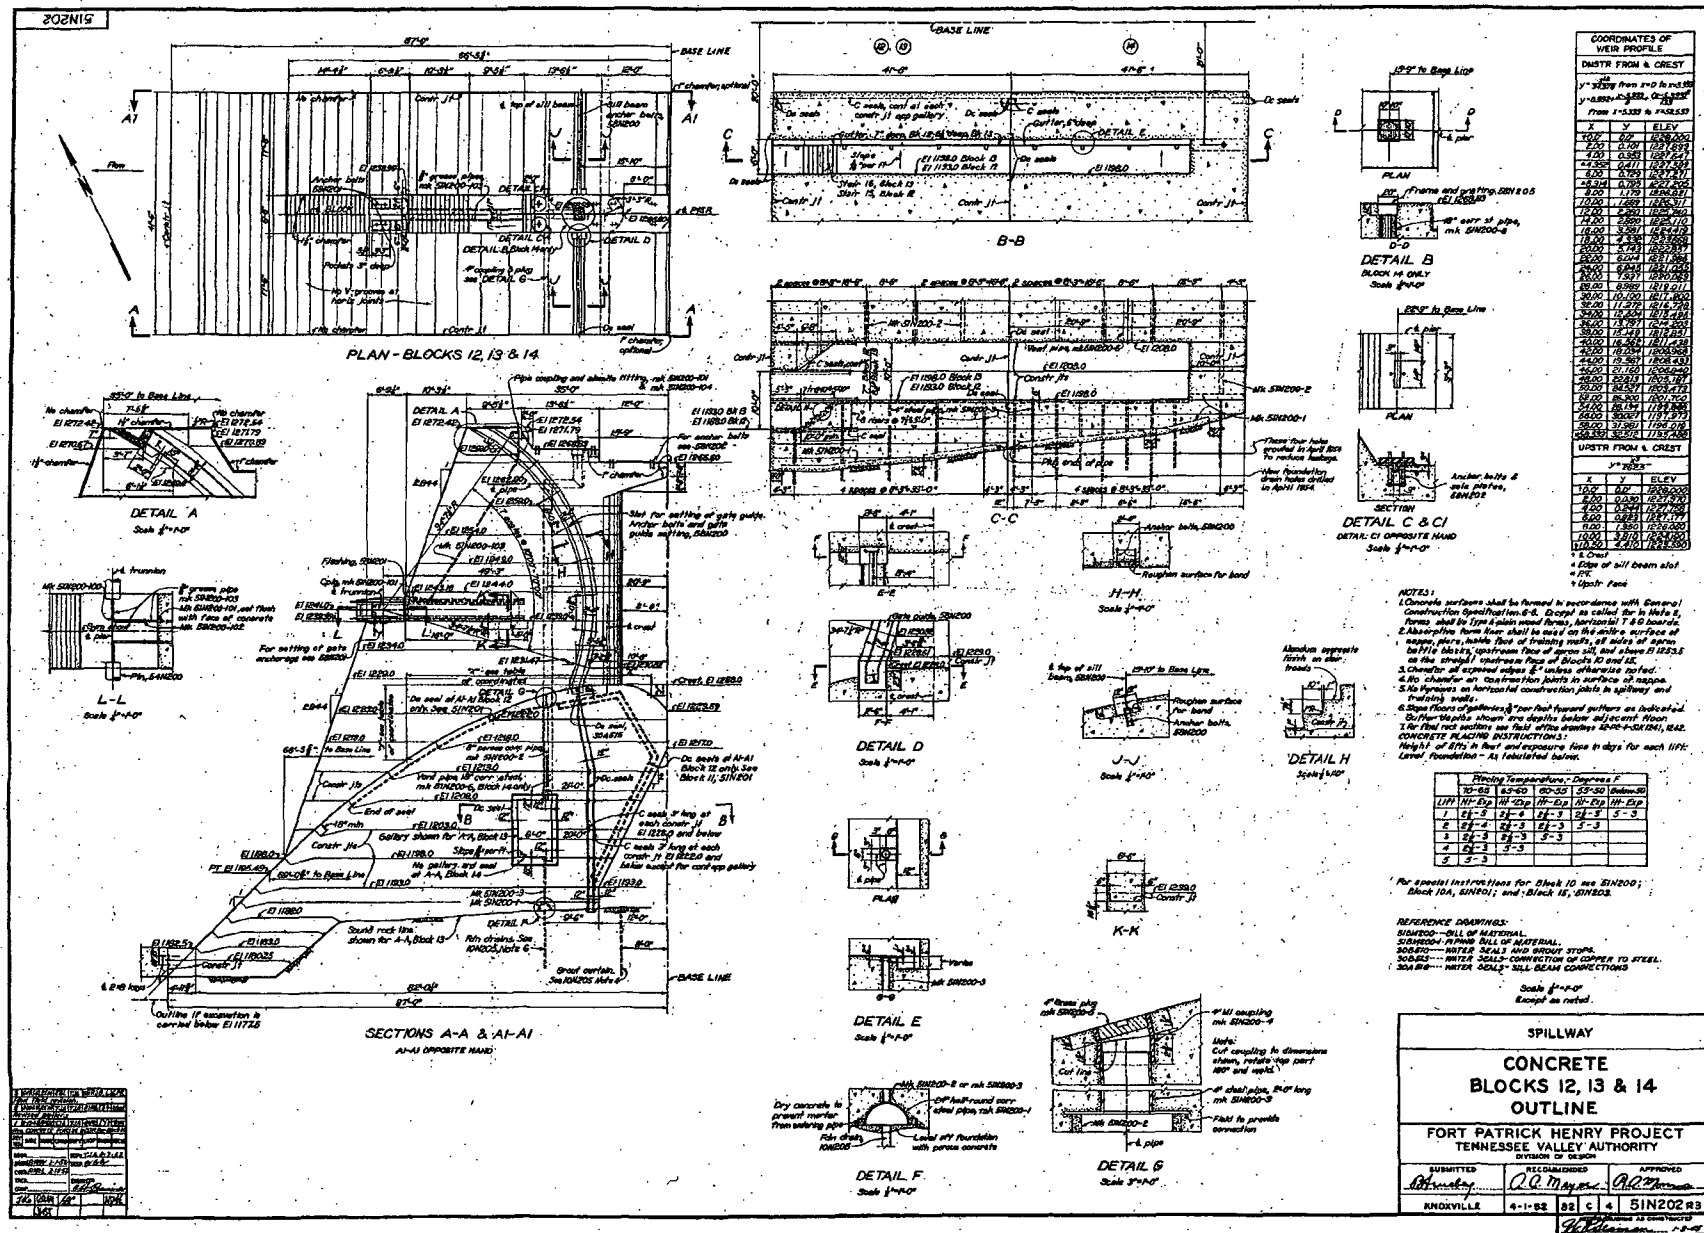

Ft Pat Henry Model Data for Headwater Ratings.xls HLmin Determination


Ft. Patrick Henry Project
Tainter Gates Partially Opened
Data from 1:15 scale model (Reference A3)

Crest EL = 1228 feet

EQUIVALENT PROTOTYPE

V	HW	H _{Lmin}	H _{Lmin}
feet	feet	feet	feet
6.50	1237.4	9.4	9.22
8.00	1239.0	11	10.95
10.00	1241.0	13	13.26
13.00	1244.7	16.7	16.72
17.00	1249.3	21.3	21.34
21.00	1254.0	26	25.95
25.00	1258.6	30.6	30.57
31.00			37.49 extrapolated using linear fit on 1:15 scale Model I

Ft. Patrick Henry 1:15 Scale Model
H_{Lmin} vs V

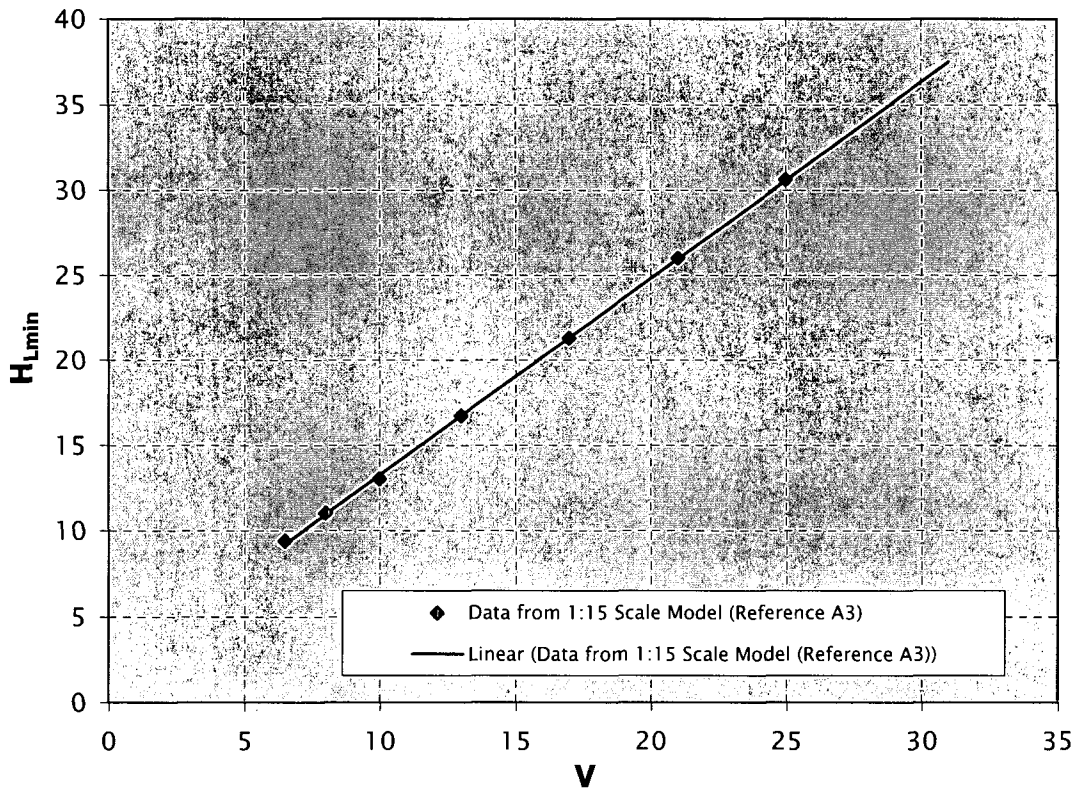

Ft Pat Henry Model Data for Headwater Ratings.xls Free Discharge

Fort Patrick Henry

Definition: $C_f = Q/(L \cdot H_c^{1.5})$

Tainter Gates Raised Above the Water Surface

Data from 1:112.5 scale model (Reference A3)

(equivalent prototype)


L (one bay) = 35 feet

Crest, Z_c = 1228 feet

HW EL. ft	H_c ft.	Q (per bay) cfs	C_f	H_c ft.	4th-order curve fit (see plot) C_f
1233.1	5.1	1330	3.30	0	2.800
1234.61	6.61	1974	3.32	0.5	2.842
1235.61	7.61	2384	3.24	1	2.882
1236.01	8.01	2574	3.24	2	2.956
1236.61	8.61	2904	3.28	4	3.085
1236.81	8.81	3004	3.28	7	3.237
1239.83	11.83	4840	3.40	10	3.353
1244.17	16.17	7994	3.51	15	3.491
1241.14	13.14	5,716	3.43	20	3.598
1248.82	20.82	11,990	3.61	25	3.698
1252.98	24.98	16,140	3.69	30	3.803
1255.62	27.62	19,100	3.76	35	3.910
1258.98	30.98	22,950	3.80	40	4.000
1247.05	19.05	10,310	3.54		
1260.41	32.41	24,890	3.85		
1262.34	34.34	27,330	3.88		
1264.07	36.07	29,570	3.90		

Free Discharge Coefficient, $C_f(H_c)$

Fort Patrick Henry

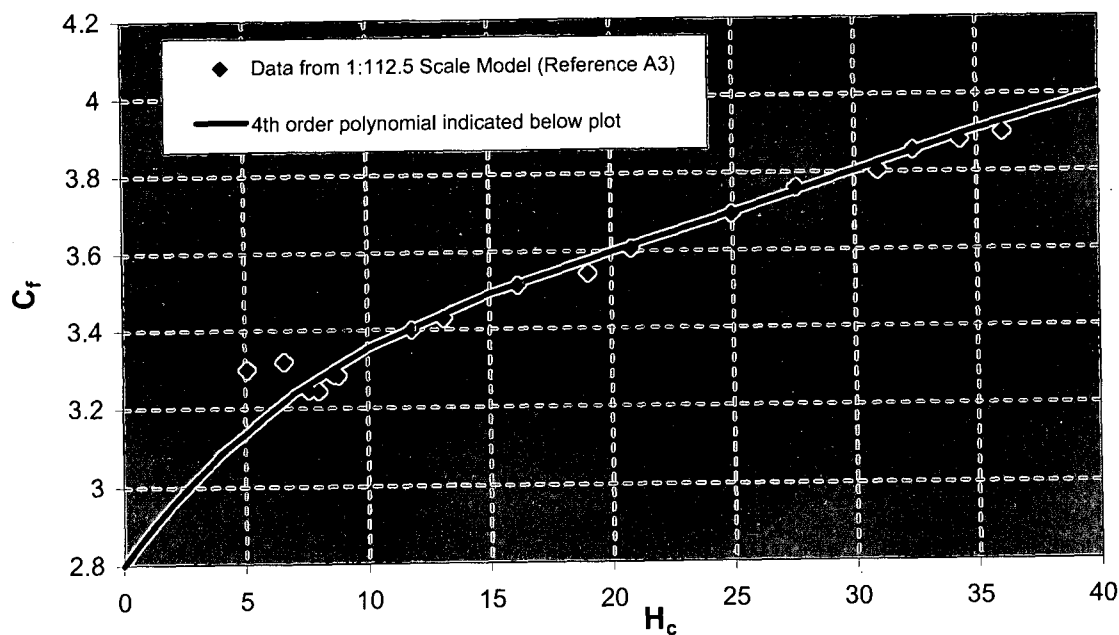

Fort Patrick Henry Project, Tainter Gates Partially Opened
Data from 1:15 scale model as published in Reference A3

Definition: $C_g = Q / \{G_n \cdot L \cdot \sqrt{2 \cdot g \cdot (H_c - H_{mp})}\}$

$H_c = HW - Z_c$

$g = 32.2 \text{ ft/s}^2$


$Z_c = 1228 \text{ ft}$

$L = 35 \text{ ft}$


	Model Test Data In Prototype Dimensions				Geometry		C_g
	V ft	HW ft	H_c ft	Q cfs	G_n ft	H_{mp} ft	
$H_c = H_{Lmin}$	10.00		13	5646	10.139	4.951	0.699
	10.00	1242.07	14.07	5774	10.139	4.951	0.671
	10.00	1243.06	15.06	5950	10.139	4.951	0.657
	10.00	1246.54	18.54	6816	10.139	4.951	0.649
	10.00	1251.52	23.52	7989	10.139	4.951	0.651
	10.00	1256.92	28.92	9229	10.139	4.951	0.662
	10.00	1259.82	31.82	9763	10.139	4.951	0.661
	10.00	1260.99	32.99	9986	10.139	4.951	0.662
	10.00		60				0.662 *
$H_c = H_{Lmin}$	13.00		16.7	8430	13.118	6.462	0.715
	13.00	1245.28	17.28	8320	13.118	6.462	0.687
	13.00	1245.48	17.48	8349	13.118	6.462	0.683
	13.00	1246.26	18.26	8476	13.118	6.462	0.670
	13.00	1247.46	19.46	8844	13.118	6.462	0.666
	13.00	1249.39	21.39	9454	13.118	6.462	0.664
	13.00	1254.64	26.64	11030	13.118	6.462	0.666
	13.00	1258.86	30.86	12190	13.118	6.462	0.670
	13.00	1264.27	36.27	13550	13.118	6.462	0.674
	13.00		60				0.674 *
$H_c = H_{Lmin}$	17.00		21.3	12467	17.123	8.464	0.724
	17.00	1250.14	22.14	12470	17.123	8.464	0.701
	17.00	1251.49	23.49	12820	17.123	8.464	0.688
	17.00	1252.05	24.05	12990	17.123	8.464	0.684
	17.00	1252.83	24.83	13270	17.123	8.464	0.682
	17.00	1257.72	29.72	15060	17.123	8.464	0.679
	17.00	1260.39	32.39	15970	17.123	8.464	0.679
	17.00	1263.96	35.96	17160	17.123	8.464	0.680
	17.00		45				0.685 *
	17.00		60				0.685 *
$H_c = H_{Lmin}$	21.00		26	17254	21.165	10.456	0.736
	21.00	1255.22	27.22	17360	21.165	10.456	0.713
	21.00	1255.51	27.51	17380	21.165	10.456	0.708
	21.00	1255.82	27.82	17450	21.165	10.456	0.704
	21.00	1256.14	28.14	17520	21.165	10.456	0.701
	21.00	1257.61	29.61	18050	21.165	10.456	0.694
	21.00	1257.61	29.61	18150	21.165	10.456	0.698
	21.00	1258.22	30.22	18340	21.165	10.456	0.694
	21.00	1260.34	32.34	19240	21.165	10.456	0.692
	21.00	1264.16	36.16	20630	21.165	10.456	0.684
	21.00		50				0.693 *
	21.00		60				0.693 *
$H_c = H_{Lmin}$	25.00		30.6	22608	25.255	12.436	0.748
	25.00	1261.26	33.26	23300	25.255	12.436	0.720
	25.00	1261.78	33.78	23490	25.255	12.436	0.717
	25.00	1262.59	34.59	23750	25.255	12.436	0.711
	25.00	1262.89	34.89	23880	25.255	12.436	0.710
	25.00	1263.49	35.49	24090	25.255	12.436	0.707
	25.00	1263.99	35.99	24260	25.255	12.436	0.705
	25.00		40				0.697 *
	25.00		55				0.703 *
	25.00		60				0.703 *
$H_c = H_{Lmin}$	31.00		37.5	31819	31.540	15.375	0.764
	31.00		42				0.720 *
	31.00		48				0.712 *
	31.00		58				0.720
	31.00		60				0.720 *

* Value of C_g is estimated; no model data, so no value for Q; geometrical parameters not needed

Ft. Patrick Henry 1:15 Scale Model

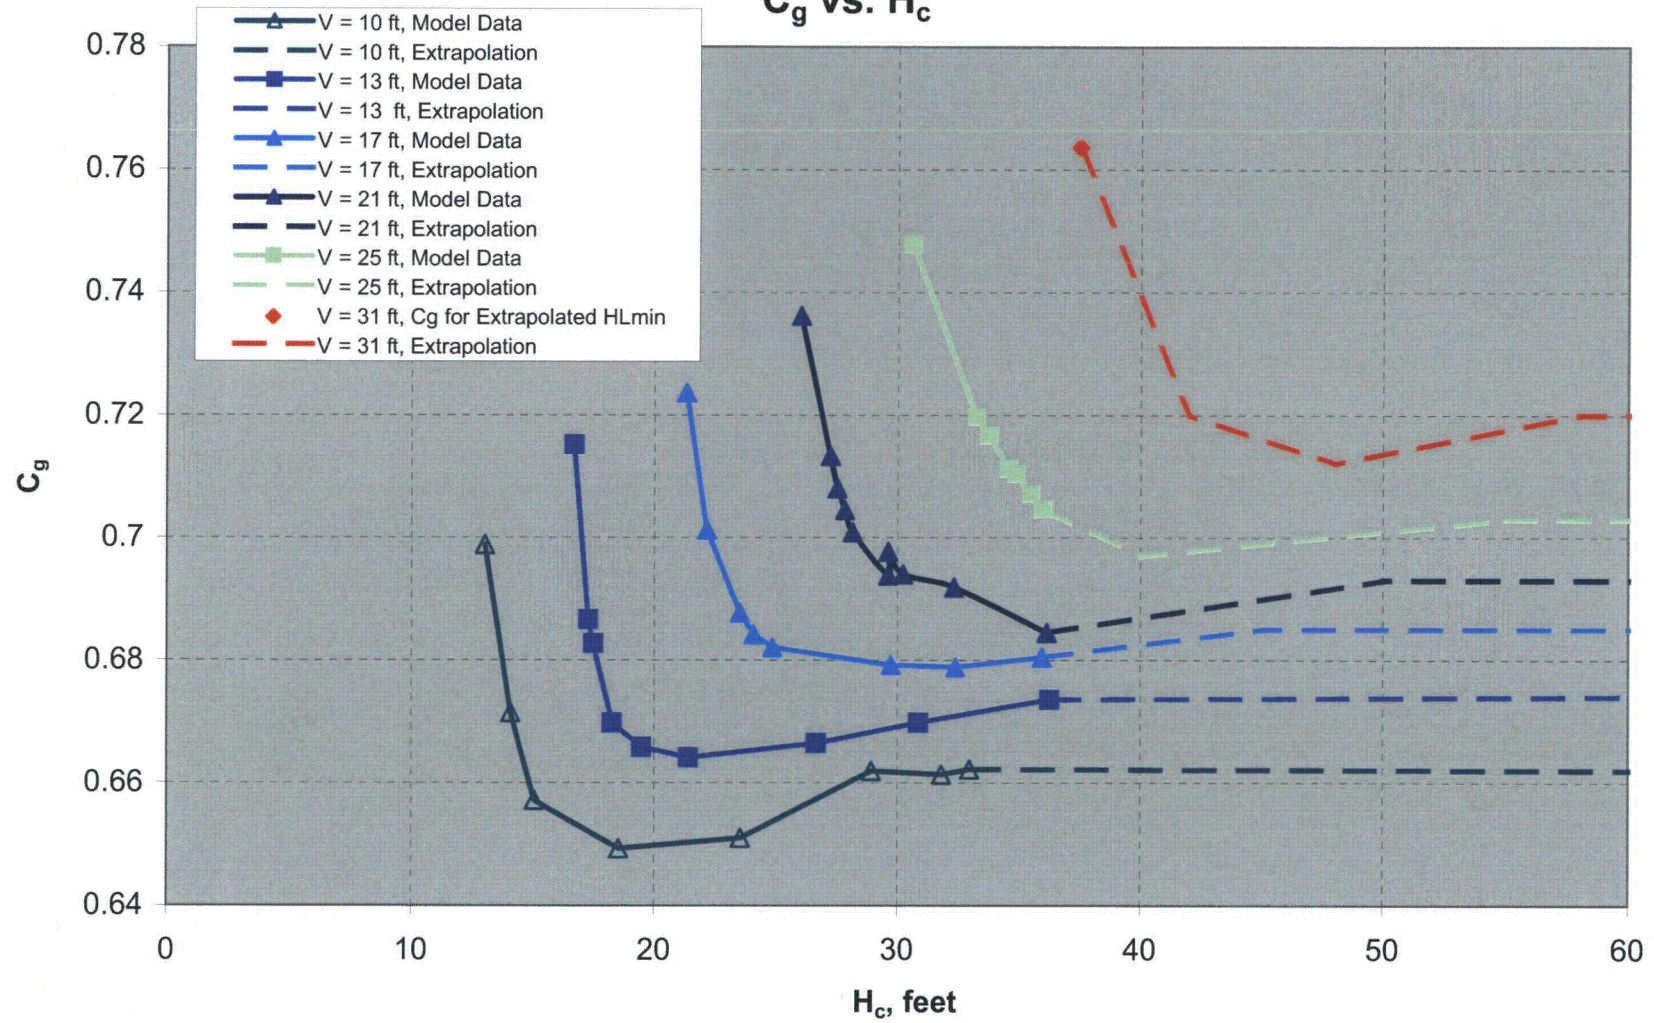 C_g vs. H_c 

Red circles indicate Fort Patrick Henry values determined or estimated from 1:15 scale model data

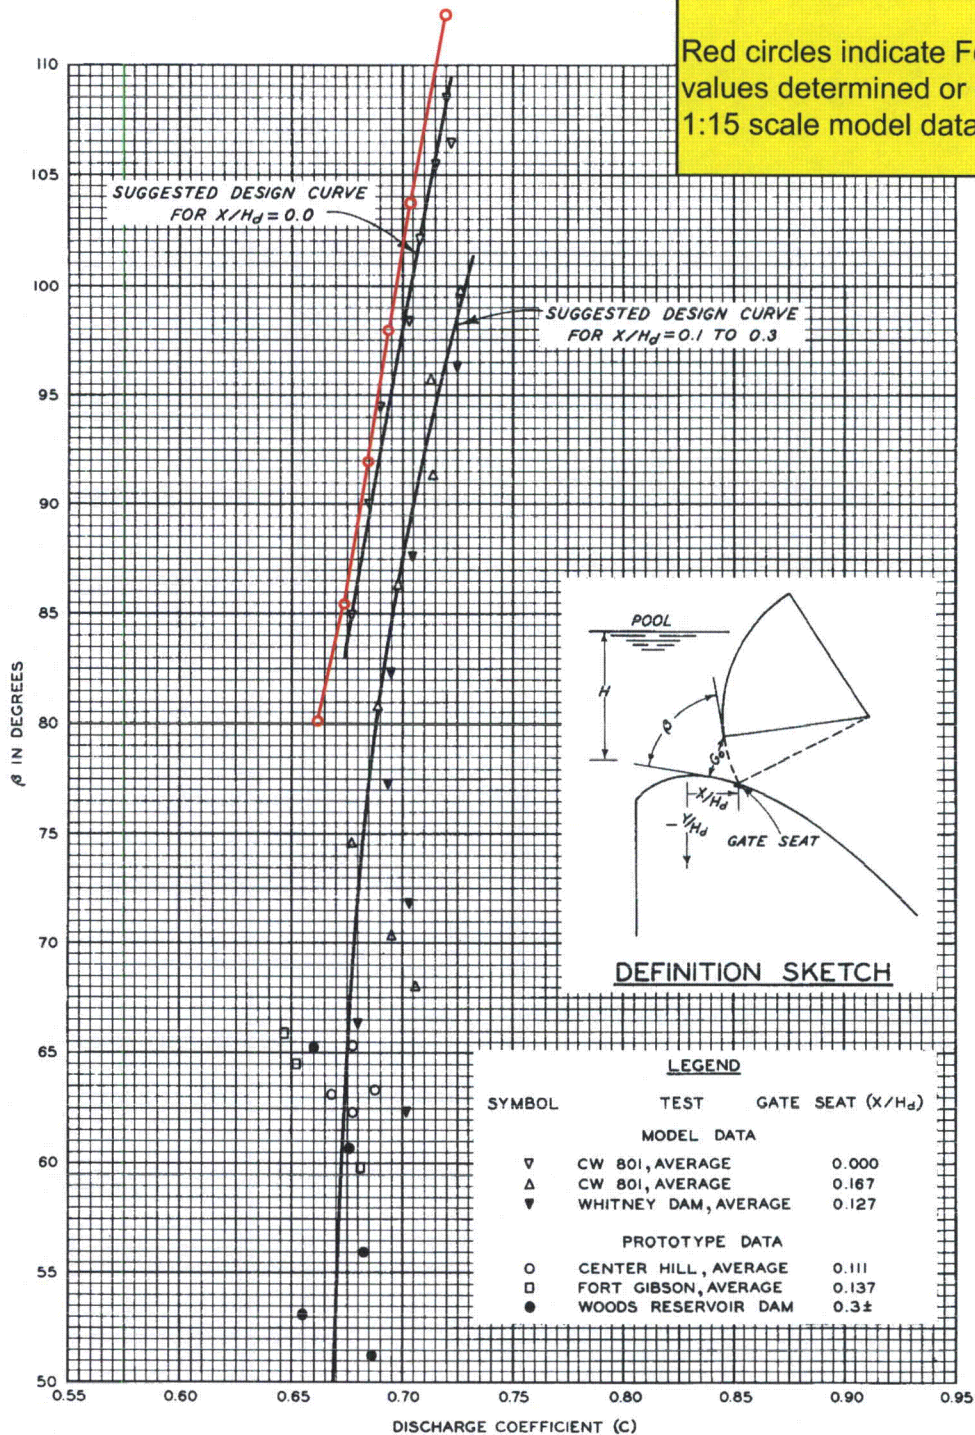

FORMULA

$$Q = C G_o B \sqrt{2gH}$$

WHERE:

G_o = NET GATE OPENING
 B = GATE WIDTH
 H = HEAD TO CENTER OF GATE OPENING

**TAINTER GATES ON
SPILLWAY CRESTS
DISCHARGE COEFFICIENTS**

HYDRAULIC DESIGN CHART 311-1

Source: Reference A7

Tennessee Valley Authority

Tainter Gate Ratings
Basic Model and Prototype Data

Project	Model Scale	No. of Spill- way Bays	MODEL		Up- stream Depth P	PROTOTYPE		
			Crest Length L	Approach Width W		Crest Elev.	Design Head H _o	Pier Nose Radius R
Apalachia	1:28.72	6	6.684	8.00	3.38	1257.0	23.0	3.00
Boone	1:50	5	3.480	(1)	(1)	1350.0	35.0	12.75 ⁽²⁾ 11.25 ⁽³⁾
Ft. Patrick Henry	1:15	1	2.333 ⁽⁵⁾	2.77 ⁽⁵⁾	2.29	1228.0	35.0	3.50 ⁽⁴⁾ 3.25
Hales Bar	1:34.76	6	6.908 ⁽⁶⁾ 6.905 ⁽⁷⁾	7.94	0.921	616.0	18.0	3.00
Hiwassee	1:55	7	4.050	8.00	6.35	1503.5		3.00
Watts Bar	1:35	6	6.866	8.00	1.5	713.0	23.5	3.25
Wheeler	1:34.35	6	6.984	7.97	1.253	541.3	16.5	2.50

- ° (1) Variable because approach was reproduced in model.
- (2) Right end pier.
- v (3) Left end pier.
- (4) Intermediate piers.
- (5) Except as noted on data tabulations.
- (6) Gates partially opened.
- (7) Gates raised above water surface.

TVA

Calculation No. CDQ000020080010	Rev: 1	Plant: GEN	Page: B1
Subject: Dam Rating Curve, Fort Patrick Henry	Prepared C.Grace		
	Checked A. Murr		

Appendix B

|

TVA

Calculation No. CDQ000020080010	Rev: 1	Plant: GEN	Page: B2
Subject: Dam Rating Curve, Fort Patrick Henry	Prepared C.Grace		
	Checked A. Murr		

Appendix B: Hydrostatic Loads on the Spillway Tainter Gates

The hydrostatic loads on the spillway tainter gates for Fort Patrick Henry Dam can be found in the following calculations.

B1 References

B1. "Watts Bar Dam – Flood and Earthquake Analysis on Radial Spillway Gates, pages 76-100" Tennessee Valley Authority, HEPE3WBHSQN-WBNBLNBFN.

B2. Calculations

Reference B1 evaluates the structural capacity of the radial spillway gates at Watts Bar Dam. This reference was used as a basis for evaluating the margin between the forces on the closed gates (FR_{closed}) when the headwater elevation is at the top of the gate (1263 feet) and when the gates are completely open (FR_{open}) and the headwater elevation is at 1288 feet at Fort Patrick Henry Dam. The margin is defined as the ration of FR_{open} to FR_{closed} . The calculation of these forces and the results of this comparison are shown in Figure B1.

Calculation No. CDQ000020080010	Rev: 1	Plant: GEN	Page: B3
Subject: Dam Rating Curve, Fort Patrick Henry	Prepared C.Grace		
	Checked A. Murr		

Comparison of forces when gates are closed and HW is at 1263 feet (top of gate) vs. when gates are fully open and HW at an elevation of 1288 feet.			
Attribute	Symbol	Value	
top elev	Zo	1263	
trun elev	Ztr	1241	
sill elev	Zsill	1227.41	
radius	R	36	
length	L	35	
angle up	α_2	37.67	
angle lwr	α	22.18	
angle tot	θ	59.85	
area of lower slice	Aslice1	676.88	
proj area	AProjected	1245.65	
Desgn LdH	FRx	1383179.73	
Result elv	Z1	1239.27	
Result ang deg		2.75	
Result ang rad		0.05	
Result Dsgn	Horiz	1381587.84	
Area slice upper	Aslice2	426.04	
Area triangle	Atriangle	313.45	
project vert	x1	7.50	
vert weight water	FRy	114685.91	
Resultant load - Gates Closed	FR _{closed}	1387926.15	
vert open fm calc	calc App A	31.54	
max hw	calc	1288.00	
lwr lip elev	Z2	1258.95	
bot angle	α_3	29.91	
top elev	Zo	1277.00	
project area for h ld	AProjected	631.74	
Flood LdH	FRx	789401.75	
Height over gate	y1	11.00	
Height ratio to orig		1.70	
project vert	x2	31.05	
Flood LdV1		746039.69	
Flood ILdV2		357525.12	
Total Flood LdV	FRy	1103564.81	
Resultant load - Gates Fully Open	FR _{open}	1356838.39	
Margin	FR _{open} /FR _{closed}	0.98	

Figure B1: Ft. Patrick Henry Spillway Gate Margin Evaluation

Calculation No. CDQ000020080010	Rev: 1	Plant: GEN	Page: B4
Subject: Dam Rating Curve, Fort Patrick Henry	Prepared C. Grace		
	Checked A. Murr		

BWSC

BARGE
WAGGONER
SUMNER &
CANNON, INC.

Project: Hydrostatic Force on Gate

Description: Diagram

Project No. _____ Sheet No. _____ of _____

Designer: _____ Date: _____

Checker: _____ Date: _____

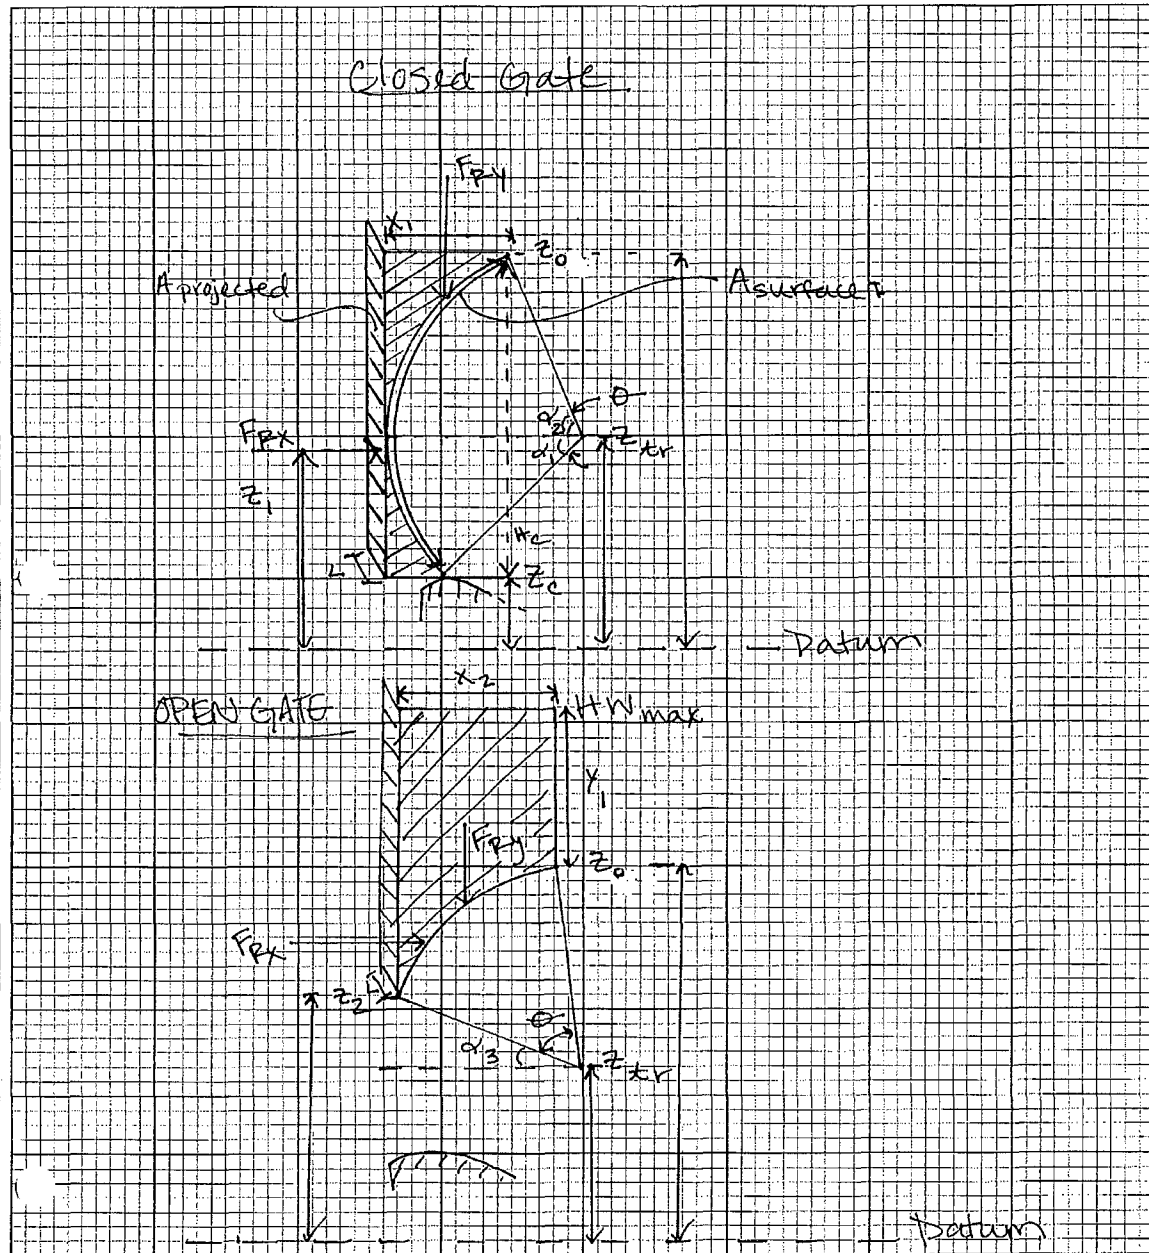


Figure B2: Diagram of Hydrostatic Forces

00ZW00 C 32

2

3

4

5

6

7

8

9

10

11

12

A

B

C


D

E


F

G


H

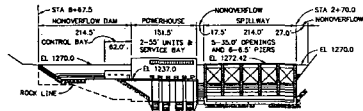


DOWNSTREAM ELEVATION

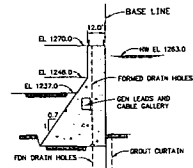


SECTION-NONOVERFLOW DAM

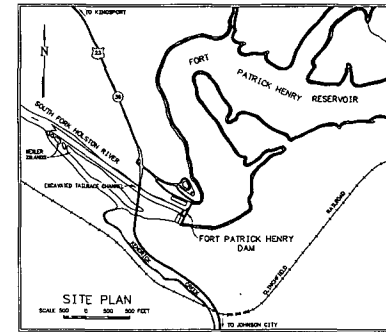


SITE PLAN

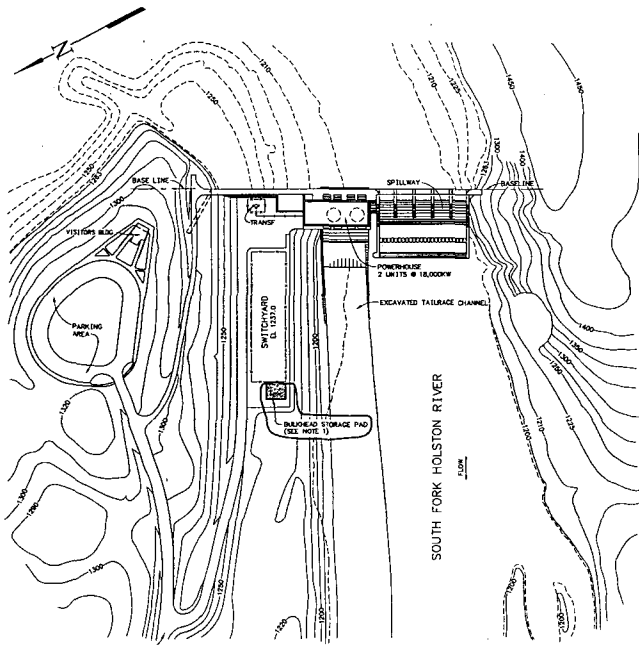


PLAN

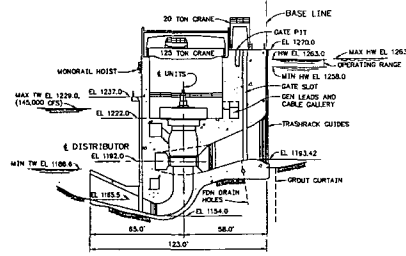

SECTION-POWERHOUSE

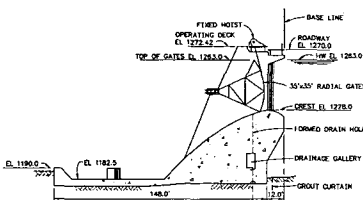

SECTION-SPILLWAY

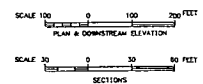

NOTES
1. FOR BULKHEAD STORAGE PAD DETAILS, SEE SHEET 710W200

NO.	DATE	BY	CHKD.	APP'D.	REVISION
1	12/12/2002	W.D.S.	W.D.S.	W.D.S.	GENERAL PLAN & SECTIONS
2	12/12/2002	W.D.S.	W.D.S.	W.D.S.	GENERAL PLAN & SECTIONS
3	12/12/2002	W.D.S.	W.D.S.	W.D.S.	GENERAL PLAN & SECTIONS
4	12/12/2002	W.D.S.	W.D.S.	W.D.S.	GENERAL PLAN & SECTIONS
5	12/12/2002	W.D.S.	W.D.S.	W.D.S.	GENERAL PLAN & SECTIONS
6	12/12/2002	W.D.S.	W.D.S.	W.D.S.	GENERAL PLAN & SECTIONS
7	12/12/2002	W.D.S.	W.D.S.	W.D.S.	GENERAL PLAN & SECTIONS
8	12/12/2002	W.D.S.	W.D.S.	W.D.S.	GENERAL PLAN & SECTIONS
9	12/12/2002	W.D.S.	W.D.S.	W.D.S.	GENERAL PLAN & SECTIONS
10	12/12/2002	W.D.S.	W.D.S.	W.D.S.	GENERAL PLAN & SECTIONS
11	12/12/2002	W.D.S.	W.D.S.	W.D.S.	GENERAL PLAN & SECTIONS
12	12/12/2002	W.D.S.	W.D.S.	W.D.S.	GENERAL PLAN & SECTIONS

SCALE: 1" = 100' 0"

EXCEPT AS NOTED

MAIN DAM WORKS

GENERAL PLAN
ELEVATION & SECTIONS


DESIGNED BY	DRAWN BY	CHECKED BY	APPROVED BY	DATE
W.D.S.	W.D.S.	W.D.S.	W.D.S.	12/12/2002
W.D.S.	W.D.S.	W.D.S.	W.D.S.	12/12/2002
FORT PATRICK HENRY PROJECT
TENNESSEE VALLEY AUTHORITY
RIVER SYSTEMS OPERATIONS

AUTOCAD 2002 7-13-51 32 C 10W200 K 8


ELECTRONICALLY RESTORED DRAWING
THIS DRAWING HAS BEEN COMPLETELY REDRAWN
AND SUPERSEDES (10W200-87)
PLOT FACTOR: 1200
N.T.A.
DO NOT ALTER MANUALLY

TASK COMPLETED BY: REV NO.

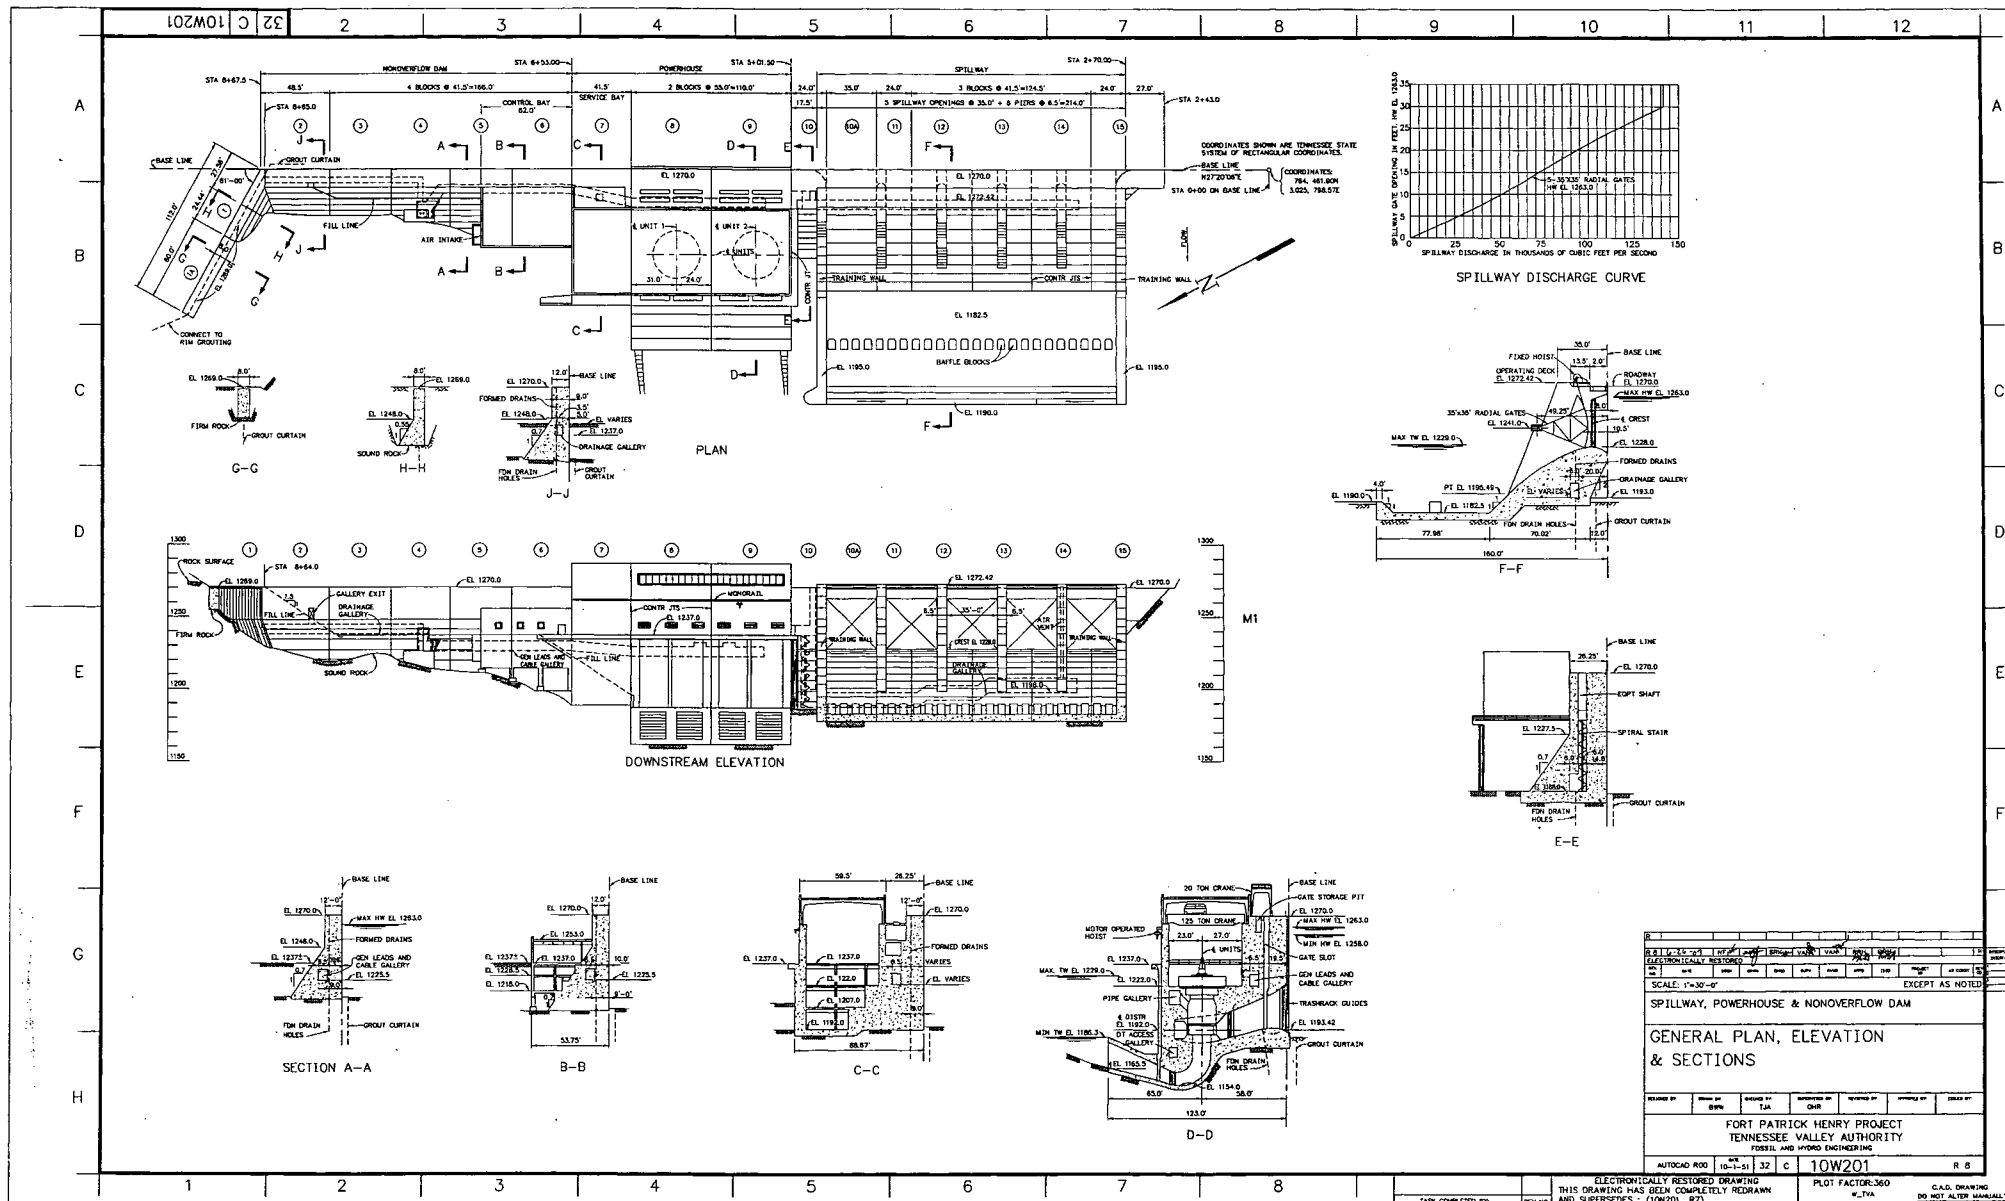


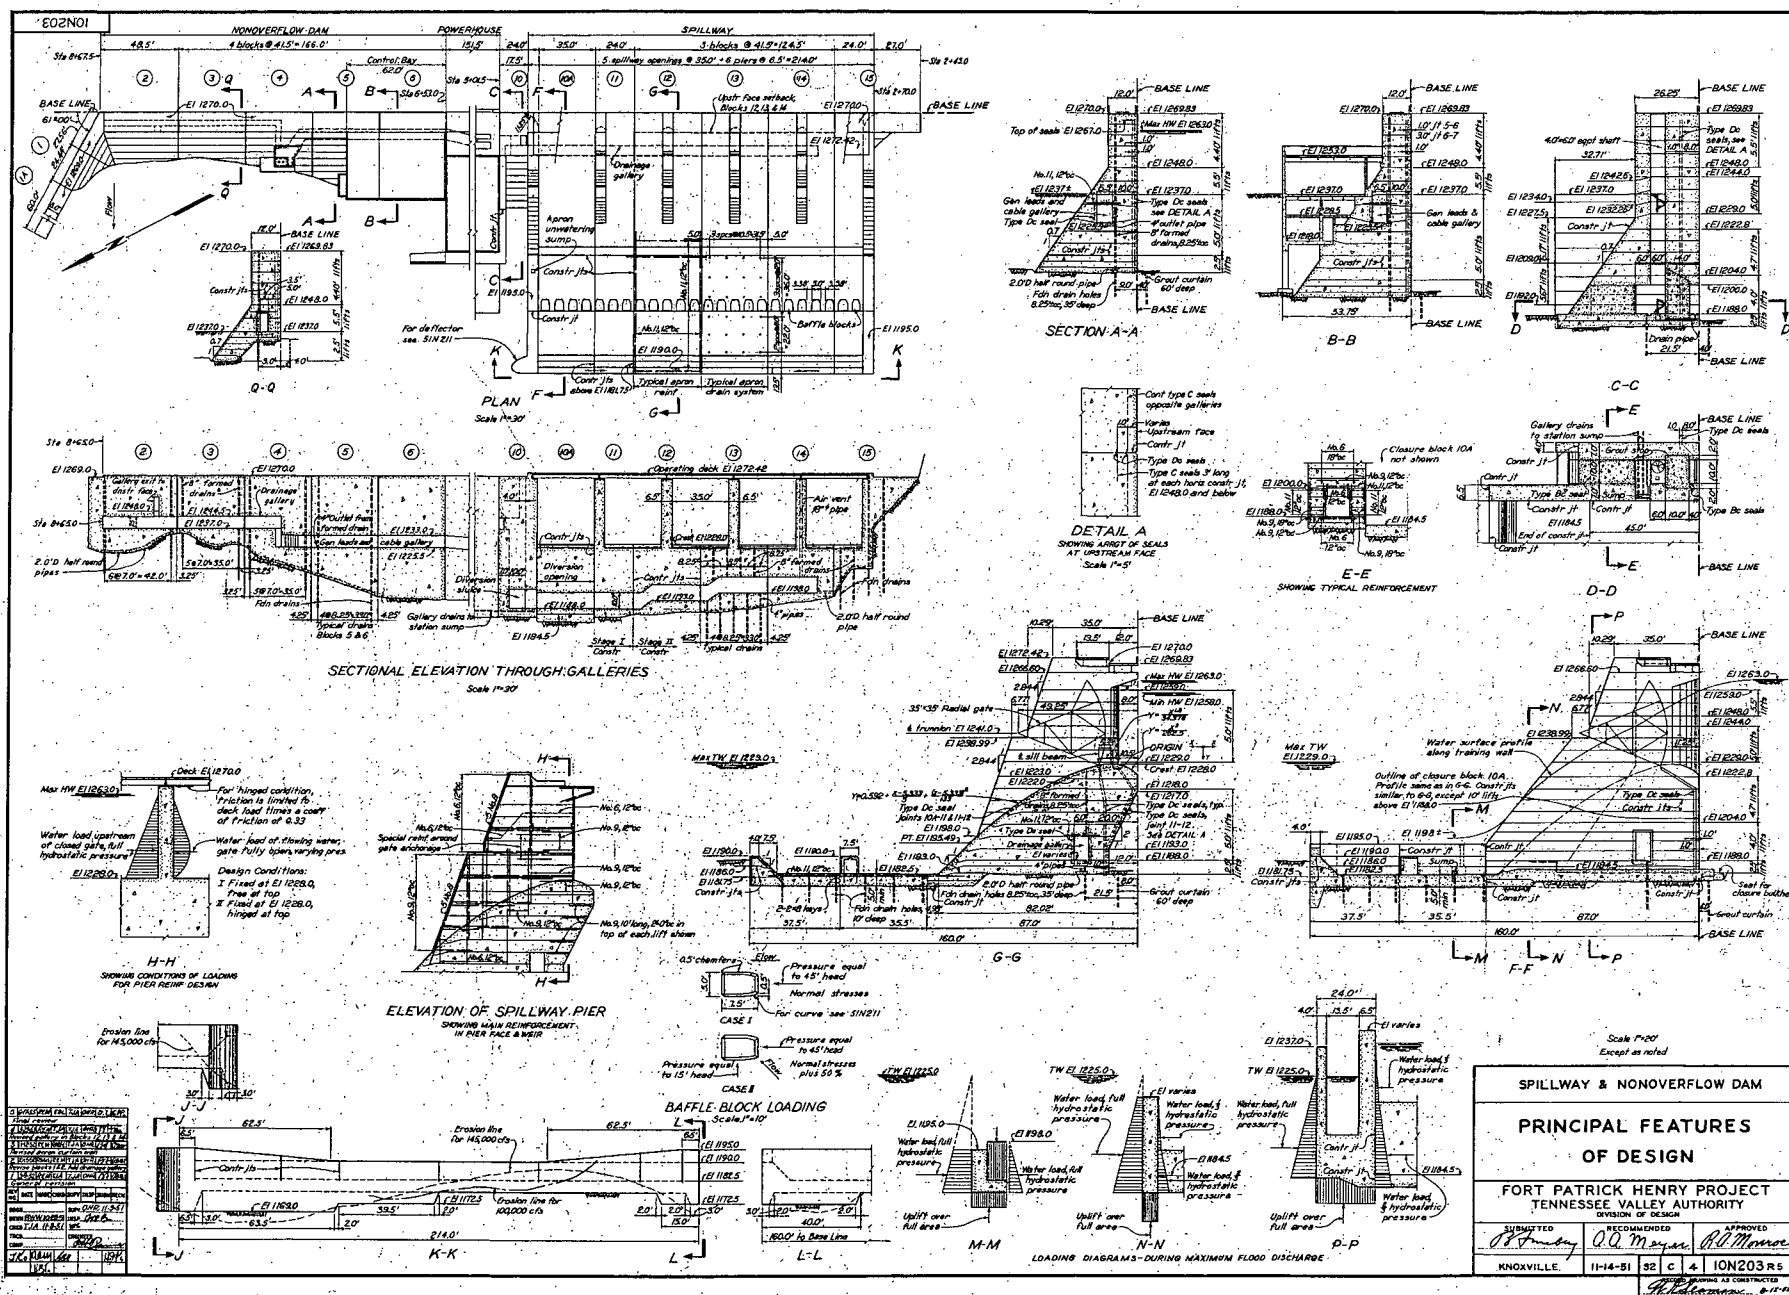

46N401

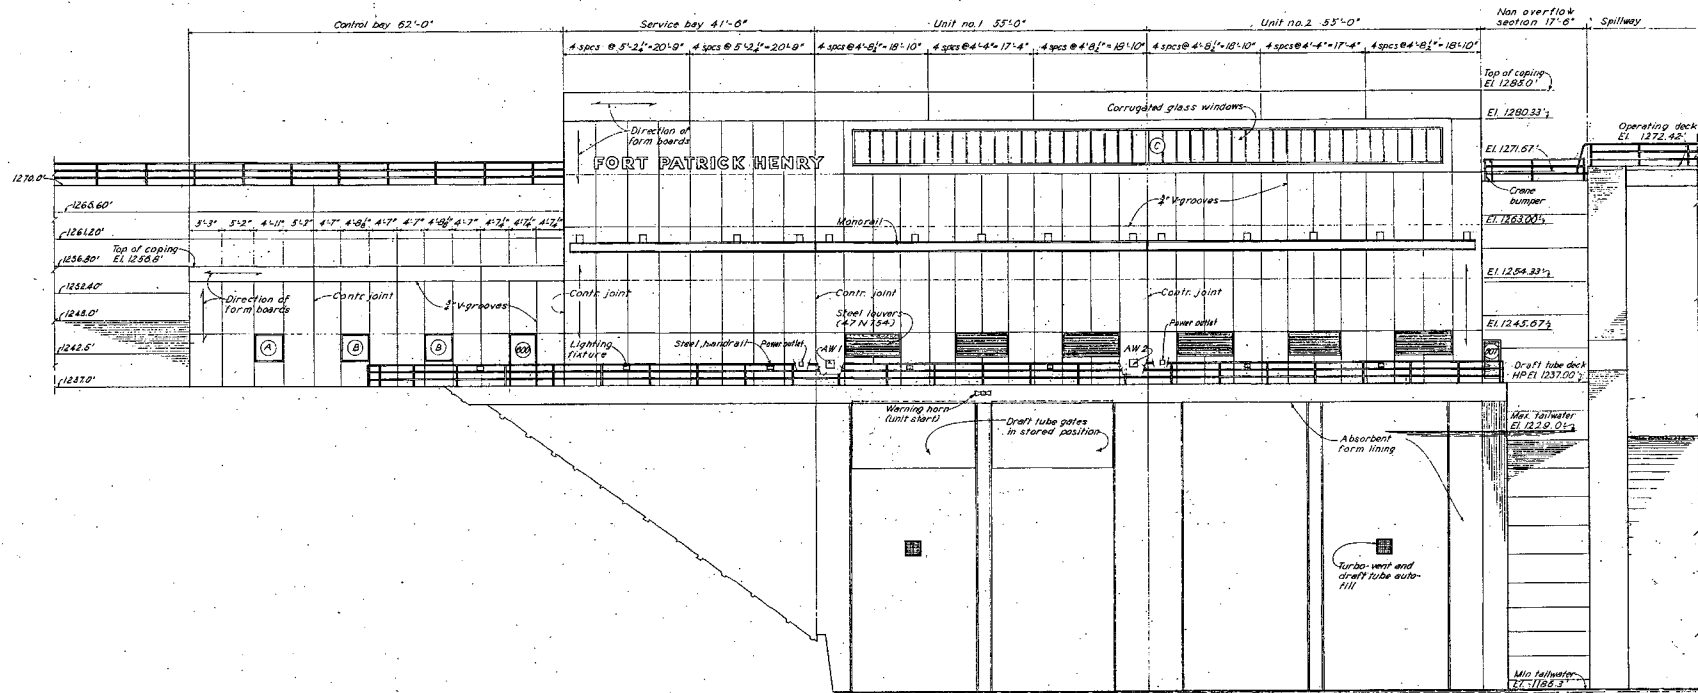

DOWNSTREAM ELEVATION

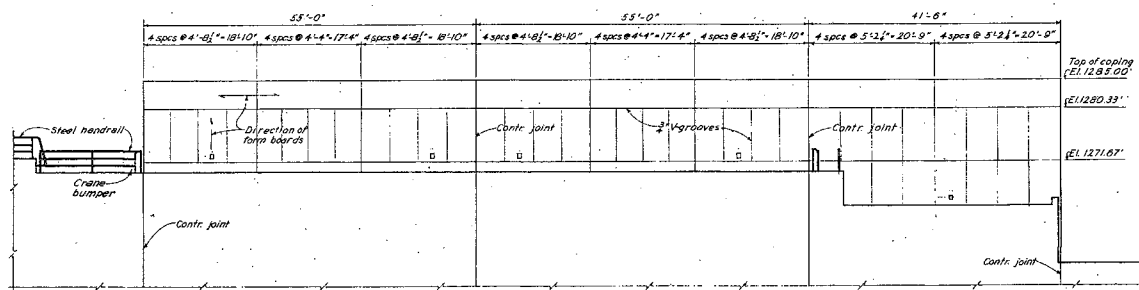

UPSTREAM ELEVATION

NOTES:
 Exterior and interior concrete finishes to be as follows:
 1. Type A plain wood forms, construction Specification 6-8.
 2. Horizontal T&G boards-non-overflow blocks of dam, non-overflow side and downstream face of flowing walls, all interior concrete wall surfaces.
 3. T&G boards in directions indicated on exterior elevations.
 4. Absorbent form lining boards, in a vertical direction without horizontal joints between lifts. For location see civil drawings.

Scale: 1/4" = 1'-0"

POWERHOUSE

ARCHITECTURAL
 ELEVATIONS
 SHEET 1


FORT PATRICK HENRY PROJECT
 TENNESSEE VALLEY AUTHORITY
 DIVISION OF DESIGN

SUBMITTED	RECOMMENDED	APPROVED
<i>Handwritten signature</i>	<i>Handwritten signature</i>	<i>Handwritten signature</i>
KNOXVILLE	11-20-56	32 A + 46N401ao


REISSUED DRAWING AS CONSTRUCTED

11/17/56

SECTION J-J
TYPICAL

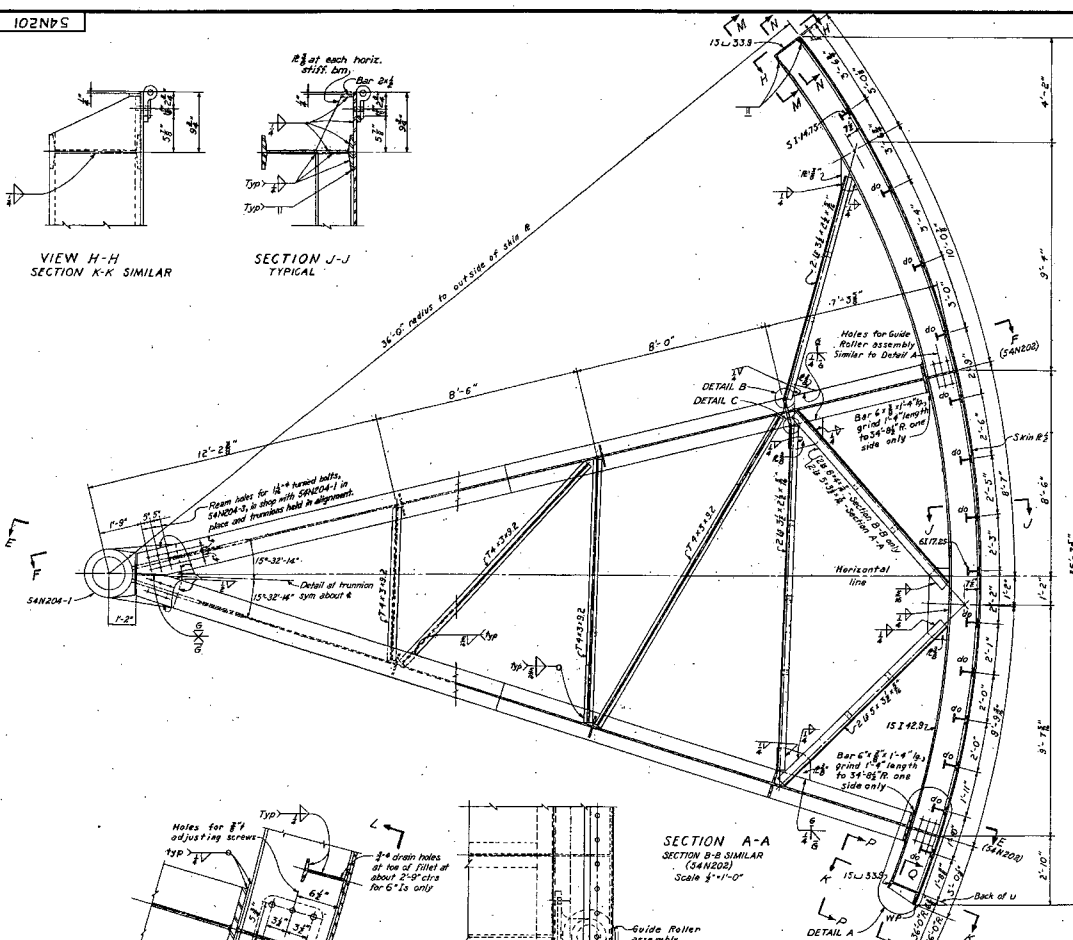


SECTION A-A
SECTION B-B SIMILAR
(54N202)
Scale 4"=1'-0"

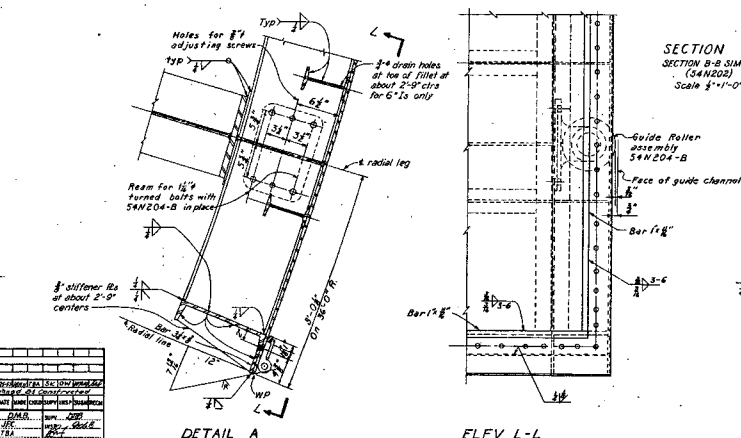


DETAIL A

FLFV L-L

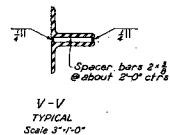

V-V
TYPICAL
Scale 3"-1'-0"

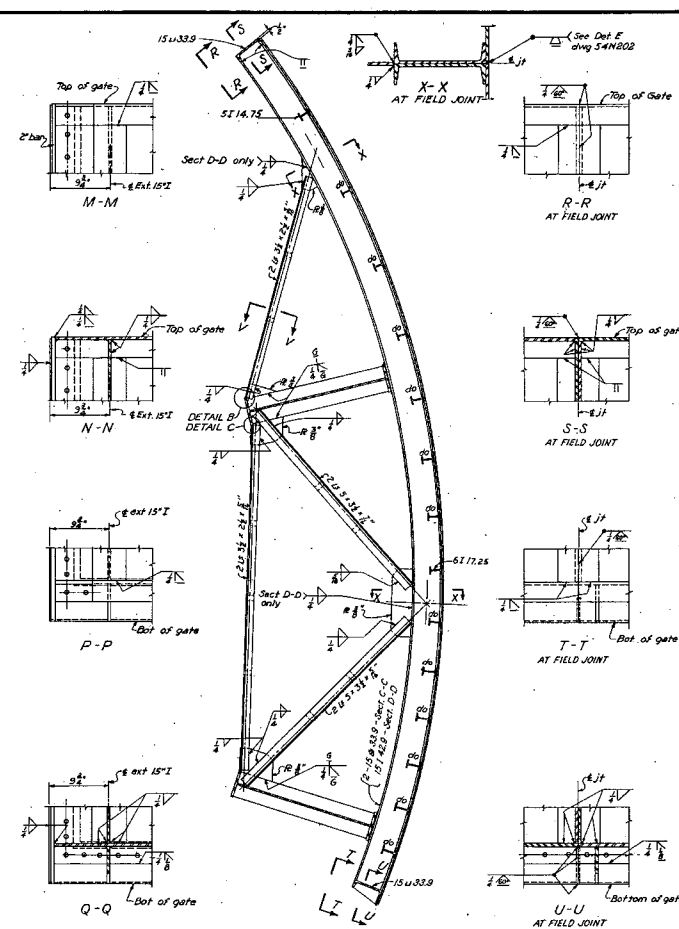

SECTIONS C-C & D-D
(54N202)
Scale $\frac{1}{8}'' = 1'-0''$

For Manufacturers details of Radial Gates refer to
American Bridge Division of United States Steel Corp.
file, TVA Contract No. C-52-13988.

Scale $1\frac{1}{2}'' = 1'-0''$
Except as noted

Scale $1\frac{1}{2}" = 1'-0"$
Except as noted

SPILLWAY
RADIAL GATES
STRUCTURAL DETAILS-SHEET 1


FORT PATRICK HENRY PROJECT
TENNESSEE VALLEY AUTHORITY

SUBMITTED		RECOMMENDED		APPROVED	
<i>W.R. Mathews</i>		<i>H. B. Cole</i>		<i>F.A. Monroe</i>	
KNOXVILLE	6-16-52	32	SH	4	54N201R


KNOXVILLE	6-16-52	32	SH	4	54N201R
-----------	---------	----	----	---	---------

RECORD DRAWING AS CONSTRUCTED


002N200

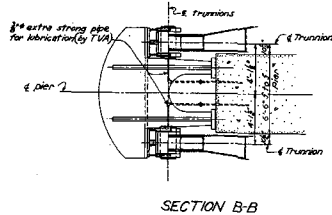


SECTION B-B

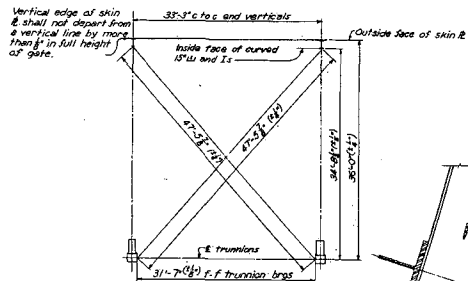


ASSEMBLY TOLERANCES
FOR ANY RADIAL PLANE
Scale 1/4"=1'-0"

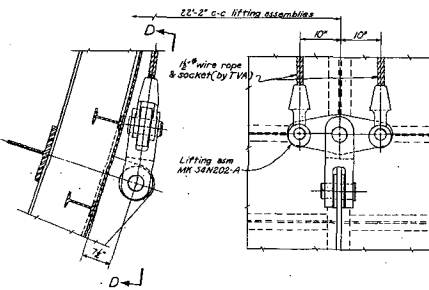


DETAIL B
Scale 1/4"=1'-0"

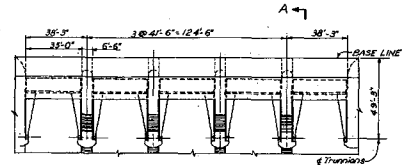

KEY PLAN
Scale 1"=30'

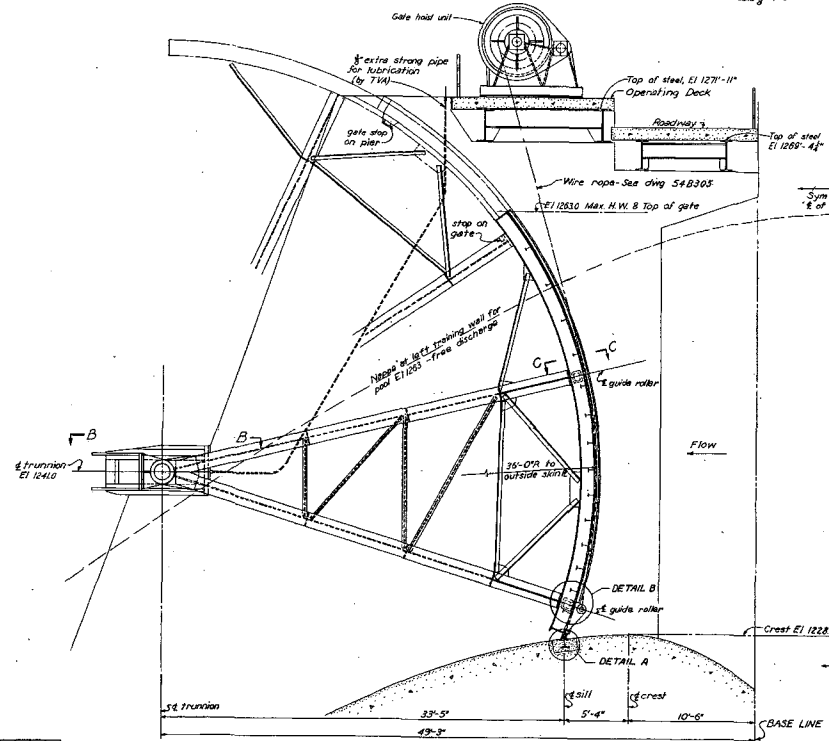


SECTION A-A
5 GATES REQD

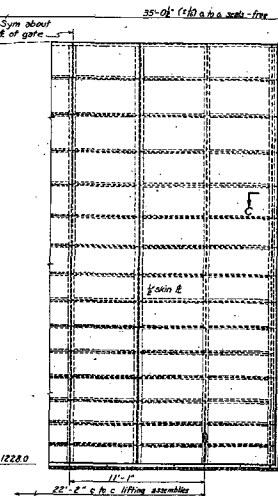


UPSTREAM ELEVATION

ELEVATION D-D
Scale 1/4"=1'-0"

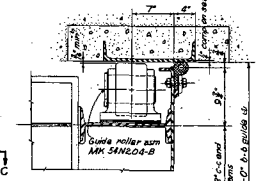

SECTION C-C
Scale 1/4"=1'-0"

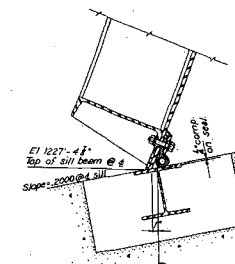

DETAIL A
Scale 1/4"=1'-0"

MARK	DESCRIPTION	QTY REQD	MATERIAL
54N200	Gate Structure	5	Steel
-1	Lifting Bar	10	Steel Tapering
-2	Claws	10	"
-3	Pin & Cotter	20	"
54N200	Bottom Rubber Seal	5	Rubber
-4	Corner Rubber Seal	10	Rubber
-5	Side Rubber Seal	5	Rubber
-6	Seal Bar	5	Steel
-7	Bottom Seal Bar	5	Steel
-8	Seal Bolt	1150	Bolt Steel
-9	Seal Bolt	550	Bolt Steel
-10	Seal Washer	550	Steel
54N200	Gate Trunnion Bearing	10	Steel Casting
-1	Trunnion Bearing Bushing	10	Bronze
-2	Finished Bolts	240	Bolt Steel
-3	Fixed Trunnion Bearing	10	Steel Casting
-4	Trunnion Pin	10	Steel Tapering
-5	Lock Pin	20	Steel
-6	Hex. Hd. Cap. Screw 1/2"x1/2"	40	Bolt Steel
-7	Flat Point Set Screw 1/2"x1/2"	40	Bolt Steel
-8	Flat Point Set Screw 1/2"x1/2"	40	Bolt Steel
-9	Guide Roller	20	Steel Tapering
-10	Guide Roller Bearing	20	Steel Casting
-11	Guide Roller Pin	20	Steel Tapering
-12	Guide Roller Bushing	20	Bronze & Tapering
-13	Lock Plate	20	Steel
-14	Shims	20	Steel
-15	Finished Bolts	60	Steel
-16	Dowel Pins 1/2"x1/2"	120	Steel
-17	Dowel Pins 1/2"x1/2"	80	Steel
-18	Hex. Hd. Cap. Screw 1/2"x1/2"	40	Bronze
-19	Hex. Hd. Cap. Screw 1/2"x1/2"	40	Bronze
-20	Machine Bolts	120	Bolt Steel

Items listed above are for 5 gates. 5 gates reqd.

For Manufacturer's details of Radial Gates refer to American Bridge Division of United States Steel Corp. file, TVA Contract No. C-52-19388.

Scale 1/4"=1'-0"
Except as Noted

SPILLWAY

**RADIAL GATES
ARRANGEMENT**

FORT PATRICK HENRY PROJECT
TENNESSEE VALLEY AUTHORITY













SUBMITTED	RECOMMENDED	APPROVED
W. H. Matthews	A. P. P. P.	H. A. Matthews
KNOXVILLE	6-16-52	32 5H 4

54N200 R1

SECOND DRAWING AS CONSTRUCTED

1-3-55

202N15

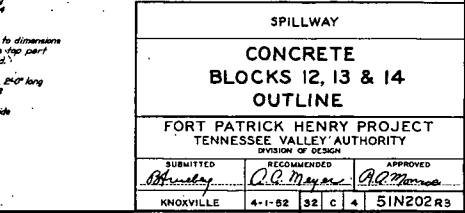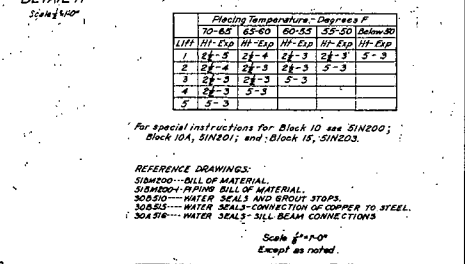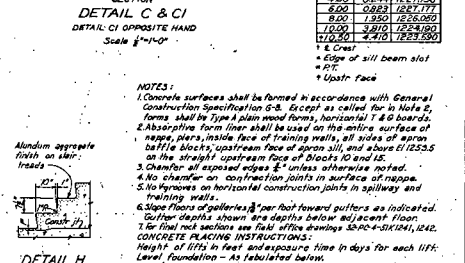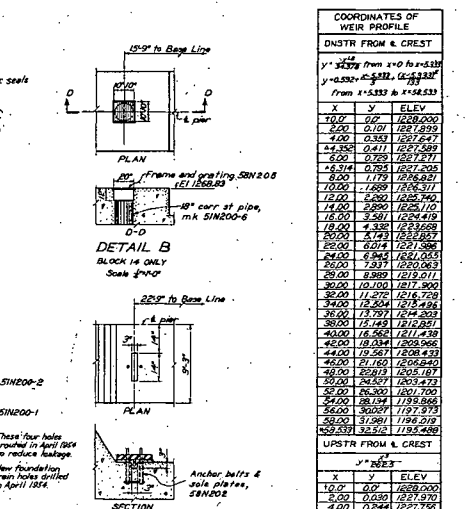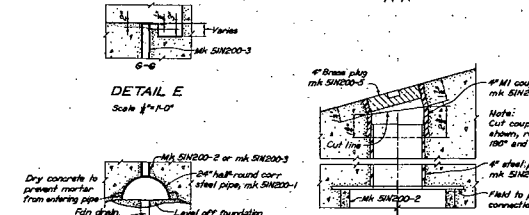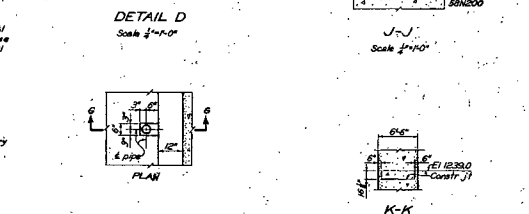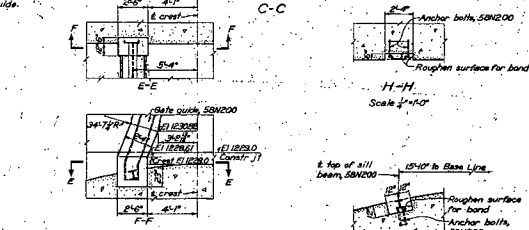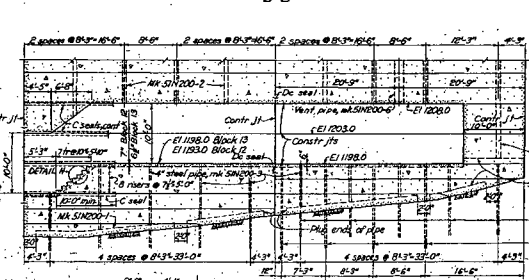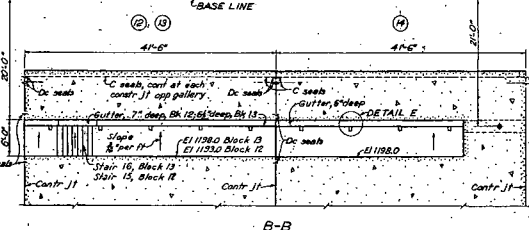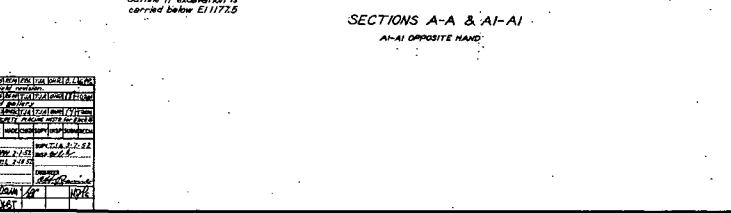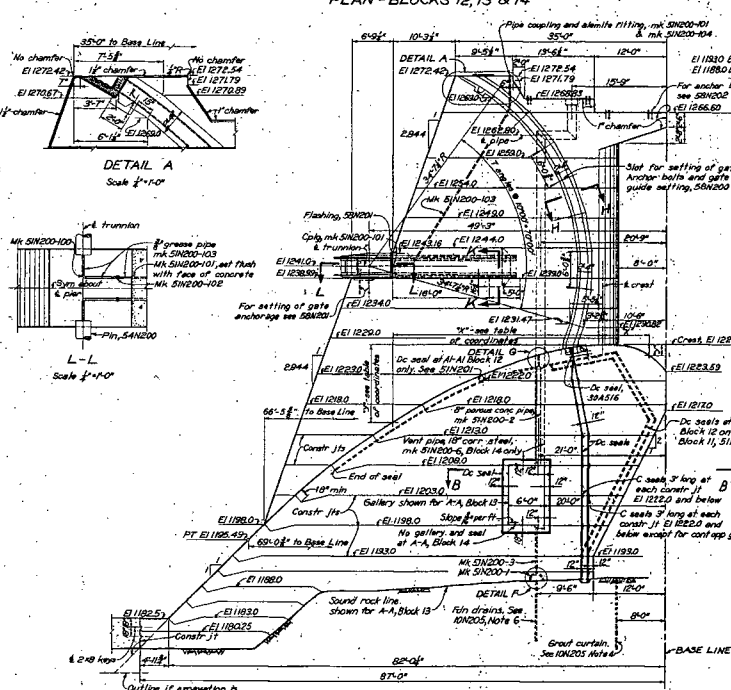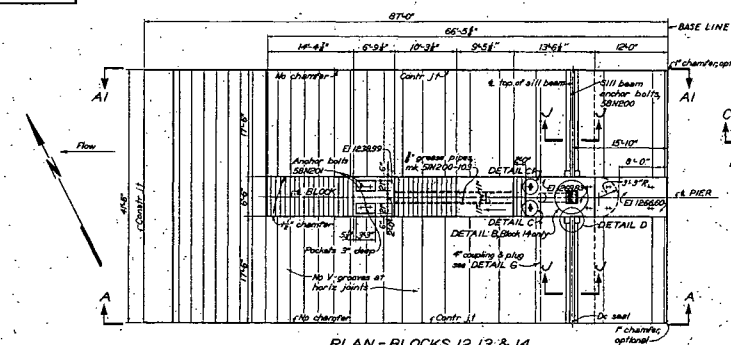

SUBMITTED			
KNOXVILLE			
RECOMMENDED			
KNOXVILLE			
APPROVED			
KNOXVILLE			
KNOXVILLE			