


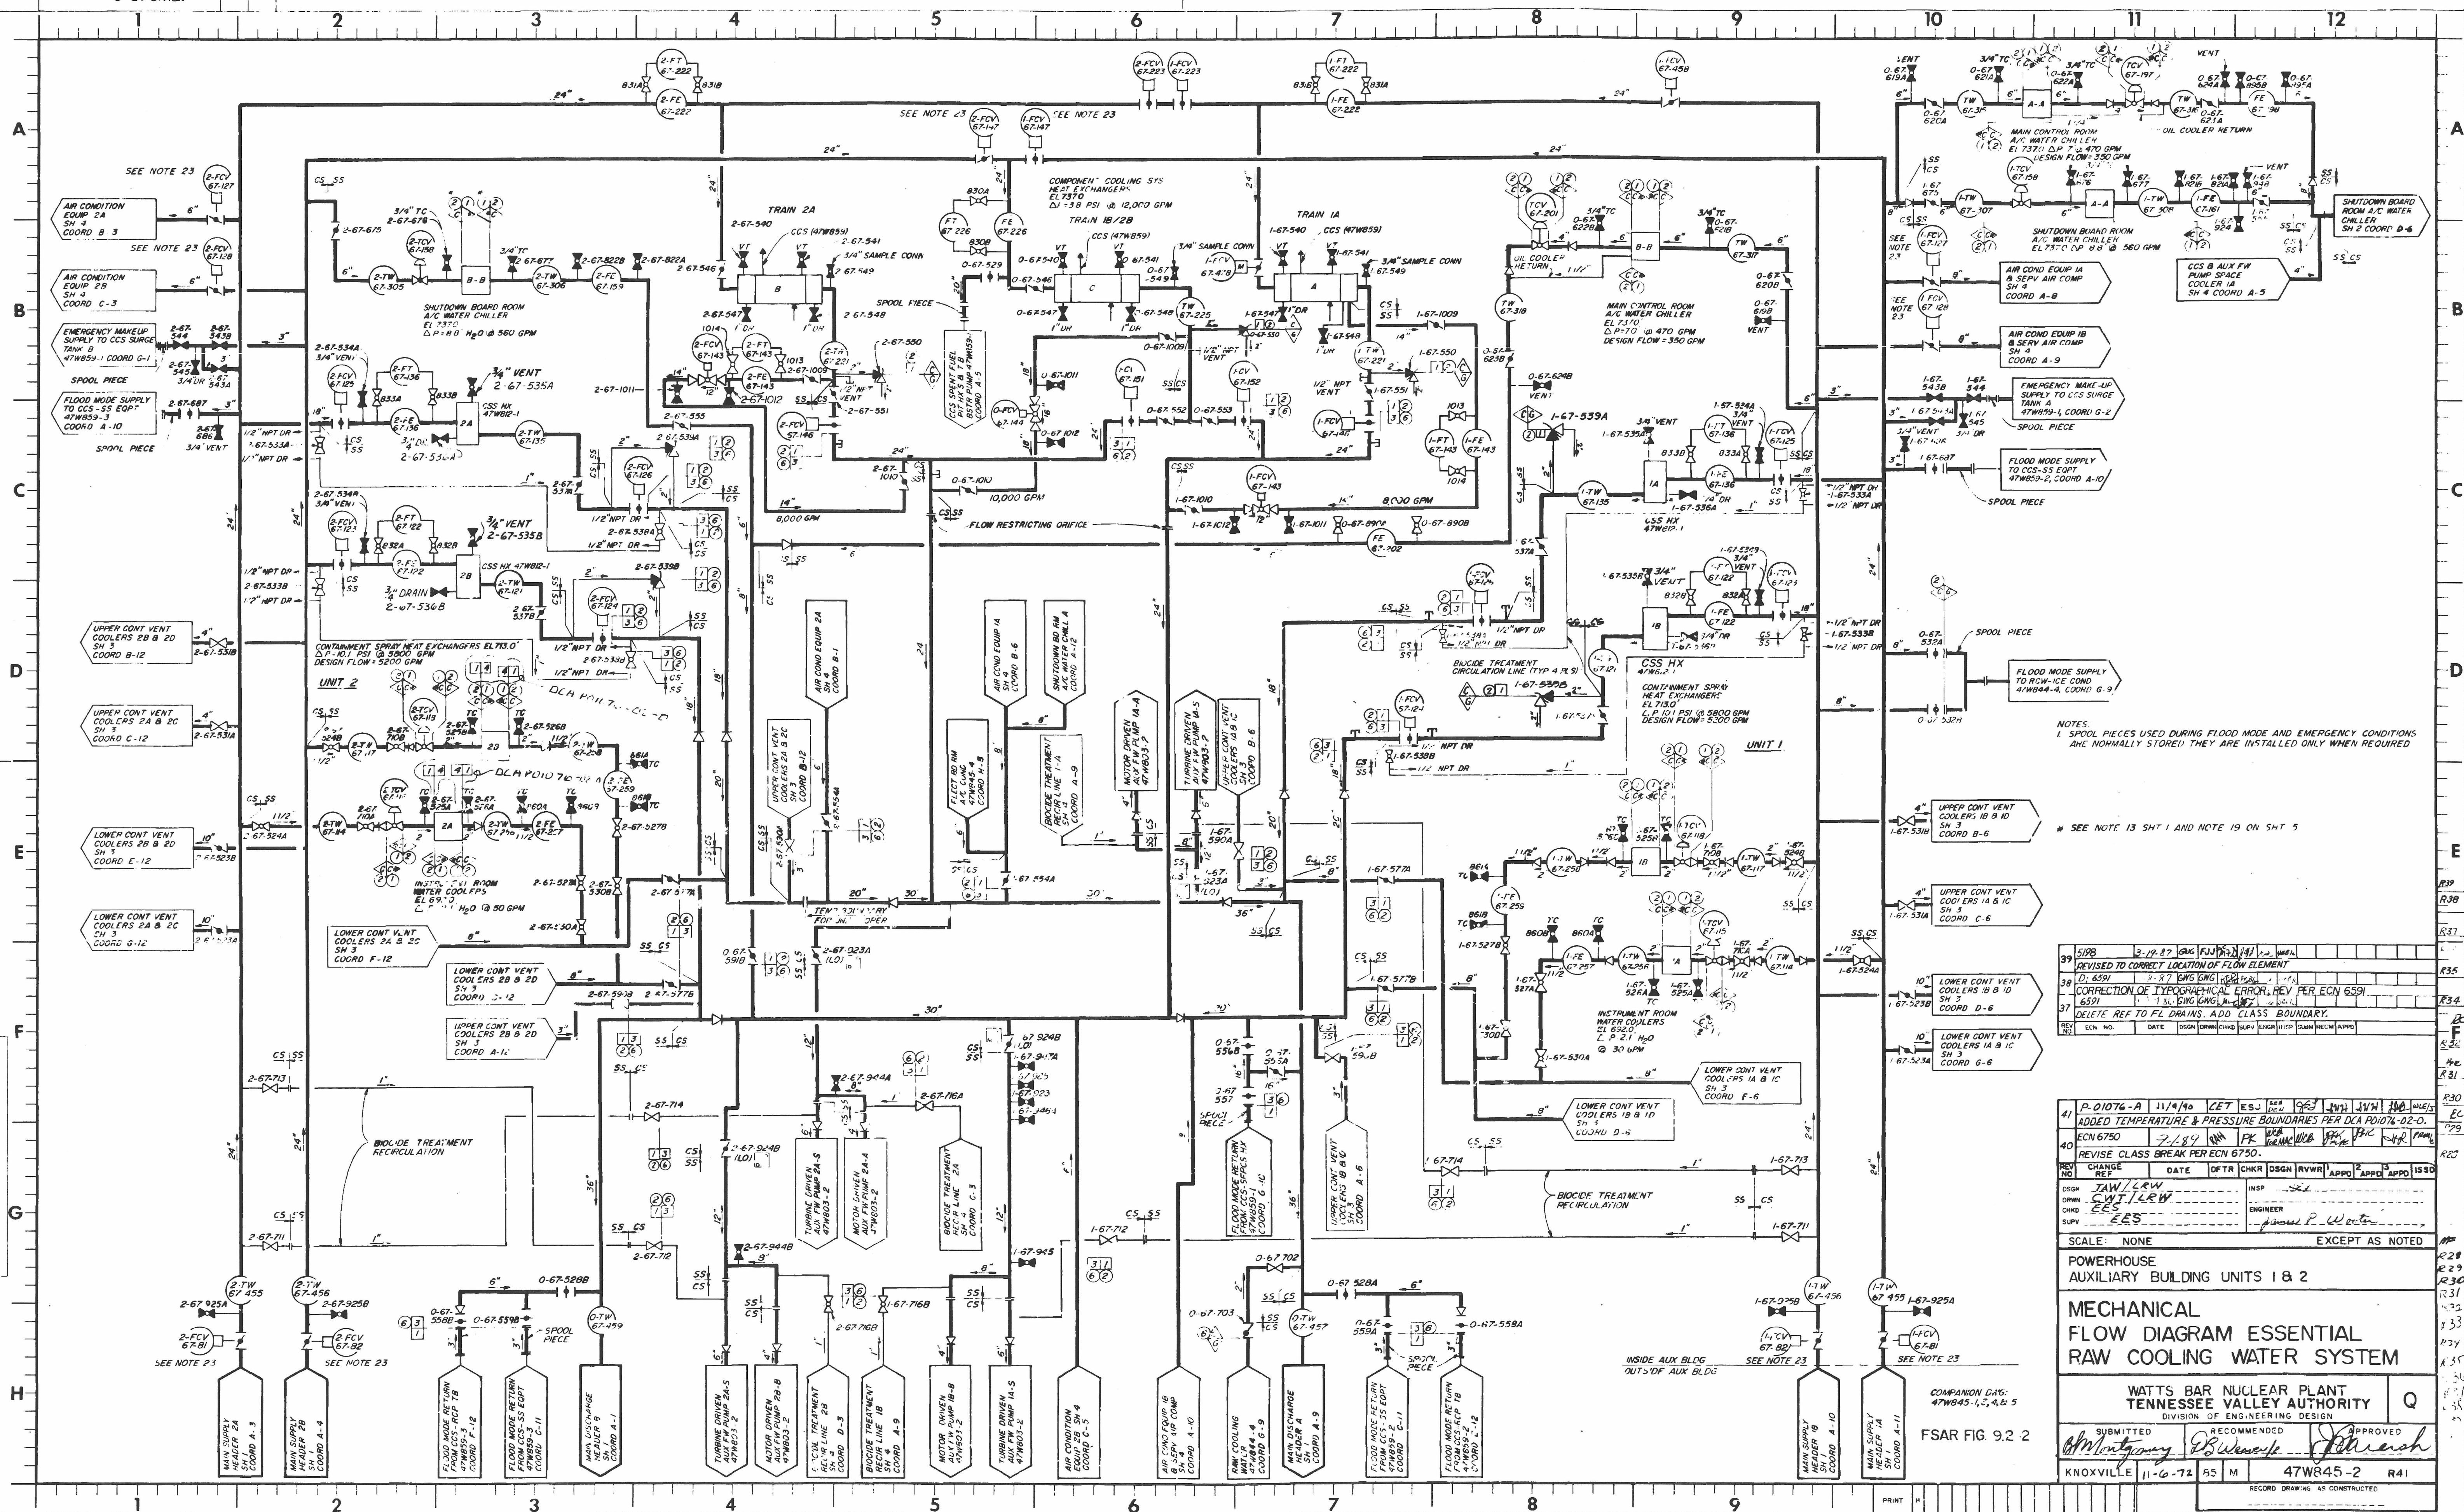

NOTES:
1. SPOOL PIECES USED DURING FLOOD MODE AND EMERGENCY CONDITIONS
AND NORMALLY STORED; THEY ARE INSTALLED ONLY WHEN REQUIRED

* SEE NOTE 13 SHT 1 AND NOTE 19 ON SHT 5

39 5128 11/14/90 [Signature] [Signature] [Signature] [Signature] [Signature] [Signature]
REVISED TO CORRECT LOCATION OF FLOW ELEMENT
38 6559 11/14/90 [Signature] [Signature] [Signature] [Signature] [Signature] [Signature]
CORRECTION OF TYPING ERROR, REV PER EGIN 6591
37 6559 11/14/90 [Signature] [Signature] [Signature] [Signature] [Signature] [Signature]
DELETE REF TO FL DRAINS, ADD CLASS BOUNDARY

41 P-01076-A 11/14/90 CET ESJ [Signature] [Signature] [Signature] [Signature] [Signature] [Signature]
ADDED TEMPERATURE & PRESSURE BOUNDARIES PER DCA P-01076-02-0
ECON 6750 7/18/90 PK [Signature] [Signature] [Signature] [Signature] [Signature] [Signature]
REVISE CLASS BREAK PER ECON 6750

REV NO CHANGE REF DATE DTR CHKR DESG RYWR APPD APPD 1580
DSGN JAW/LRW
CHKD CMT/LEW
SUPV EES
INSPE [Signature]
ENGINEER [Signature]
APPROVED [Signature]

SCALE: NONE EXCEPT AS NOTED

POWERHOUSE
AUXILIARY BUILDING UNITS 1 & 2

MECHANICAL
FLOW DIAGRAM ESSENTIAL
RAW COOLING WATER SYSTEM

WATTS BAR NUCLEAR PLANT
TENNESSEE VALLEY AUTHORITY
DIVISION OF ENGINEERING DESIGN

SUBMITTED: [Signature]
RECOMMENDED: [Signature]
APPROVED: [Signature]

FSAR FIG. 9.2.2

KNOXVILLE 11-6-72 BS M 47WB45-2 R41

RECORD DRAWING AS CONSTRUCTED

PRINT SIZE

PRINTS READ-R

COMPANION DGS:
47WB45-1, 47WB45-3

INSIDE AUX BLDG
OUTSIDE AUX BLDG

SEE NOTE 23

SEE NOTE 23

