



**Entergy Nuclear South**  
Entergy Operations, Inc.  
17265 River Road  
Killona, LA 70057-3093  
Tel 504 739 6660  
Fax 504 739 6678  
jkowale@entergy.com

**Joseph A. Kowalewski**  
Vice President, Operations  
Waterford 3

W3F1-2010-0050

June 8, 2010

U.S. Nuclear Regulatory Commission  
Attn: Document Control Desk  
Washington, DC 20555-0001

**Subject:** Response to Request for Additional Information Associated with  
Technical Specification Table 3.4-1 Isolation Valve Addition  
Waterford Steam Electric Station Unit 3  
Docket No. 50-382  
License No. NPF-38

**REFERENCES:**

1. W3F1-2010-0019, Technical Specification Table 3.4-1 Isolation Valve Addition, February 22, 2010.
2. NRC Letter, Request for Additional Information Re: Technical Specification Table 3.4-1 Isolation Valve Addition, April 14, 2010 [ADAMS Accession Number ML101040651].

Dear Sir or Madam:

In Reference 1, Entergy Operations, Inc. (Entergy) proposed a change to Waterford Steam Electric Station Unit 3 (Waterford 3) Technical Specifications (TS) Table 3.4-1 Isolation Valve Addition.

During the submittal review process, the Nuclear Regulatory Commission (NRC) determined that a Request for Additional Information (RAI) was required to complete the review of the Entergy request (Reference 2).

A001  
NRK

The response to the RAI is included in Attachment 1 to this letter. This letter contains no new commitments.

If you have any questions or require additional information, please contact William Steelman at 504-739-6685.

I declare under penalty of perjury that the foregoing is true and correct. Executed on June 8, 2010.

Sincerely,

A handwritten signature in black ink, appearing to read 'W. Steelman', written in a cursive style.

JAK/WJS

Attachment: Response to Request for Additional Information

cc: Mr. Elmo E. Collins, Jr.  
Regional Administrator  
U. S. Nuclear Regulatory Commission  
Region IV  
612 E. Lamar Blvd., Suite 400  
Arlington, TX 76011-4125

NRC Senior Resident Inspector  
Waterford Steam Electric Station Unit 3  
P.O. Box 822  
Killona, LA 70066-0751

U. S. Nuclear Regulatory Commission  
Attn: Mr. N. Kalyanam  
Mail Stop O-07D1  
Washington, DC 20555-0001

Wise, Carter, Child & Caraway  
ATTN: J. Smith  
P.O. Box 651  
Jackson, MS 39205

Winston & Strawn  
ATTN: N.S. Reynolds  
1700 K Street, NW  
Washington, DC 20006-3817

Morgan, Lewis & Bockius LLP  
ATTN: T.C. Poindexter  
1111 Pennsylvania Avenue, NW  
Washington, DC 20004

**Attachment to**

**W3F1-2010-0050**

**Response to Request for Additional Information**

## **NRC REQUEST FOR ADDITIONAL INFORMATION**

In Reference 1, Entergy Operations, Inc. (Entergy) proposed a change to Waterford Steam Electric Station Unit 3 (Waterford 3) Technical Specifications (TS) Table 3.4-1 Isolation Valve Addition. During the submittal review process, the Nuclear Regulatory Commission (NRC) determined that a Request for Additional Information (RAI) was required to complete the review of the Entergy request (Reference 2).

The following lists the Waterford 3 NRC RAIs and responses.

### **RAI 1**

Provide name plate ratings and procurement details of the solenoid valves.

### **RAI 1 Response**

The preliminary valve drawing no. 2141673xx (attached) from the manufacturer (Valcor) reflects a nameplate primary pressure rating of Class 1717 and pressure boundary design of 2485 psig at 650 deg. F. The solenoid valves are being procured in accordance with Waterford-3 Specification 1564.110A (Control Valves & Accessories & Line Service Solenoid Valves Safety Class 1, 2, 3 & Non-nuclear Safety Class). Procurement requirements / details are as follows: 3/4" Diameter, Schedule 160, Socket Weld, Class 1E qualified to IEEE-323, ASME III, Class 1, Seismic Cat. 1, Borated Water Service, Stainless Steel Body, EGS type ECSA Conduit Seal, Radiation Environment  $5.1 \times 10^7$  rads, with independent limit switches (2) normally open and (2) normally closed.

### **RAI 2**

Provide the electrical one line and applicable schematic drawings showing the power and control circuits for valves SI-4052A and SI-4052B.

### **RAI 2 Response**

Drawing G287 sheet 1 is the electrical one line diagram for the DC control power (3A-DC-S and 3B-DC-S) and 120VAC Static Uninterruptible Power Supply (SUPS) 3A-S and 3B-S.

Drawings B424 Sheets 596, E596, 595, and E595 are the schematic drawings showing the power for valve SI-4052A and its indication lights.

Drawings B424 Sheets 591, E591, 590, and E590 are the schematic drawings showing the power for valve SI-4052B and its indication lights.

These drawings are attached to this response.

### **RAI 3**

Provide a summary of the voltage drop calculation including circuit lengths and the cable design details. Also, explain how the cables are routed from the distribution panels to the valves and the criteria used to meet electrical separation, independence, and redundancy requirements.

### **RAI 3 Response**

The voltage drop calculation determines that the Power Distribution Panels (PDP's) 3A-S and 3B-S have sufficient voltage to assure that the new solenoids can operate properly. The lowest design voltages at SI-4052A and SI-4052B are 96.9Vdc and 98.7Vdc, respectively. The existing loads along with SI-405A (B) also remain above the minimum voltage required after the addition of the new solenoid valves, SI-4052A and SI-4052B. The new solenoid valve has an operating voltage rating range of 90V – 140V and a full load current rating of 1.5A.

The original controls for SI-405A(B) were modified by Engineering Change (EC) 935 to eliminate the Control Room CP-8 test switches and test indicating lights. The spared conductors (Class 1E) for cables associated with existing SI-405A(B) will be used for the new solenoid. These cables are routed from the Control Room Panel CP-8, located in the Reactor Auxiliary Building (RAB) +46 Elevation to the Auxiliary Relay Panel A (B), located in the RAB +35 Elevation, to the containment electrical penetrations RAB +35 Elevation and terminated at the solenoids located inside the Reactor Containment Building +21 Elevation.

Class 1E spare cables between the Remote Shutdown Panel LCP-43 and the Auxiliary Relay Panel A (B) are used for the new solenoid. This portion of the circuit is associated with controlling the valves from the alternate shutdown panel during a control room evacuation event. The cable lengths between the LCP-43 and the Auxiliary Relay Panel A and B are 115 feet and 55 feet, respectively.

These cable are class 1E and are routed in safety related raceway that meet all separation, independence, and redundancy requirements in accordance with Regulatory guide 1.75 "Criteria for Independence of Electrical Safety Systems" and IEEE-384 "Criteria for Separation of Class 1E Equipment and Circuits". Train A and Train B are independent of each other with regard to power requirement and train separation requirement.

The cable length between the Control Room and Auxiliary Relay Panel A is 110 feet. The cable length between Auxiliary Relay Panel A and containment electrical penetration is approximately 335 feet. The cable length between containment electrical penetration and the solenoid is approximately 260 feet.

Similarly, the cable length between the Control Room and Auxiliary Relay Panel B is 90 feet. The cable length between Auxiliary Relay Panel B and containment electrical

penetration is approximately 160 feet. The cable length between containment electrical penetration and the solenoid is approximately 260 feet.

#### **RAI 4**

Provide a summary of the loading calculations that indicates battery and power distribution panels have acceptable margin available for this modification.

#### **RAI 4 Response**

Two calculations associated with safety related Battery 3A-S are ECE91-061 "Battery 3A-S Cell Sizing" and ECE91-058 "Battery 3A-S Calculation for Station Blackout". Likewise, the two calculations associated with safety related Battery 3B-S are ECE91-062 "Battery 3B-S Cell Sizing" and ECE91-059 "Battery 3B-S Calculation for Station Blackout." The Power Distribution Panel (PDP) loading calculations for PDP-3A1-DC-S and PDP-3B1-DC-S are ECE91-193 and ECE91-194, respectively.

The purpose of ECE91-061 is to ensure that Waterford 3 has adequate battery capacity to power DC loads during a design basis accident and a loss of offsite power (LOOP). The Emergency Diesel Generator starts within 10 seconds of a LOOP and provides power to the two safety related Battery Chargers via the load sequencer relay 7 seconds upon restoration of AC power. Therefore, the calculation analyzes the Battery to provide power to the associated DC buses for a bounding time of 1 minute. Shutdown cooling is not commenced during the first minute of the LOOP event. Hence, the new solenoid SI-4052A will not be energized (i.e. to open) which will not impact the loading on the battery.

The purpose of ECE91-058 is to ensure that Waterford 3 has adequate battery capacity to support decay heat removal (natural recirculation) during a Station Blackout for a 4-hour coping duration. The new solenoid SI-4052A will not be energized during natural recirculation and hence will not impact the loading on the battery.

Each train of safety related battery at Waterford 3 has 60 cells with an 8-hour rating of 2320 ampere hours at 1.75 end cell voltage. Two auxiliary relays, rated at 0.082 FLA, are added for the control circuit on SI-4052A. The indicating lights on the valves SI-405A are removed from the battery. The net change is an increase of 0.002A, which has insignificant impact on the battery margin.

Same analysis on Battery 3B-S is applicable for SI-4052B.

The PDP panels are rated for 400 amps. The PDP-3A1-DC-S capacity is approximately 48% of its rating and PDP-3B1-DC-S is approximately 53% of its rating. This change increases the PDP load by less than one amp and is well within the available PDP capacity margin.

**RAI 5**

Provide a summary of the calculations that indicates Static Uninterruptible Power Supplies (SUPS) 3A-S and 3B-S and power distribution panels have acceptable margin available for this modification.

**RAI 5 Response**

The loading calculations for SUPS 3A-S, SUPS 3B-S, Power Distribution Panel (PDP) 390-SA, and PDP-391-SB are ECE91-176 and ECE91-177, respectively. SUPS 3A-S and 3B-S are rated at 20kVA. The load on SUPS 3A-S is approximately 31% of its rating and the load on SUPS 3B-S is approximately 27%. The PDP panels are rated for 100 amps. The PDP-390-SA is approximately 52% of its rating and PDP-391-SB is approximately 46% of its rating. The indicating lights for SI-4052A (B) will be powered from SUPS 3A-S and 3B-S. A total of 0.016 FLA will be added to each SUPS and PDP, which has insignificant impact on the SUPS and PDP margin.

**RAI 6a**

Describe the environmental parameters for the valves and cables including their physical locations.

**RAI 6a Response**

The following environmental parameters are defined in Environmental Zone Map drawings G-M-0001, G-M-0002, G-M-0004, G-M-0009, and G-M-0012.

Normal Service Conditions

- |                         |   |
|-------------------------|---|
| a. Temperature          | 120°F Normal Inside Containment<br>104°F Normal Outside Containment |
| b. Pressure:            | 14.7 psia Nominal   |
| c. Radiation (40 year): | 0.31 Mrad Gamma Inside Containment (Air Equivalent)                 |
| d. Relative Humidity:   | 20% to 90%  |

Plant Design Basis Events (Worst Case)

- |                          |   |
|--------------------------|---|
| a. Accident Temperature: | 414°F Maximum Inside Containment (MSLB)<br>269°F Maximum Inside Containment (LOCA)<br>150°F for 4 hours Maximum Outside Containment |
|--------------------------|---|



- b. Accident Pressure: 44 psig Maximum Inside Containment  
14.7 psia Maximum Outside Containment
- c. Accident Type MSLB & LOCA (with Loss of Offsite Power for 4 Hours)
- d. Required Operating Time 120 days post accident
- e. Radiation: 33 Mrads Gamma (Air Equivalent) Inside Containment  
330 Mrads Beta Inside Containment
- f. Relative Humidity: 100% Maximum Inside Containment  
20% to 90% Outside Containment
- g. Submergence: None
- h. Chemical Spray: Yes: Inside Containment Only

The Bypass Line installed around valves SI-405A(B) including solenoid valves SI-4052A(B) will be located in the Reactor Containment Building Elev. +21 outside the D-ring. The cables will be located in the Reactor Auxiliary Building, control room, and containment.

#### **RAI 6b**

Explain how these components are qualified to meet the requirements of 10 CFR 50.49 for the environmental conditions they are expected to be exposed to. Also, provide a summary of the environmental qualification reports including the accident profiles.

#### **RAI 6b Response**

The EQ solenoid valves to be installed under Engineering Changes (ECs) 14765, 14766 and 14767 are currently in the procurement process and will meet 1564.110A Rev.15 specification which envelopes the environmental requirements. EC 14765 states the modification installation shall not commence until an EQ assessment is developed and approved since vendor documentation to validate qualification is not available at this time. In addition to EC 14765 tracking qualification of these components, Action Request AR 84956-03 has been generated to evaluate the manufacturers EQ documentation ensuring the 10 CFR 50.49 requirements and the site requirements are satisfied. In addition, Waterford 3 submittal letter W3F1-2010-0019 Attachment 4 contains the following commitment:

SI-4052A(B) will be procured to withstand the environmental and accident conditions inside containment as shown in FSAR Table 3.11-1.

### **RAI 7**

Provide a summary of the protective device coordination of the circuits including the respective containment penetrations for valves SI-4052A and SI-4052B.

### **RAI 7 Response**

The new solenoid valve, SI-4052A(B), will be added in parallel with valve SI-405A (B) and will be fed from 125V dc control power, which is the same circuit that provides control power to SI-405A(B). The electrical penetrations (141 and 142) associated with these circuits are protected by double protections (two fuses) which currently meet the requirement of Technical Specification 3/4.8.4.

The valve position indication lights for SI-4052A(B) and SI-405A(B) will be powered separately from the control circuit power for the same shutdown loop's valves SI-401A(B). The electrical penetrations (141 and 142) associated with these circuits are protected by double protections (breaker/fuse) which are currently tested in accordance with Technical Specification surveillance 4.8.4.1.

### **REFERENCES**

1. W3F1-2010-0019, Technical Specification Table 3.4-1 Isolation Valve Addition, February 22, 2010.
2. NRC Letter, Request for Additional Information Re: Technical Specification Table 3.4-1 Isolation Valve Addition, April 14, 2010 [ADAMS Accession Number ML101040651].
3. NRC Letter, Acceptance Review for Technical Specification Table 3.4-1 Isolation Valve Addition, March 23, 2010 [ADAMS Accession Number ML100820566].

DESIGN/PERFORMANCE

- FLUID BORATED
- DESIGN & OPERATIONAL CONDITIONS
  - PRIMARY PRESSURE RATING CLASS 1717
  - PRESSURE BOUNDARY DESIGN 2485 PSIG AT 650°F
  - NORMAL OPERATIONAL DESIGN 2350 PSIG AT 560°F
- FLOW Cv=4.0 MIN.
- HYDROSTATIC CONDITIONS
  - SHELL LEAKAGE ZERO AT 6200 PSIG WATER & 70°F
  - DISC LEAKAGE .125 cc/MIN. WATER AT 4535 PSIG WATER & 70°F (FORWARD)
- SOLENOID OPERATOR
  - COIL INSULATION CLASS H
  - ENCLOSURE RATING NEMA 4
  - VOLTAGE 90-140 VDC
  - CURRENT INRUSH 1.5 AMP MAX. AT 125VDC & 70°F
  - HOLDING 1.5 AMP MAX. AT 125VDC & 70°F
  - DUTY CONTINUOUS AT 125VDC MAX.
- FAILURE POSITION CLOSED
- WEIGHT 65 LBS. MAX. (WEIGHT DOES NOT INCLUDE PIGTAILS)
- INSTALLATION HEAT TRANSFER DUE TO IN-LINE WELDING SHALL BE MINIMIZED SUCH THAT MAX. BODY TEMPERATURE WITHIN 1" OF WELD SHALL NOT EXCEED 400°F.
- RADIATION ENVIRONMENT
  - GAMMA RADIATION INTEGRATED DOSAGE OF 5.1 X 10<sup>7</sup> RADS
- CODE COMPLIANCE
  - ASME SECT. III 1977 EDITION INCLUDING SUMMER 1977 ADDENDA
  - CLASS 1 DESIGN
- POSITION INDICATION MAGNETIC REED SWITCH
  - SWITCHING VOLTAGE 125 VDC OR 125 VAC
  - SWITCHING CURRENT .50 AMPS MAX.
  - SWITCHING CAPABILITY 80 WATTS MAX.
- CUSTOMER DOCUMENTS
  - a) WATERFORD 3
  - b) TAG NUMBERS:
    - SI-4052A
    - SI-4052B





10 LEADWIRES 30 FT. LONG MIN. #16 AWG SOLID COPPER CONDUCTOR, POLYIMIDE INSULATED, 600 VOLT 200°C FIREWALL III SIS

OWNER IS RESPONSIBLE FOR MAINTAINING THE SEALS, ITEMS 7, 27 & 30 AND FOR SEALING THE CONDUIT CONNECTION AND PREVENTING THE ENTRANCE OF MOISTURE THRU THE CONDUIT TO MAINTAIN THE VALIDITY OF THE IEEE-323 QUALIFICATION AND THE REQUIREMENTS OF THE NEMA 4 ENCLOSURE.

REVISIONS		DATE	APPROVED
ECO	LTR	DESCRIPTION	




WARNING-This document contains technical data whose export is restricted by the Arms Export Control Act (Title 22, U.S.C., Sec 2751, et seq), or the Export Administration Act of 1979, as amended, Title 30, U.S.C App 2401 et seq. Violation of these export laws are subject to severe criminal penalties.

THIS DRAWING IS FOR PROPOSAL PURPOSES ONLY ALL DIMENSIONS ARE FOR REFERENCE ONLY

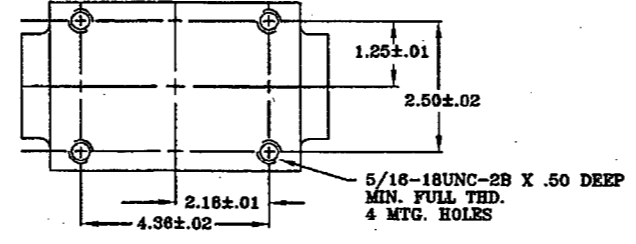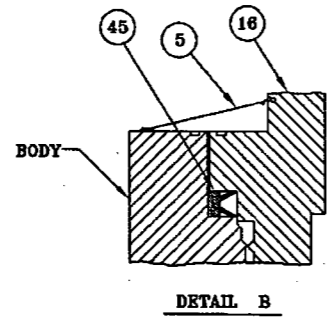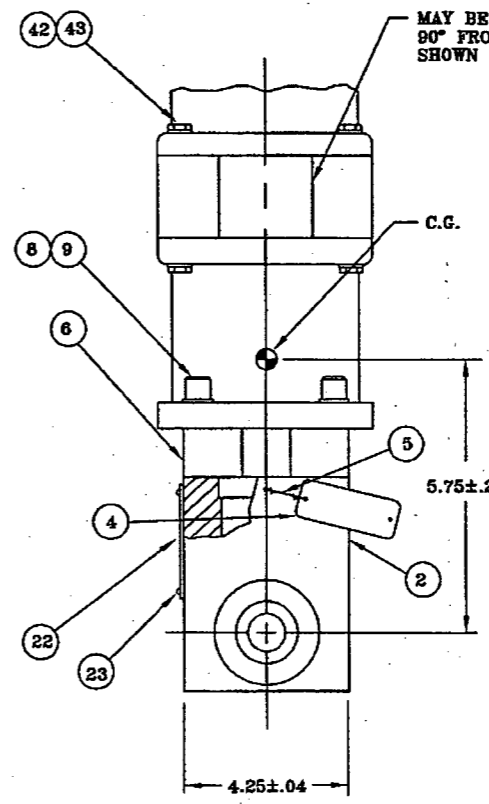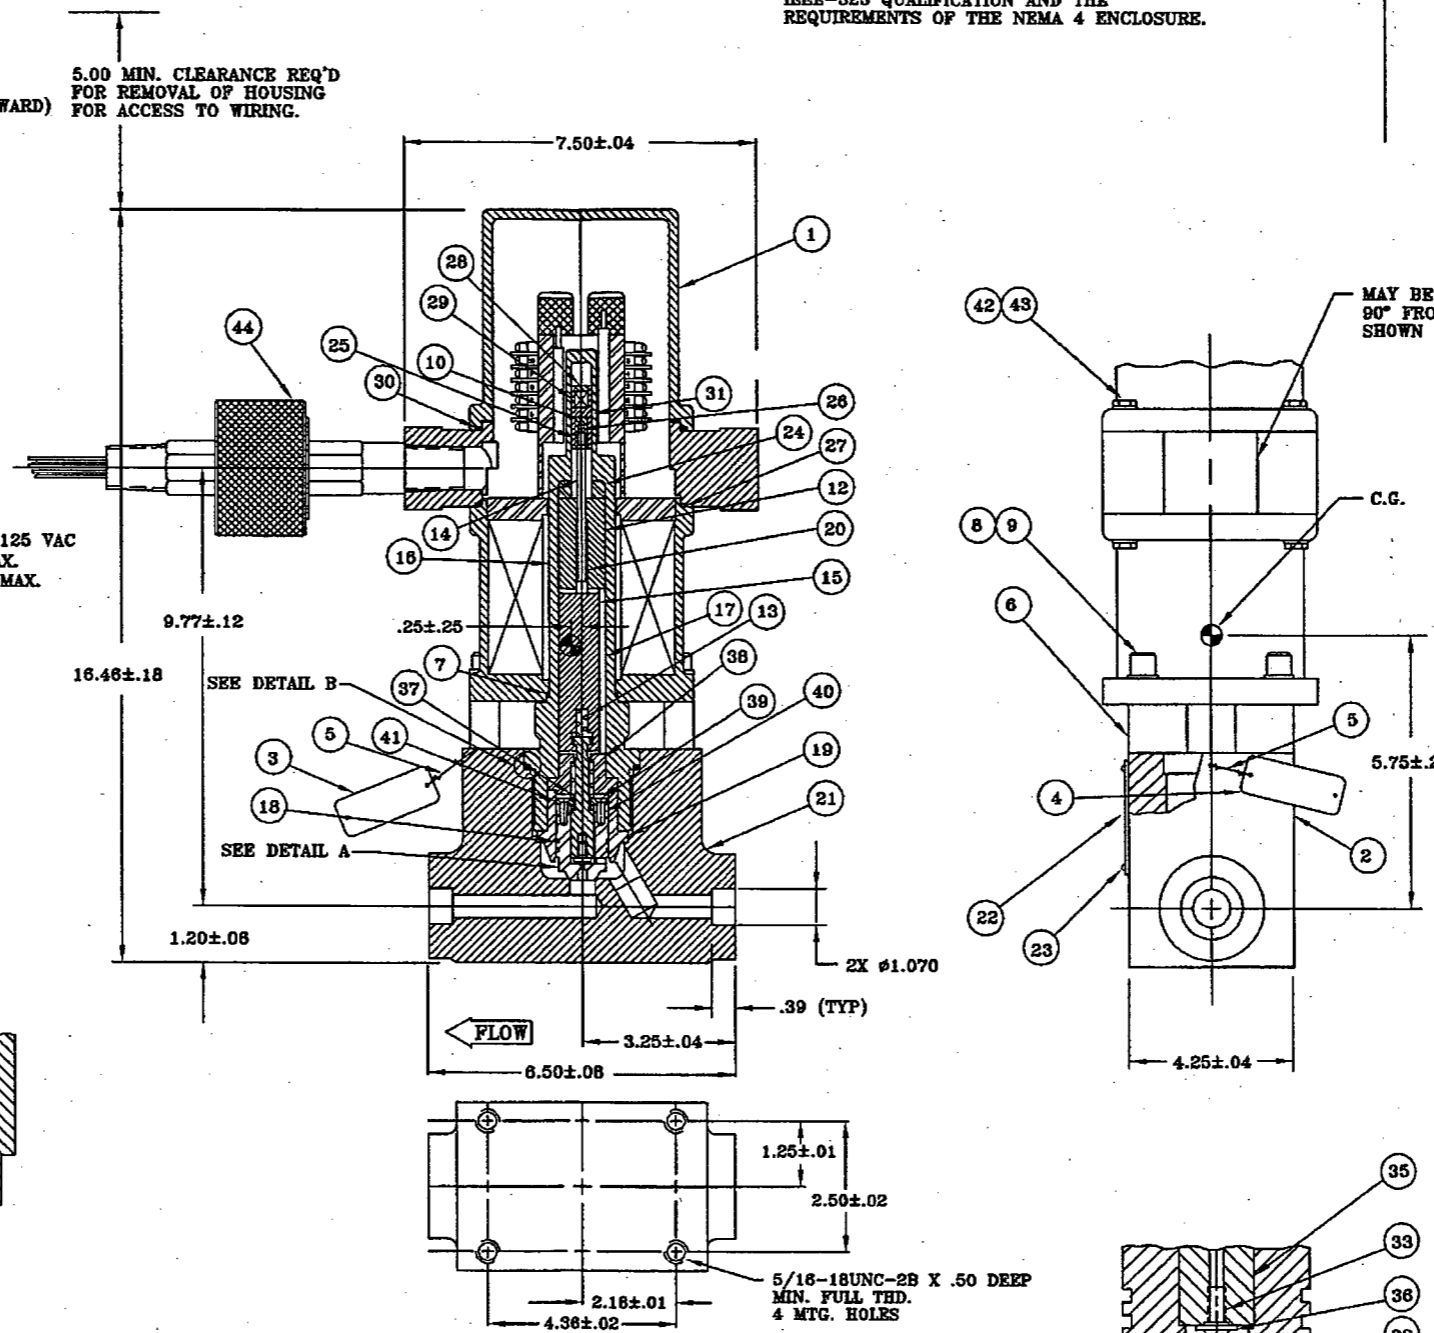

\* PRESSURE RETAINING PARTS

ITEM	DESCRIPTION	MATERIAL
45	K-SEAL	INCONEL X750
44	CONNECTOR	EGS
43	LOCKWASHER	300 SERIES ST. STL.
42	SCREW, HEX HD.	300 SERIES ST. STL.
41	PLATE	ASTM A276 TYPE 316
40	HELI-COIL	300 SERIES ST. STL.
39	SCREW, FLAT HD.	300 SERIES ST. STL.
38	RING	ASTM A276 TYPE 316
37	SPRING	ELGILOY
36	SEAL	STELLITE 6B
35	POPPET	ASTM A479 TYPE 316
34	SEAL	STELLITE 6B
33	HELI-COIL	300 SERIES ST. STL.
32	DISC	ASME SA-479 TYPE 316
31	CUP	ASTM A479 TYPE 316
30	O-RING	SILICONE
29	MAGNET	REMCO-16
28	PLUG	ASTM A479 TYPE 316
27	O-RING	SILICONE
26	LOCKPIN	300 SERIES ST. STL.
25	COUPLING	ASTM A479 TYPE 316
24	SPACER	ASTM A276 TYPE 316
23	SCREW, DRIVE	300 SERIES ST. STL.
22	NAMEPLATE	302 OR 304 ST. STL.
21	BODY	ASME SA-240 TYPE 316
20	SPRING	ELGILOY
19	GUIDE	ASTM A276 TYPE 316
18	PISTON RING	410 ST. STL.
17	PIN	ASTM A479 TYPE 316
16	BONNET	ASME SA-479 TYPE 316
15	PLUNGER	430/ VALCOR STD. S121
14	ROD	ASTM A479 TYPE 316
13	SPRING	ELGILOY
12	STOP	430/ VALCOR STD. S121
11		
10	SPIROL PIN	INCONEL X-750
9	SCREW, CAP, SOC. HD.	300 SERIES ST. STL.
8	LOCKWASHER	302 OR 304 ST. STL.
7	PACKING	GRAFOIL
6	SPACER	300 SERIES ST. STL.
5	LOCKWIRE	302 OR 304 ST. STL.
4	VALVE TAG	300 SERIES ST. STL.
3	WELD CAUTION TAG	300 SERIES ST. STL.
2	VALVE ASSY	
1	SOLENOID ASSY	

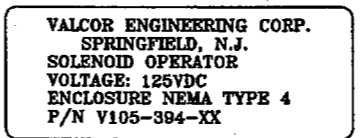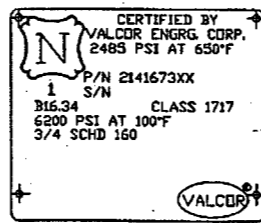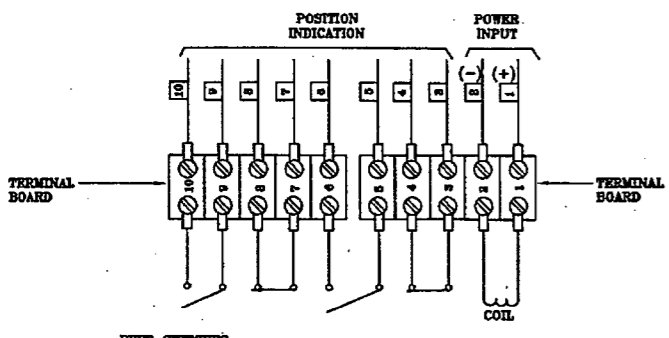

NUCLEAR HARDWARE

TECHNICAL DATA DISCLOSED HEREIN IS THE PROPERTY OF VALCOR ENGINEERING CORP. AND SHALL NOT BE RELEASED, USED, DUPLICATED OR DISCLOSED IN WHOLE OR IN PART FOR MANUFACTURE OR PROCUREMENT WITHOUT THE WRITTEN PERMISSION OF VALCOR ENGINEERING CORP. EXCEPT FOR EMERGENCY REPAIR OR OVERHAUL WORK, WHERE THE ITEM OR PROCESS CONCERNED IS NOT OTHERWISE REASONABLY AVAILABLE TO ENABLE TIMELY PERFORMANCE OF THE WORK. PROVIDED THAT RELEASE, USE, DUPLICATION, AND DISCLOSURE HEREOF SHALL BE SUBJECT TO THE FOREGOING LIMITATION, THIS LEGEND SHALL BE MARKED ON ANY REPRODUCTION HEREOF IN WHOLE OR IN PART.

SIGNATURES		DATE	VALCOR ENGINEERING CORPORATION	
DRAWN	B. KARCH	4/30/10	SPRINGFIELD, NEW JERSEY	
CHECKED			3/4 SCHD 160	CLASS 1717 D.C.
ENGINEER			VALVE, SOLENOID, POSITION INDICATION, NUCLEAR SERVICE	
PRODUCTION			MODEL: V526-6048-XX N.C.	
APPROVED			SIZE	CODE IDENT. NO. DWG. NO. & PART NO.
APPROVED			D	96487 2141673XX
APPROVED			SCALE	-/- COMP. NO. SHT 1/1


**THIS PAGE IS AN  
OVERSIZED DRAWING OR  
FIGURE,**

**THAT CAN BE VIEWED  
AT THE RECORD TITLED:  
“LOUISIANA POWER & LIGHT  
COMPANY, WATERFORD S.E.S. UNIT  
NO.3, 1977-1165 MW INSTALLATION  
125 VDC AND 120 VAC  
ONE LINE DIAGRAM,  
G287, SH.1”**

**WITHIN THIS PACKAGE...OR  
BY SEARCHING USING THE  
DOCUMENT/REPORT NO.**


**D-01X**

Engineering Change Markup EC#: 14766	Page 2 of 2
DOC#: B424	SHT#: 596 REV 21
Safety Related: <input checked="" type="checkbox"/>	Before View: <input type="checkbox"/> Control Room Drawing: <input checked="" type="checkbox"/>
Prepared By: <i>[Signature]</i>	Date: 03/19/10
	Reviewer Name (Optional): <i>[Signature]</i>

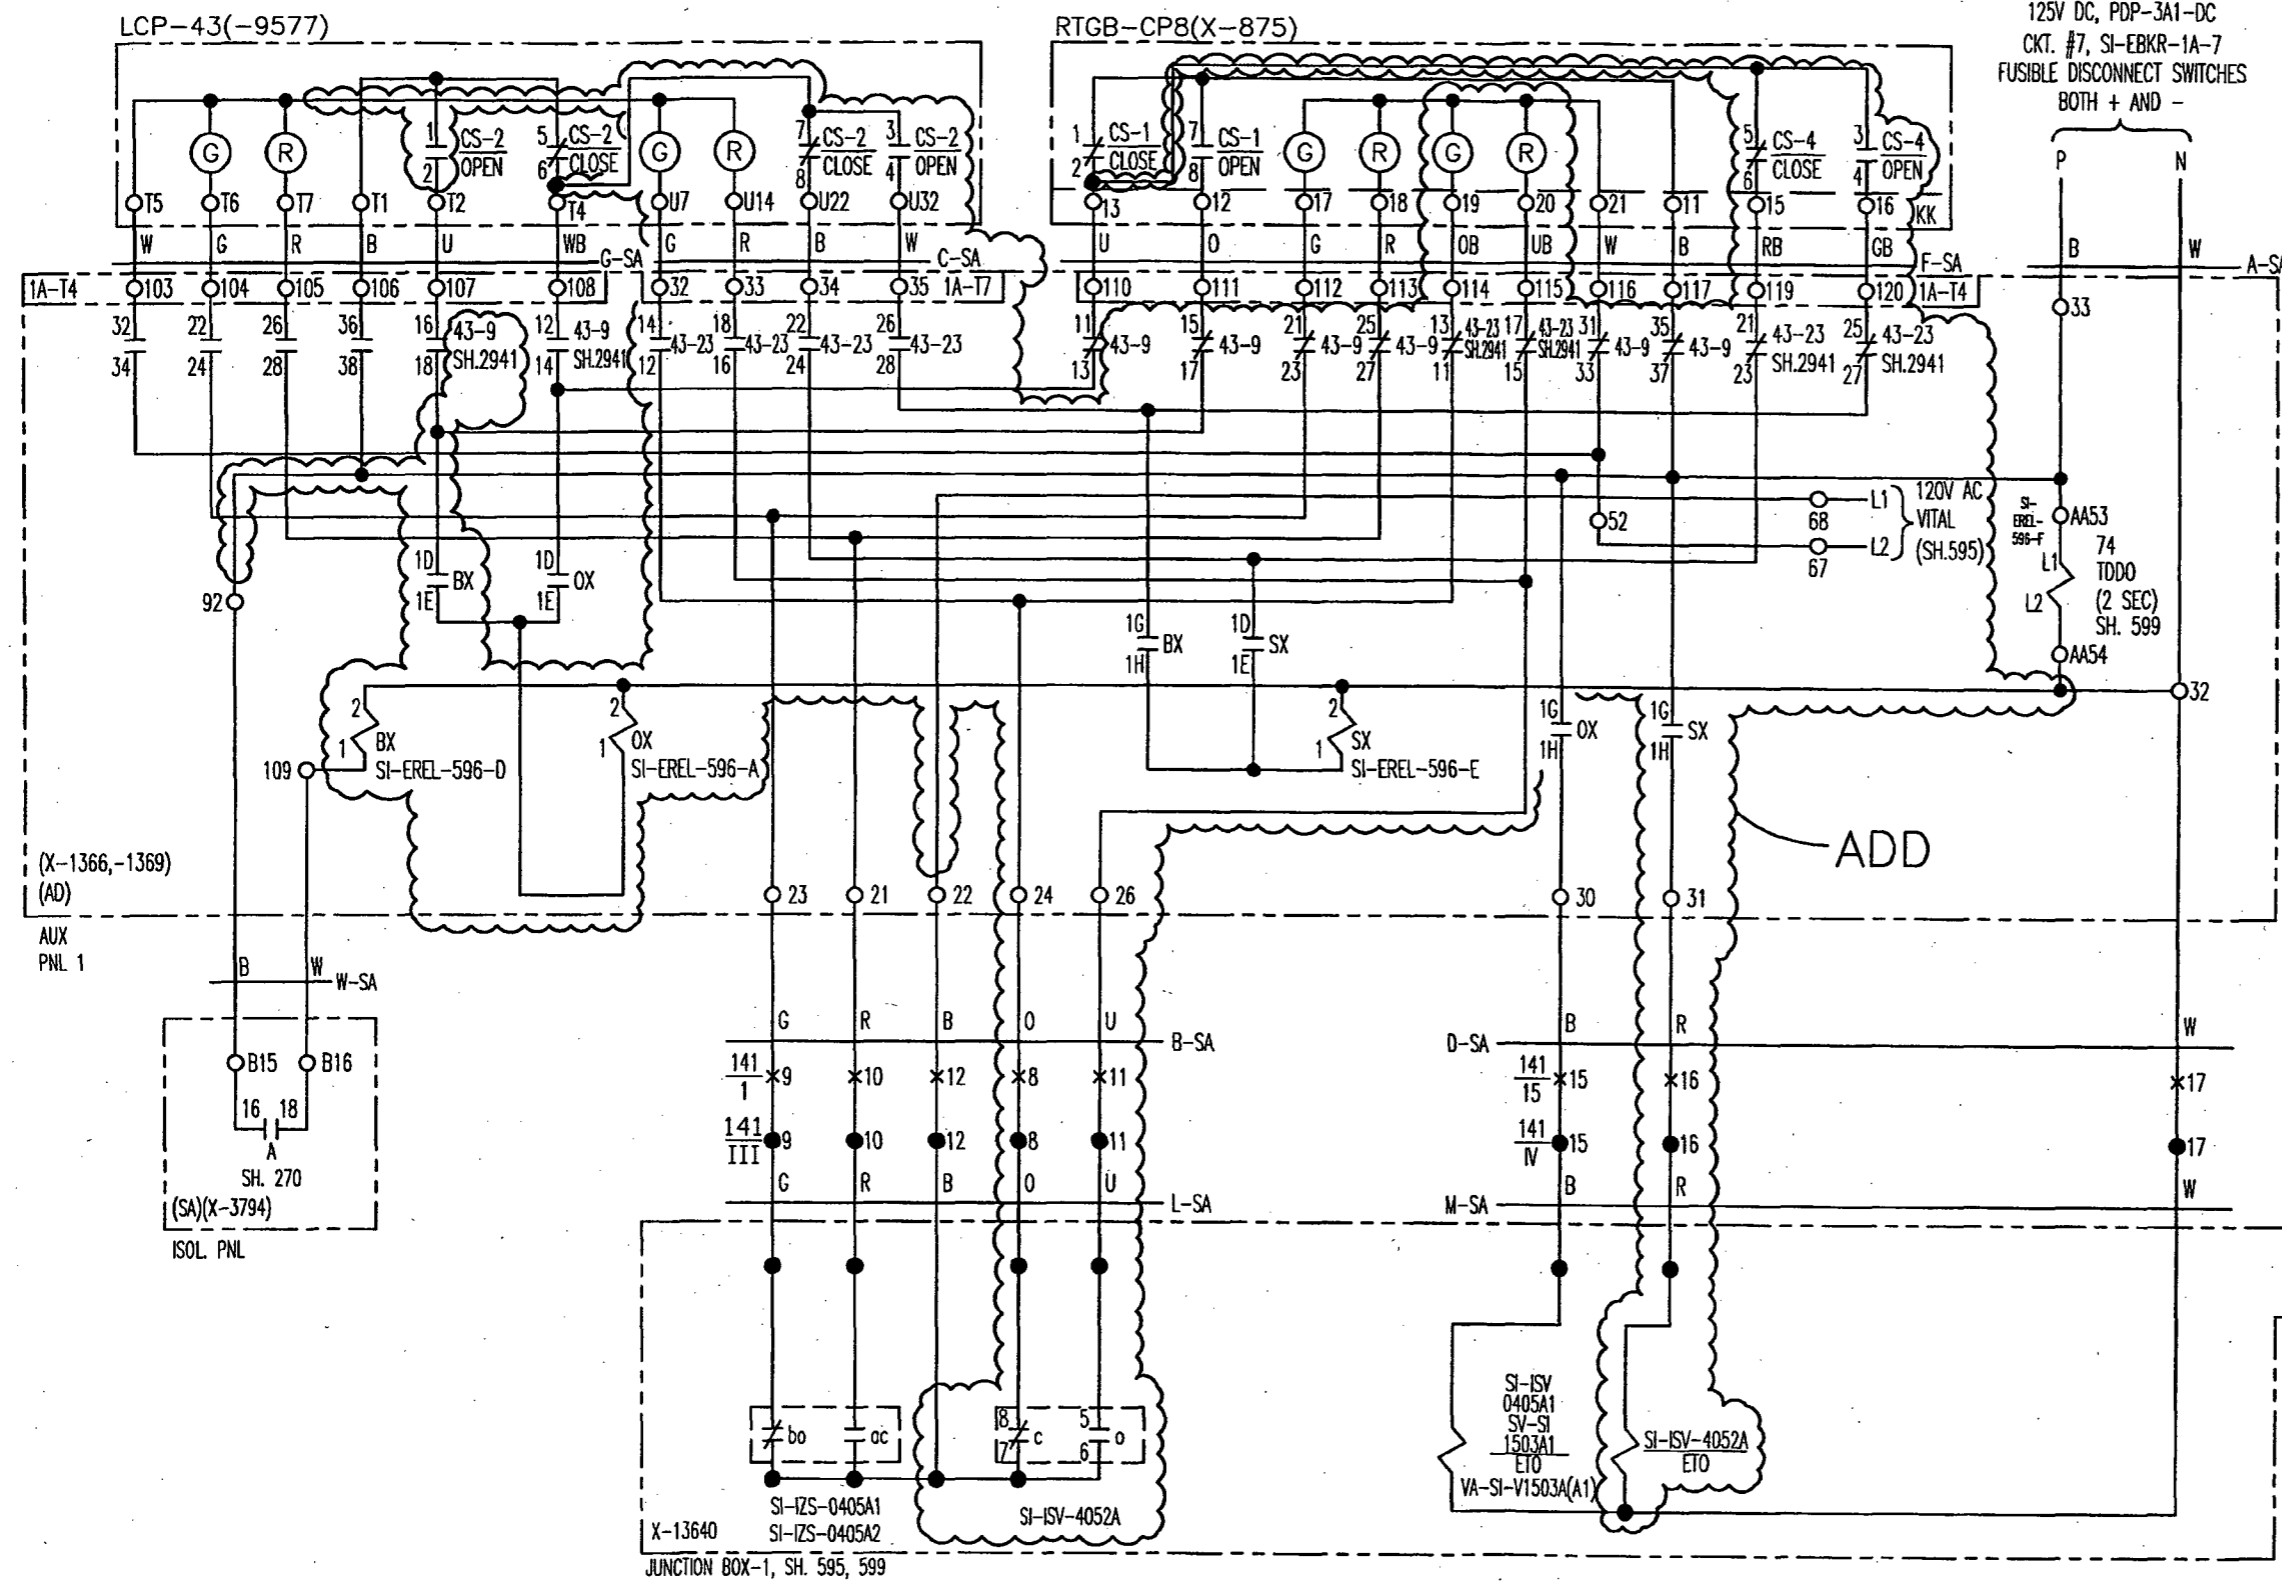



NOTE:  
FOR SWITCH DEVELOPMENTS SEE  
SH. E596.

ADD

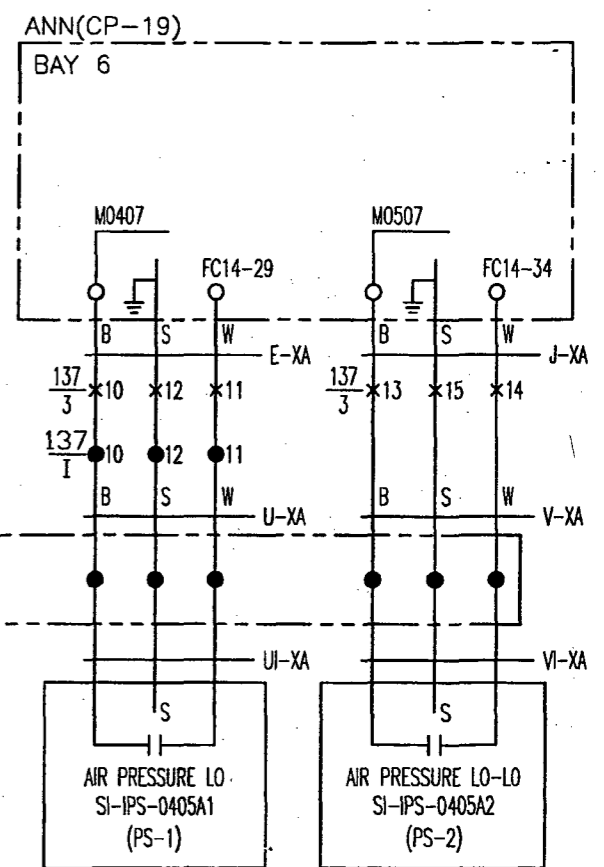

NOTE . FOR COMPUTER INPUTS  
SEE CWD SH 2838

					20	14-6-95	DD	THS	CB	EBASCO SERVICES INCORPORATED NEW YORK		LOUISIANA POWER & LIGHT CO. WATERFORD S. E.S. UNIT No.3 CONTROL WIRING DIAGRAM RCS LOOP 2 SHUTDOWN COOLING ISOLATION VA. ISI-1503A	B424 SHEET 596
					19	10-2-91	M	HU	CB	EP	FMG		
					18	11-8-91	EJB	VL	THS	DIV. IBC DR. REL		APPROVED <i>[Signature]</i>	
					17	10-5-91	SP	VAIC	THS	H. J. TYMANIC			
REV.	DATE	BY	APPROVAL	REV	DATE	BY	APPROVED	DATE: 12-1976		<i>[Signature]</i>			

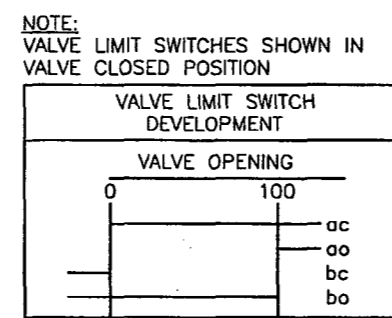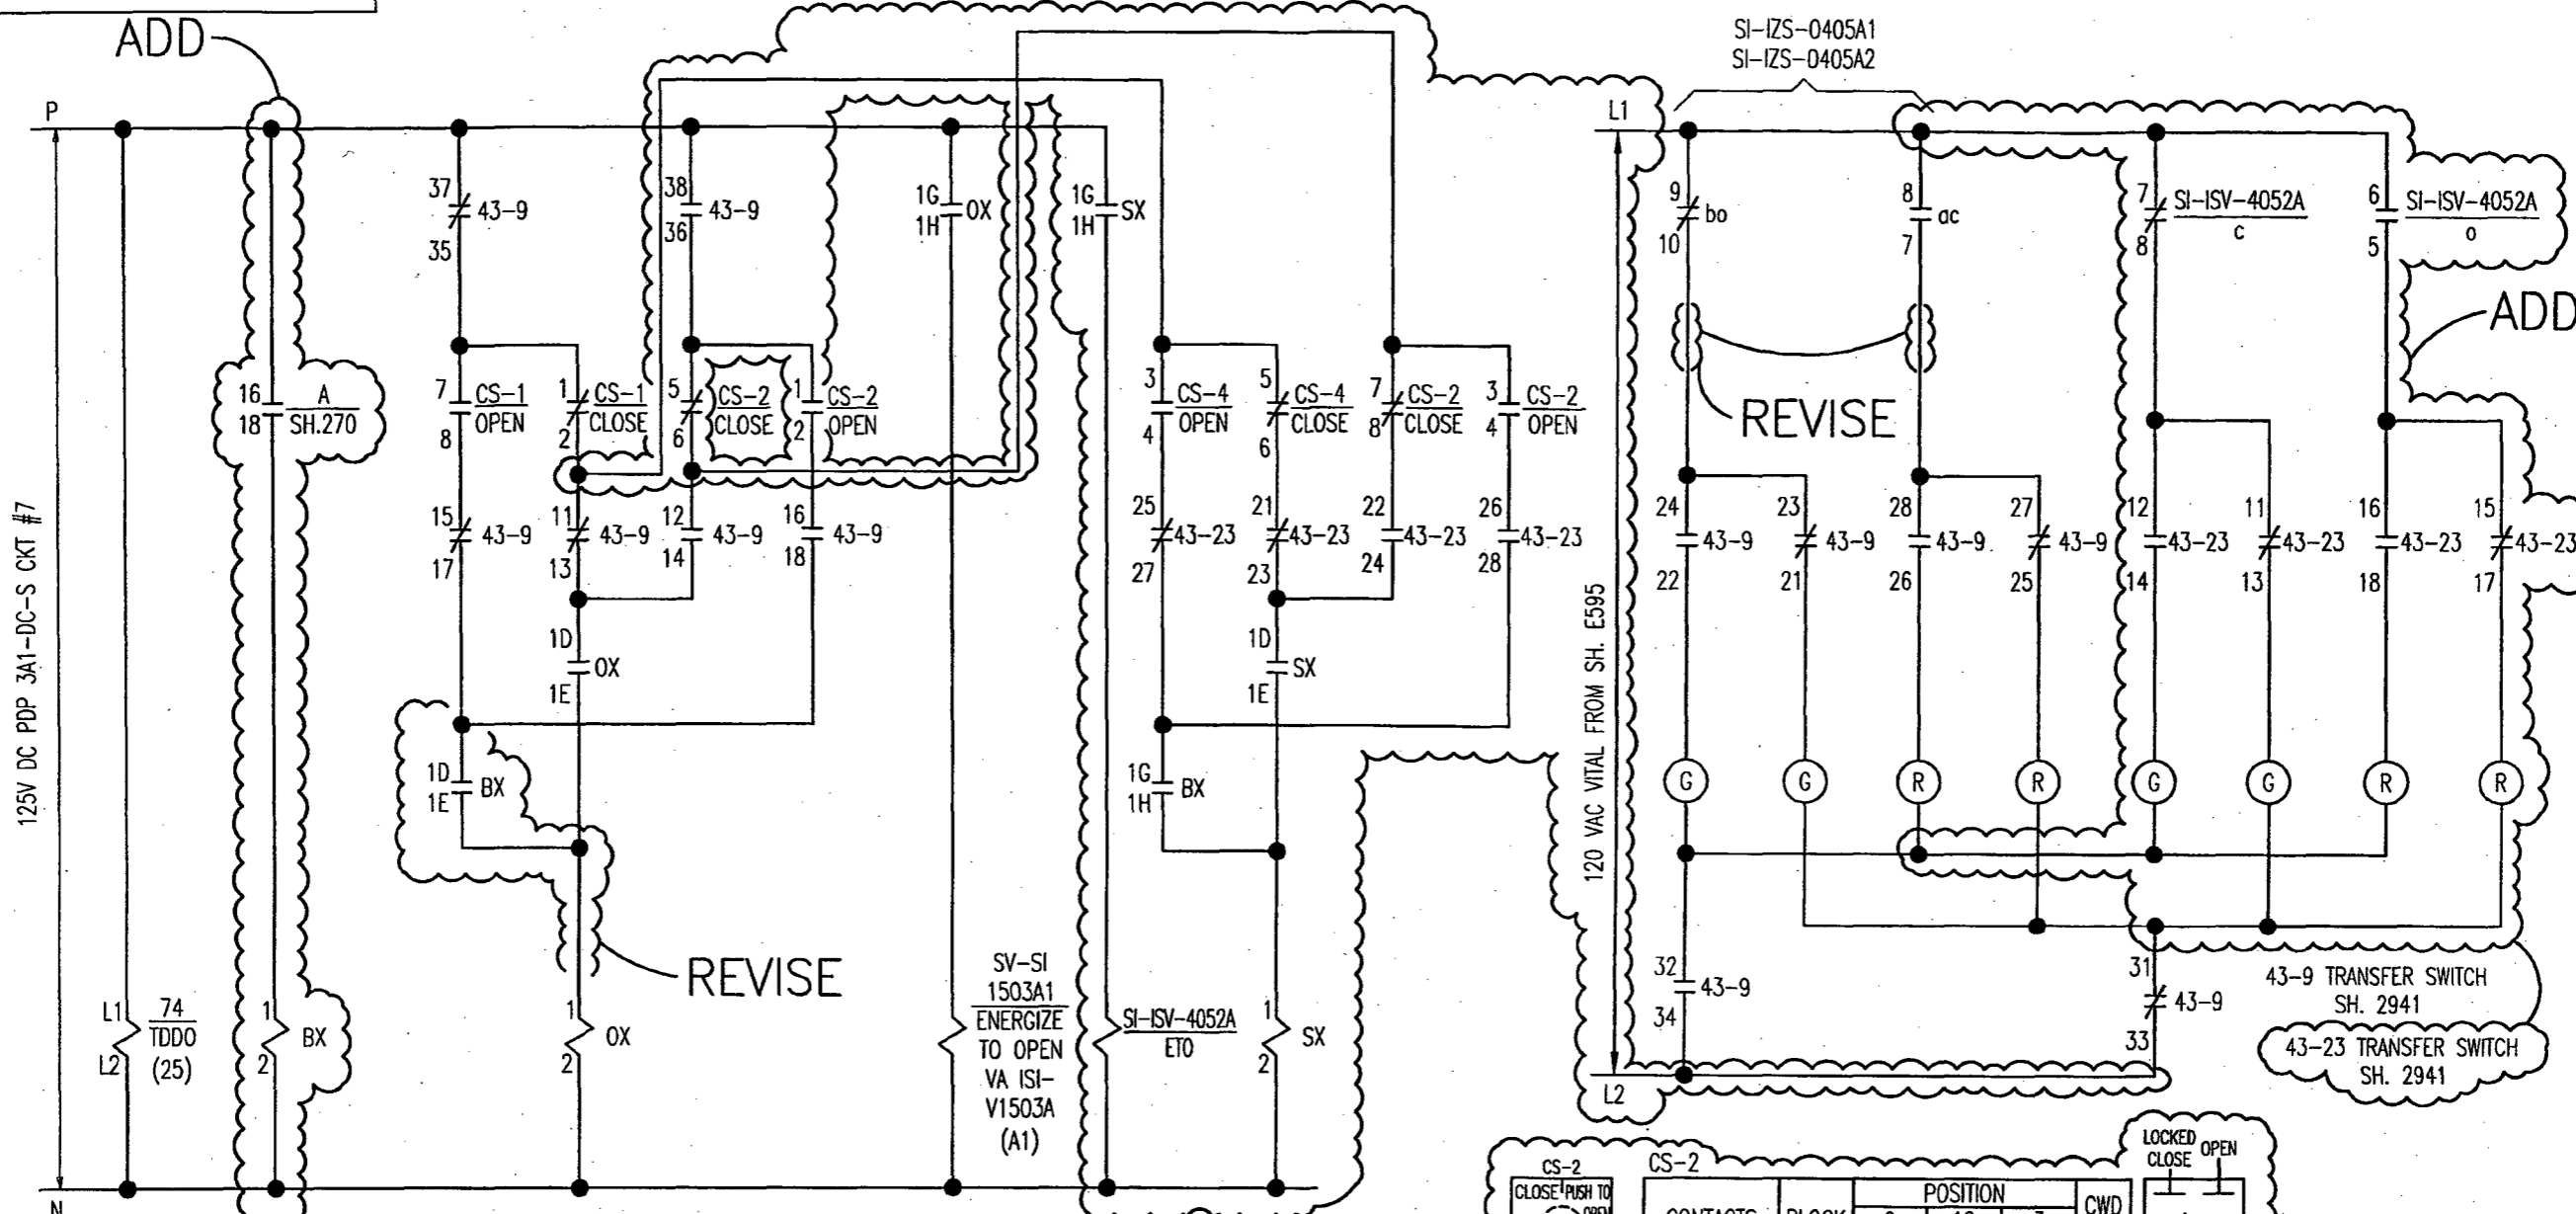

CS-4

CONTACTS	POSITION			CWD SH.
	9 close	12 NORM	3 open	
1-2	x	x		
3-4			x	*
5-6		x	x	*
7-8	x			

TYPE CMC SPRING RETURN TO NORMAL

CS-2

CONTACTS	BLOCK	POSITION			CWD SH.
		9 close	12 NORM	3 open	
1-2	Free Depress			x	*
5-6	Free Depress		x	x	*
3-4	Free Depress		x		*
7-8	Free Depress		x	x	*

TYPE CMC SPRING RETURN TO NORMAL

CS-1 (RTGB)

CONTACTS	POSITION			CWD SH.
	10 LOCKED CLOSE	12 NORM	2 OPEN	
1-2		x	x	*
3-4	x			
5-6	x	x		
7-8			x	*

TYPE PTK SPRING RETURN FROM OPEN TO NORM, MAINTAINED IN CLOSE KEY REMOVAL IN CLOSE POS ONLY

Engineering Change Markup EC#: 14766 Page 2 of 2  
 DOC#: B424 SHT#: E596 REV 4  
 Safety Related:  Before View  Control Room Drawing:   
 Prepared By: *[Signature]* Date: 03/19/10  
 Reviewer Name (Optional): *[Signature]*

REV.	DATE	BY	APPROVAL
4	6-5-08	JAG	DD DD
3	10-2-91	ML HO LFP CB TMS EF	
2	10/22/90	DJH VJ	
1	7-2-87	DR	


**EBASCO SERVICES INCORPORATED**  
 DIV I & C DR 05  
 CH S. LIN  
 DATE JAN. 9, 1980  
 APPROVED: *[Signature]*

**LOUISIANA POWER & LIGHT CO.**  
 WATERFORD S.E.S. UNIT NO.3  
 CONTROL WIRING DIAGRAM  
 RCS LOOP 2 SHUTDOWN COOLING  
 ISOLATION VA ISI-V1503A

B424  
SHEET E596

(G-167-2)

\* THIS SHEET

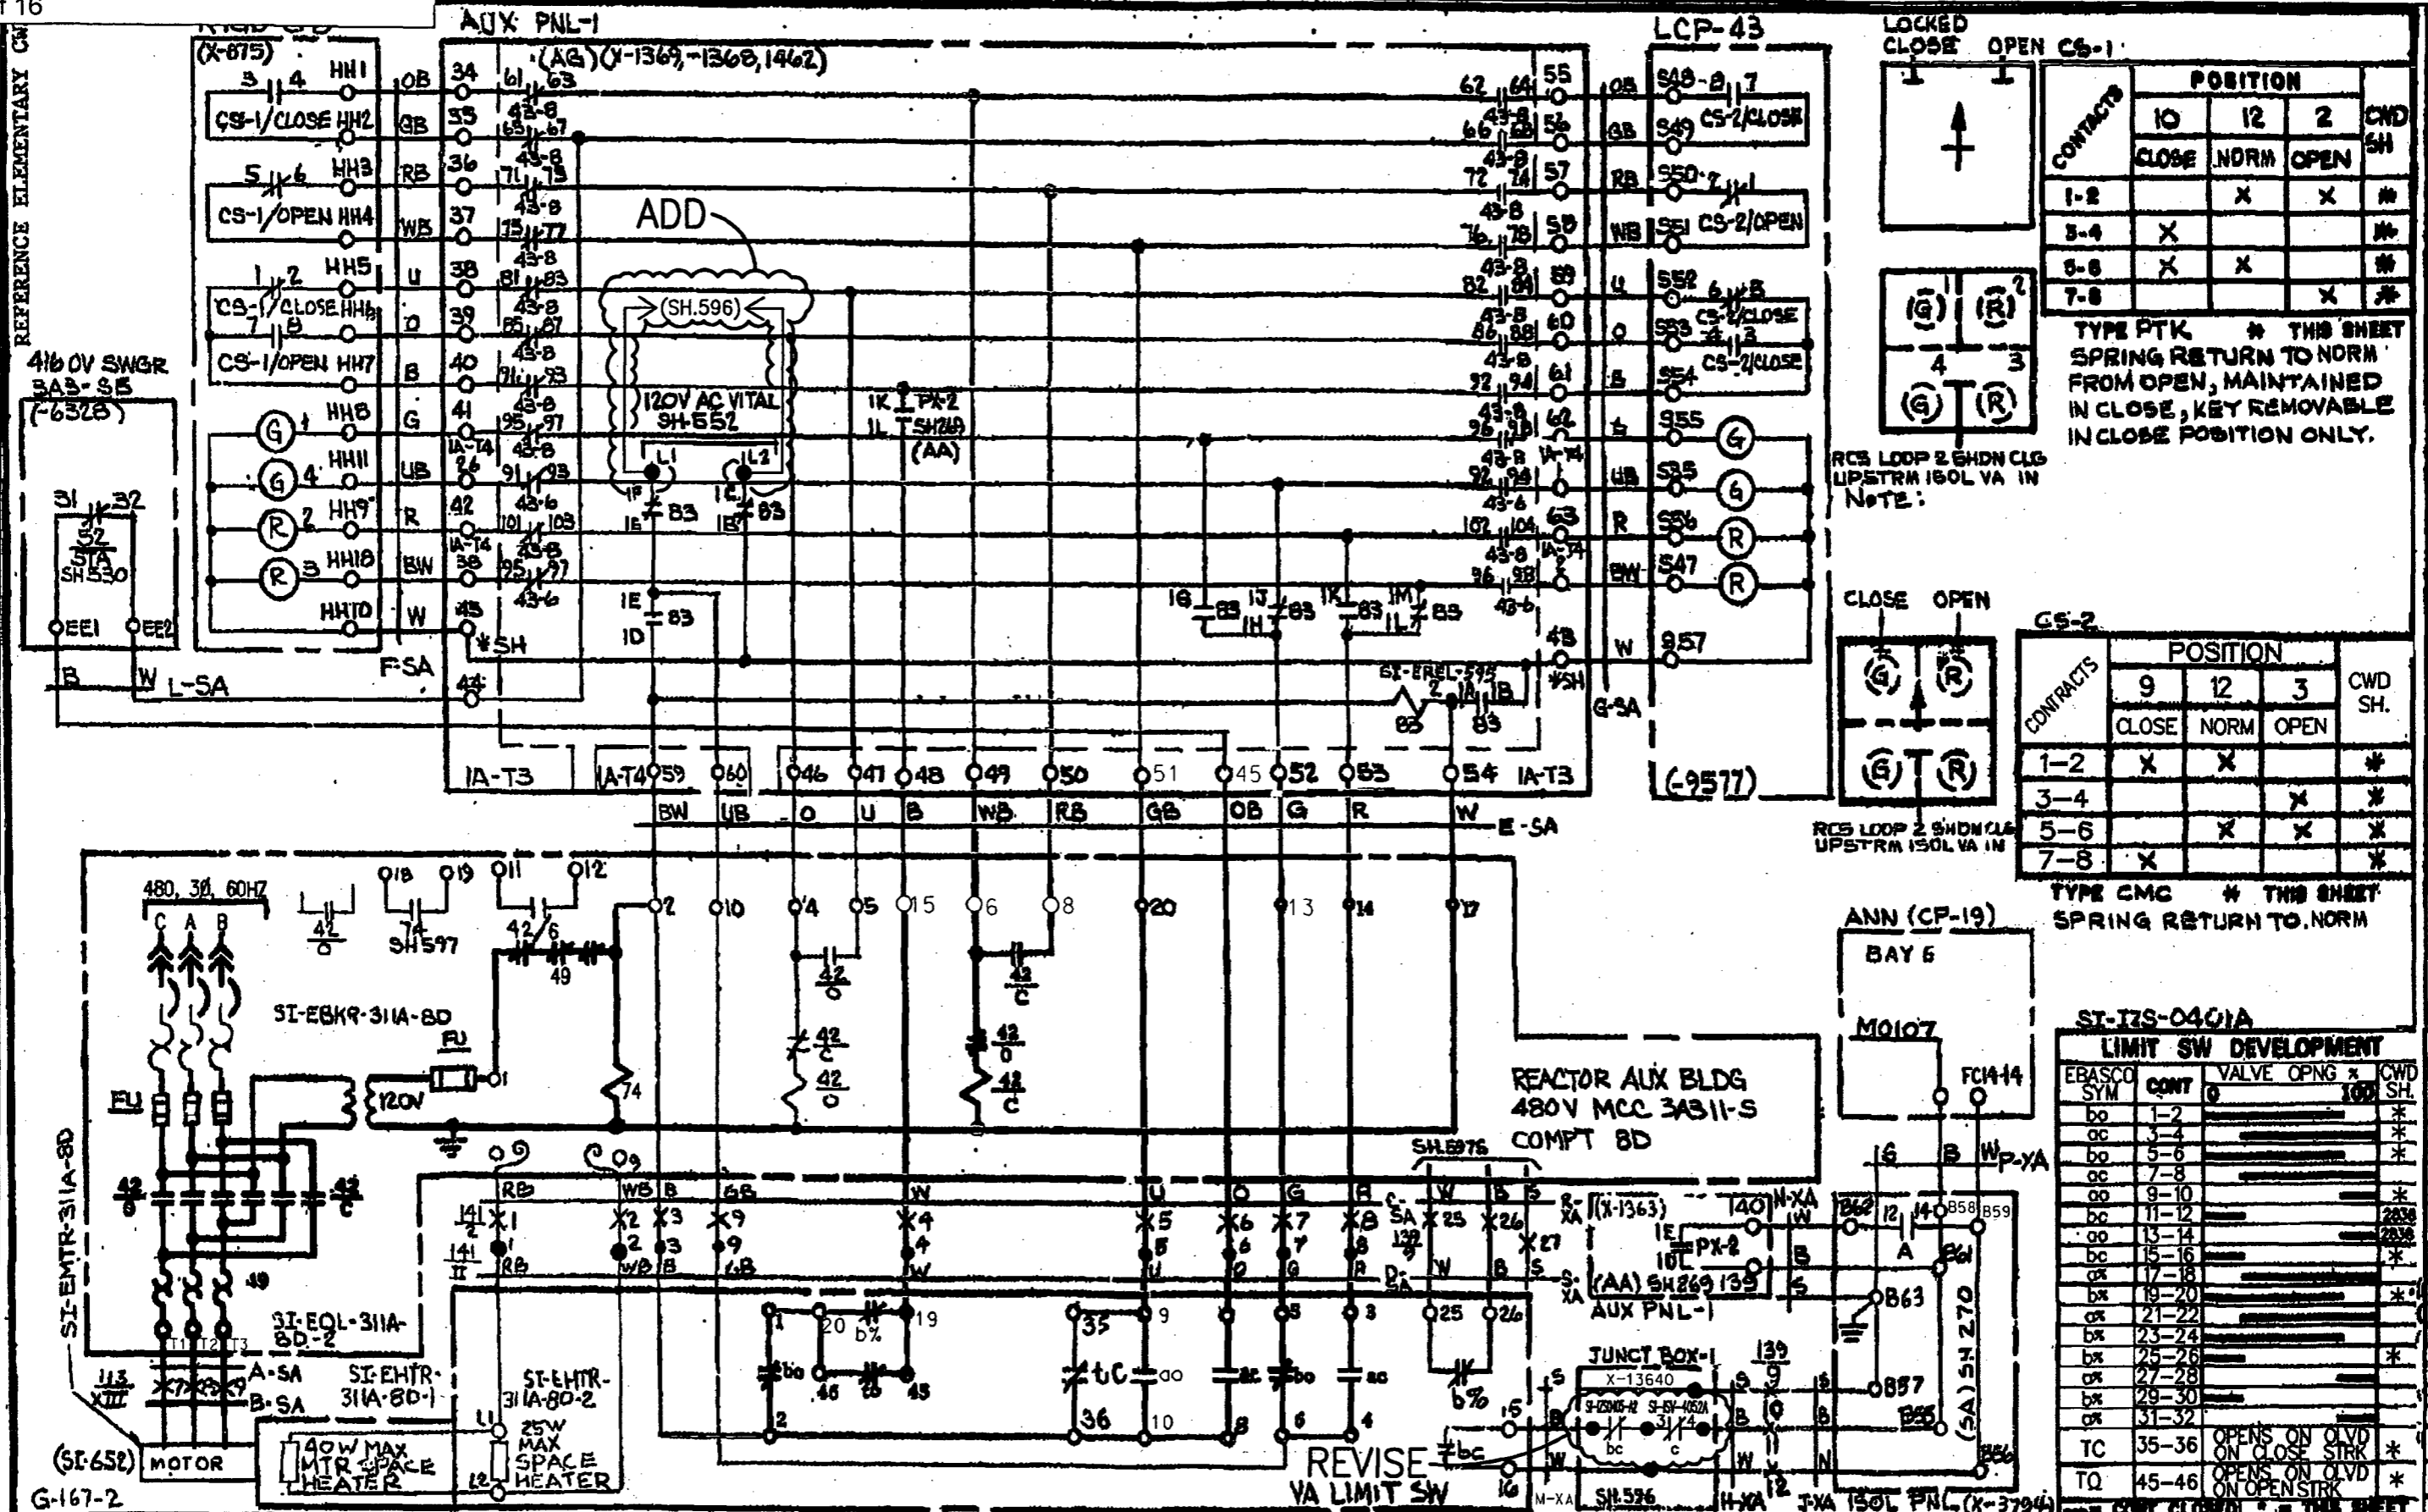

LOCKED CLOSE OPEN CS-1

CONTACTS	POSITION			CWD SH
	10	12	2	
1-2		X	X	*
3-4	X			*
5-6	X	X		*
7-8			X	*

TYPE PTK \* THIS SHEET SPRING RETURN TO NORM FROM OPEN, MAINTAINED IN CLOSE, KEY REMOVABLE IN CLOSE POSITION ONLY.

CS-2

CONTACTS	POSITION			CWD SH
	9	12	3	
1-2	X	X	*	
3-4			X	
5-6		X	X	
7-8	X		*	

TYPE CMC \* THIS SHEET SPRING RETURN TO NORM


ST-175-0401A  
LIMIT SW DEVELOPMENT

EBASCO SYM	CONT	VALVE OPNG	CWD SH
bo	1-2	_____	*
oc	3-4	_____	*
bc	5-6	_____	*
cc	7-8	_____	*
oo	9-10	_____	*
bc	11-12	_____	2338
oo	13-14	_____	2338
bc	15-16	_____	*
cc	17-18	_____	*
bx	19-20	_____	*
cc	21-22	_____	*
bx	23-24	_____	*
cc	25-26	_____	*
cc	27-28	_____	*
cc	29-30	_____	*
cc	31-32	_____	*
TC	35-36	OPENS ON OLVD ON CLOSE STRK	*
TQ	45-46	OPENS ON OLVD ON OPEN STRK	*

Engineering Change Markup EC#: 14766 Page 2 of 2  
DOC#: B424 SHT#: 595 REV 28  
Safety Related:  Before View  Control Room Drawing:   
Prepared By: *Russ Vally* Date: 10/03/09  
Reviewer Name (Optional): *PK for DAS*

REV	DATE	BY	APPROVAL
28	6-5-08	JAG	DD DD
27	9-21-95	LLB	ML PJB
26	2-10-95	DDD	THS EF
25	8-17-93	THS	DDD GM

EBASCO SERVICES INCORPORATED, LOUISIANA POWER & LIGHT CO.  
NEW YORK  
WATERFORD S.E.S. UNIT No.3  
CONTROL WIRING DIAGRAM  
RCS LOOP No.2 SHUTDOWN  
COOLING ISOL VAISI-V1504A  
B424 SHEET 595

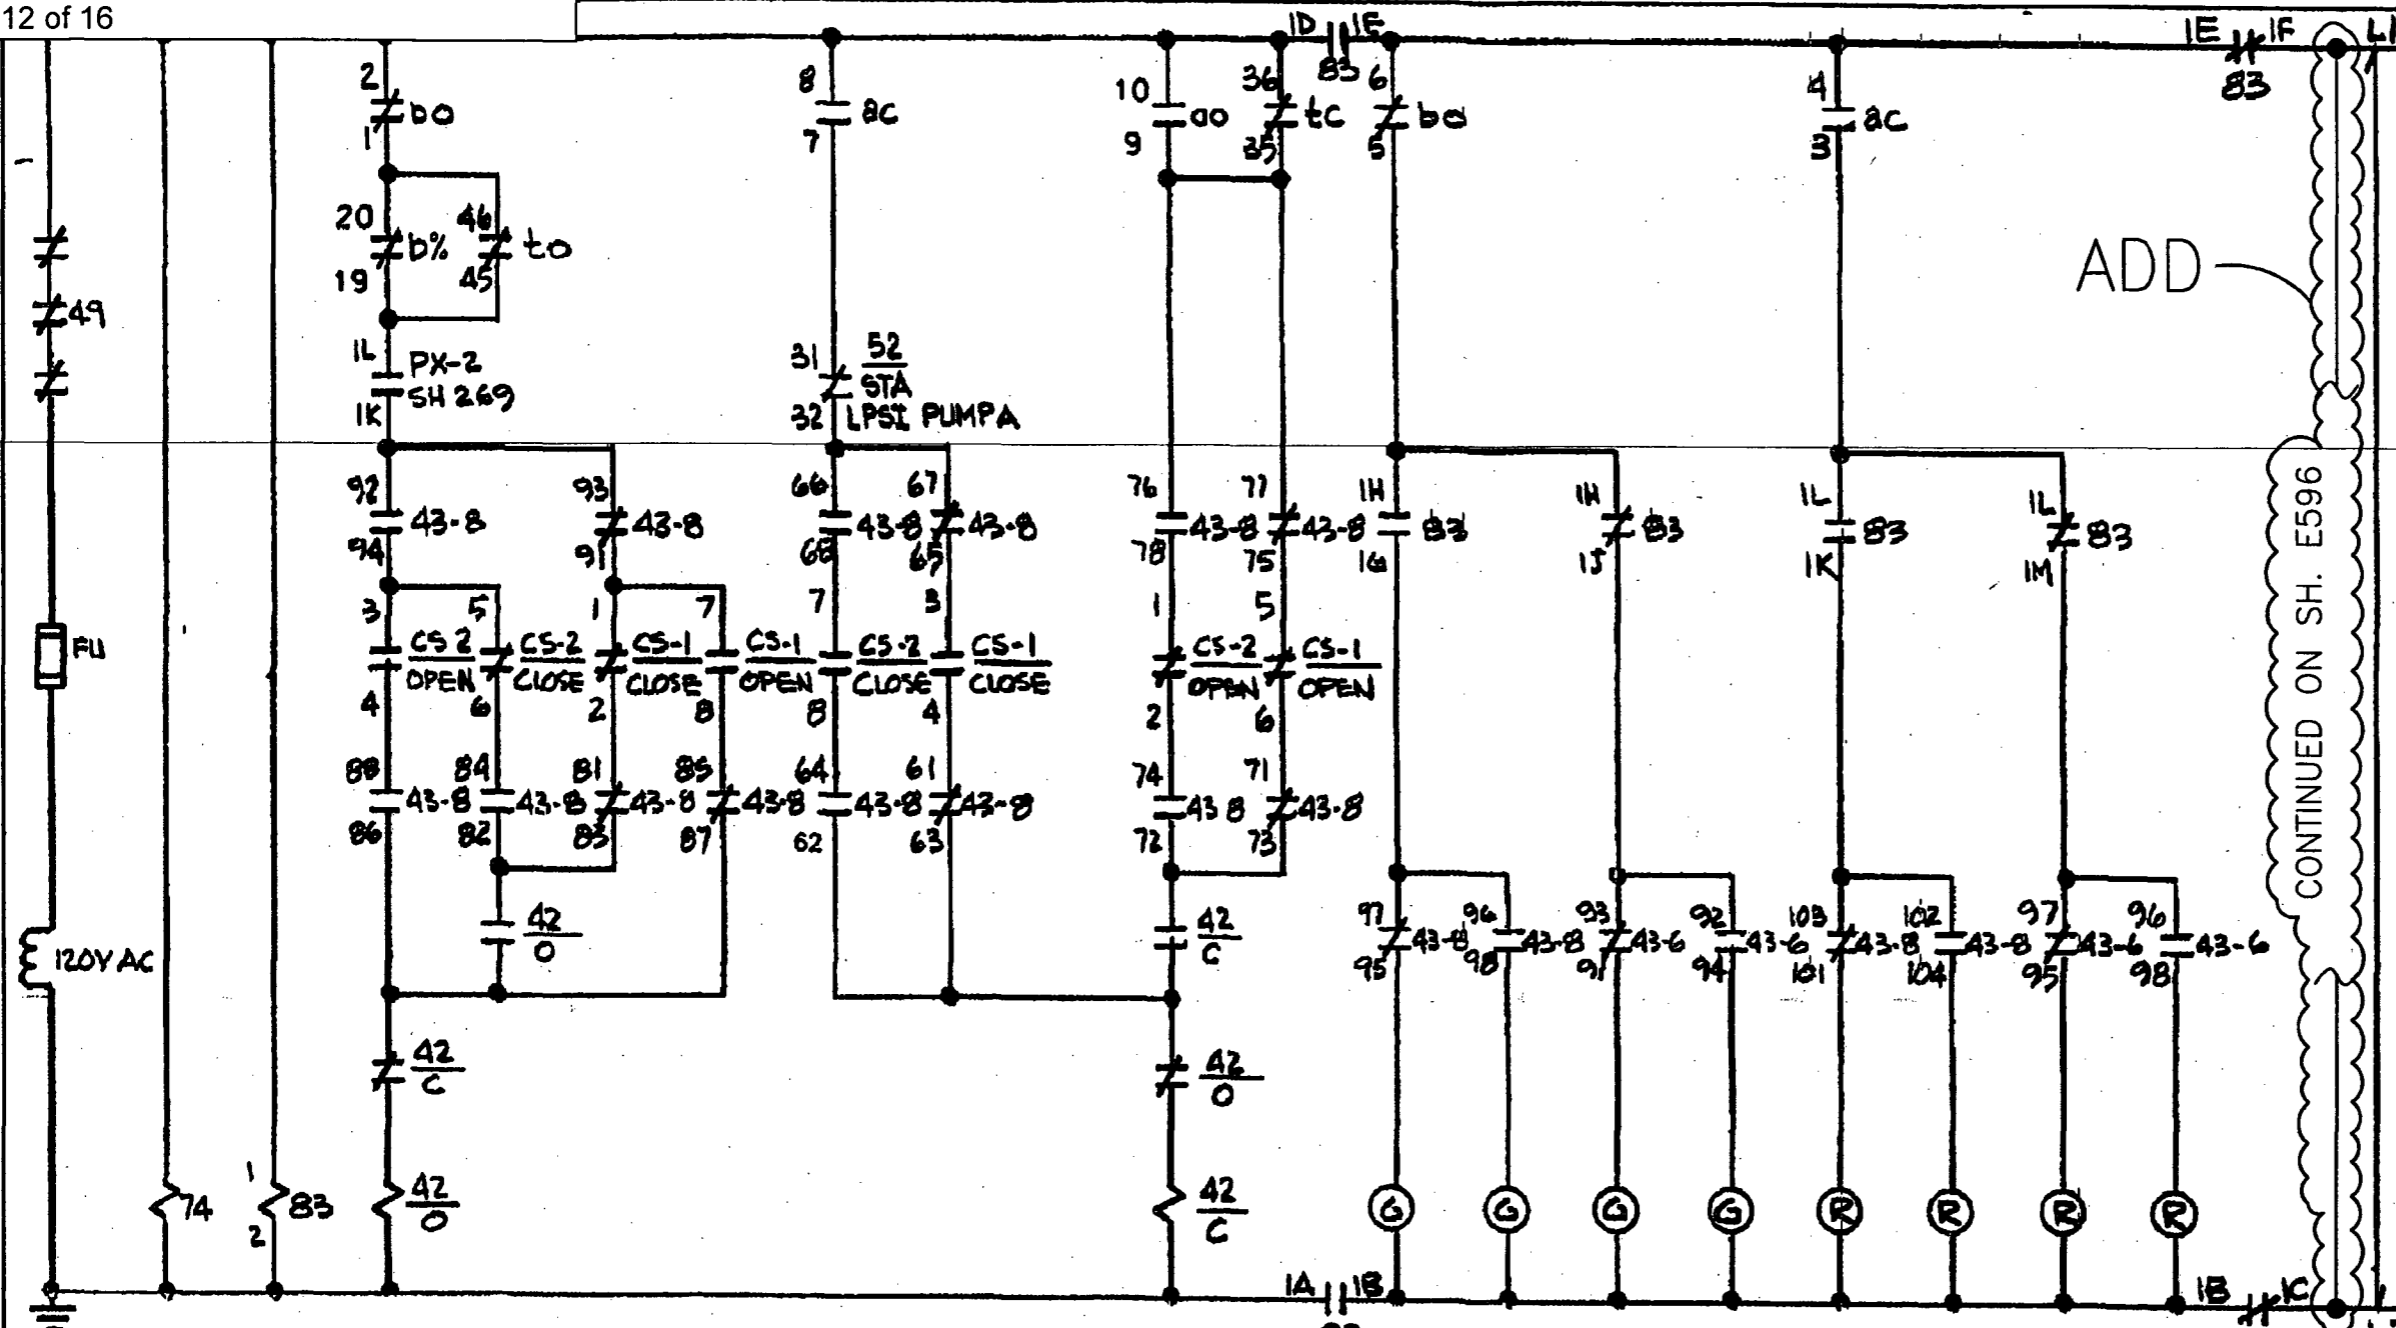

NOTES

ADD

CONTINUED ON SH. E596

120V AC VITAL  
PDR 390-5A  
CKT # 6

LIMIT SWITCH DEVELOPMENT				
EBASCO SYMBOL	CONT	VALVE OPNG	CWD	DO SH.
bc	1-2	=====	*	*
bc	3-4	=====	*	*
bc	5-6	=====	*	*
bc	7-8	=====	*	*
bc	9-10	=====	*	*
bc	11-12	=====	2038	*
bc	13-14	=====	2038	*
bc	15-16	=====	595	*
bc	17-18	=====	*	*
bc	19-20	=====	*	*
bc	21-22	=====	*	*
bc	23-24	=====	*	*
bc	25-26	=====	595	*
bc	27-28	=====	*	*
bc	29-30	=====	*	*
bc	31-32	=====	*	*
to	35-36	OPENS ON OVERLOAD ON CLOSE STROKE	*	*
to	45-46	OPENS ON OVERLOAD ON OPEN STROKE	*	*

43-B TRANSFER SWITCH SH.2941  
\* THIS SHEET

Engineering Change Markup	EC#:	14766	Page	2 of 2
DOC#:	B-424	SHT#:	E595	REV
				7
Safety Related	<input checked="" type="checkbox"/> Before View	<input type="checkbox"/> Control Room Drawing	<input checked="" type="checkbox"/>	
Prepared By:	Date	Reviewer Name (Optional)		
	02/16/10	PC/DW/ML		

CONTACTS	POSITION			CWD SH.
	10	12	2	
1-2		x	x	*
3-4	x			*
5-6	x	x		*
7-8			x	*

CONTACTS	POSITION			CWD SH.
	9	12	3	
1-2	x	x		*
3-4			x	*
5-6		x	x	*
7-8	x			*

SPRING RETURN TO NORMAL FROM OPEN, MAINTAINED IN CLOSE, KEY REMOVABLE IN CLOSE POSITION ONLY

SPRING RETURN TO NORMAL

This drawing was used in its entirety to scan and rasterize to produce this revision, REV 4

INCORP. SMP-964 RI, 249KJ, 2034 R3  
SMP-1493 RI  
(G-167-2)

REV	DATE	CH	APPROVED	REV	DATE	CH	APPROVED
7	2-10-99	C	[Signature]	3	7-28-00	[Signature]	[Signature]
6	12-2-99	[Signature]	RJC		7-6-00	[Signature]	[Signature]
5	10-2-99	[Signature]	LTP	2	12-29-00	[Signature]	[Signature]
4	10/22/99	DLH	VI	1	12-2-03	[Signature]	[Signature]

**EBASCO SERVICES INCORPORATED**  
DIV I B C OR DS  
CH S. LIN  
DATE JAN. 9, 1980  
APPROVED [Signature]


**LOUISIANA POWER & LIGHT CO.**  
WATERFORD S.E.S. UNIT NO. 3  
CONTROL WIRING DIAGRAM  
RCS LOOP 2 SHUTDOWN COOLING  
ISOLATION VA 151-V1604A

LOU-1564  
B-424  
SHEET E595



125V DC, PDP-3B1-DCS  
CKT. #9, SI-EBKR-1B-9  
FUSIBLE DISCONNECT SWITCH  
BOTH + AND -


Engineering Change Markup EC#: 14767	Page 2 of 2
DOC#: B424	SHT#: 591 REV 25
Safety Related: <input checked="" type="checkbox"/>	Before View: <input type="checkbox"/> Control Room Drawing: <input checked="" type="checkbox"/>
Prepared By: <i>[Signature]</i>	Date: 03/19/10
	Reviewer Name (Optional): <i>[Signature]</i>

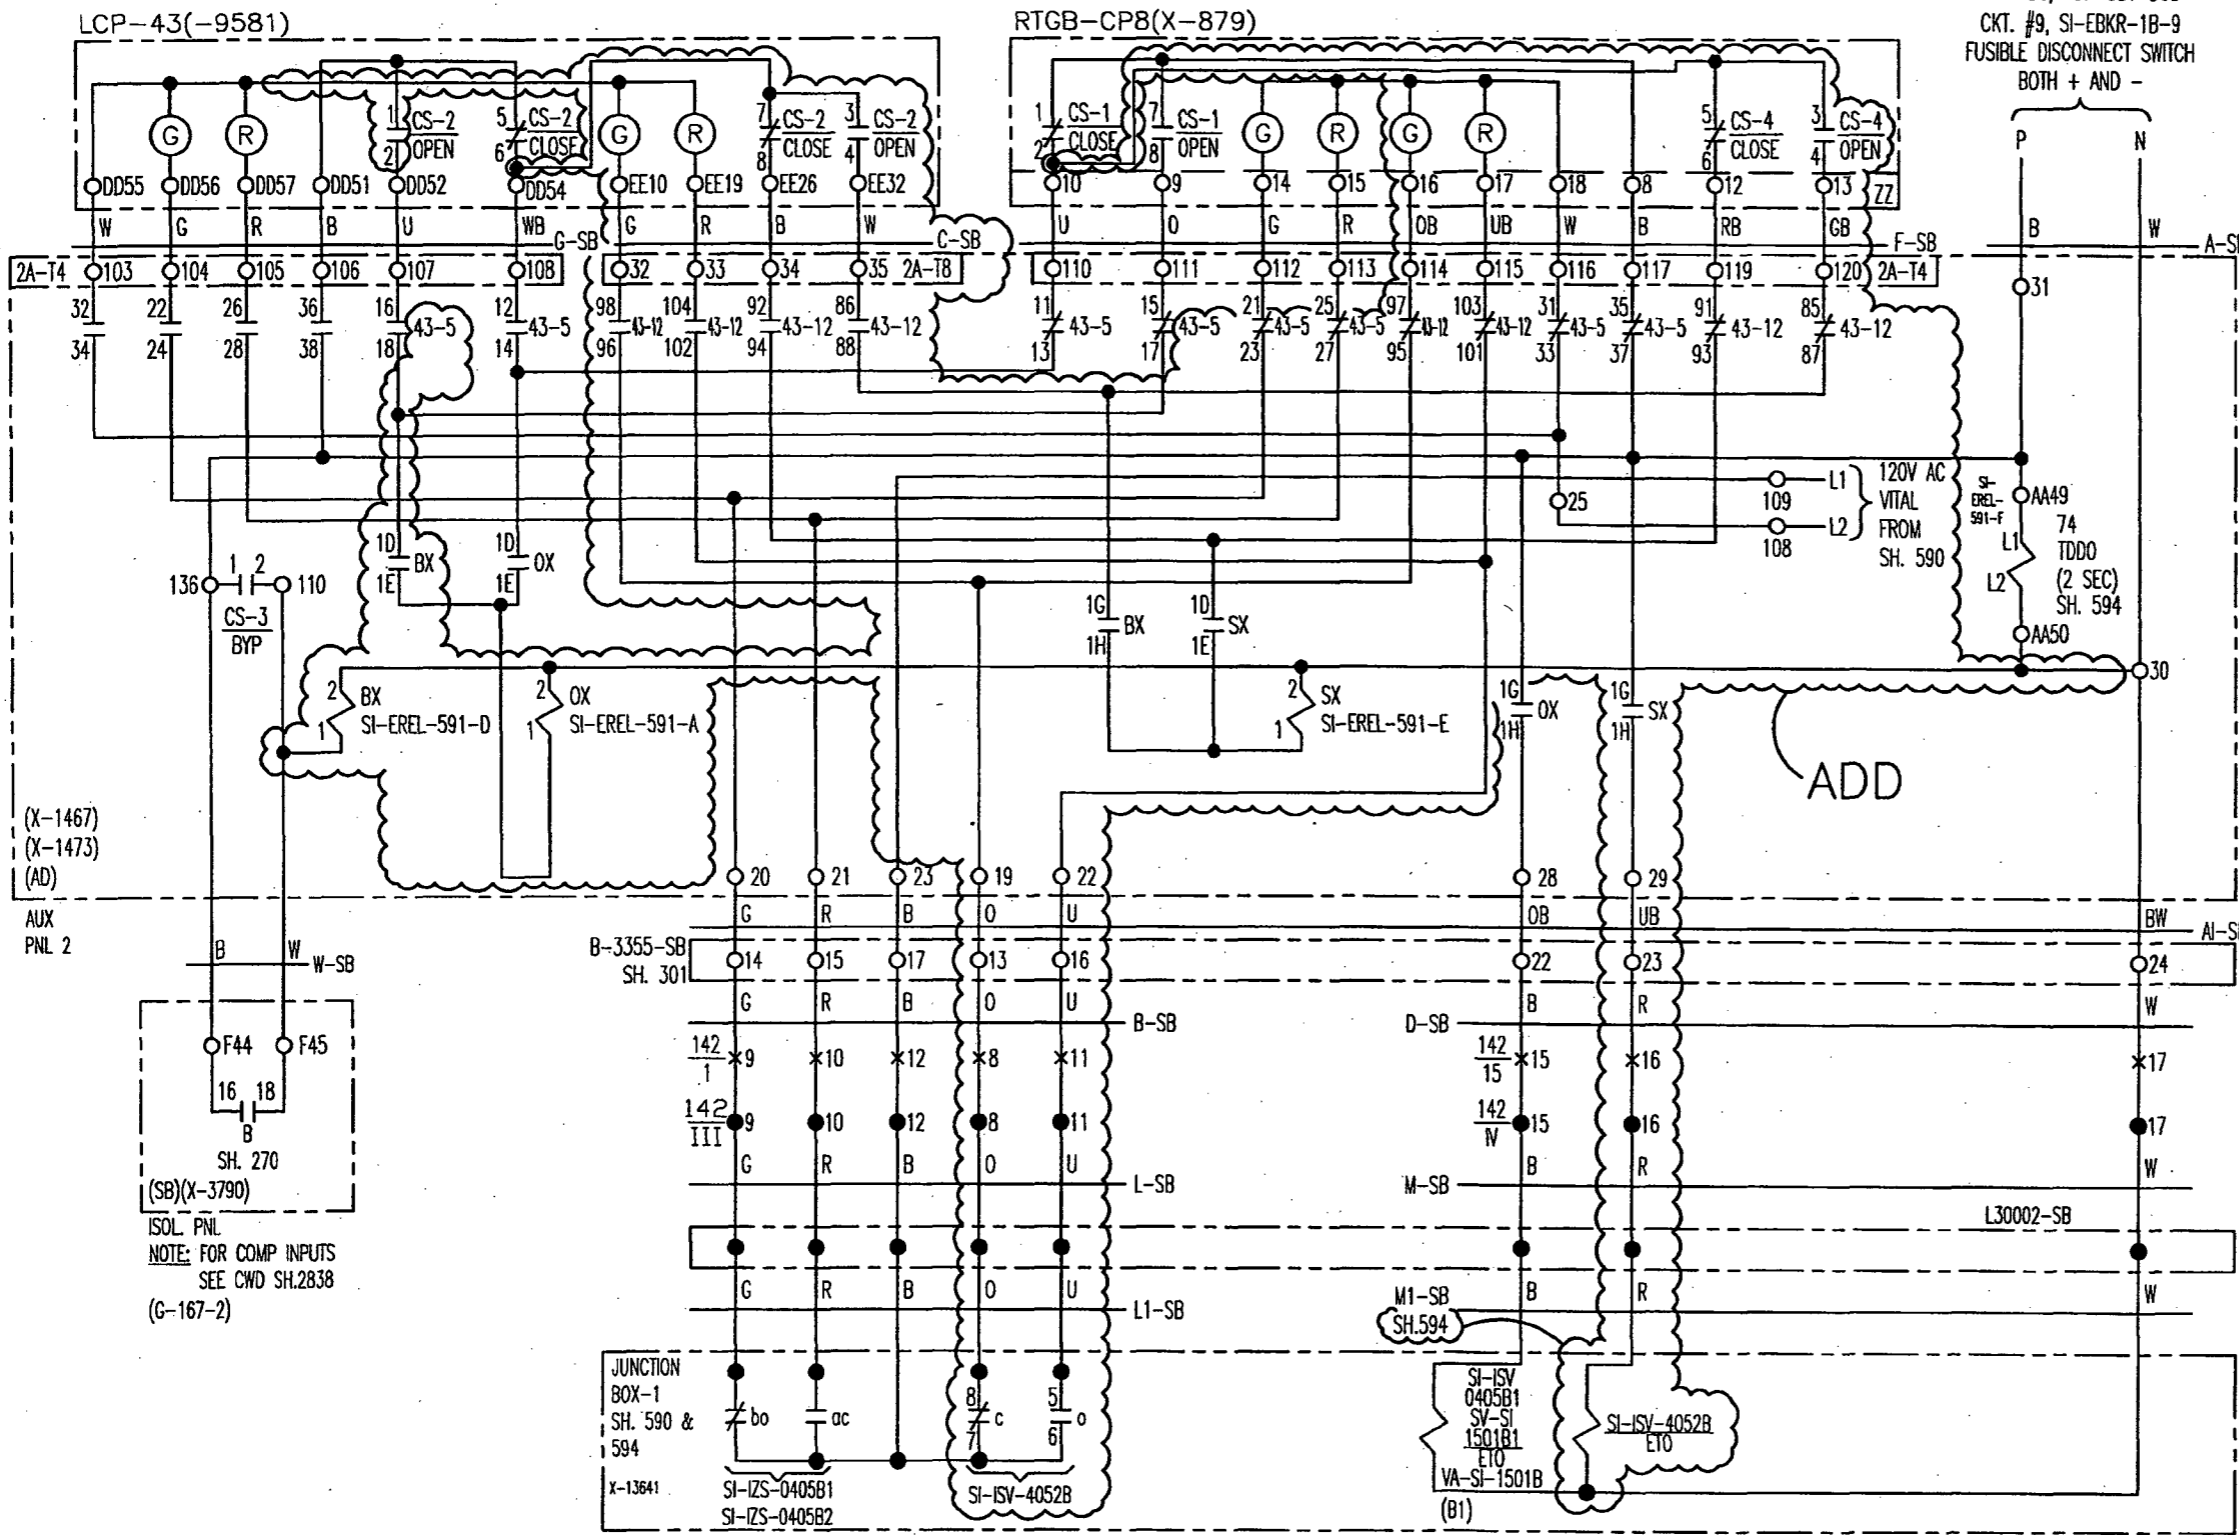

NOTE:  
FOR SWITCH DEVELOPMENTS SEE  
SH. E591.

ADD

ADD

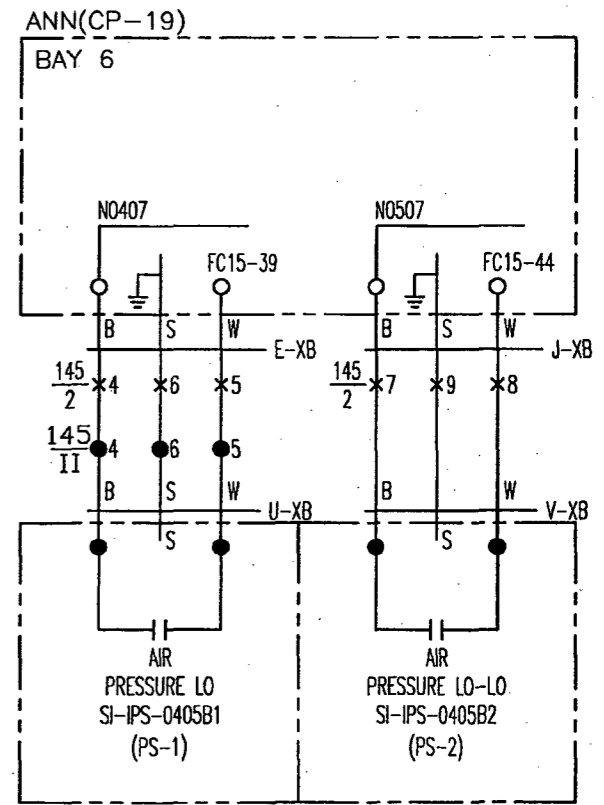


(X-1467)  
(X-1473)  
(AD)  
AUX PNL 2  
ISOL. PNL  
NOTE: FOR COMP INPUTS  
SEE CWD SH.2838  
(G-167-2)

BLOCK	CONTACTS	POSITION		CWD SHL
		10	2	
1	1-2		X	*
	3-4	X		

TYPE PTK \* THIS SHEET  
MAINTAINED CONTACTS  
KEY REMOVABLE IN NORM POSITION ONLY


25	6-5-08	JAG	DD	DD	22	4-9-94	ML	LB	N/A	EBASCO SERVICES INCORPORATED NEW YORK	LOUISIANA POWER & LIGHT CO. WATERFORD S. E. S. UNIT No.3 CONTROL WIRING DIAGRAM RCS LOOP I SHUTDOWN COOLING ISOLATION VA ISI-V1501B	B424 SHEET 591
24	12-5-00	JAG	RJC	N/A	20	8-16-80	MAM	JK	MM			
23	4-5-95	DD	THS	CB	19	10-5-89				APPROVED <i>[Signature]</i>		
REV	DATE	BY	APPROVED	REV	DATE	BY	APPROVED	DATE	NOV 2, 1976			

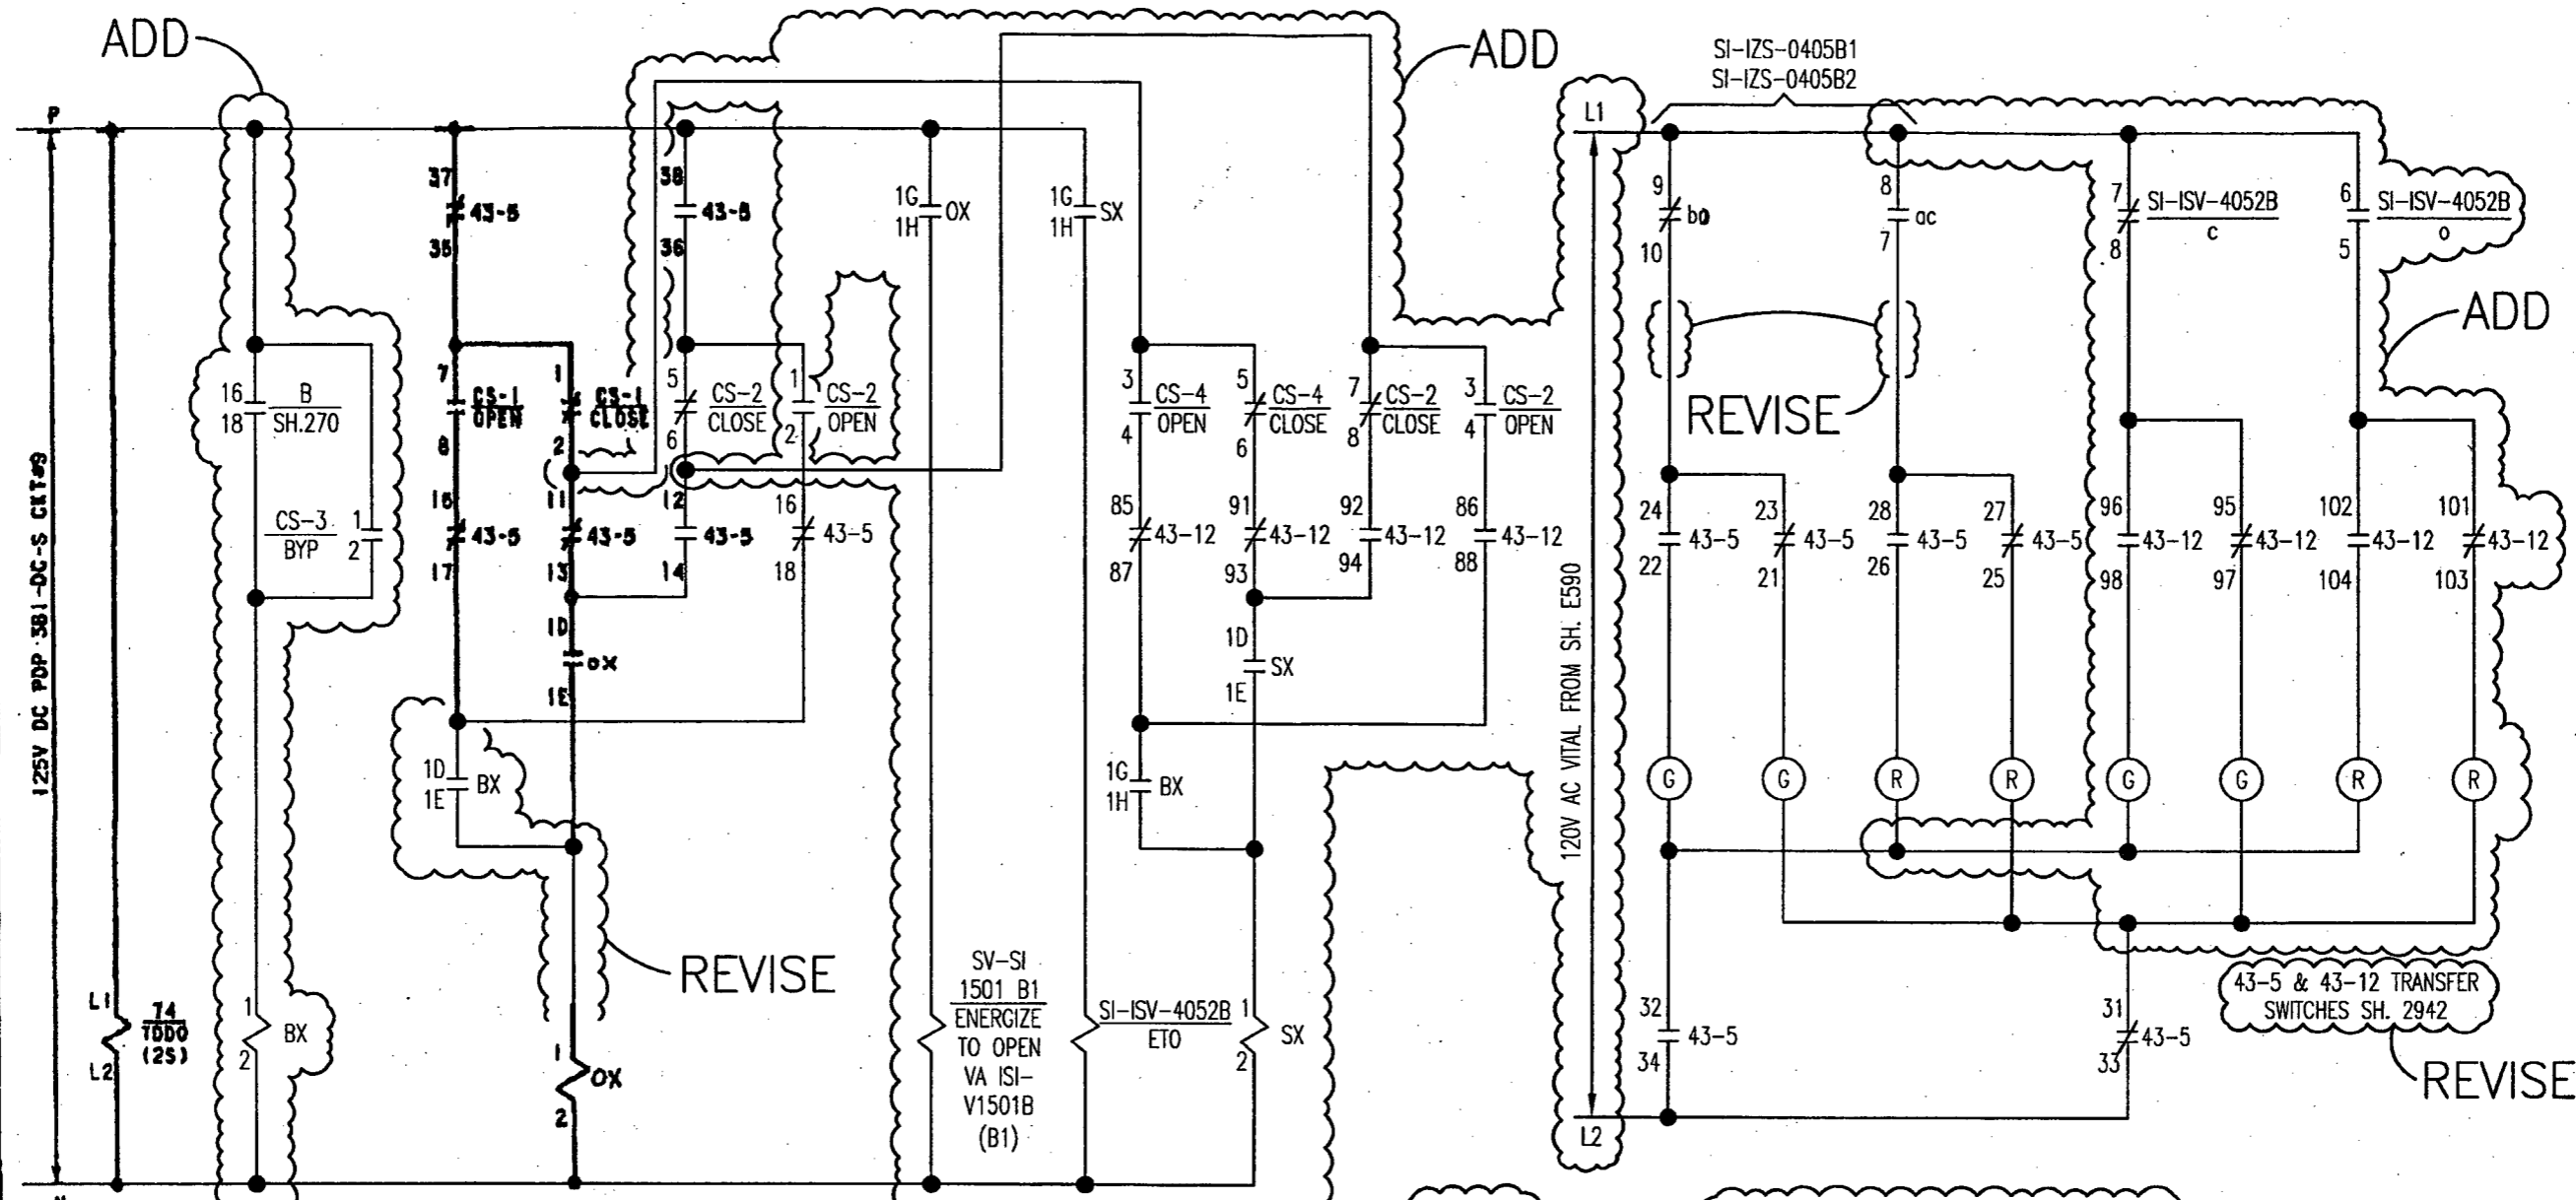

CS-3 (AUX PNL 2)

BLOCK	CONTACTS	POSITION		CWD SH.
		10	2	
1	1-2		X	*
	3-4	X		

MAINTAINED CONTACTS. KEY REMOVABLE IN NORM POSITION ONLY

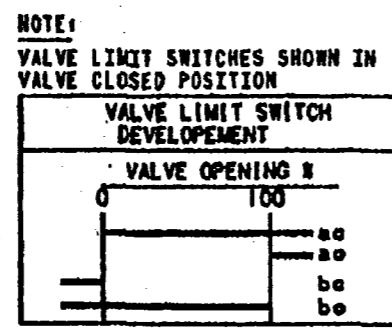

CS-4

CONTACTS	POSITION			CWD SH.
	9 close	12 NORM	3 open	
1-2	x	x		
3-4			x	*
5-6		x	x	*
7-8	x			

TYPE CMC SPRING RETURN TO NORMAL

CS-2

CONTACTS	BLOCK	POSITION			CWD SH.
		9 close	12 NORM	3 open	
1-2	2			x	*
5-6	2		x	x	*
3-4	1		x		*
7-8	1		x	x	*

TYPE CMC SPRING RETURN TO NORMAL

CS-1 (RTGB)

CONTACTS	POSITION			CWD SH.
	10 CLOSED	12 NORM	2 OPEN	
1-2		x	x	*
3-4	x			
5-6	x	x		
7-8			x	*

TYPE PTK SPRING RETURN FROM OPEN TO NORM, MAINTAINED IN CLOSE KEY REMOVAL IN CLOSE POS ONLY

\* THIS SHEET

Engineering Change Markup EC#: 14767 Page 2 of 2  
 DOC#: B424 SHT#: E591 REV 5

Safety Related:  Before View  Control Room Drawing:   
 Prepared By: [Signature] Date: 03/19/10 Reviewer Name (Optional): [Signature]

(G-167-2)


REV.	DATE	BY	APPROVAL
5	6-3-08	DD JAG JAG	
4	12-5-00	JAG RJC N/A	

**EBASCO SERVICES INCORPORATED**  
 DIV I & E DR 05  
 CH S. LIN  
 DATE JAN. 2, 1980


APPROVED [Signature]

**LOUISIANA POWER & LIGHT CO.**  
**WATERFORD S.E.S. UNIT NO. 3**  
**CONTROL WIRING DIAGRAM**  
 RCS LOOP 1 SHUTDOWN COOLING ISOLATION VA 1SI-V1501B


B424  
 SHEET E591

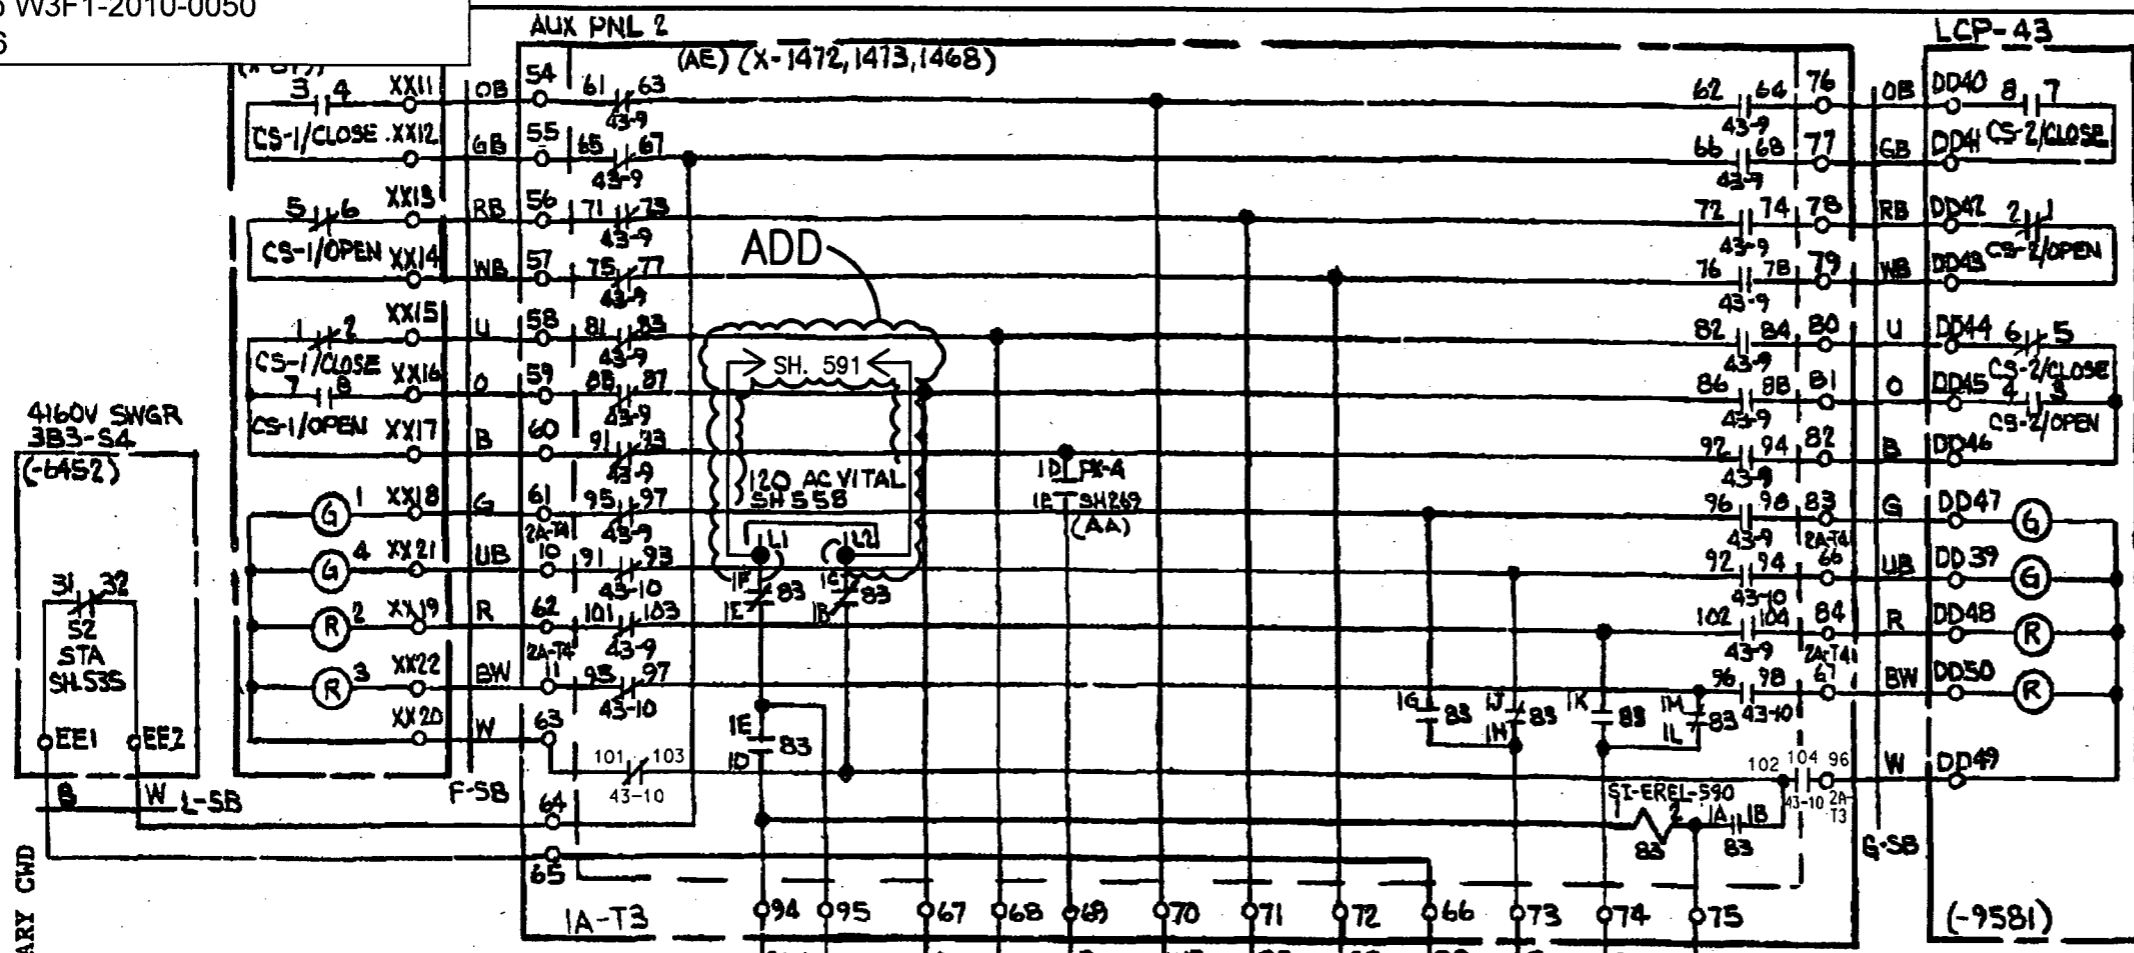

REFERENCE ELEMENTARY CWD

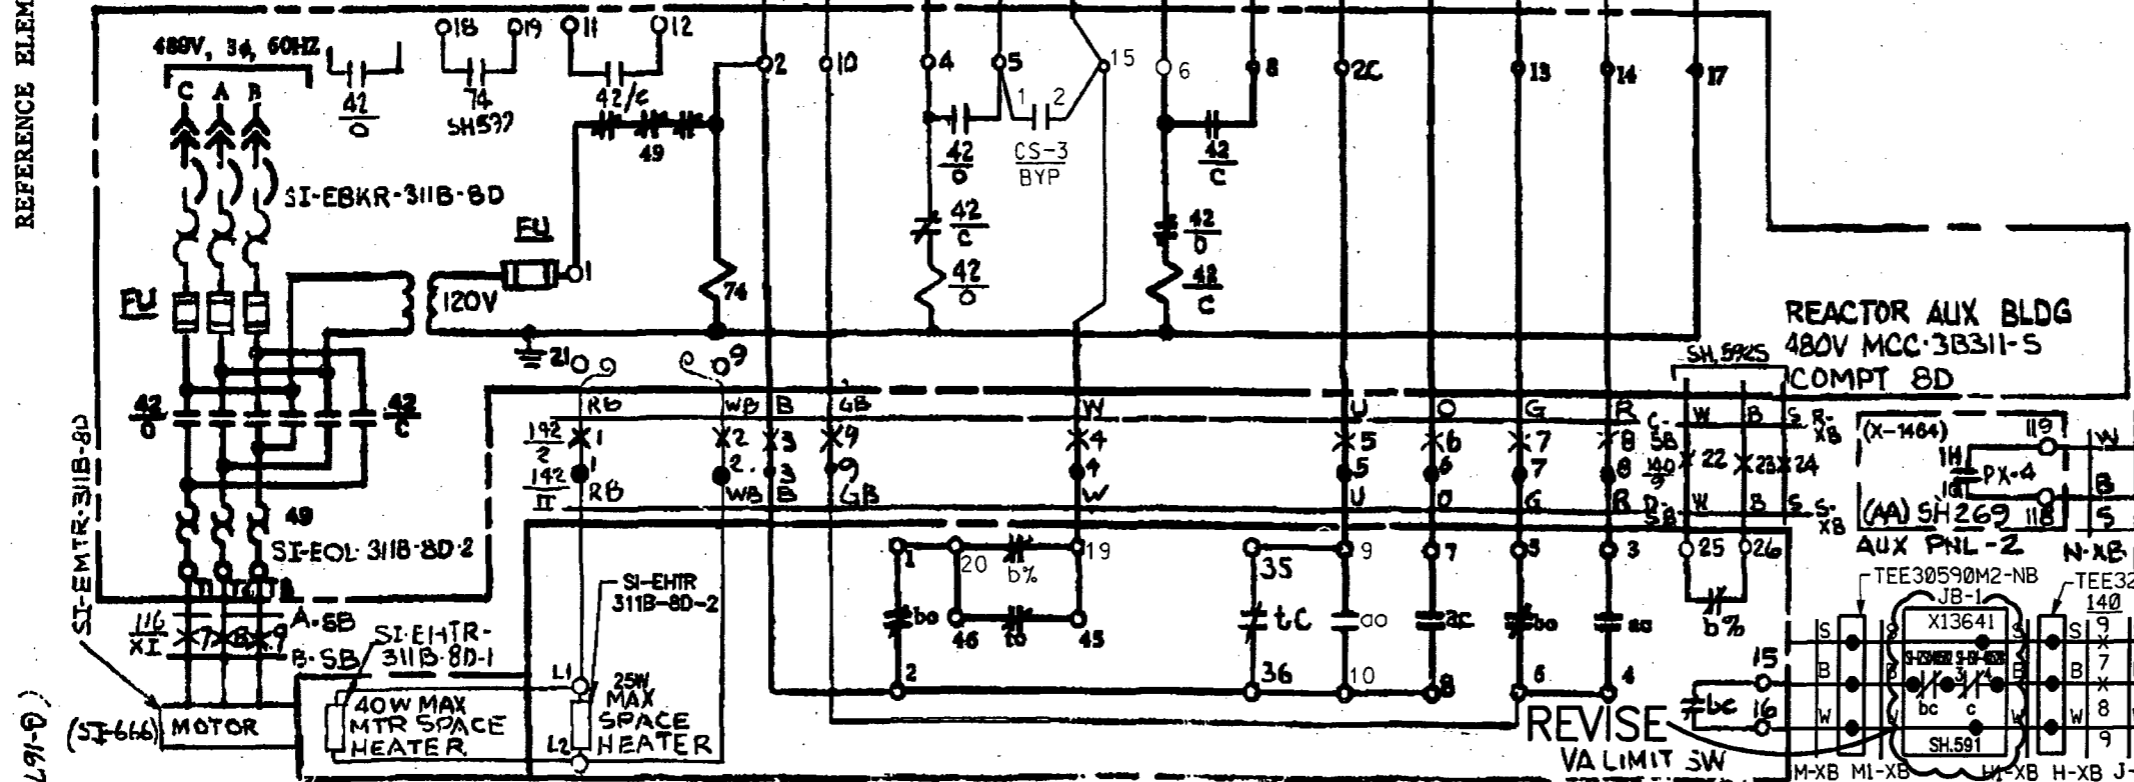


(-1672)

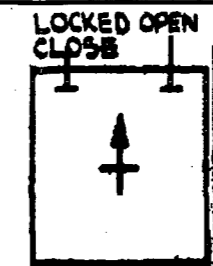

CONTACTS	POSITION			CWD SH.
	10	12	2	
1-2		X	X	#
3-4	X			#
5-6	X	X		#
7-8			X	#

TYPE PTK \* THIS SHEET SPRING RETURN TO NORM FROM OPEN, MAINTAINED IN CLOSE, KEY REMOVABLE IN CLOSE POSITION ONLY.


RCS LOOP 1 SHDN CLG UPSTRM ISOLVA IN

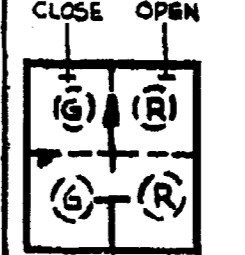

CONTACTS	POSITION			CWD SH.
	9	12	3	
1-2	X	X		#
3-4			X	#
5-6		X	X	#
7-8	X			#


TYPE GME \* THIS SHEET SPRING RETURN TO NORM

RCS LOOP SHDN CLG UPSTRM ISOLVA IN

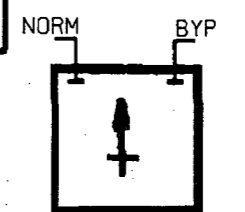

BLOCK	CONTACTS	POSITION		CWD SH.
		10	2	
1	1-2		X	*
	3-4	X		

TYPE PTK \* THIS SHEET MAINTAINED CONTACTS KEY REMOVABLE IN NORM POSITION ONLY

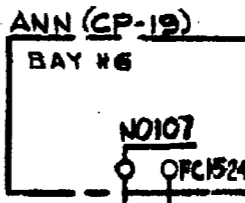

LIMIT SW DEVELOPMENT				
EMASCO SYM	CONT	VALVE	OPEN	CWD SH.
85	1-2			*
85	3-4			*
85	5-6			*
85	7-8			*
85	9-10			*
85	11-12			2/38
85	13-14			2/38
85	15-16			*
85	17-18			*
85	19-20			*
85	21-22			*
85	23-24			*
85	25-26			*
85	27-28			*
85	29-30			*
85	31-32			*
85	33-34			*
85	35-36			*
85	37-38			*
85	39-40			*
85	41-42			*
85	43-44			*
85	45-46			*

Engineering Change Markup EC#: 14767	Page 2 of 2
DOC#: B424	SHT#: 590 REV 32
Safety Related: <input checked="" type="checkbox"/>	Before View <input type="checkbox"/>
Control Room Drawing: <input checked="" type="checkbox"/>	
Prepared By: <i>Kate Walker</i>	Date: 10/03/09
Reviewer Name (Optional): P. A. Co. DAF	


REV.	DATE	BY	APPROVAL	REV.	DATE	BY	APPROVAL
30	12-5-00	JAG	RJC	N/A			
29	9-19-97	THS	RJC	N/A			
32	6-2-08	DD	JAG	JAG	28	9-21-95	LLB ML PJB
31	2-12-06	JAG	DDD	N/A	27	2-10-95	DDD THS EF

**KBASCO SERVICES INCORPORATED**  
NEW YORK

BY: *JAG* DATE: *SEP 28, 1976*

**LOUISIANA POWER & LIGHT CO.**  
WATERFORD S. E. UNIT No. 3  
CONTROL WIRING DIAGRAM  
RCS LOOP No. 1 SHUTDOWN  
COOLING ISOL VASI-V1502

B424  
SHEET 590

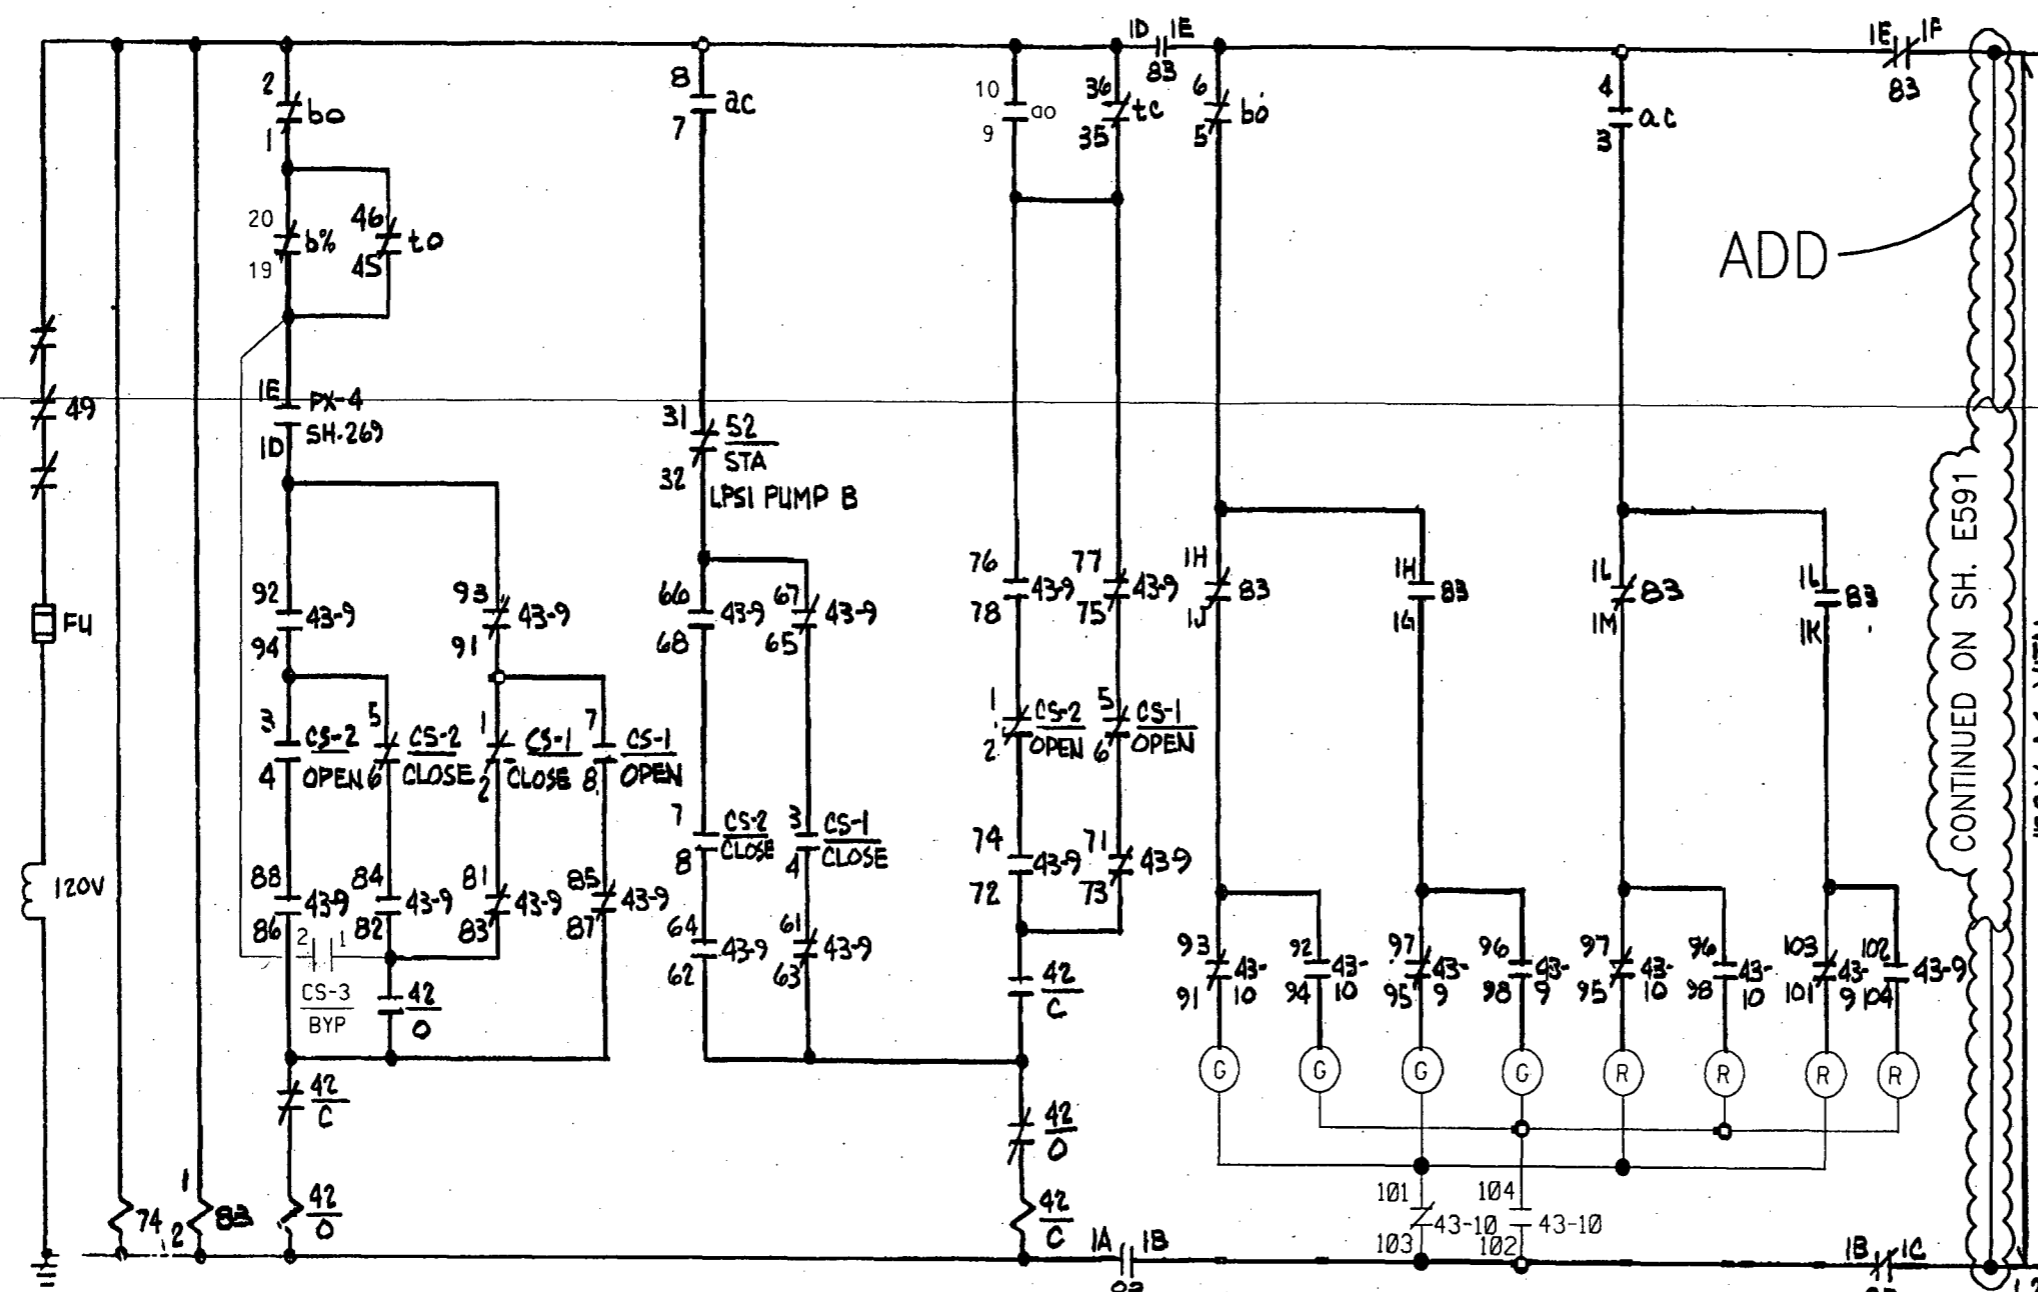

NOTES:

ADD

CONTINUED ON SH. E591

120 V AC VITAL  
PDP 391-SB  
CKT #6

CS-3

BLOCK	CONTACTS	POSITION		CWD SH
		10	2	
1	1-2		X	*
	3-4	X		

MAINTAINED CONTACTS  
KEY REMOVABLE IN  
NORM POSITION ONLY

CS-1 (RTGB)

CONTACTS	POSITION			CWD SH
	10	12	2	
	CLOSE	NORM	OPEN	
1-2		X	X	*
3-4	X			*
5-6	X	X		*
7-8			X	*

SPRING RETURN TO NORMAL  
FROM OPEN, MAINTAINED  
IN CLOSE, KEY REMOVABLE  
IN CLOSE POSITION ONLY

CS-2 (LOCAL)

CONTACTS	POSITION			CWD SH
	9	12	3	
	CLOSE	NORM	OPEN	
1-2	X	X		*
3-4			X	*
5-6		X	X	*
7-8	X			*

SPRING RETURN TO NORMAL

LIMIT SWITCH DEVELOPMENT			
EBASCO SYMBOL	CONT	VALVE OPNG & CWD SH.	
bc	1-2	=====	*
bc	3-4	=====	*
bc	5-6	=====	*
bc	7-8	=====	*
bc	9-10	=====	*
bc	11-12	=====	2838
bc	13-14	=====	2838
bc	15-16	=====	590
bc	17-18	=====	
bc	19-20	=====	*
bc	21-22	=====	
bc	23-24	=====	
bc	25-26	=====	590
bc	27-28	=====	
bc	29-30	=====	
bc	31-32	=====	
tc	35-36	OPENS ON OVERLOAD ON CLOSE STROKE	*
tc	45-46	OPENS ON OVERLOAD ON OPEN STROKE	*

43-10, 43-9 TRANSFER SWITCH SN.2942

\* THIS SHEET

Engineering Change Markup	EC#:	14767	Page	2 of 2
DOC#:	B424	SHT#:	E590	REV
				9
Safety Related	<input checked="" type="checkbox"/>	Before View	<input type="checkbox"/>	Control Room Drawing
	<input checked="" type="checkbox"/>			<input checked="" type="checkbox"/>
Prepared By:	<i>R. O. S.</i>	Date:	02/16/10	Reviewer Name (Optional):
				<i>[Signature]</i>

(G-167-2)

This drawing was used in its entirety to scan and rasterize to produce this revision, REV 4.

REV	DATE	BY	APPROVED	REV	DATE	BY	APPROVED
				7	2-9-95	C	DDD EF
				6	12-2-92	EB ML	RJC N/A
				5	10-3-91	ML HU	LFP TMG
				8	12-5-00	JAG RJC	N/A
				4	10/22/90	DLH VI	MM

**EBASCO SERVICES INCORPORATED**  
DIV I.B.C. OR DS  
CH S.LIN  
DATE JAN. 9, 1980  
APPROVED  
*[Signature]*

**LOUISIANA POWER & LIGHT CO.**  
WATERFORD S.E.S. UNIT NO.3  
CONTROL WIRING DIAGRAM  
RCS LOOP 1 SHUTDOWN  
COOLING ISOLATION VA 151-V1502B

B424  
SHEET E590