


REVISIONS	
1	THIS ISSUE IS NON-CLASS "A" PER CI 240-1. RELEASE FOR RECORD. P.N. 7076 11-3-78
2	THIS REVISION IS NON-CLASS "A" PER CI-240-1. ADDED REF. DRAWINGS. ADDED LATEST REV. NO. TO REF. DWG. RELEASE FOR RECORD. P.N. 7076 J.R.J.S
3	BBASCO SERVICES, INC. 1-10-82
4	THIS REVISION IS CLASS A PER CI-240-1 UPDATED DWG. PER AS-BUILT INFORMATION AND SERVICE INSPECTION FIELD INFORMATION. RELEASED FOR RECORD. P/N 21369 TREADWELL CORP 11-12-82
5	THIS REVISION IS NON-CLASS PER CI-240-1. UPDATED DWG. PER INFORMATION RECEIVED FROM FIELD. RELEASE FOR RECORD. P.N. 21369 WJ/RC 5/16/84
6	THIS REV IS NON-CLASS PER CI-240-1. CHANGED DISCIPLINE CODE FROM MS TO ME. RELEASE FOR RECORD. J.J./J.H.

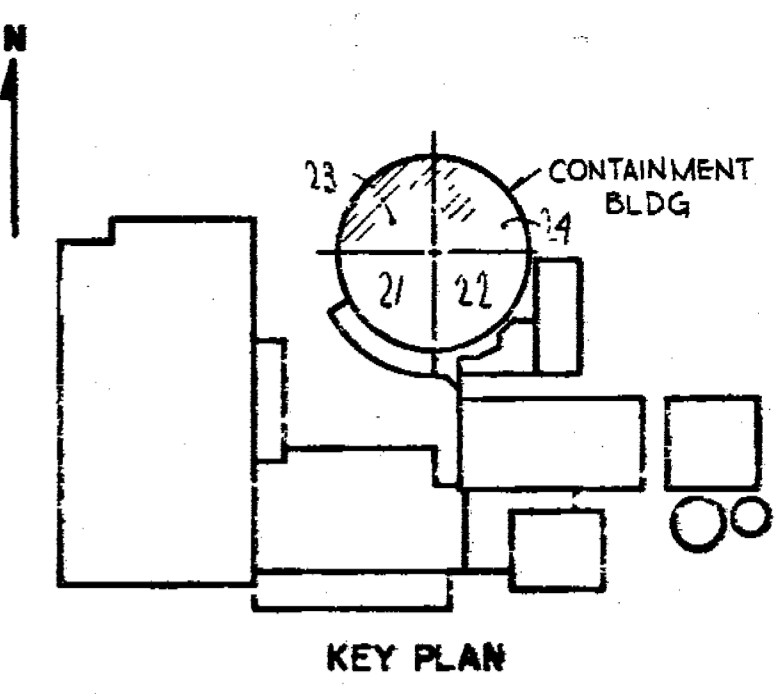

THIS REVISION IS CLASS A PER CI-240-1 UPDATED DWG. PER AS-BUILT INFORMATION AND SERVICE INSPECTION FIELD INFORMATION. RELEASED FOR RECORD. P/N 69982-AD-4 NPS 12/16/93 AAA

REFERENCE DRAWINGS

- FLOW DIAGRAM MAIN STEAM SYSTEM 9321-F-2017
- CONTAINMENT BUILDING MAIN STEAM PIPING PLAN - STEAM GEN'S NO. 23 & 24 9321-F-2540
- SECTIONS & DETAILS STEAM GENERATORS NO. 23 & 24 9321-F-2542
- ARR'GT OF PIPE RESTRAINTS NORTH HALF - SHEET 1 9321-F-2798

Docket # 50-247
 Accession # 990310017
 Date 2/28/94 of L
 Regulatory Docket File

NOT FOR FABRICATION OR INSTALLATION

B206661-5
CONSOLIDATED EDISON CO.
 OF NEW YORK, INC.

STATION INDIAN POINT No 2	
INSERVICE INSPECTION ISOMETRIC OF MAIN STEAM LINE No 4 INSIDE CONTAINMENT	
SCALE NONE	DRAWN BY C. ZAPATA
P/N 7076	CHECKED BY M. STEINAUER
DATE 11/3/78	DATE 1/24/84
GENERAL ENGINEERING	CHIEF DESIGN ENGINEER
MECHANICAL ENGINEERING	MECH PLANT ENGINEER
CIVIL ENGINEERING	PLANT STRUCT ENGINEER
ELECTRICAL ENGINEERING	T & D STRUCT ENGINEER
GAS & STEAM OPERATIONS	STATION ELEC ENGINEER
PRODUCTION	T & D ENGINEER
	STRUCT ENGINEER
	CONVENTIONAL POWER
	NUCLEAR POWER

NOT FOR FABRICATION OR INSTALLATION

THIS DRAWING CONTAINS ITEMS WHICH MUST BE CONTROLLED WITHIN CON EDISON AS:
"CLASS A" ITEMS
 PER CI-240-1

SYMBOL IDENTIFICATION

- — SUPPORT NUMBER
- ⬡ — WELD NUMBER
- △ — QUALITY GROUP CLASSIFICATION
- ▭ — INTEGRAL SUPPORT WELD NUMBER
- ** — STRUCTURAL DISCONTINUITY PER TABLE IWC-2520

ANSTEC APERTURE CARD

TYPICAL WELD DETAIL DRAWINGS
 28" CLASS A-1, .912" MIN. WALL - D208033

GENERAL NOTES:

1. WELDS LESS THAN 2 1/2" NOM. PIPE DIA. SOCKET WELDED; 2 1/2" AND LARGER - BUTT WELDED
2. WELDS IN QUALITY GROUP B PIPING, FOUR INCH NOM. PIPE DIA. OR LESS ARE EXEMPT FROM NDT REQUIREMENTS PER IWC-1222 (a) & (b).
3. (*) INDICATES REMOVABLE INSULATION

