


VALVE BONNET BONNET

VALVE NO.	VALVE TYPE	NO. OF BOLTS	BOLT DIA.	BOLT TYPE	VALVE MANUFACTURER	MANUFACTURER DWG. NO.
856D	2-TM50FM				VELAN	137110
856F						
857A	2-C58				CONVAL	
857D	2-C58				CONVAL	
857H	2-C58				CONVAL	
857M	2-C58				CONVAL	

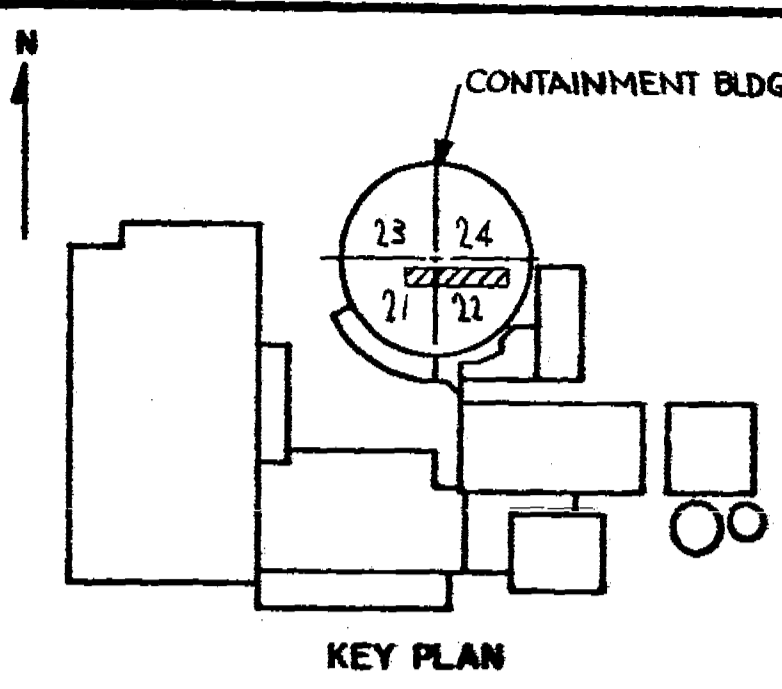

NO.	DATE	DESCRIPTION
0	11-3-78	THIS ISSUE IS NON-CLASS A PER CI 240-1. RELEASE FOR RECORD. P.N. 7076 11-3-78
3	11-3-78	THIS REVISION IS NON-CLASS PER CI 240-1 UPDATED DWG PER AS FOUND CONDITIONS. PKG # 6928. RELEASE FOR RECORD. P.N. 69911-CI 145/KE
4	5/4/81	THIS REV. IS NON-CLASS PER CI 240-1 CHANGED DISCIPLINE CODE FROM MT TO ML. RELEASE FOR RECORD. P.N. 69911-EI 183
5	12/22/94	THIS REVISION IS CLASS A PER CI 240-1 UPDATED DWG PER AS-BUILT INFORMATION AND SERVICE INSPECTION FIELD REVISION INFORMATION. RELEASE FOR RECORD. P/N 69982-AD-4 NPS 12-14-93 AAA

- GENERAL NOTES**
- WELDS IN QUALITY GROUP B PIPING 1 1/2 INCH NOM. PIPE DIA. OR LESS ARE EXEMPT FROM NDT REQUIREMENTS PER IWC-1221 (b).
  - WELDS LESS THAN 2 1/2" NOM PIPE DIA. SOCKET WELDED; 2 1/2" AND LARGER - BUTT WELDED
  - WELDS IN QUALITY GROUP A PIPING, ONE INCH NOM PIPE DIA. OR LESS ARE EXEMPT FROM NDT REQUIREMENTS PER IWB-1220 (b).
  - ⊕ INDICATES REMOVABLE INSULATION

THIS DRAWING CONTAINS ITEMS WHICH MUST BE CONTROLLED WITHIN CON EDISON AS: **"CLASS A" ITEMS PER CI-240-1**

- REFERENCE DRAWINGS**
- FLOW DIAGRAM - SAFETY INJECTION SYSTEM A235296
  - FLOW DIAGRAM - REACTOR COOLANT SYSTEM 9321-F-2736
  - CONTAINMENT BUILDING - SAFETY INJECTION SYSTEM - PLAN - SHEET No.1 9321-F-2614
  - CONTAINMENT BUILDING - SAFETY INJECTION SYSTEM - SECTIONS - SHEET No.1 9321-F-2615
  - CONTAINMENT BUILDING - SAFETY INJECTION SYSTEM - PLAN - SHEET No.2 9321-F-2617
  - MODIFICATION TO SAFETY INJECTION SYSTEM PIPING A206121
  - A206122

- SYMBOL IDENTIFICATION**
- - SUPPORT NUMBER
  - - VALVE NUMBER
  - ⬡ - WELD NUMBER
  - △ - QUALITY GROUP CLASSIFICATION
  - ▭ - INTEGRAL SUPPORT WELD NUMBER

**B206683-5**

**CONSOLIDATED EDISON CO.**  
OF NEW YORK, INC.

STATION LOCATION INDIAN POINT NUMBER 2  
INSERVICE INSPECTION ISOMETRIC OF SAFETY INJECTION LINE #16 INSIDE CONTAINMENT BUILDING

SHEET 3 OF 3

SCALE NONE DRAWN BY C. ZAPATA  
P.N. 7076 CHECKED BY SIMONE  
DATE 2/2/81

APPROVALS

GENERAL ENGINEERING	CHIEF DESIGNER	<i>[Signature]</i>
Mechanical ENGINEERING	MECH. PLAN. ENGINEER	<i>[Signature]</i>
CIVIL ENGINEERING	T & D STRUCT. ENGINEER	<i>[Signature]</i>
ELECTRICAL ENGINEERING	STATION ELECT. ENGINEER	
GAS & STEAM OPERATIONS	STRUCT. ENGINEER	
PRODUCTION	CONVENTIONAL NUCLEAR POWER	

ML