


8 206904
 LINE NO 352 - INSIDE
 INDIAN POINT NO 2

REVISIONS
 THIS ISSUE IS NON-CLASS A PER CI 240-1. RELEASE FOR RECORD. P.N. 7076 11-3-78

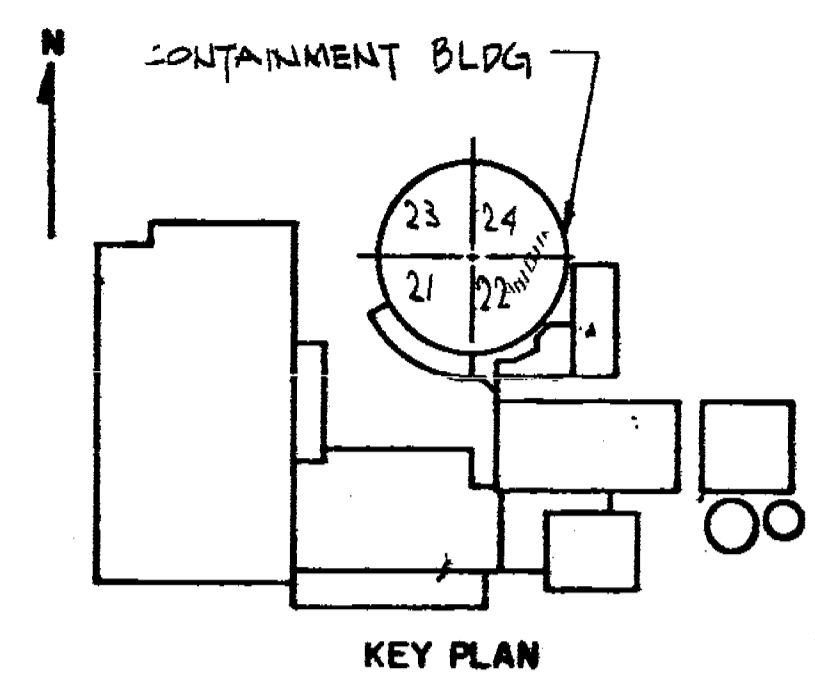

VALVE BONNET BOLTING

VALVE NO.	VALVE TYPE	NO. OF BOLTS	BOLT DIA.	BOLT TYPE	VALVE MANUFACTURER	MANUFACTURER DWG. NO.
B94B	10-VMSB FJ	10	1 7/8"	STUD BOLT	DARLING	11663
B95B	10-C4BZ	16	1 7/8"	STUD BOLT	DARLING	11542
B97B	10-C4BZ	16	1 7/8"	STUD BOLT	DARLING	11542

THIS REVISION IS NON-CLASS A PER CI-240-1. UPDATED DWG. TO SHOW WORK ON DWG. 9321-F-2614, THRU REV. 19. ADDED LATEST REV. NO TO REF. DWG'S. RELEASE FOR RECORD. P.N. 7076 AM/AS

THIS REVISION IS NON-CLASS A PER CI-240-1. UPDATED DWG. AS PER RESPONSE TO IE BULLETIN 79-14. AS CONSTRUCTED. RELEASE FOR RECORD. P.N. 90051 TREADWELL CORP. JC/SB

ADDED LATEST REV. NO TO REF. DWG'S, REMOVED SR-713 352-SR-2. RELEASE FOR RECORD. P.N. 21368 TREADWELL CORP. WSH/2/9/79

THIS REV. IS NON-CLASS PER CI-240-1 CHANGED DISCIPLINE CODE FROM MS TO ML. RELEASE FOR RECORD. P.N. 69982-AD-4 NPS 12/15/93 AAA

THIS REVISION IS CLASS A PER CI-240-1. UPDATED DWG. PER AS-BUILT INFORMATION AND SERVICE INSPECTION FIELD REVISION INFORMATION. RELEASE FOR RECORD. P/N 69982-AD-4 NPS 12/15/93 AAA

NOT FOR FABRICATION OR INSTALLATION
 THIS DRAWING CONTAINS ITEMS WHICH MUST BE CONTROLLED WITHIN CON EDISON AS:
"CLASS A" ITEMS
 PER CI-240-1

NOT FOR FABRICATION OR INSTALLATION

- GENERAL NOTES
1. QUALITY GROUP B PORTION OF LINE NO 352 FROM VALVE B94B TO AND INCLUDING ACCUMULATOR NO 22, EXEMPT FROM NDT REQUIREMENTS PER IWC-1221 (c), STATICALLY PRESSURIZED, PASSIVE PWR SI. SYSTEM.
 2. WELDS LESS THAN 2 1/2" NOM. PIPE DIA. - SOCKET WELDED 2 1/2" AND LARGER - BUTT WELDED
 3. WELDS IN QUALITY GROUP A PIPING, ONE INCH NOM PIPE DIA OR LESS EXEMPT FROM NDT REQUIREMENTS PER IWB-1220 (b).
 4. (R) INDICATES REMOVABLE INSULATION
 5. WELDS IN QUALITY GROUP B PIPING, FOUR INCH NOM. PIPE DIA OR LESS ARE EXEMPT FROM NDT REQUIREMENTS PER IWC-1221 (a).

- REFERENCE DRAWINGS
- FLOW DIAGRAM - SAFETY INJECTION SYSTEM - A235296
 - CONTAINMENT BUILDING SAFETY INJECTION SYSTEM PLAN SHT. 1 - 9321-F-2614
 - CONTAINMENT BUILDING SAFETY INJECTION SYSTEM PLAN SHT. 2 - 9321-F-2617

- SYMBOL IDENTIFICATION
- [Rectangle] SUPPORT NUMBER
 - [Oval] VALVE NUMBER
 - [Hexagon] WELD NUMBER
 - [Triangle] QUALITY GROUP CLASSIFICATION
 - [Double Line] INTEGRAL SUPPORT WELD NUMBER

TYPICAL WELD DETAIL DRAWINGS
 10" CLASS 2501, SCH 140S - D20B025
 10" CLASS 601, SCH 40S - D20B024

ANSTEC APERTURE CARD

B206904-4
CONSOLIDATED EDISON CO.
 OF NEW YORK, INC.

STATION LOCATION: INDIAN POINT NO 2
 INSERVICE: INSPECTION
 ISOMETRIC OF SAFETY INJECTION SYSTEM
 LINE NO 352 - INSIDE CONTAINMENT
 ACCUMULATOR NO 22 DISCHARGE

SCALE: NONE
 DRAWN BY: P. DENE
 PH: 7076
 CHECKED BY: M. STEINAUER
 DATE: 11/21/78

APPROVALS

GENERAL ENGINEERING	CHIEF DESIGN ENGINEER	[Signature]
MECHANICAL ENGINEERING	MECH. ENGINEER	[Signature]
CIVIL ENGINEERING	PLANT STRUCT. ENGINEER	[Signature]
ELECTRICAL ENGINEERING	T & D STRUCT. ENGINEER	[Signature]
GAS & STEAM OPERATIONS	STATION ELECT. ENGINEER	[Signature]
PRODUCTION	CONVENTIONAL POWER	[Signature]
	NUCLEAR POWER	[Signature]

Docket # 50-247
 Accession # 206904-4
 Date 2/28/94
 Regulatory Docket File