
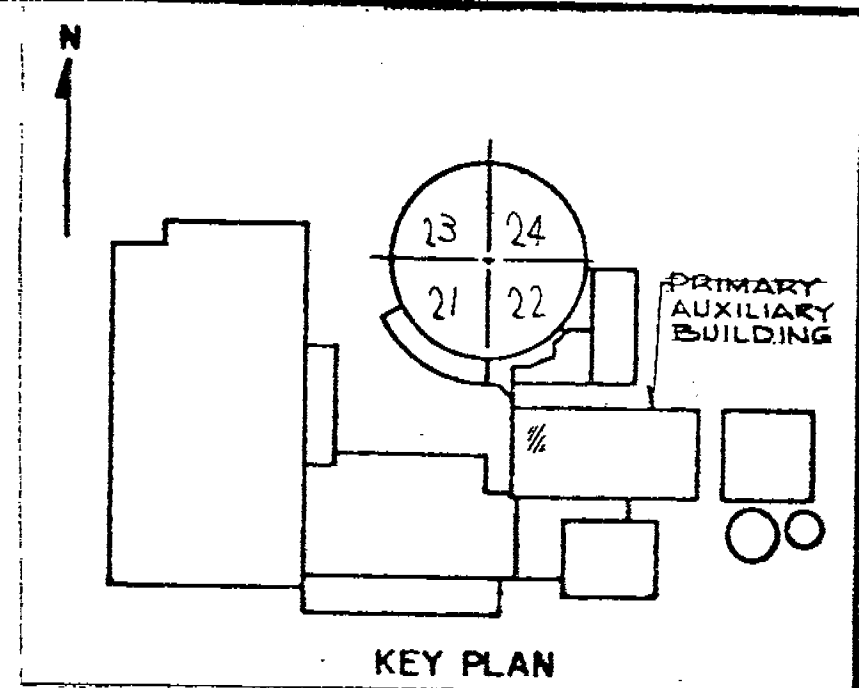


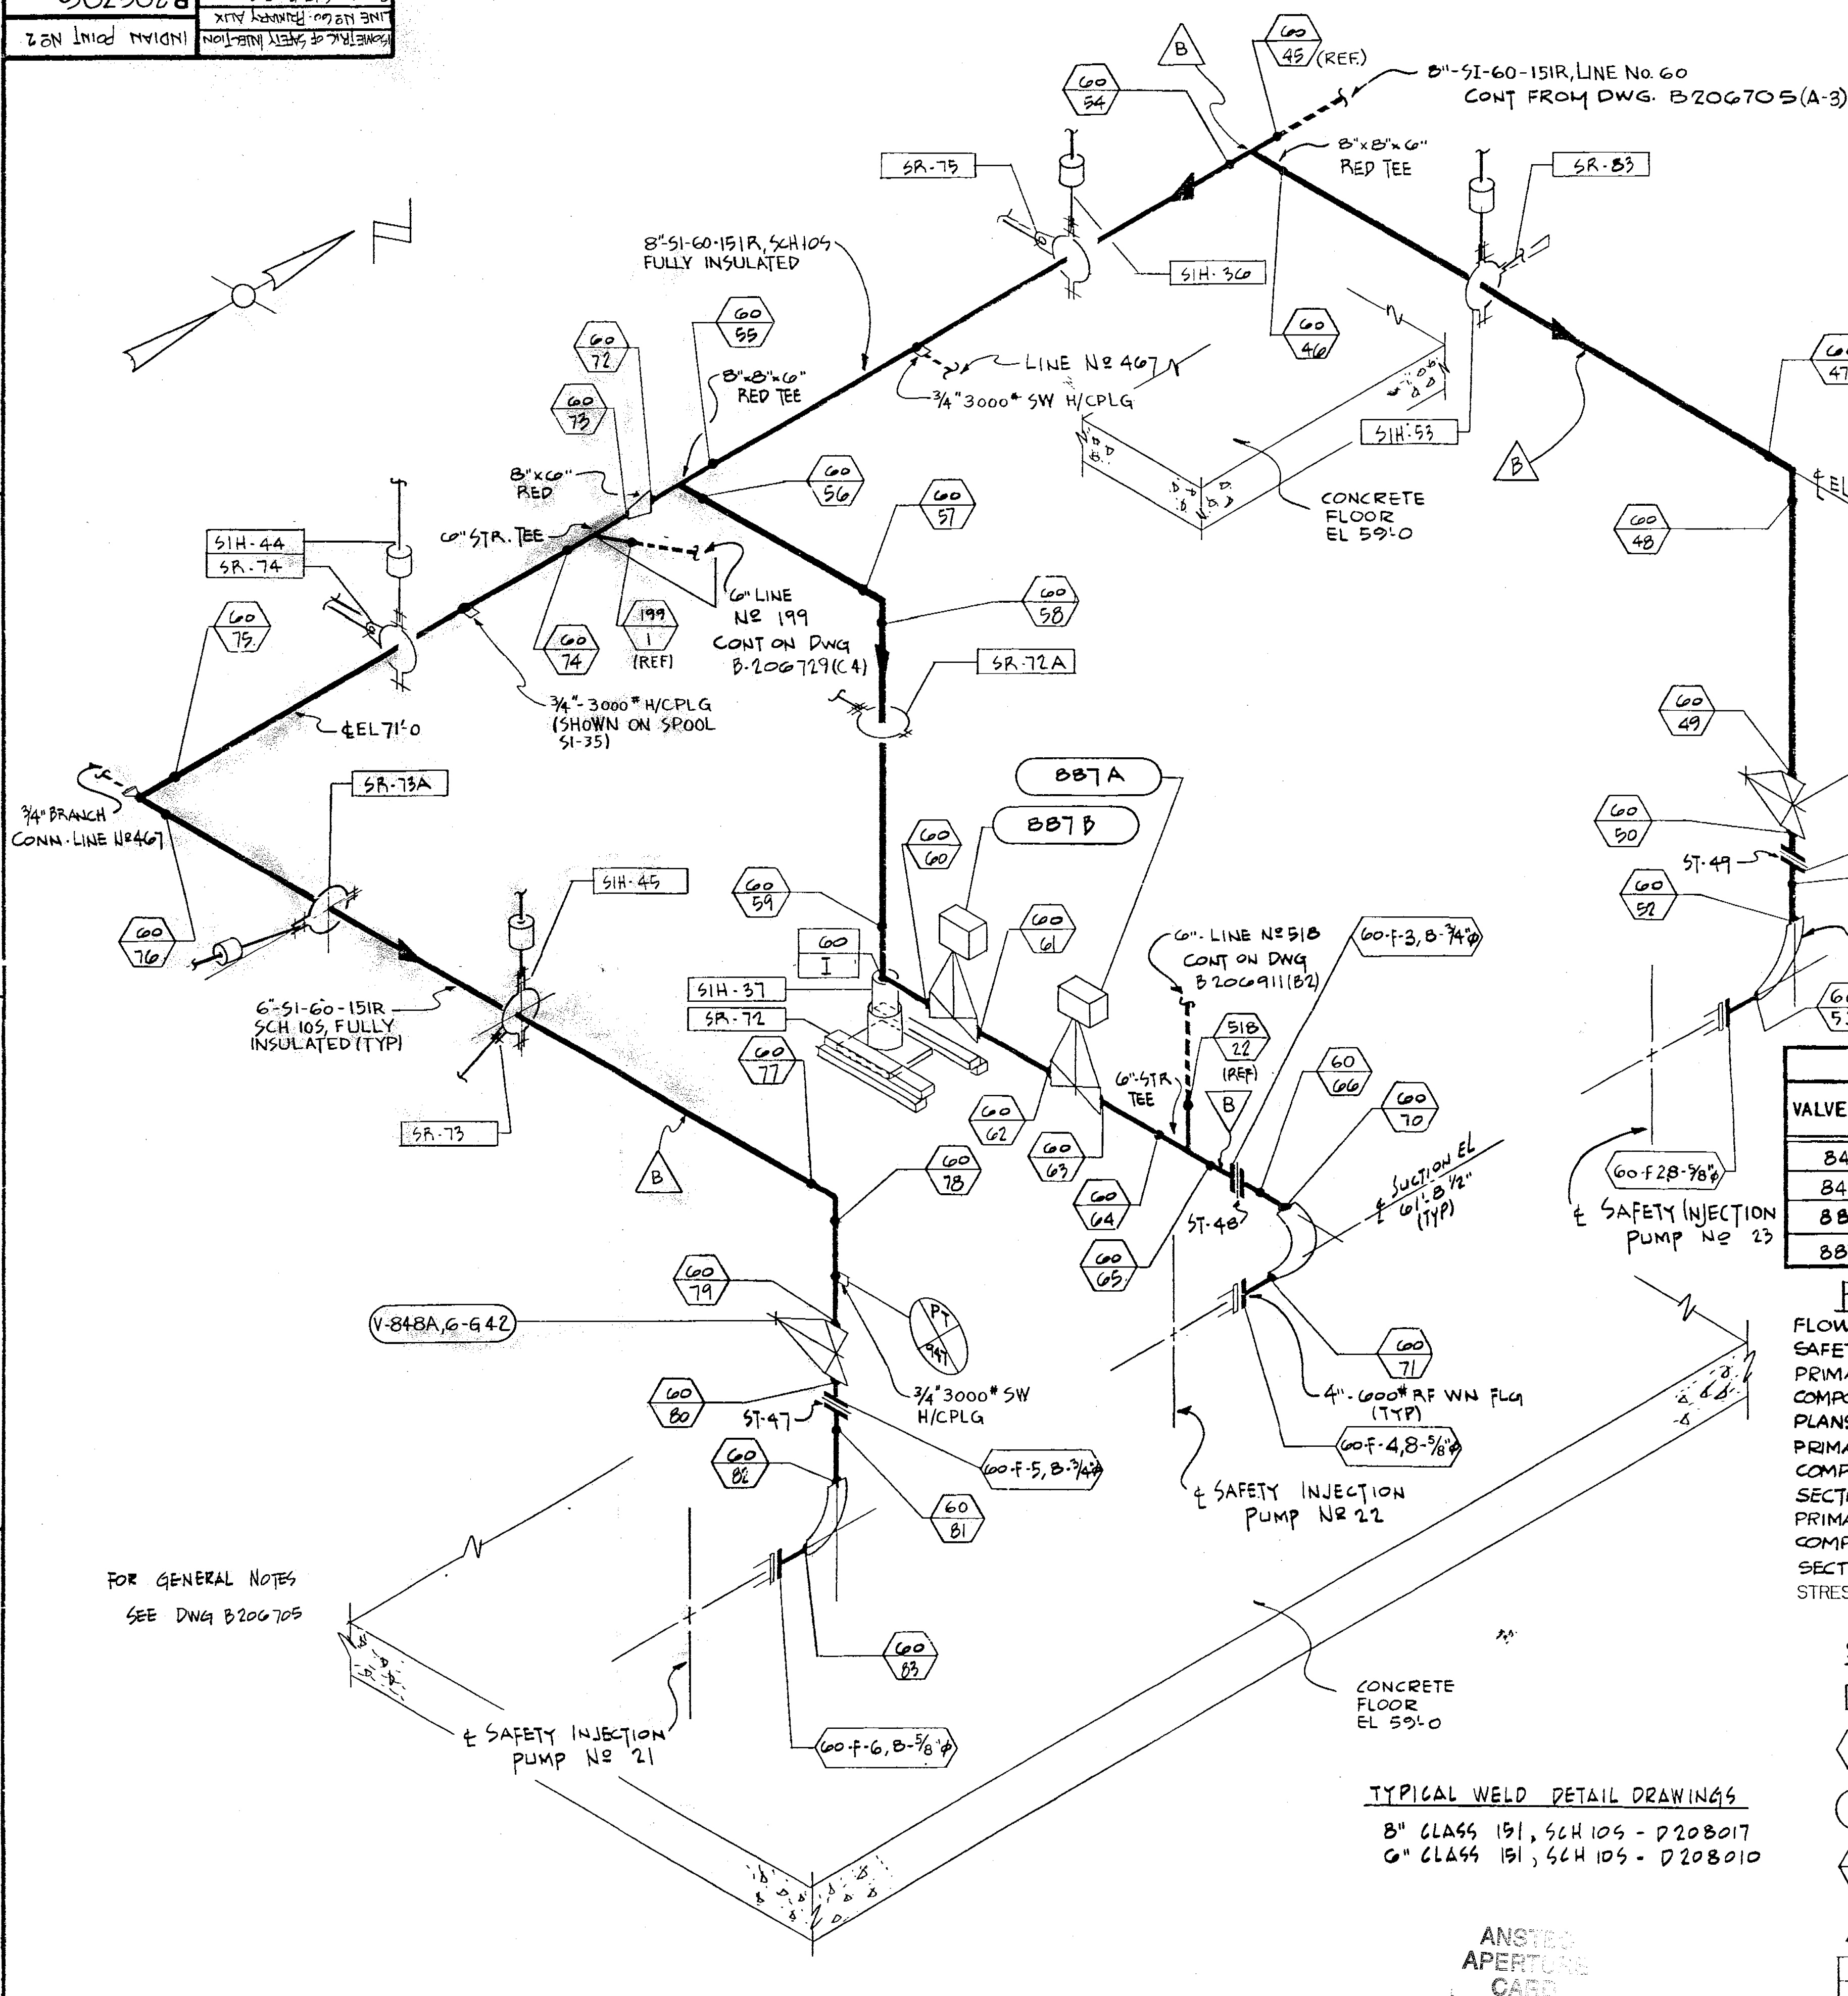

THIS REVISION IS CLASS 'A' AS PER CI-240-1. UPDATED DWG AS PER AS-BUILT INFORMATION AND IN-SERVICE INSPECTION FIELD REVISION INFORMATION RELEASE FOR RECORD
P.N. 69982-AD-3 JMBV 12/16/93
ATOMIC INC.
12/17/93 FOM

NOT FOR FABRICATION OR INSTALLATION

THIS DRAWING CONTAINS ITEMS WHICH MUST BE CONTROLLED WITHIN CON EDISON AS:
"CLASS A" ITEMS
PER CI-240-1

VALVE BONNET BOLTING						
VALVE NO.	VALVE TYPE	NO. OF BOLTS	BOLT DIA.	BOLT TYPE	VALVE MANUFACTURER	MANUFACTURER DWG. NO.
848A	G-642				ALOYCO	D-43511
848B	G-642				ALOYCO	D-43511
887A		10	5/8"	STUD BOLTS	ALOYCO	D-45200
887B		10	5/8"	STUD BOLTS	ALOYCO	D-45200


- REFERENCE DRAWINGS
- FLOW DIAGRAM - SAFETY INJECTION SYSTEM 9321-F-2735
 - PRIMARY AUXILIARY BUILDING COMPOSITE PIPING ARRANGEMENT PLANS AT EL. 15', EL. 35', EL. 42', EL. 50' 9321-F-2573
 - PRIMARY AUXILIARY BUILDING COMPOSITE PIPING ARRANGEMENT SECTIONS - SHEET NO. 3 9321-F-2588
 - PRIMARY AUXILIARY BUILDING COMPOSITE PIPING ARRANGEMENT SECTIONS - SHEET NO. 4 9321-F-2589
 - STRESS ISOMETRIC FOR PIPING PROBLEM #SI-60 B235432

- SYMBOL IDENTIFICATION
- SUPPORT NUMBER
 - FIG. NO., NUMBER OF BOLTS AND BOLT DIAMETER
 - VALVE NUMBER
 - WELD NUMBER
 - QUALITY GROUP CLASSIFICATION
 - INTEGRAL SUPPORT WELD NUMBER

TYPICAL WELD DETAIL DRAWINGS

8" CLASS 151, SCH 10S - D208017
6" CLASS 151, SCH 10S - D208010

ANSTED APERTURE CARD

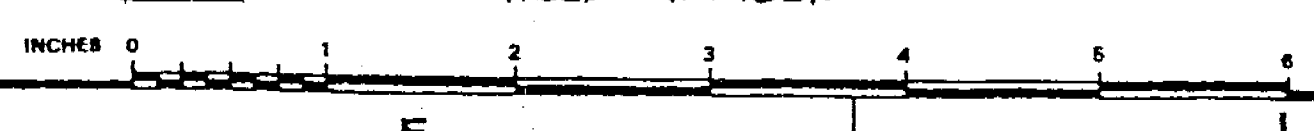

REVISIONS

0	11-3-78	THIS ISSUE IS NON-CLASS 'A' PER CI 240-1. RELEASE FOR RECORD. P.N. 7076 11-3-78
1	11-16-80	THIS REVISION IS NON-CLASS 'A' PER CI 240-1. UPDATED DWG. TO SHOW WORK ON DWG. 9321-F-2573, THRU REV. 32. ADDED REF. DRAWINGS. ADDED LATEST REV. NO. TO REF. DRAWINGS. RELEASE FOR RECORD. P.N. 7076 AM/AS EBASCO SERVICES, INC. 1-10-80
2	11-16-82	THIS REVISION IS NON-CLASS 'A' PER CI 240-1. ADDED LATEST REV. NO. TO REF. DWG'S. REMOVED SR-83A & B3D. RELEASE FOR RECORD. P.N. 21368 TREADWELL CORP. 11-12-82
3	11-16-82	THIS REVISION IS NON-CLASS PER CI-240-1. CHANGED DISCHARGE CODE FROM MT TO ML. RELEASE FOR RECORD. P.N. 69911-EZ

NOT FOR FABRICATION OR INSTALLATION

B206706-4

CONSOLIDATED EDISON CO.
OF NEW YORK, INC.

STATION LOCATION INDIAN POINT NO. 2

INSERVICE INSPECTION

ISOMETRIC OF SAFETY INJECTION LINE

NR 60 - PRIMARY AUXILIARY BUILDING

SHT 3 OF 3

SCALE NONE

DRAWN BY P. DENE

CHECKED BY M. STEINHAUER

DATE 2/28/94

Regulatory Docket File

APPROVALS

GENERAL ENGINEERING	CHIEF DESIGN ENGINEER	DATE 2/28/94
MECHANICAL ENGINEERING	MECH. PLUMB ENGINEER	
CIVIL ENGINEERING	PLANT STRUCT. ENGINEER	
ELECTRICAL ENGINEERING	T & D STRUCT. ENGINEER	
GAS & STEAM OPERATIONS	STATION ELECT. ENGINEER	
PRODUCTION	T & D ENGINEER	
	STRUCT. ENGINEER	
	CONVENTIONAL POWER	
	NUCLEAR POWER	