

SAFETY RELATED AS NOTED

UNIT NO. 1


BECHTEL CORPORATION ENGINEERS & CONSTRUCTORS LOS ANGELES, CALIF.		
JOB NO.	DATE	APPROVED
3946	12-22-64	<i>[Signature]</i>

REVISIONS	DATE	APPROVED	C.K.	C.K.	CHECKED	MADE	J.O.N.
3 AS BUILT BY PLUMBING CO. (FCN 5-3181-R)	2-5-70	<i>[Signature]</i>					
2 GENERAL REVISION	7-21-70	<i>[Signature]</i>					
1 GENERAL REVISION	9-23-70	<i>[Signature]</i>					
0 ISSUED FOR CONSTRUCTION	12-22-64	<i>[Signature]</i>					
A GENERAL REVISIONS	3-13-64	<i>[Signature]</i>					

LOCATION	SAN ONOFRE NUCLEAR GEN. STATION
GENERAL ARRANGEMENT	SECTIONS-SHEET 2
SOUTHERN CALIFORNIA EDISON COMPANY	LOS ANGELES, CALIF.
SCALE	1/8" = 1'-0"

11/2/74 No. 5

568704-3

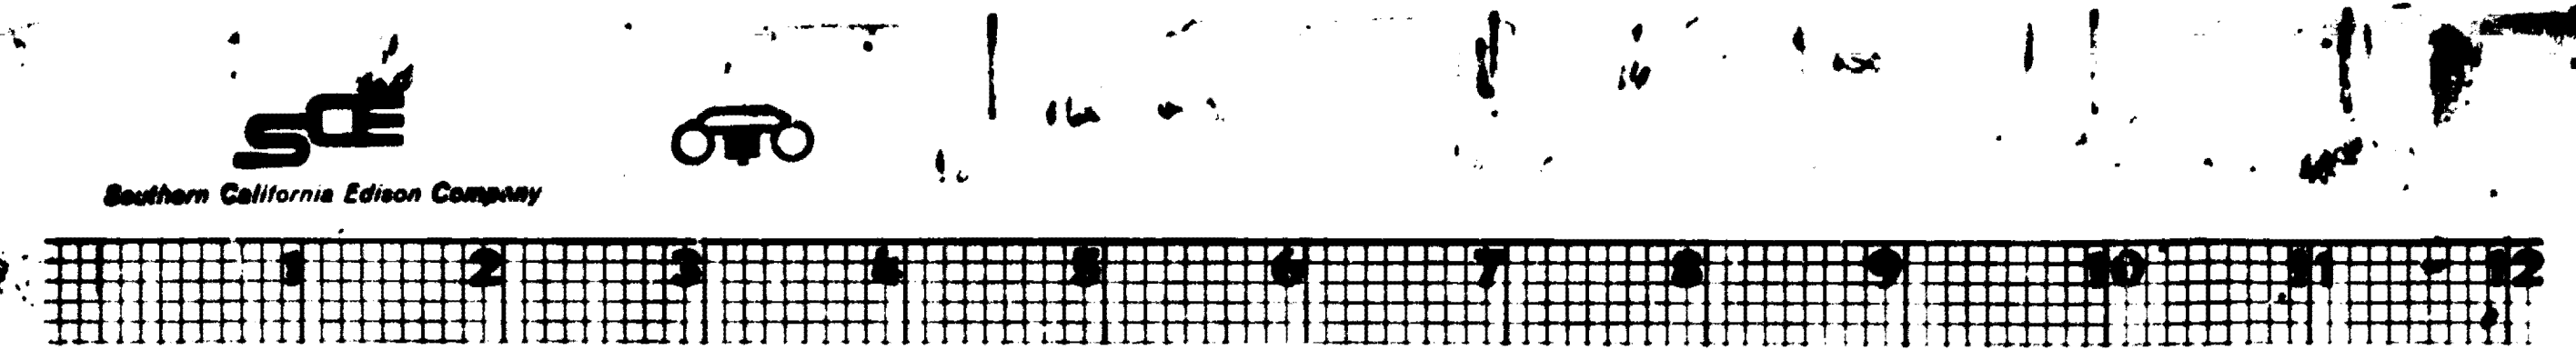

26X