
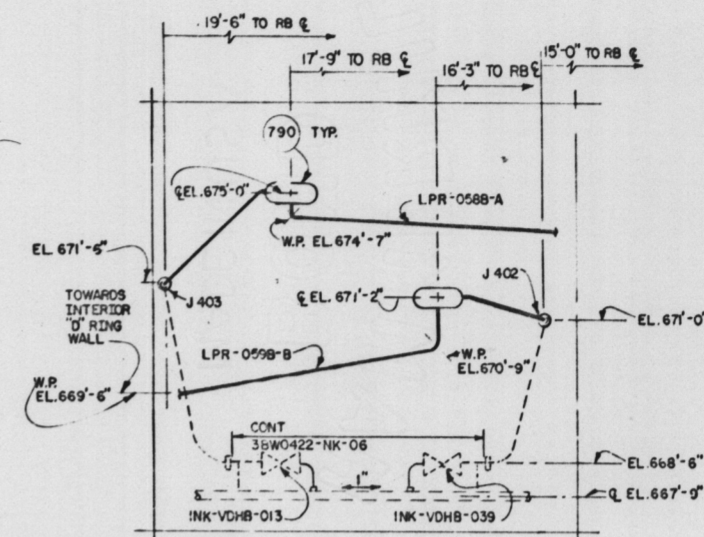


NOTES:
1. FOR GENERAL NOTES AND REFERENCE DRAWINGS SEE 5RW1925-NC-01.

ASSUMED NORTH

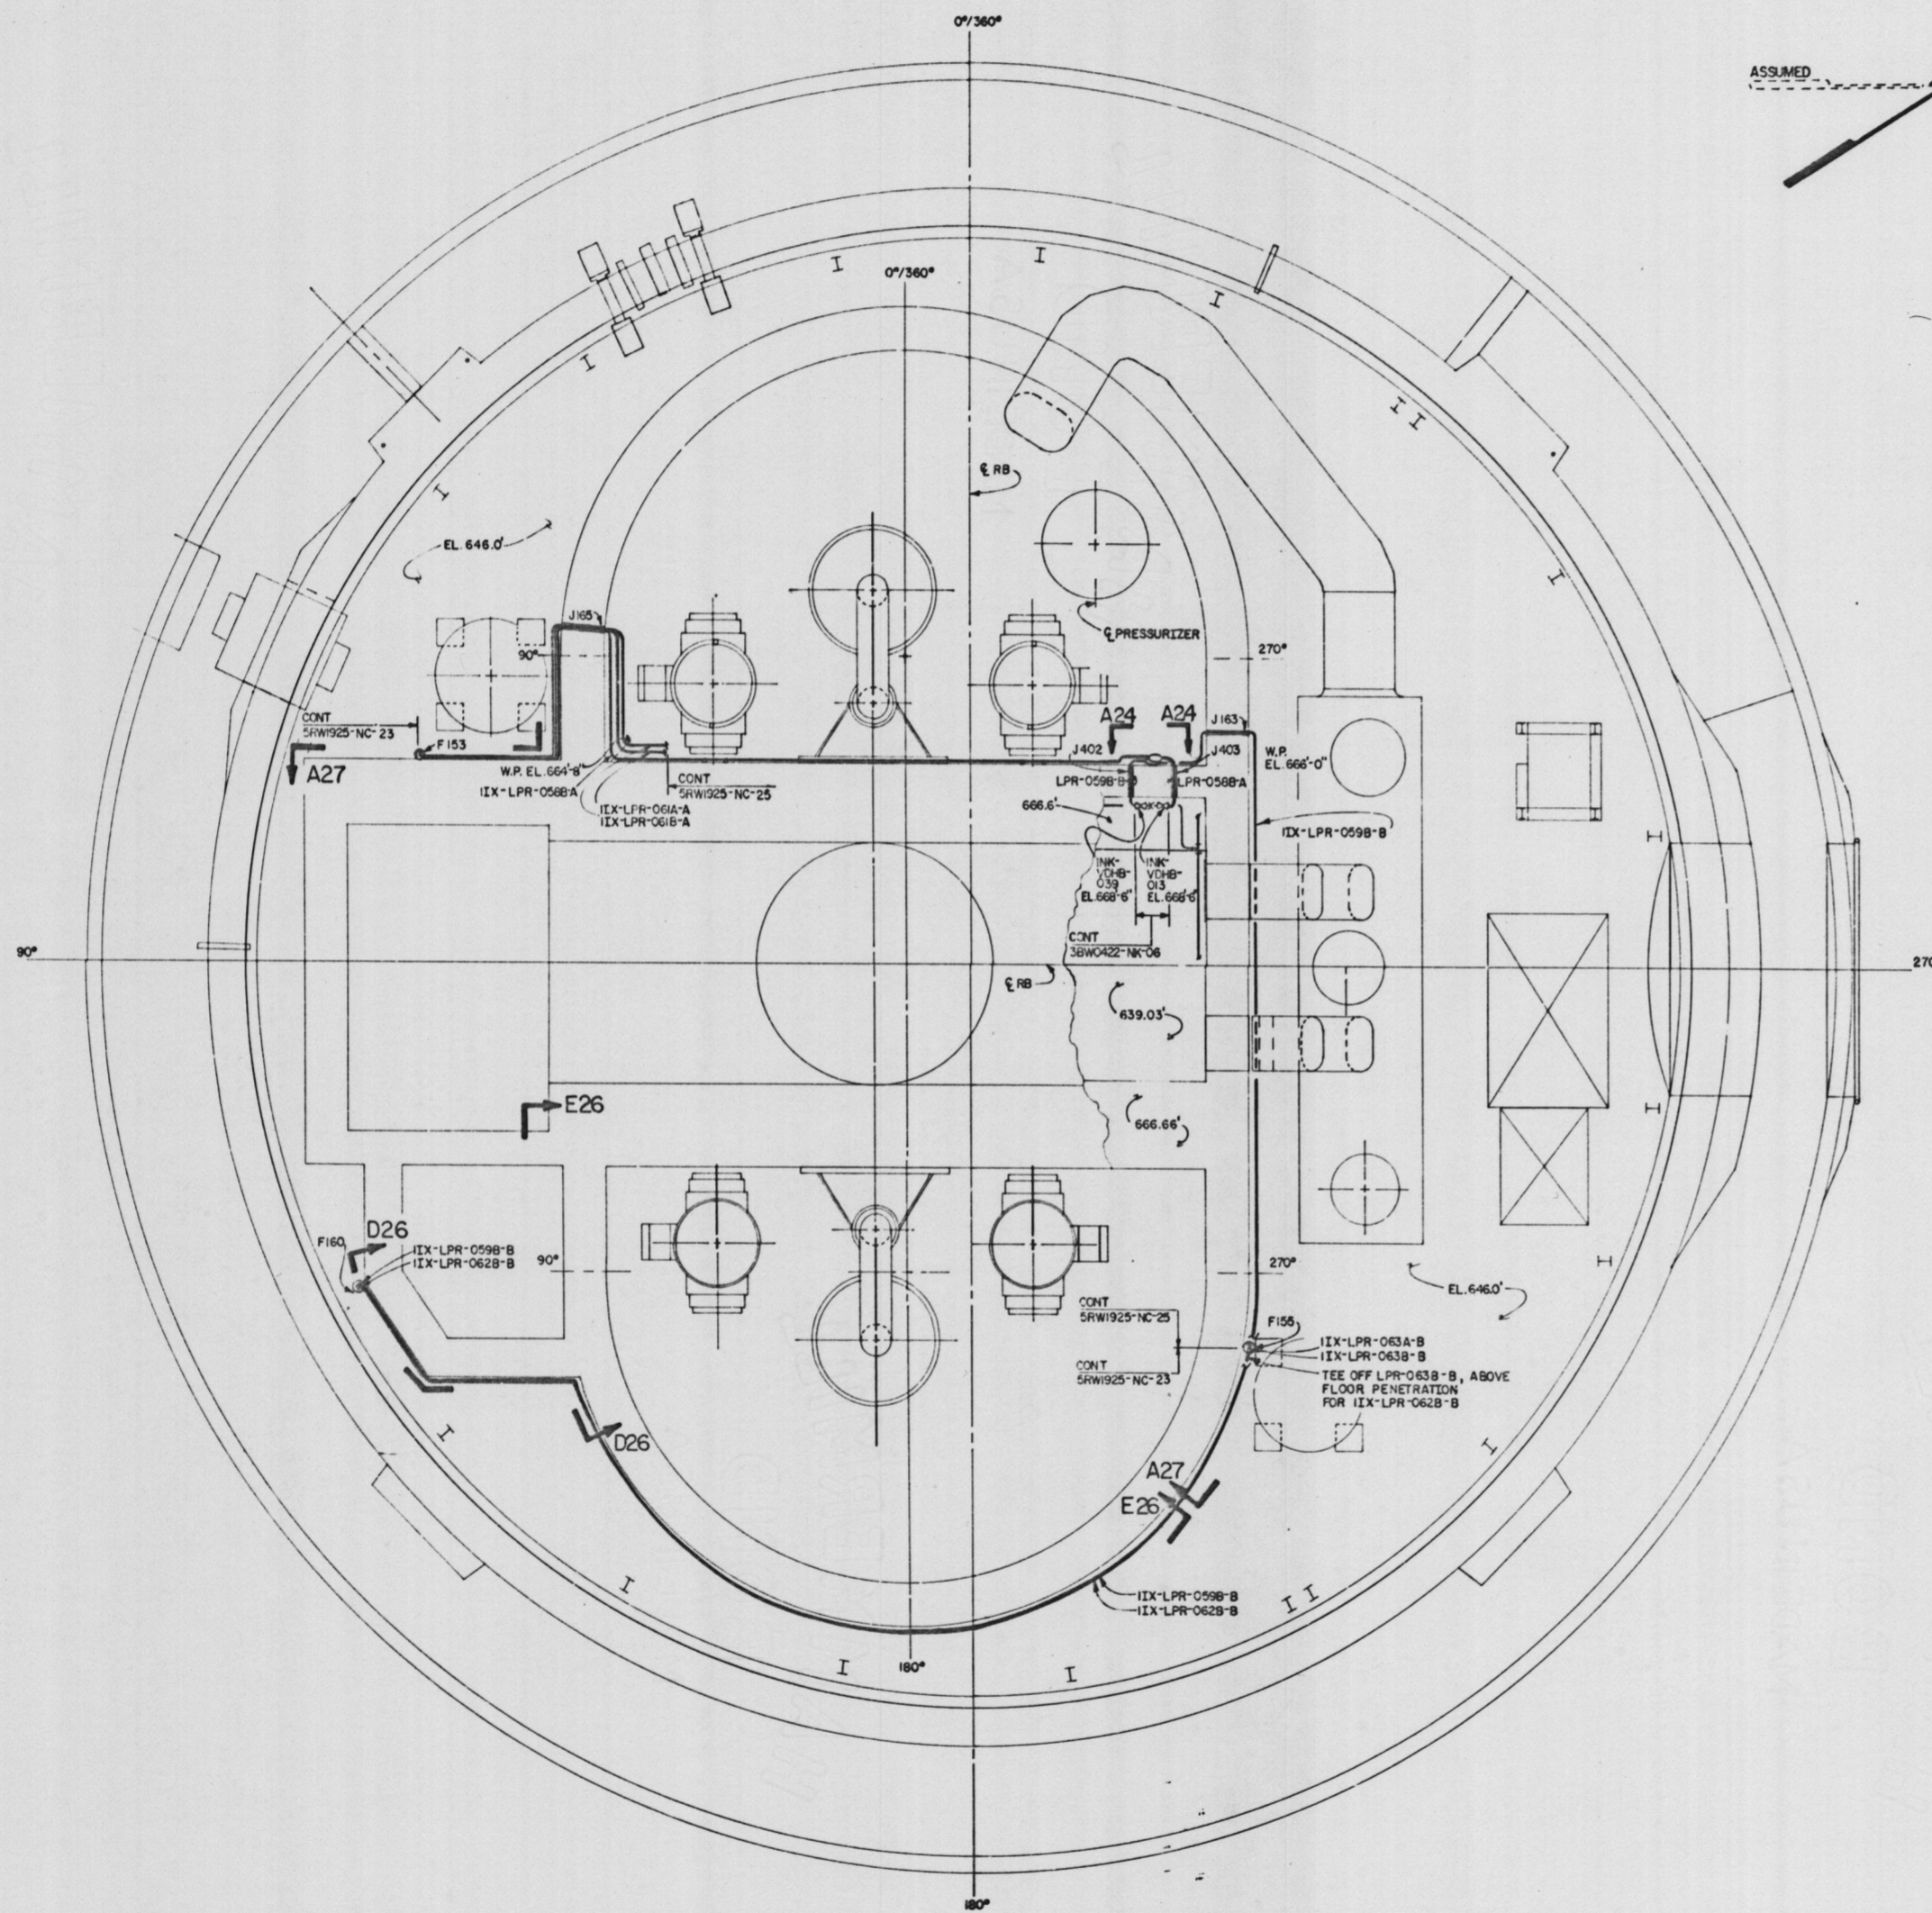

A24-A24
CONDENSATE POT SCHEMATIC
NTS

PRC
APERTURE
CARD

Docket # 50-435/A39
Control # 8301060310
Date 12/23/82 of Document
REGULATORY DOCKET FILE

8301060351

PLAN EL.646.0'

RO ISSUED PER ECN 89

REV NO	ECN NO	DATE	DESIGN	CHKD	SUPV	ENGR	INSP	SUBM	REC'D	APPR
1										

SCALE: 1/8" = 1'-0" EXCEPT AS NOTED

REACTOR BLDG
UNIT I
INSTRUMENTS & CONTROLS
LCL PNLs IIX-ILPR -058-A, -059-B, -060-A,
-061-A, -062-B & -063-B
INSTALLATION EL.646.0'

BELLEFONTE NUCLEAR PLANT
TENNESSEE VALLEY AUTHORITY
DIVISION OF ENGINEERING DESIGN

FURTHER REVIEW
CEB R.O. Bennett
EEB N/A
MEB N/A
NEB J.A. Ralston

SUBMITTED RECOMMENDED APPROVED
INSPECTED AND APPROVED FOR ISSUE
KNOXVILLE 12-3-81 88 E 5RW1925-NC-24 RO

PRINT H
SIZE F

RECORD DRAWING AS CONSTRUCTED