


NOTES:
1. FOR GENERAL NOTES AND REFERENCE DRAWINGS SEE SRW1925-NC-01.

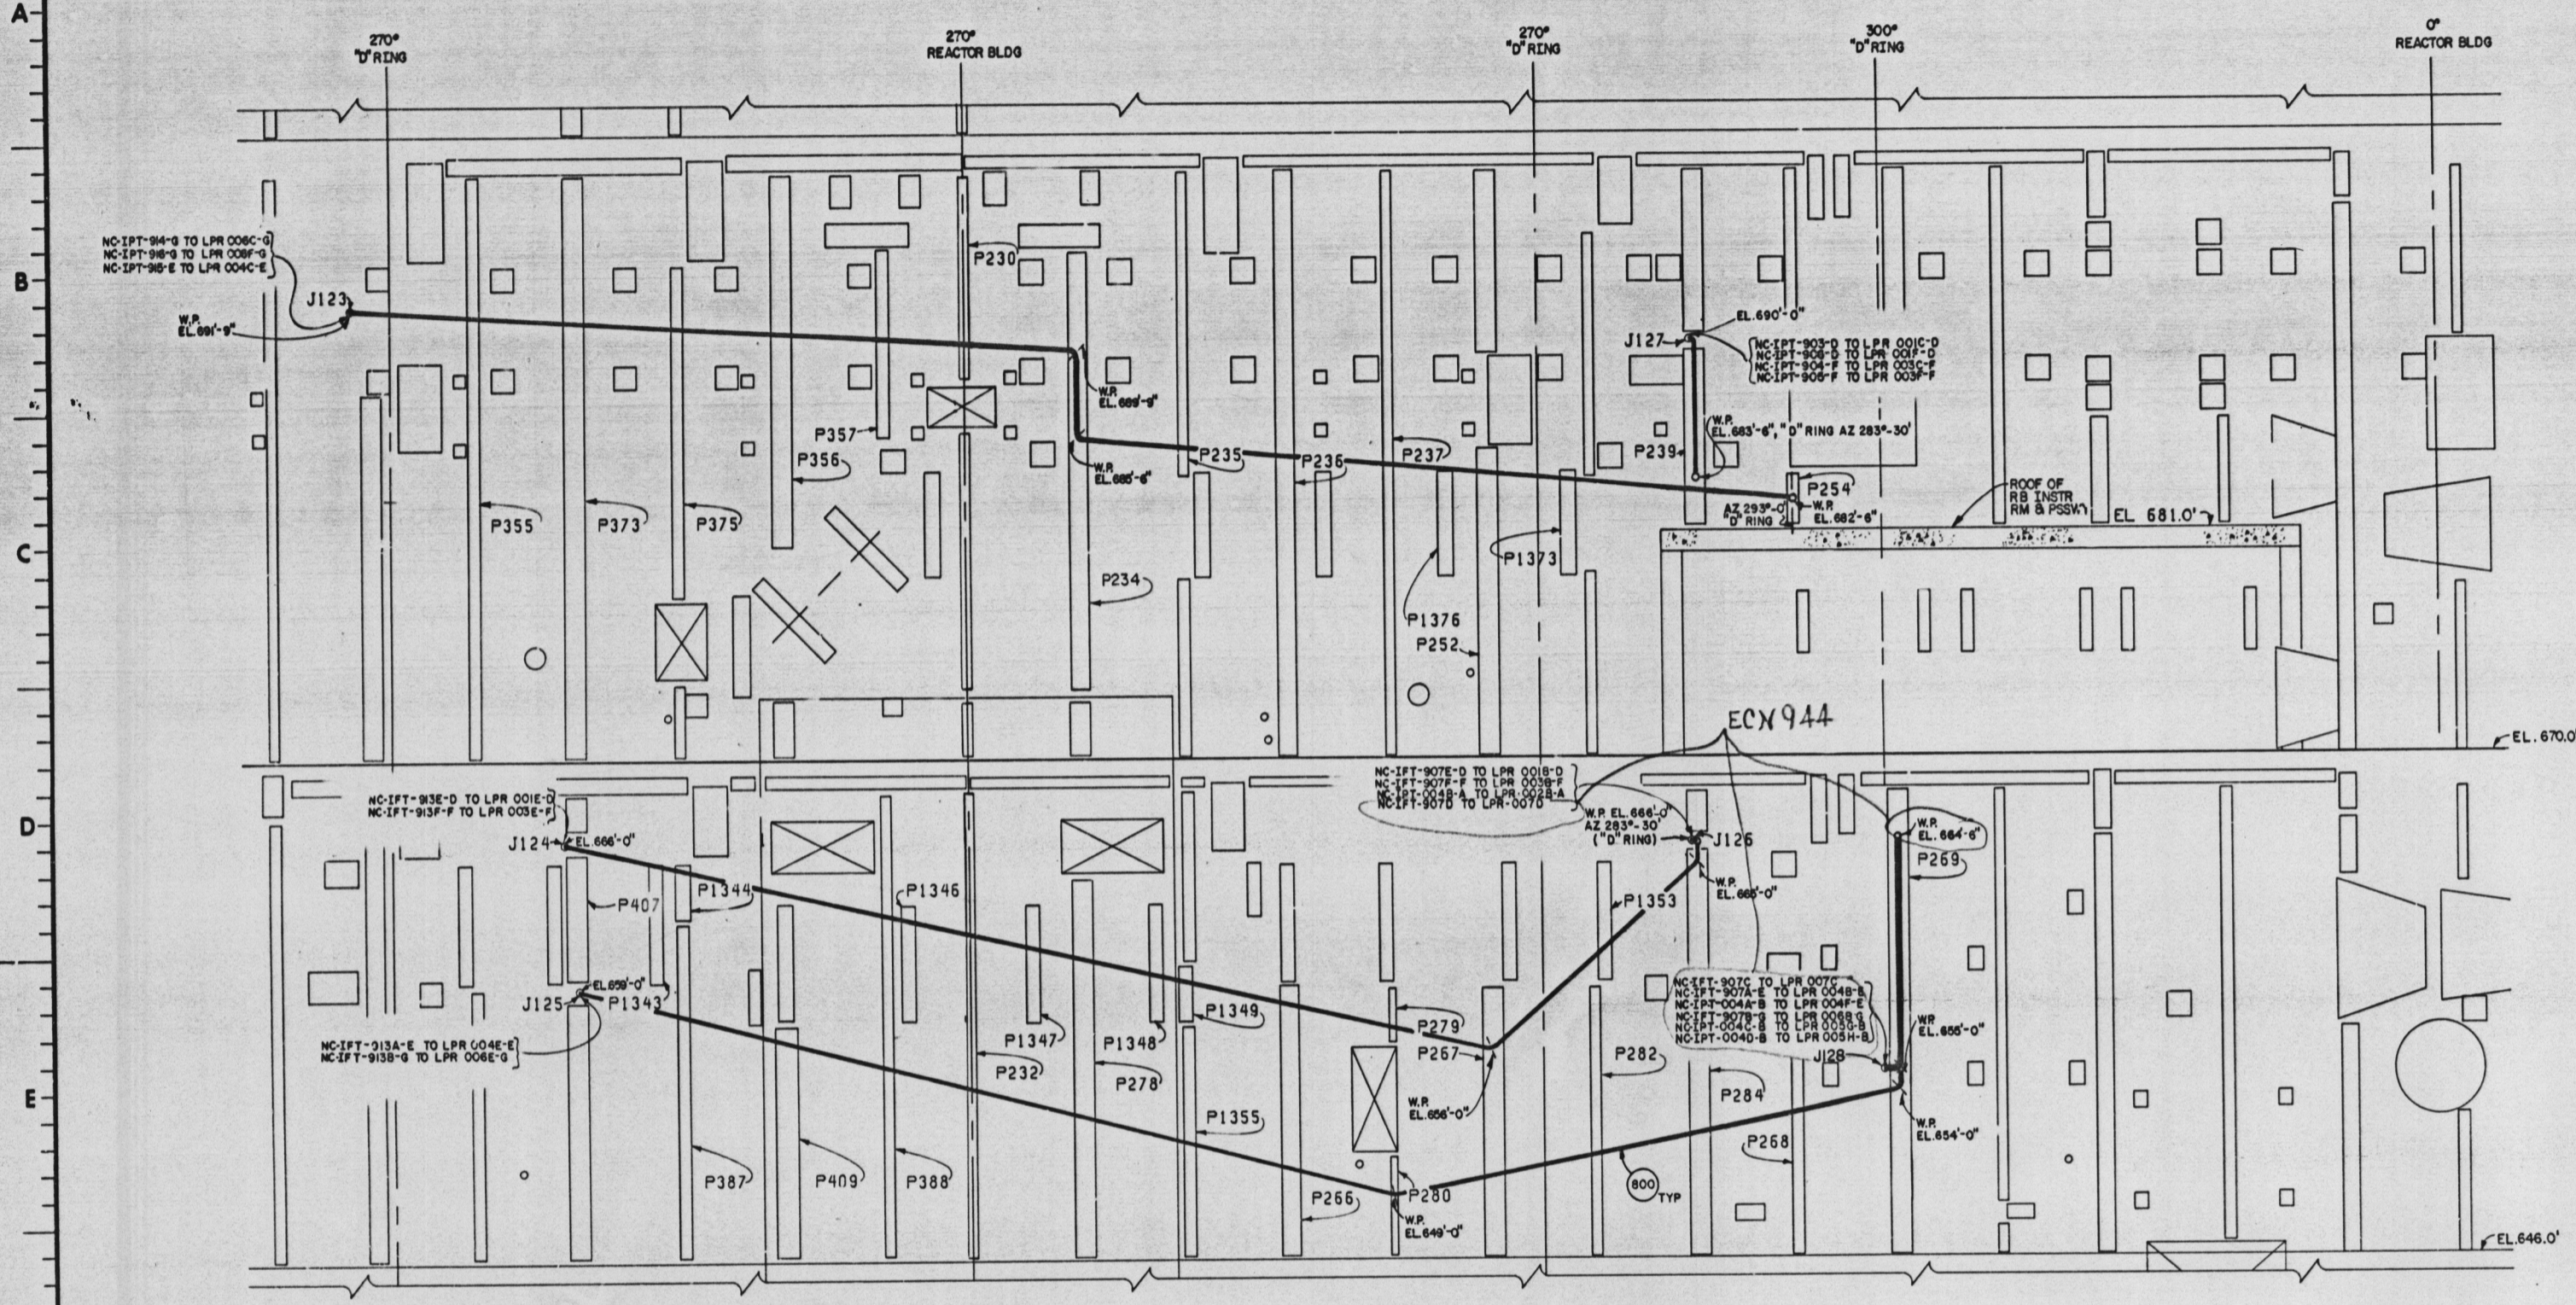

D4-D4
DEVELOPED EXTERIOR ELEVATION
SECONDARY SHIELD WALL

8301060333

PRC
APERTURE
CARD

Docket # 50-438
Control # 8301060330
Date 12/23/82 of Document
REGULATORY DOCKET FILE

I 944		9-22-88		10-22-88		10-22-88		10-22-88		10-22-88		
INCORPORATED ECN 944												
REV	NO.	DATE	DESIGNED	CHECKED	SUPVISED	ENGR	INSP	SUBM	RECAL	APPR		
DESIGN	J. J. Smith					INSP						
DRWN	J. J. Smith					ENGINEER	Chas. D. Anthony					
CHKD	J. J. Smith					ENGINEER						
SUPV	E. B. Bennett											
SCALE 1/4"=1'-0" EXCEPT AS NOTED												
REACTOR BUILDING UNIT I												
INSTRUMENTS & CONTROLS												
LCL PNLs IIX-ILPR-001-D THRU -004-E, -006-G, -007												
INSTALLATION EL 646.0 TO 700.0												
BELLEFONTE NUCLEAR PLANT TENNESSEE VALLEY AUTHORITY DIVISION OF ENGINEERING DESIGN												
SUBMITTED			RECOMMENDED			APPROVED						
INSPECTED AND APPROVED FOR ISSUE			Chas. D. Anthony			J. J. Smith			P. M. Healy			
KNOXVILLE		10-10-80		88 E		SRW1925-NC-04		RECORD DRAWING AS CONSTRUCTED				

FURTHER REVIEW	
CEB	R. C. Smith
EEB	N/A
MEB	N/A
NEB	Mary F. Dilworth

NF
RD
24