




PLAN - EL728.0  
SYMMETRICAL ABOUT E  
EXCEPT AS NOTED

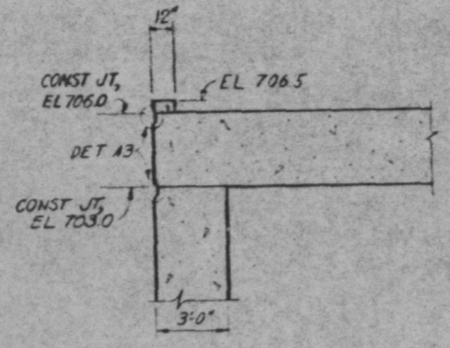


A3-A3 AS SHOWN  
B3-B3 OPP HAND  
SCALE 1/4\"/>

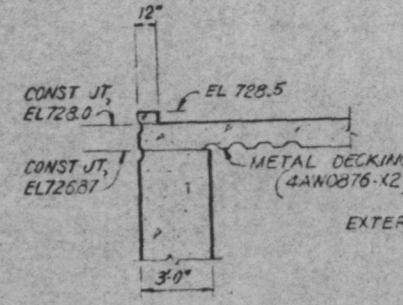


H3-H3 AS SHOWN  
J3-J3 OPP HAND  
SCALE 1/4\"/>

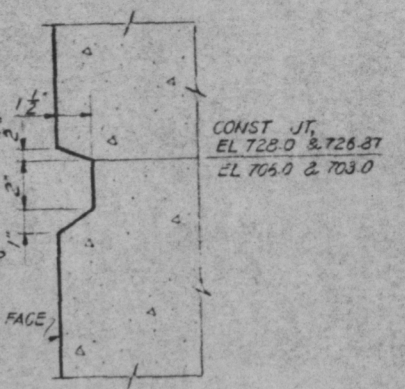


DETAIL A3  
SCALE 3/8\"/>

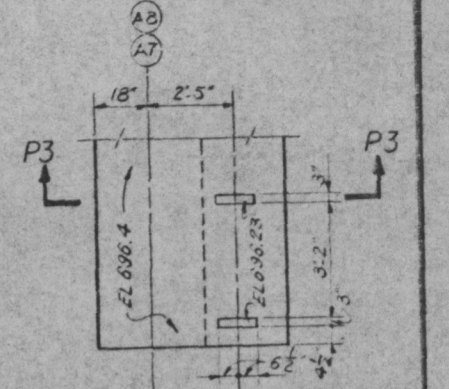


DETAILS B3 & C3  
B3 AS SHOWN  
C3 OPP HAND  
SCALE 3/8\"/>

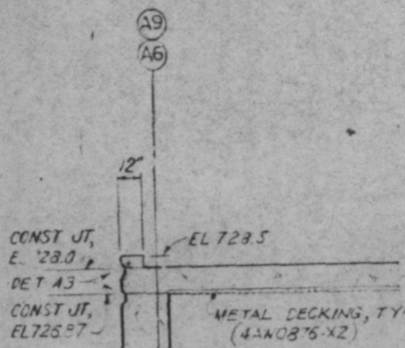


C3-C3 AS SHOWN  
D3-D3 OPP HAND  
SCALE 1/4\"/>

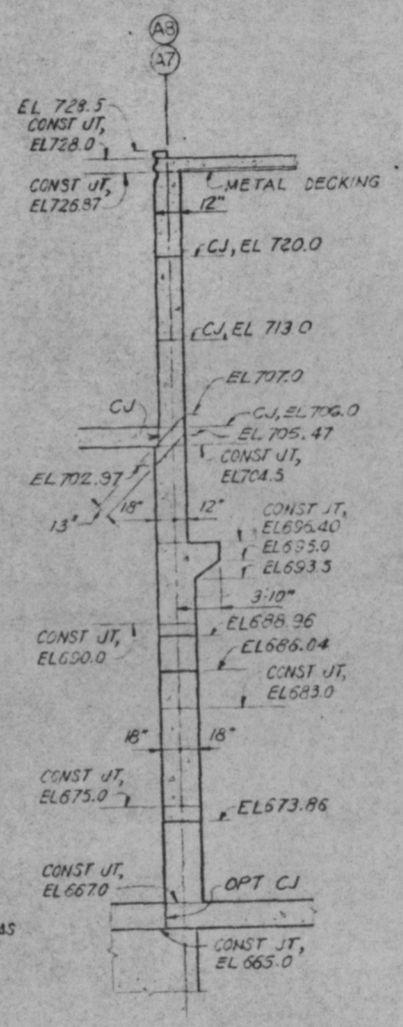


M3-M3 AS SHOWN  
N3-N3 OPP HAND

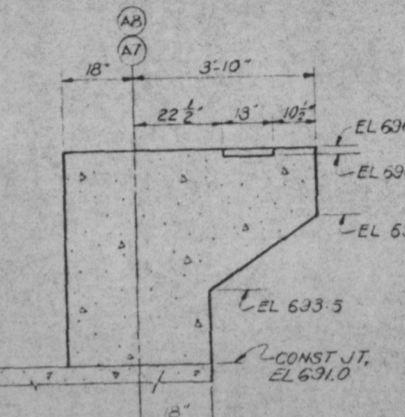


Q3-Q3  
SCALE 1/2\"/>

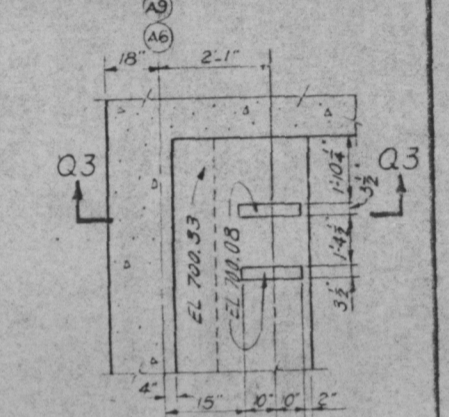

DETAILS D3 & E3  
D3 AS SHOWN  
E3 OPP HAND  
SCALE 3/8\"/>

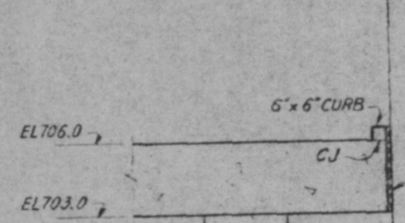

E3-E3 AS SHOWN  
F3-F3 OPP HAND  
SCALE 1/4\"/>

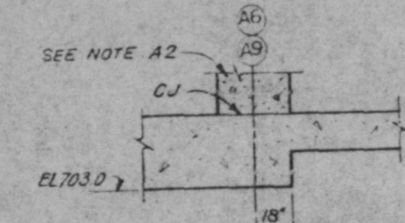

G3-G3  
SCALE 1/4\"/>

PRC  
APERTURE  
CARD

Docket # 50-438/439  
Control # 8209010340  
Date 8/25/92 of Document  
REGULATORY DOCKET FILE

SCALE 1/4\"/>

NOTES:  
1 FOR LIST OF NOTES AND REFERENCE DRAWINGS SEE 4AW0362-XI-1.

4	SI	3-21-79	REVISION	ADD OPT CJ & CJ PLAN - EL 728.0 PER FCR 0-1539 & 0-1594
3	SI	1-12-79	REVISION	REV PILASTERS IN PLAN - EL 728.0; ADD OPT CJ; FCR 0-1539
2	SI	8-11-77	REV WBS/FENWICK	REV ROOF OPENINGS; REV CJ, SECTS M3 & N3
1	SI	5-26-77	WBS/FENWICK	MINOR REVISIONS

AUXILIARY BUILDING - STAGE II  
UNITS 1 & 2

CONCRETE  
SLABS, WALLS AND ROOF ABOVE EL 664.0  
OUTLINE

BELLEFONTE NUCLEAR PLANT  
TENNESSEE VALLEY AUTHORITY  
DIVISION OF ENGINEERING DESIGN

SUBMITTED	RECOMMENDED	APPROVED
<i>Paul S. Cole</i>	<i>Ch. Tucker</i>	<i>R. M. Hester</i>
KNOXVILLE 7-22-77	88 c	4AW0362-XI-3 R4

RECORD DRAWING AS CONSTRUCTED

8209010343