


OPERATIONS RECORDER  
000-EECC-64  
EL 610, COL CII-P

REF TVA DWG (9CN7364-DA-02)

48V DC

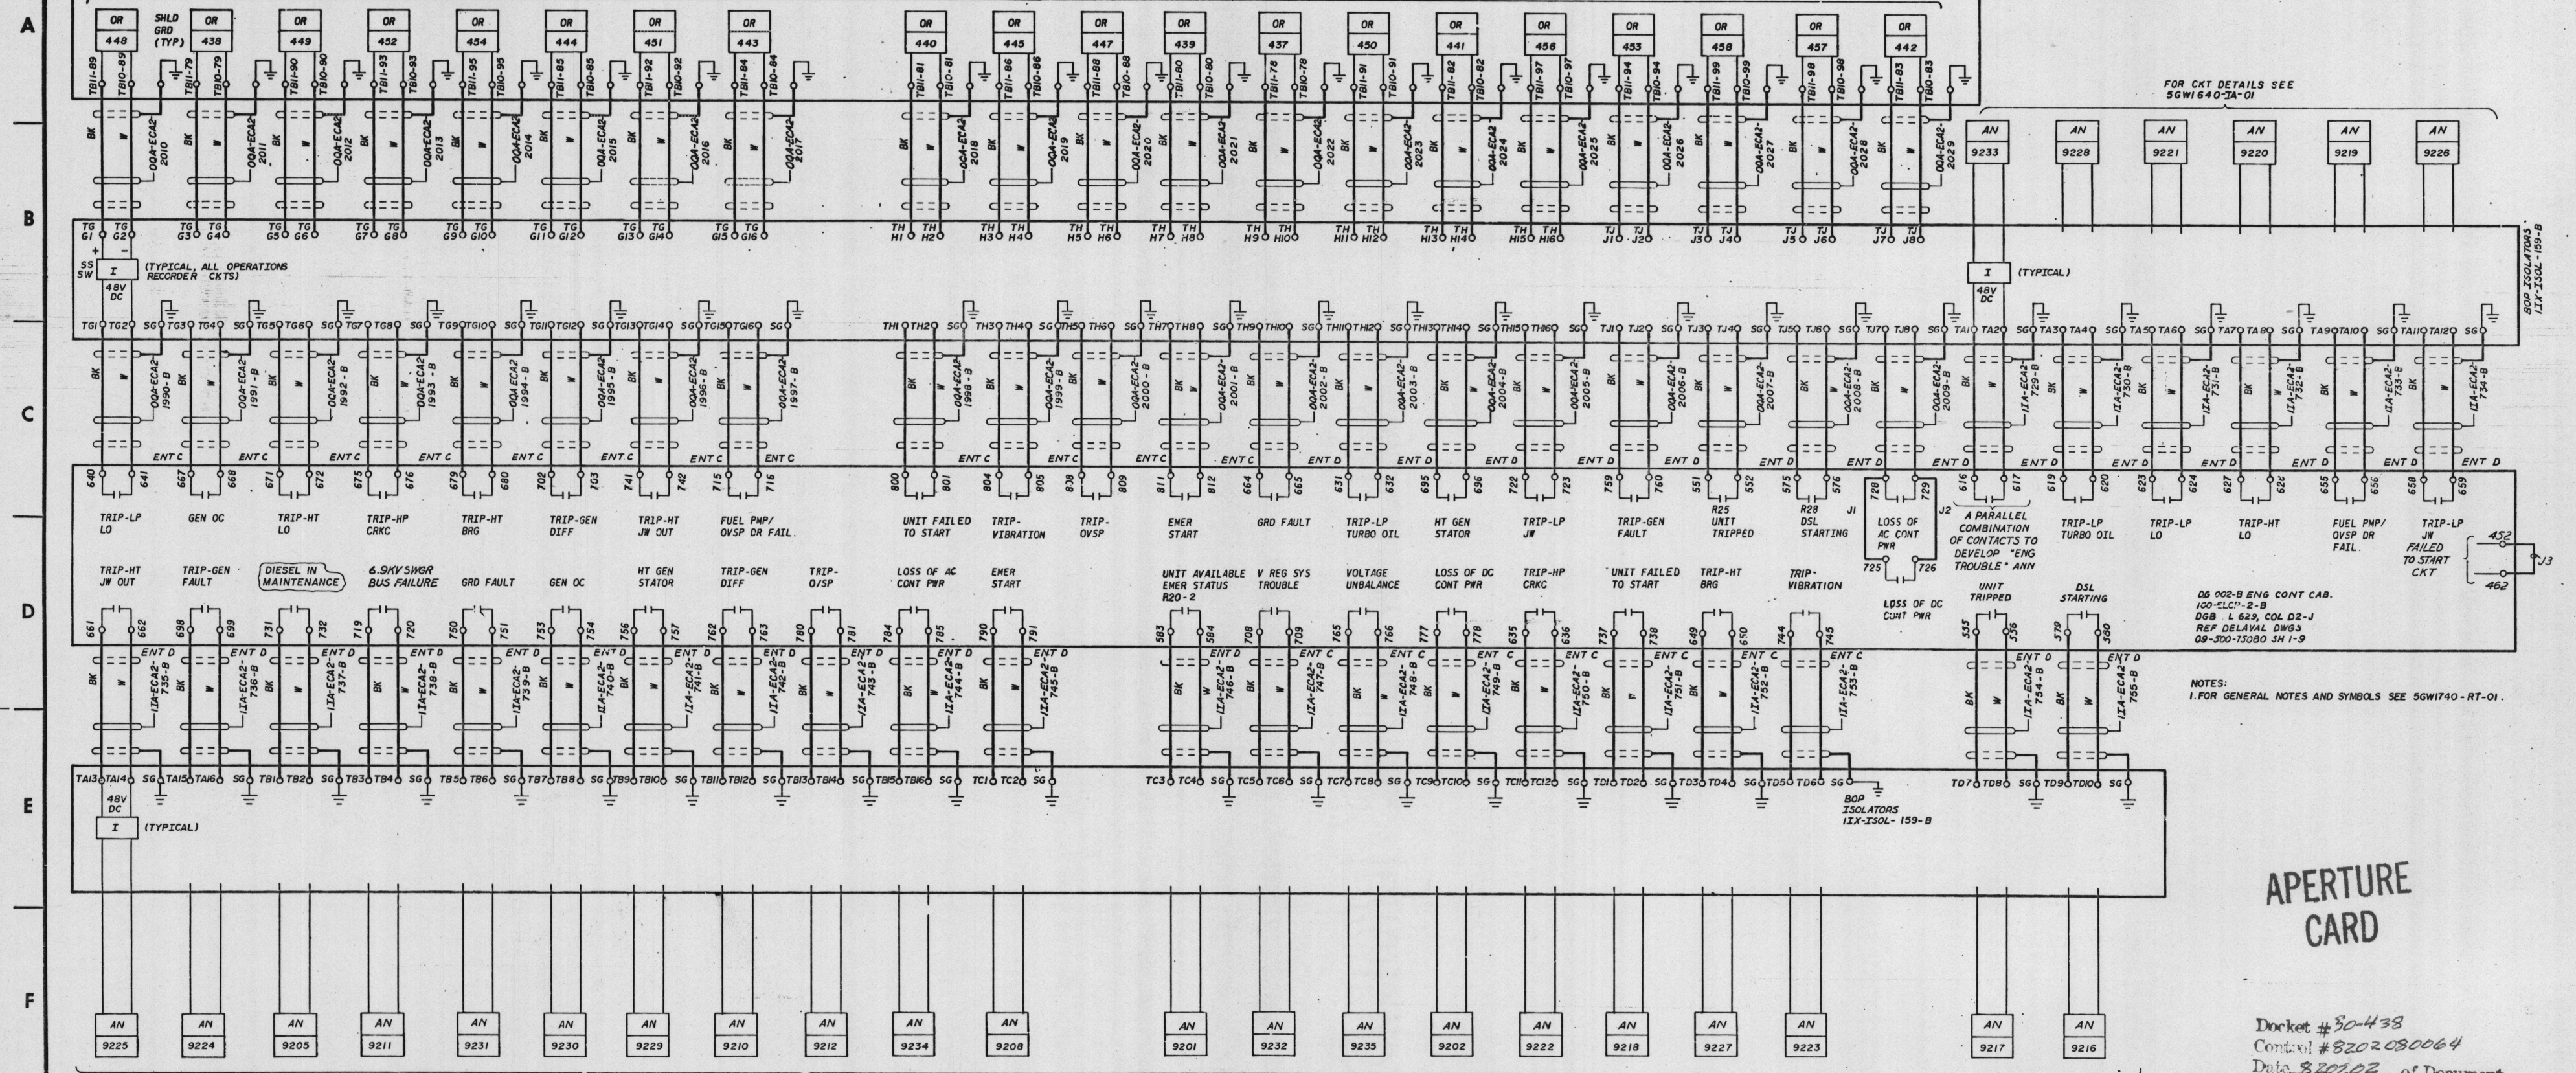

FOR CKT DETAILS SEE  
5GW1640-IA-01

NOTES:  
1. FOR GENERAL NOTES AND SYMBOLS SEE 5GW1740-RT-01.

APERTURE  
CARD

Docket # 30-438  
Control # 8202080064  
Data 820202 of Document  
REGULATORY DOCKET FILE

FOR CKT DETAILS SEE  
5GW1640-IA-01

DG 002-B ENGINE AND GENERATOR ANNUNCIATION

DG 002-B ENGR CONT CAB.  
100-ELCP-2-B  
DGB EL 629, COL D2-J  
REF DELAVAIL DWGS  
09-300-15090 SH 1-9

BOP ISOLATORS  
IXX-ISOL-159-B

FOR CKT DETAILS SEE 5GW1640-IA-01

PRINTS RECORDED  
BY UNIT PROJ  
DATE SIZE  
ME  
CE  
AD  
CD  
ED  
MD  
SW  
BL  
PA

REV	NO.	DATE	BY	CHKD	APPD	REASON
1	51	5-8-77	W.L. Albrecht			
ADDED ORA TERM NO. ANN PT NO. B CABLE NO. SEAMS PT NO. B CABLE NO. REF DWG NO. BOP ISOLATOR NO. TERM NO. B INTERNALS AND REMOVED CABLE SHIELD TERMINATION ON BOP ISOLATOR CAB FOR ORA CABLES.						
DESIGN	DATE	ENGR	INSPECTION	APPROVED		
DRWN	5-8-77	W.L. Albrecht	INSPECTION	APPROVED		
CHKD			ENGINEER	W.L. Albrecht		
SUPV						
GENERAL UNIT 1						
SYSTEM SCHEMATIC						
DG CONT SYS - RT						
BELLEFONTE NUCLEAR PLANT TENNESSEE VALLEY AUTHORITY						
DIVISION OF ENGINEERING DESIGN						
REVIEWED	SUBMITTED	RECOMMENDED	APPROVED			
RC (CNL) - N/A	W.L. Albrecht	R.M. Hedger	R.M. Hedger			
RE (ELEC) - N/A						
RM (MECH) - N/A						
KNOXVILLE 10-2-77 88 E 5GW1740-RT-14 R1						
RECORD DRAWING AS CONSTRUCTED						